



This drawing illustrates or otherwise contains information proprietary to HAMILTON CONSTRUCTION MANAGEMENT CORP. Any disclosure or use of this information is expressly prohibited without written agreement.

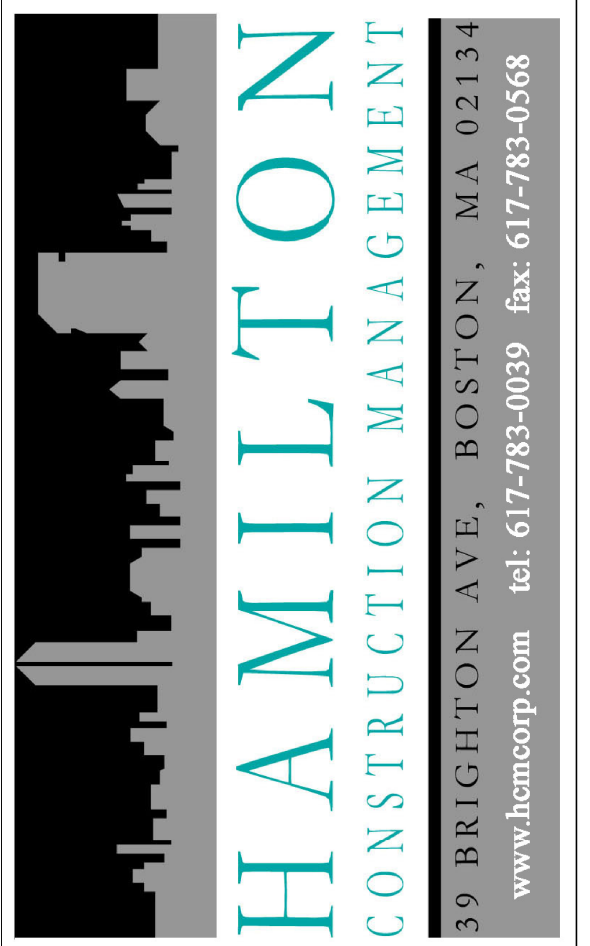

1101 Beacon Street, 6th Floor
Brookline, MA
Office Area- Square Footage Plans

February 13, 2023

A-7

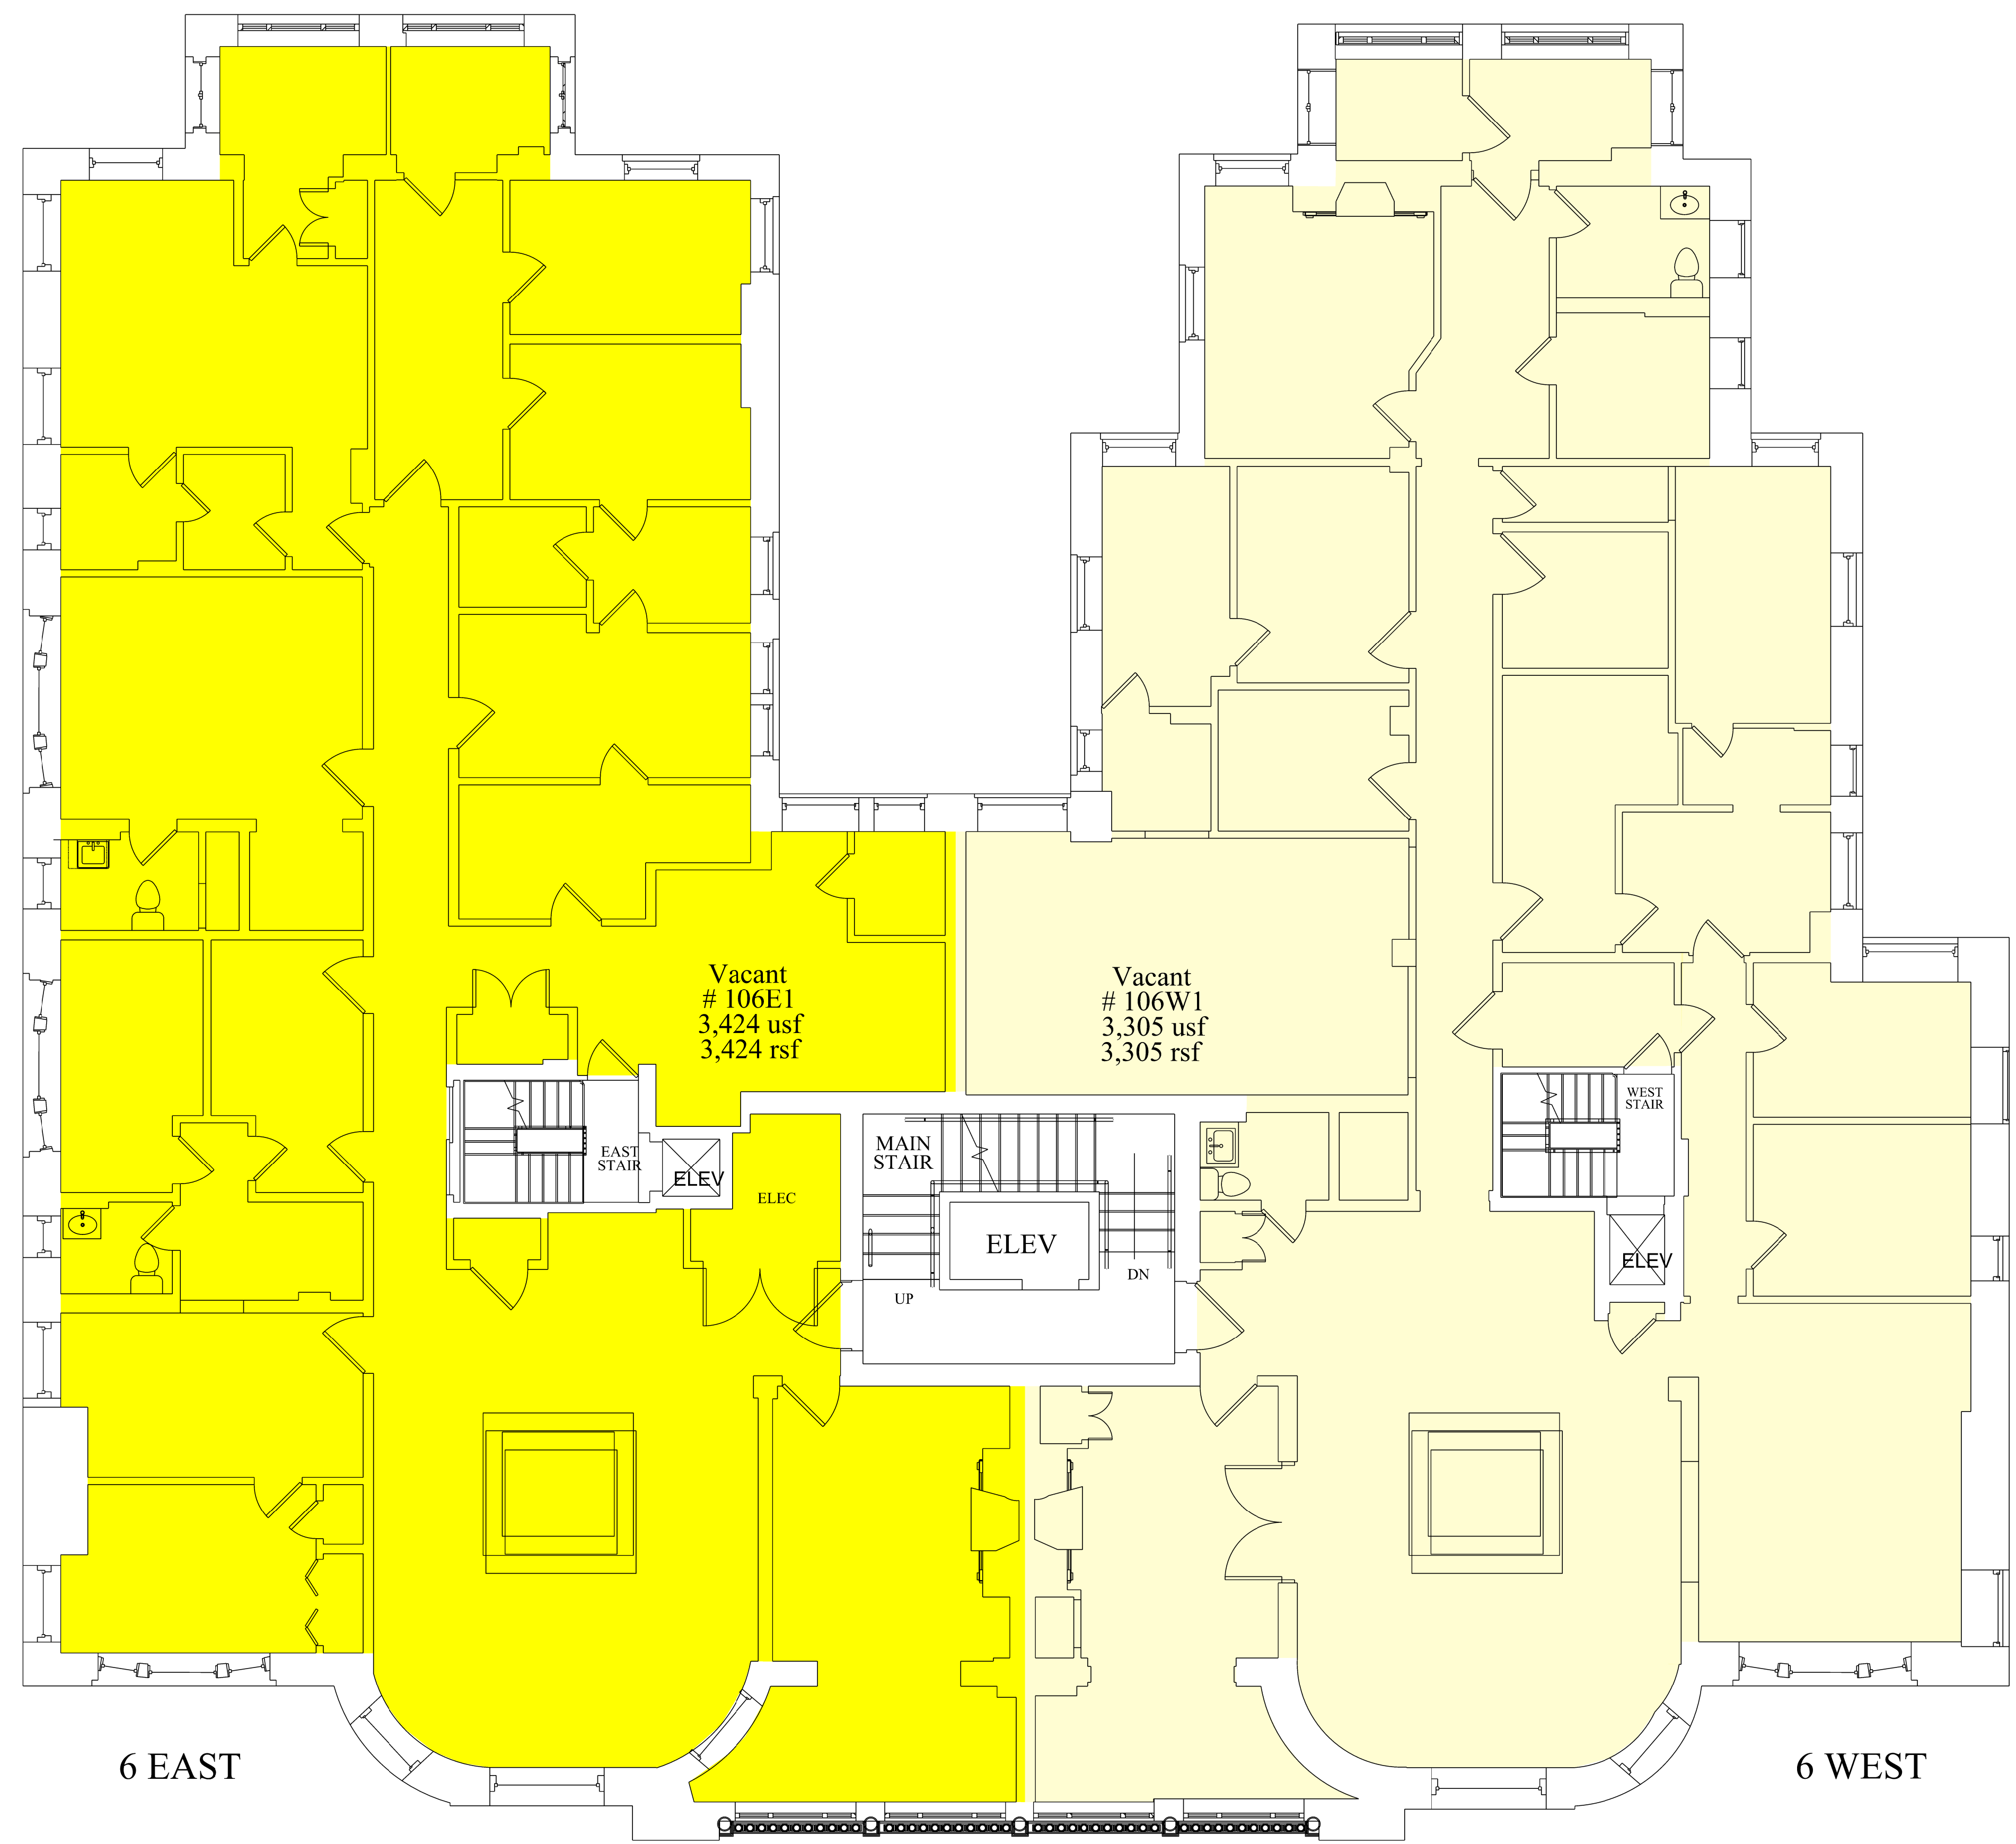

① Sixth Floor Plan - As Builts
3/16" = 1'-0"

