




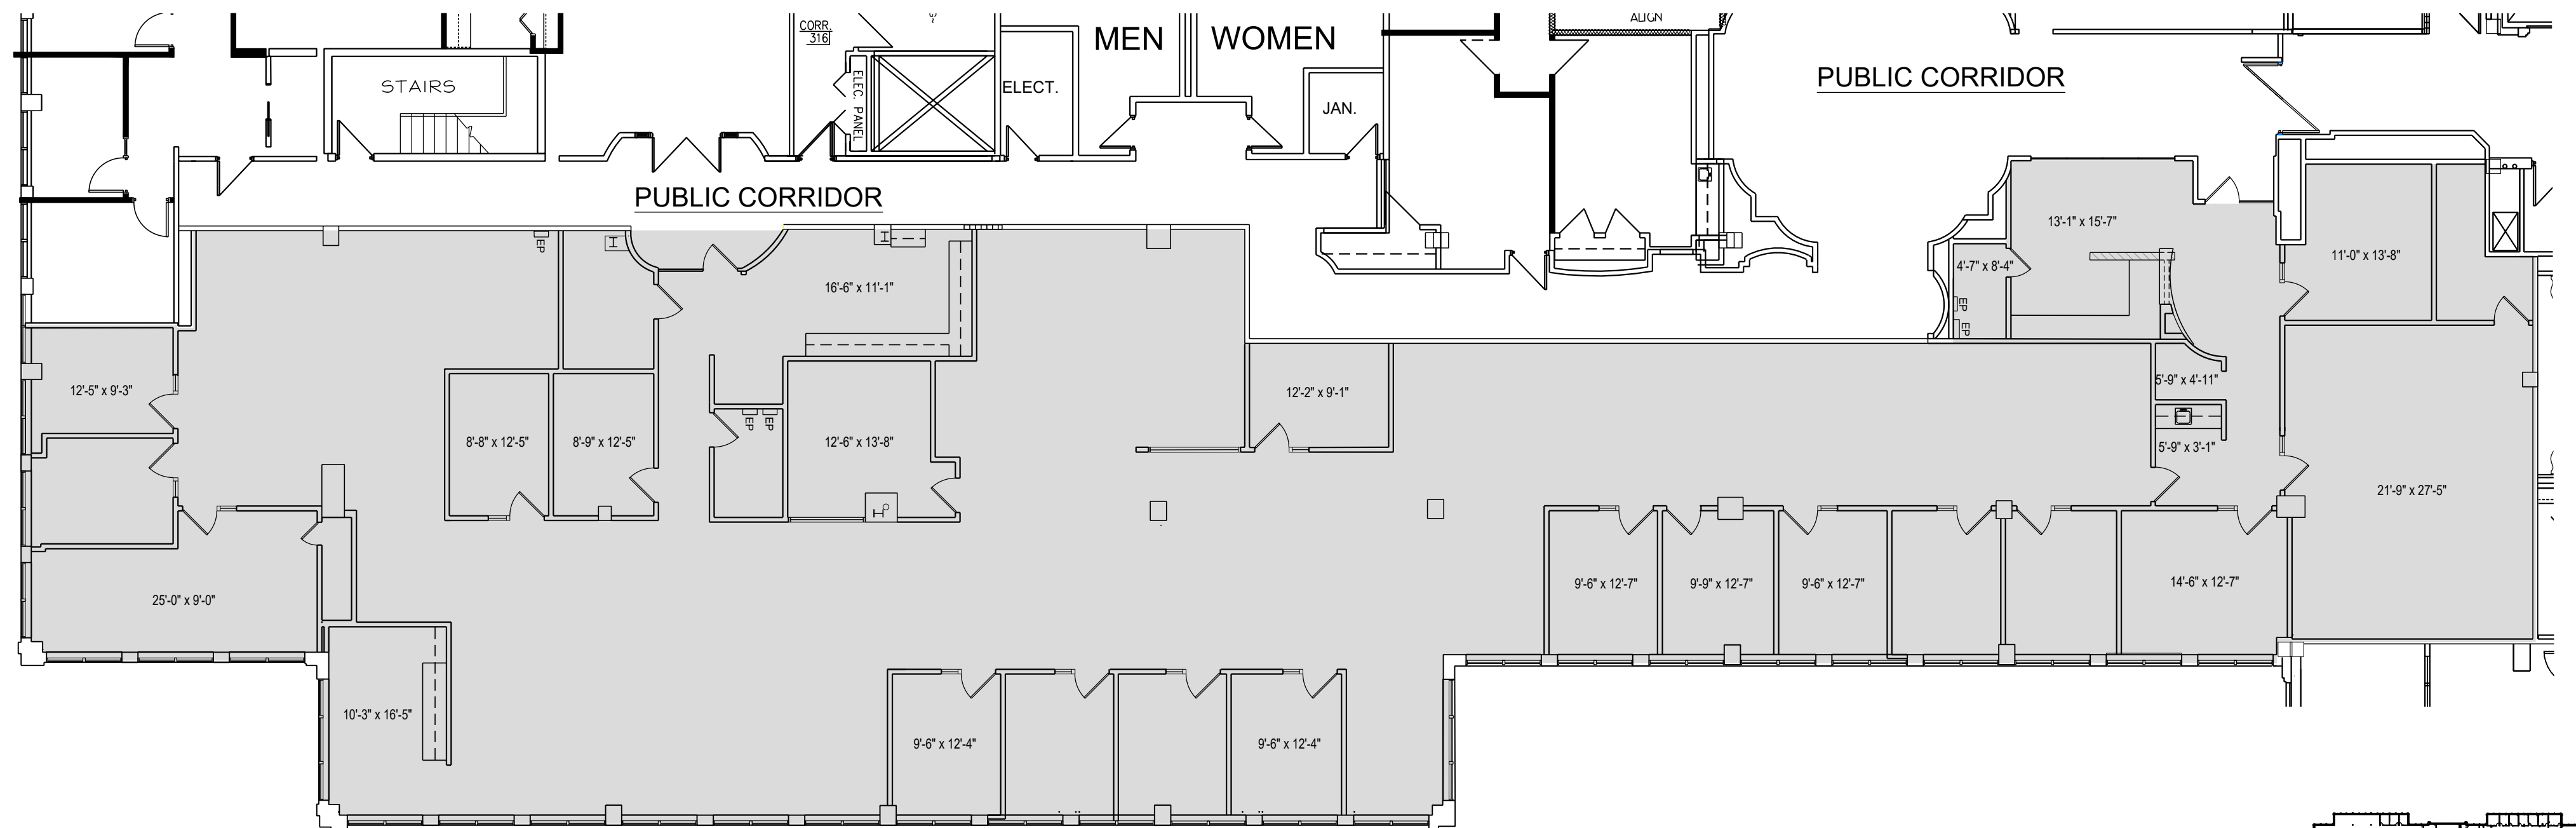

10,363 RSF

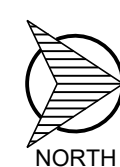

LONG LAKE CROSSING
1301 W. LONG LAKE RD. - SUITE 360
 8-17-26 SCALE: 3/32" = 1'-0"

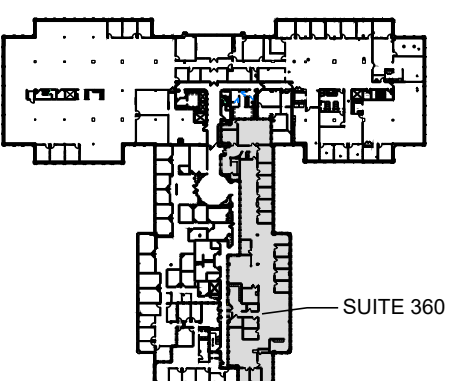