


# Property Key

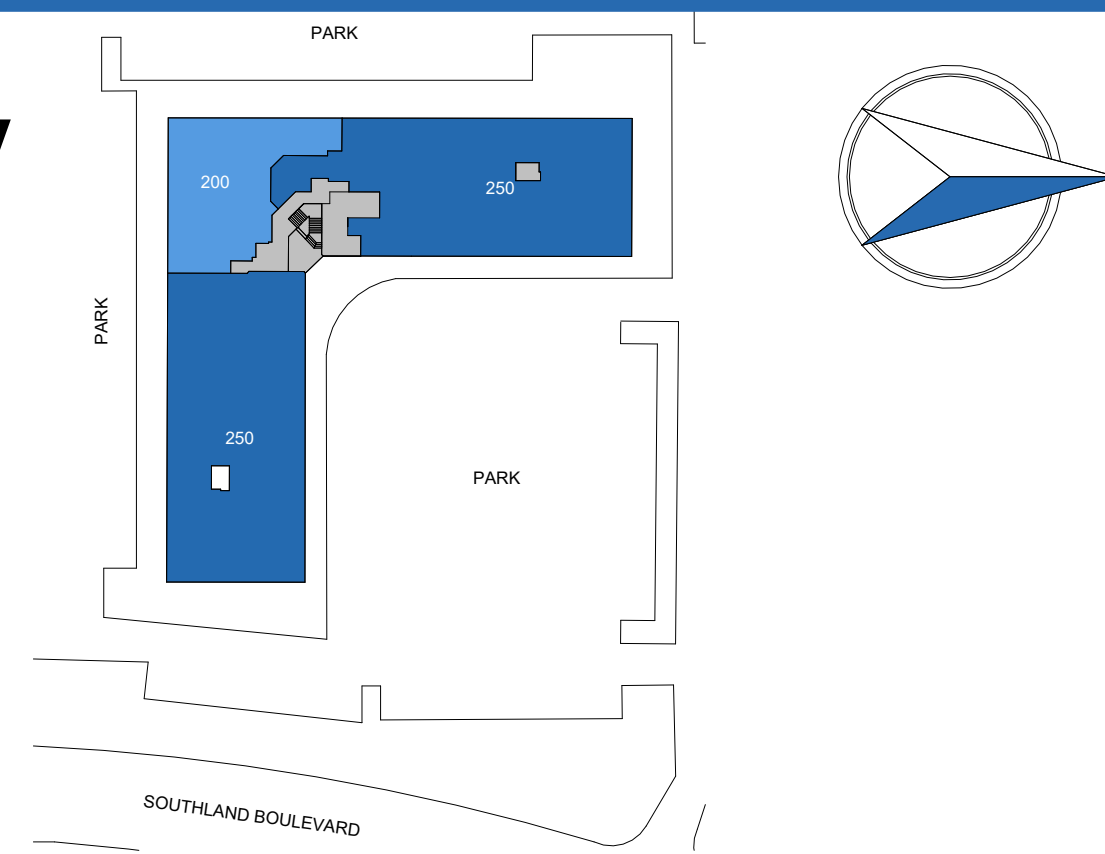

# Southland As Built Marketing Package


7700 Southland Blvd, Orlando, FL 32809, US

Building: 7700

Suite: 250 Floor 2

Sheet **E1**

Scale: Not to Scale  
Sheet Size: 42" x 30"  
Not For Construction


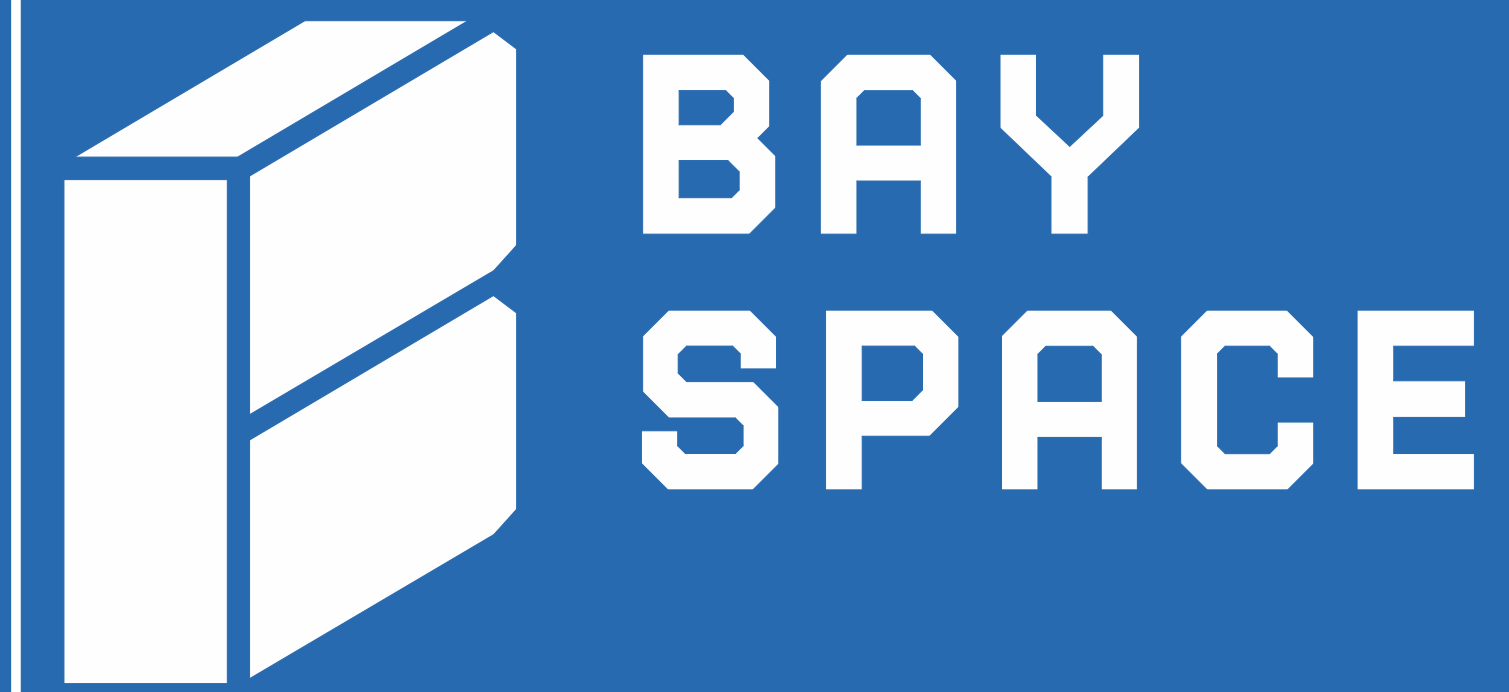


## Usable Square Foot Analysis

Office Area	18,379	100 %
Warehouse Area	0	0%
Total Area	18,379	

## Building Information

Deck Height:	N/A	
Clear Height:	8' - 4"	
Ceiling Height:	8' - 4"	
Sprinklered:	<input type="checkbox"/> Yes	<input checked="" type="checkbox"/> No
Mechanical Area:	158 SQFT	

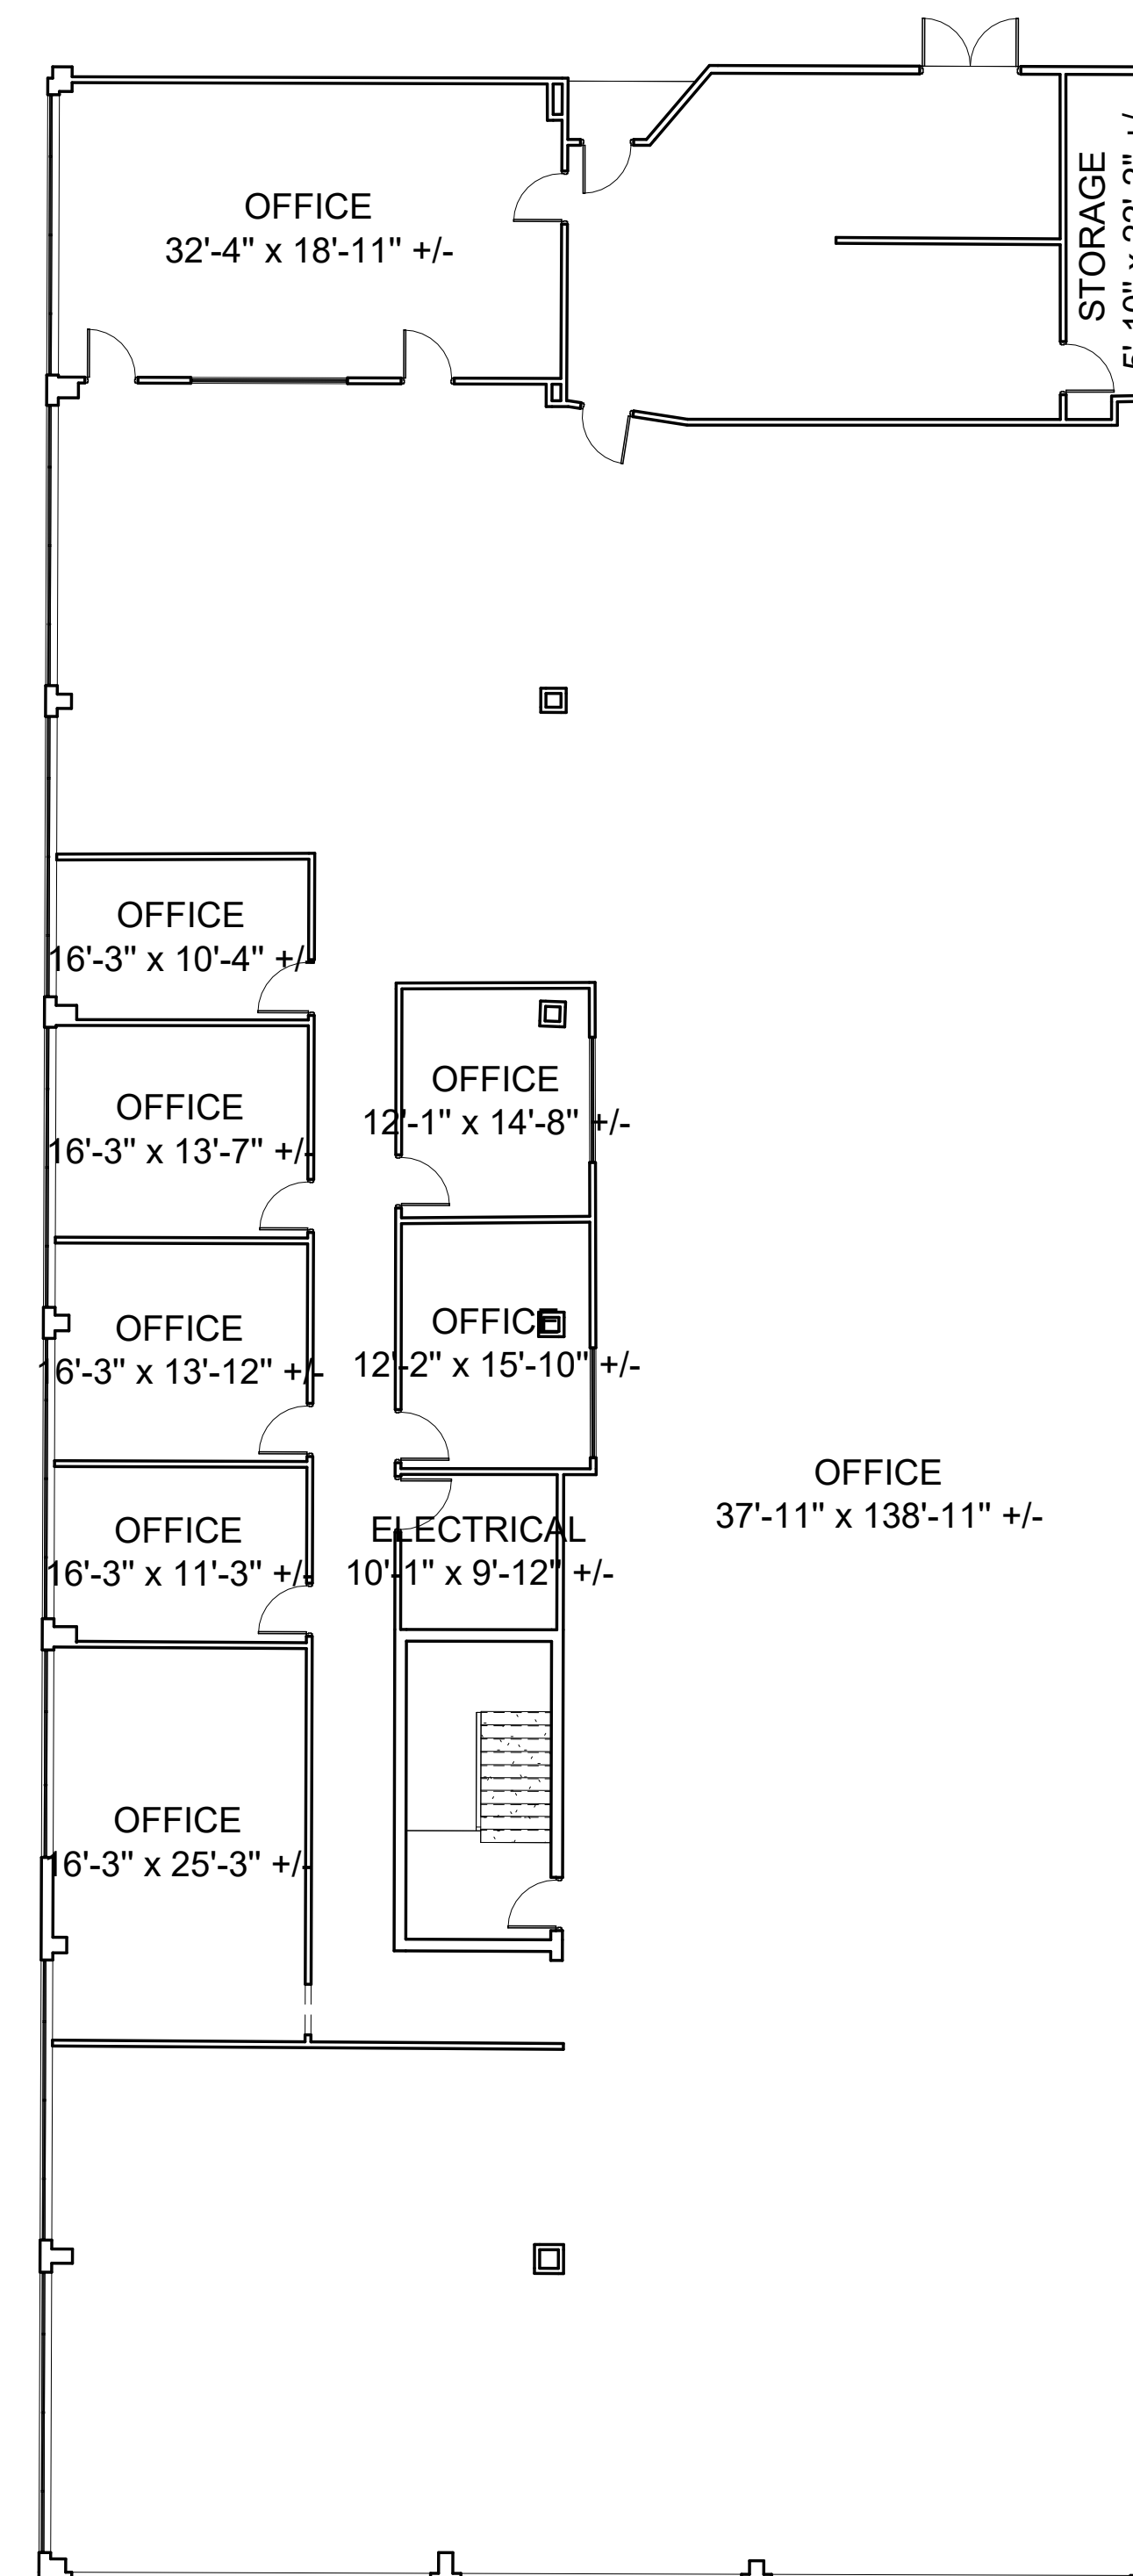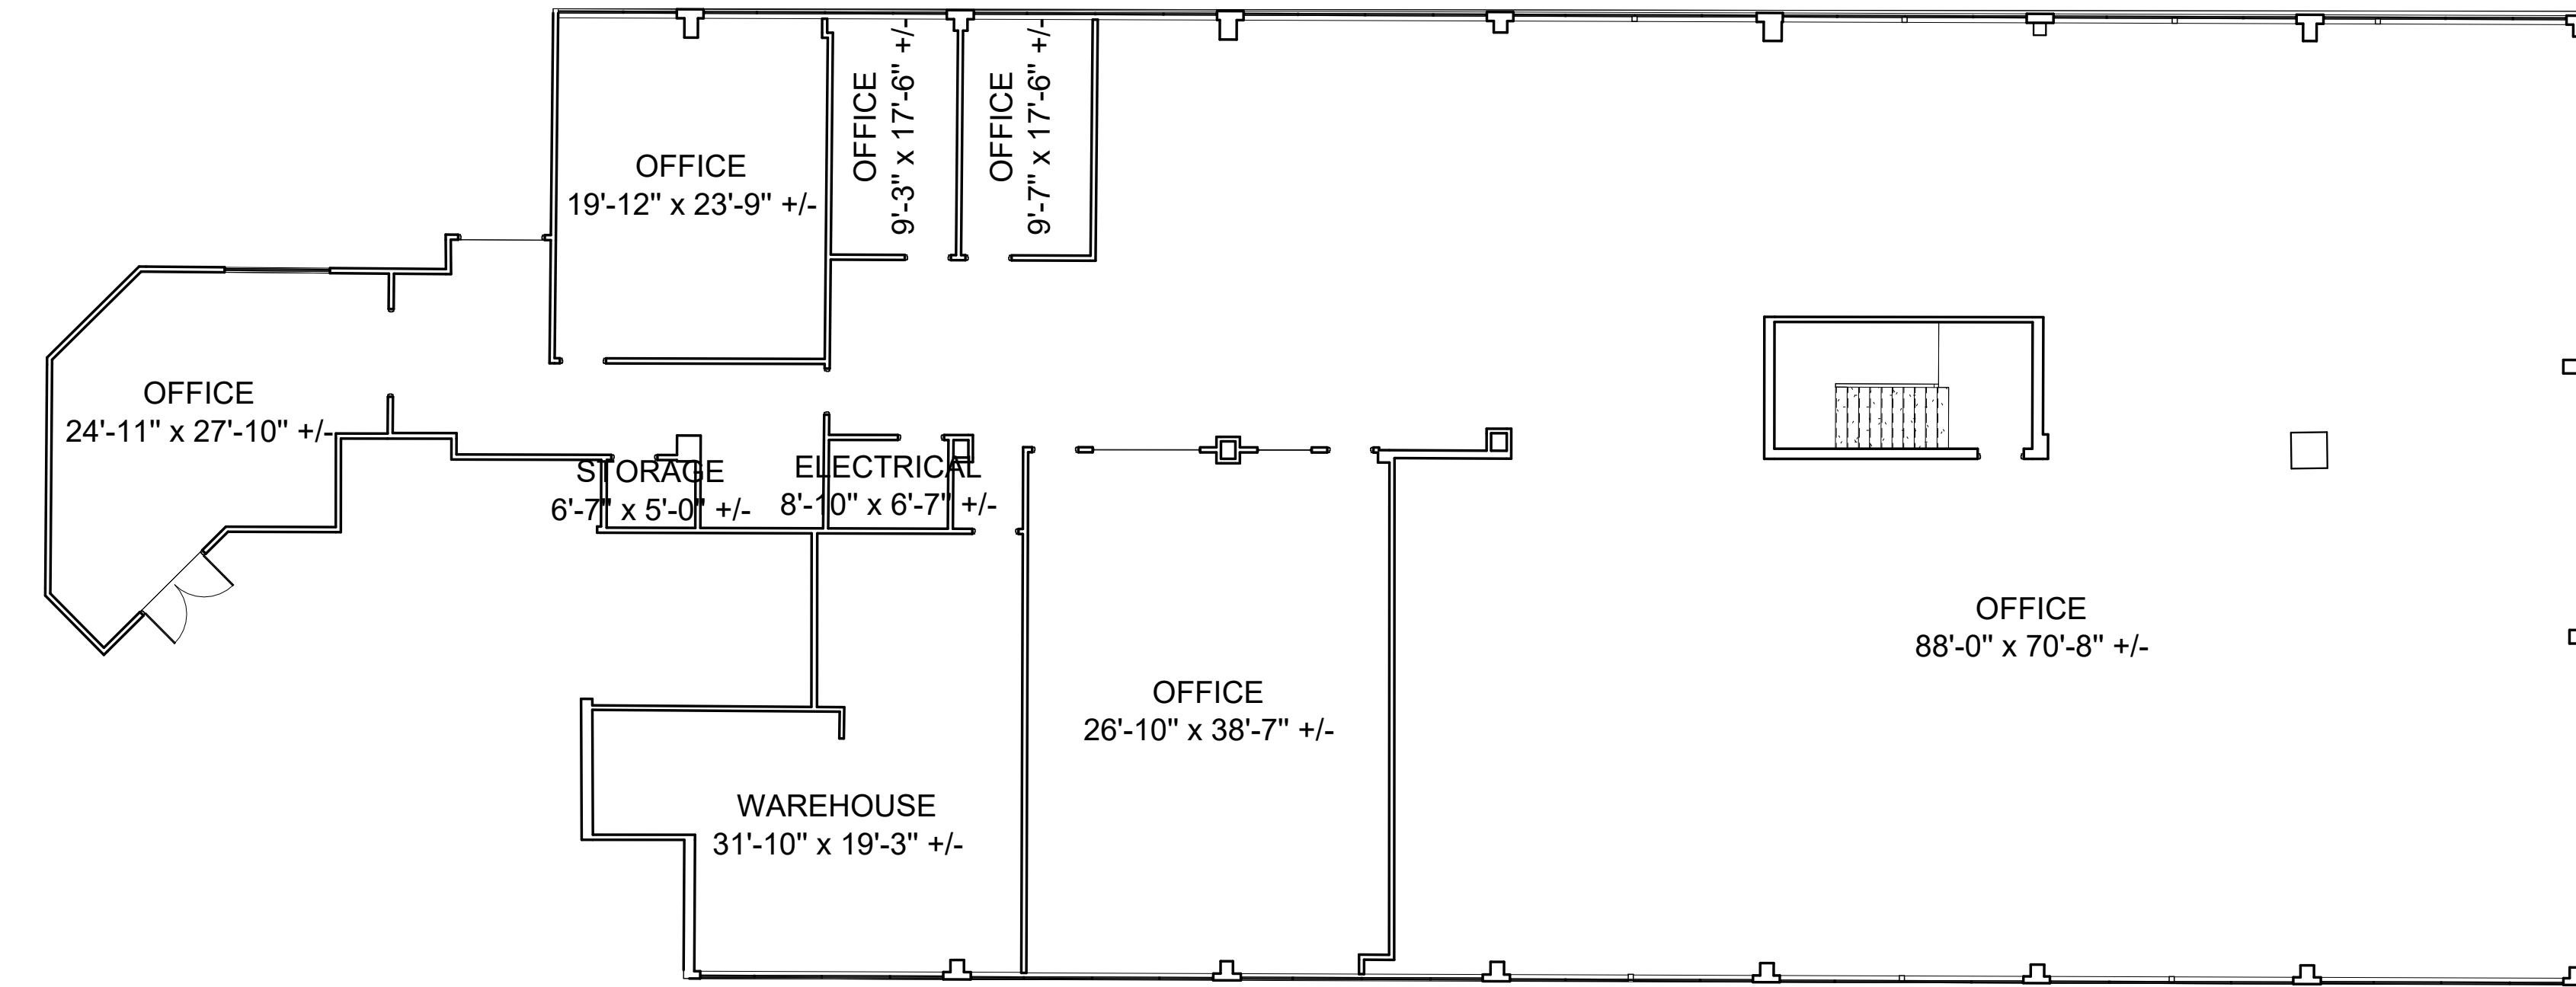

② 2nd Floor -250  
1: 130

As Built Floor Plan for Marketing

