


SPACE AVAILABLE

SUITE 220: 1,615 SF

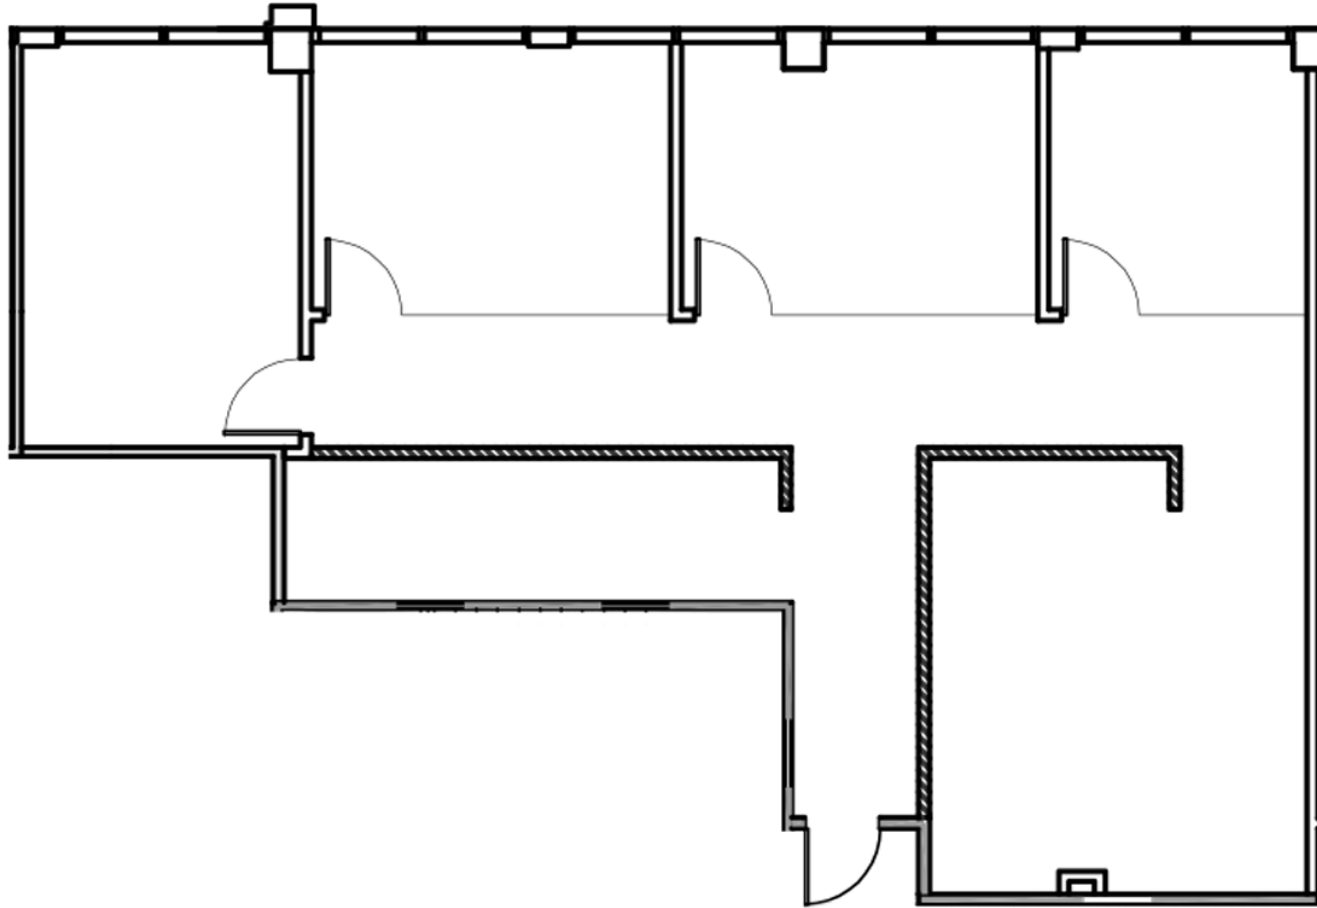

**ANCHOR PLAZA**  
4343 Anchor Plaza Parkway  
Tampa, FL 33634

No warranty or representation, expressed or implied, is made to the accuracy of information contained herein, and same is submitted subject to errors, change of price, rental or other conditions, withdrawal without notice, and to any special listing conditions imposed by our principals. PLANS NOT TO SCALE

**BRAD MAYES**  
813.793.8642  
Brad.Mayes@FranklinSt.com

**MATT ALEXANDER**  
813.559.2006  
Matthew.Alexander@FranklinSt.com

 **FranklinStreet**  
Licensed Real Estate Broker | FranklinSt.com