


SPACE AVAILABLE

SUITE 215: 2,635 SF

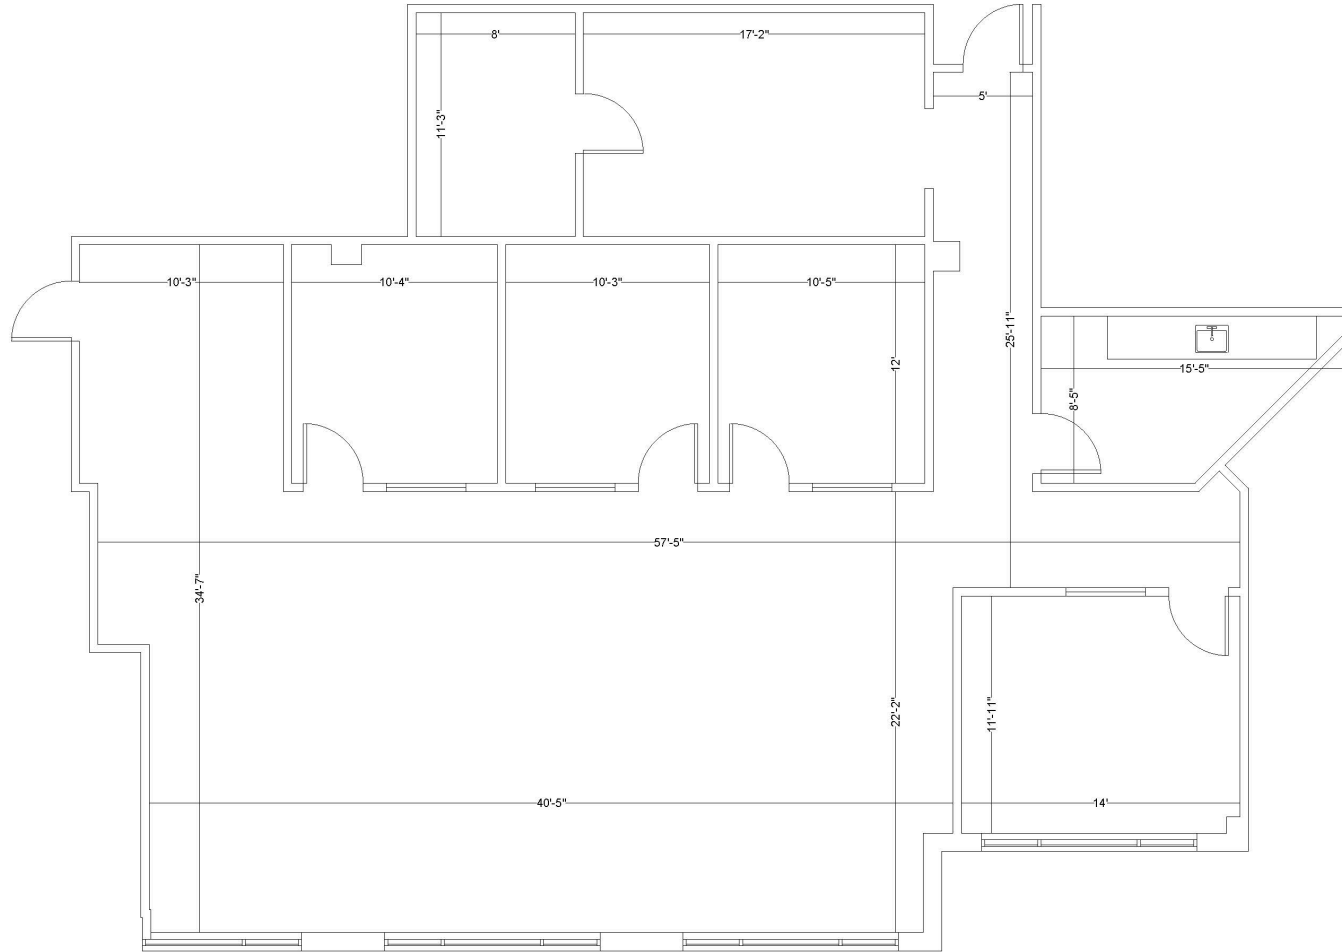

380 PARK PLACE BOULEVARD
Clearwater, FL 33759

No warranty or representation, expressed or implied, is made to the accuracy of information contained herein, and same is submitted subject to errors, change of price, rental or other conditions, withdrawal without notice, and to any special listing conditions imposed by our principals. PLANS NOT TO SCALE

MATT ALEXANDER
813.559.2006
Mathew.Alexander@FranklinSt.com

NICK POLO
813.682.6194
Nick.Polo@FranklinSt.com

CHAD RUPP
813.345.5891
Chad.Rupp@FranklinSt.com

FranklinStreet
Licensed Real Estate Broker | FranklinSt.com