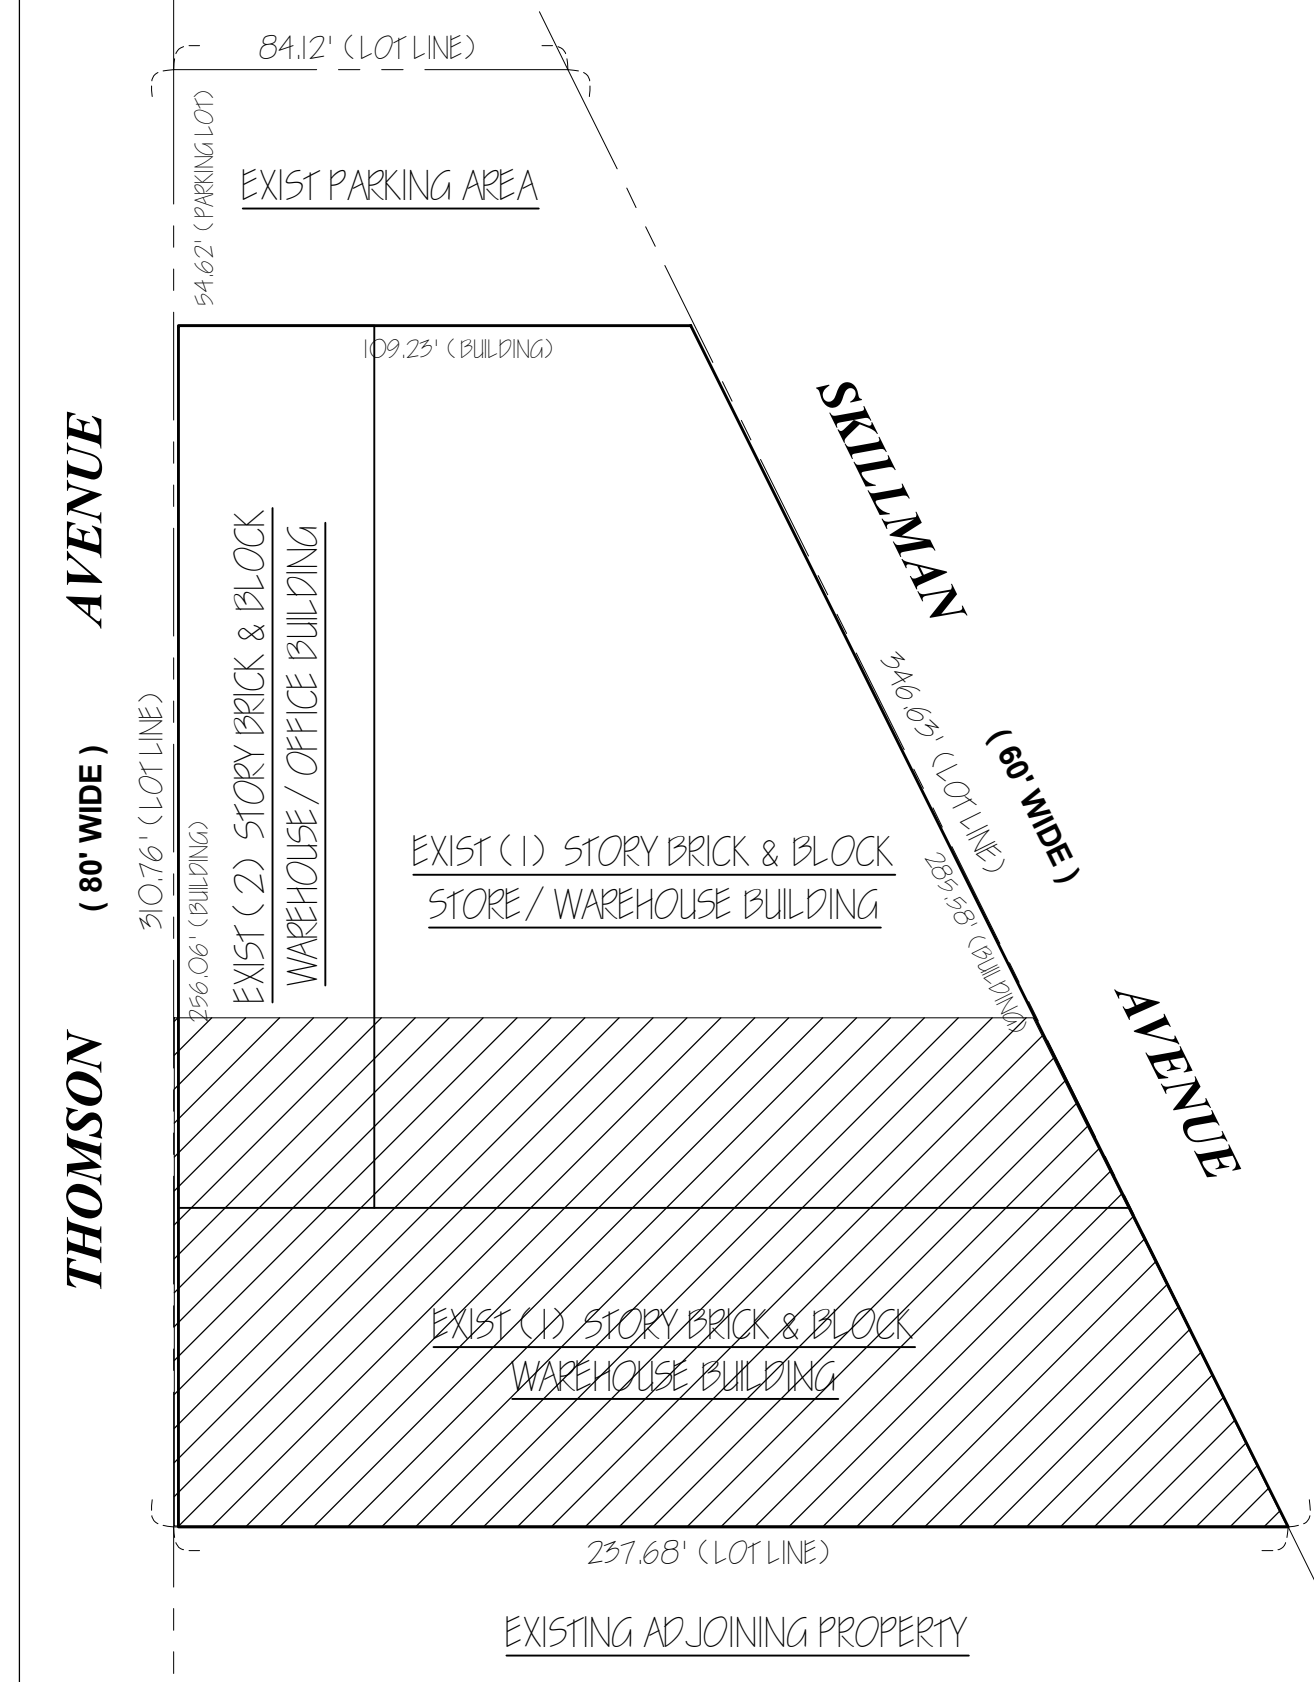
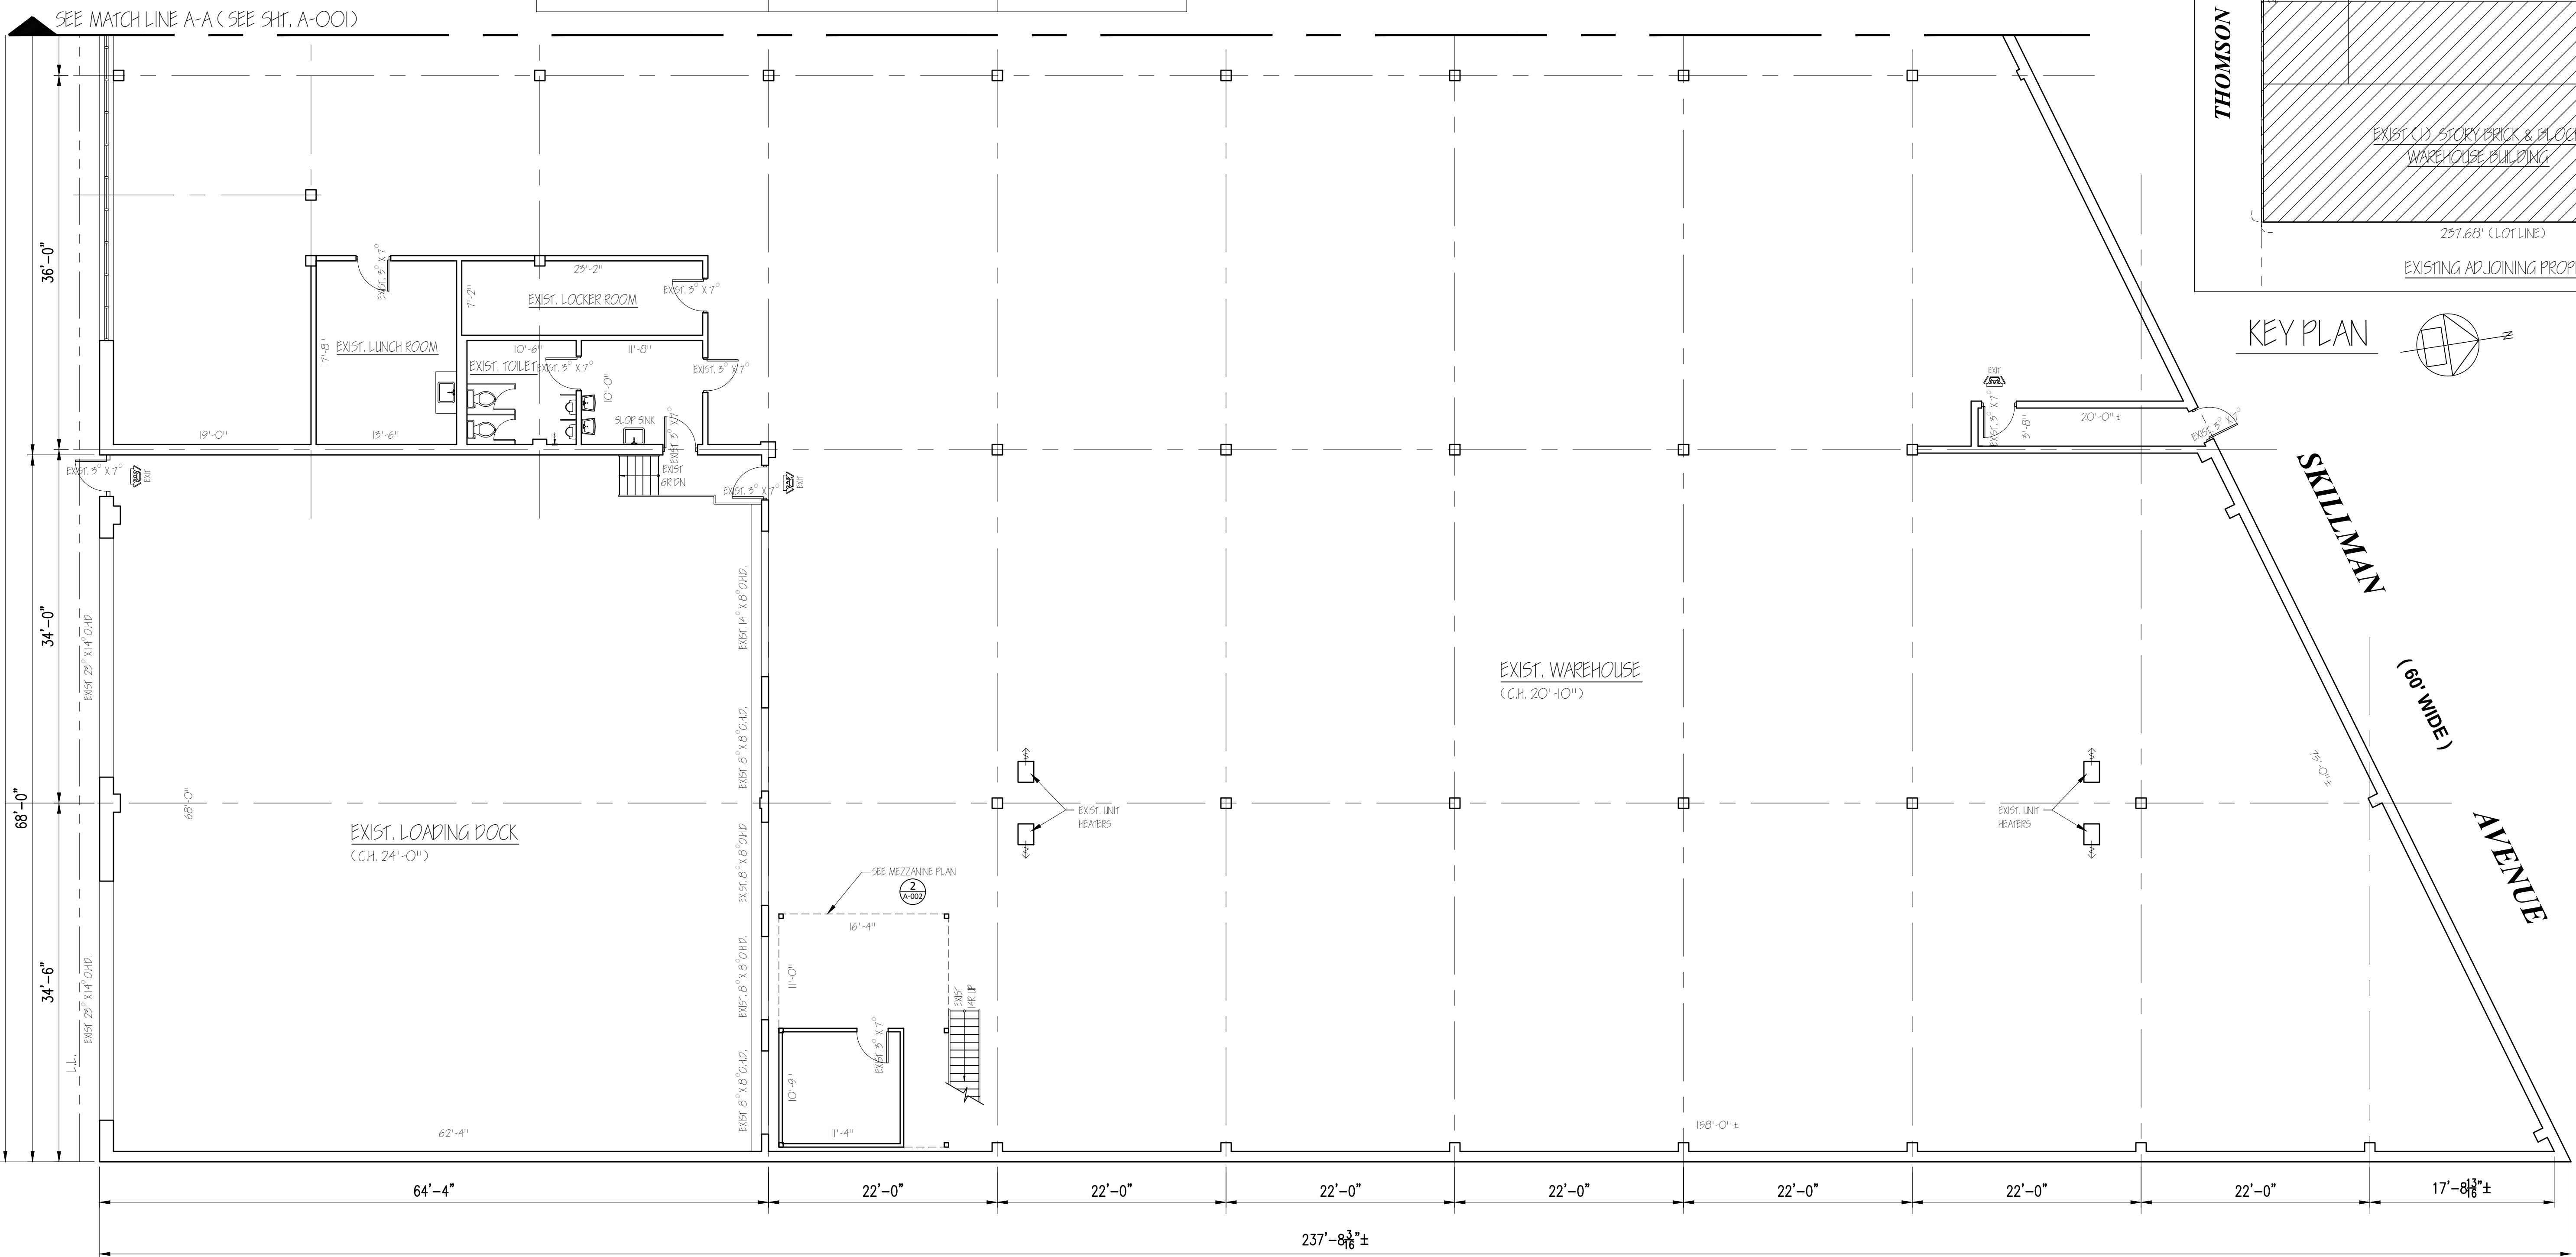


**2** EXIST. MEZANNINE PLAN  
**A-002** SCALE 1/8" = 1'-0"  

KEY PLAN  

**1** EXIST. PART 1ST FLOOR AS-BUILT PLAN  
**A-002** SCALE 1/8" = 1'-0"  
