


TOTAL SF AVAILABLE -3,450 SF


OFFICE - 0,000 SF

WAREHOUSE SF - 3,450 SF

[Click to access CADD file](#)

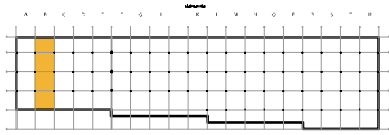

Key Plan

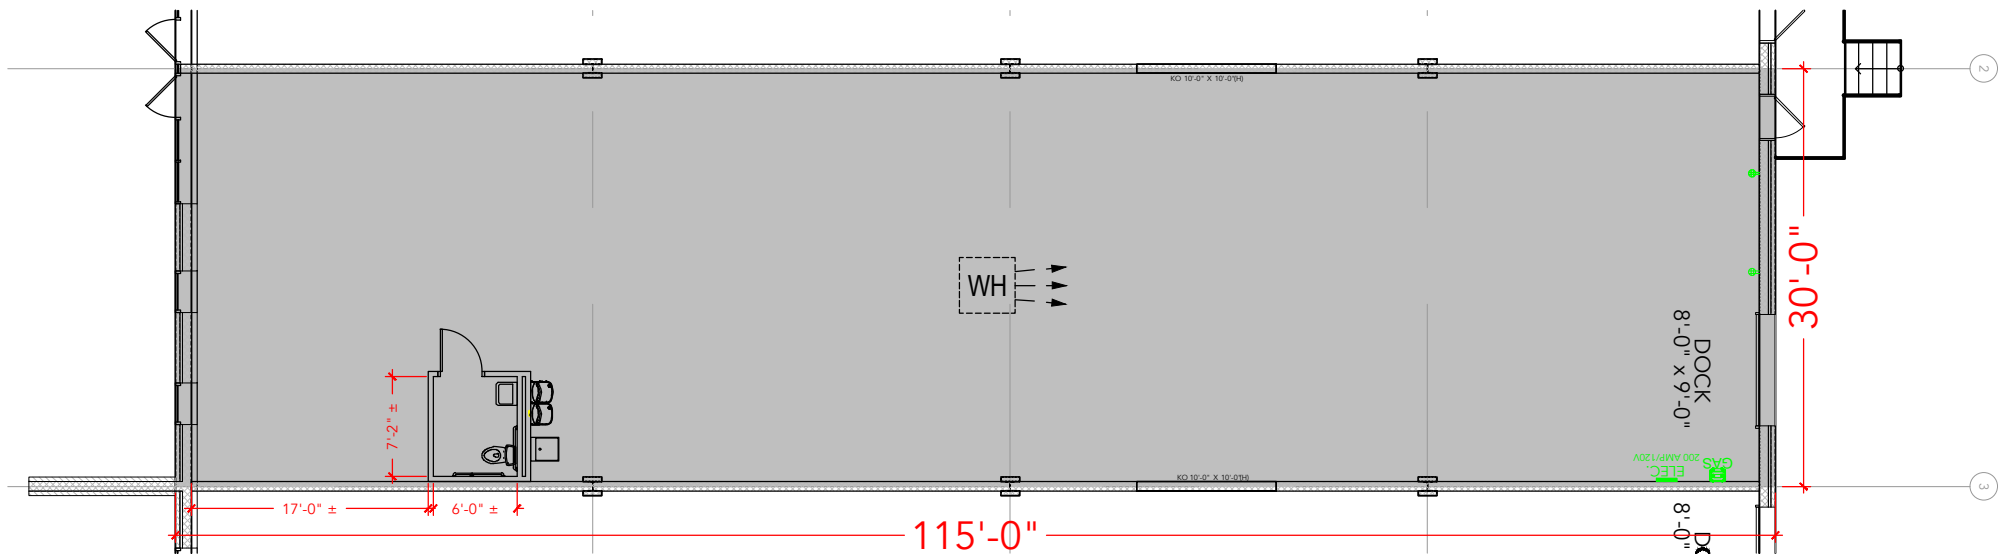

Floor Plan