


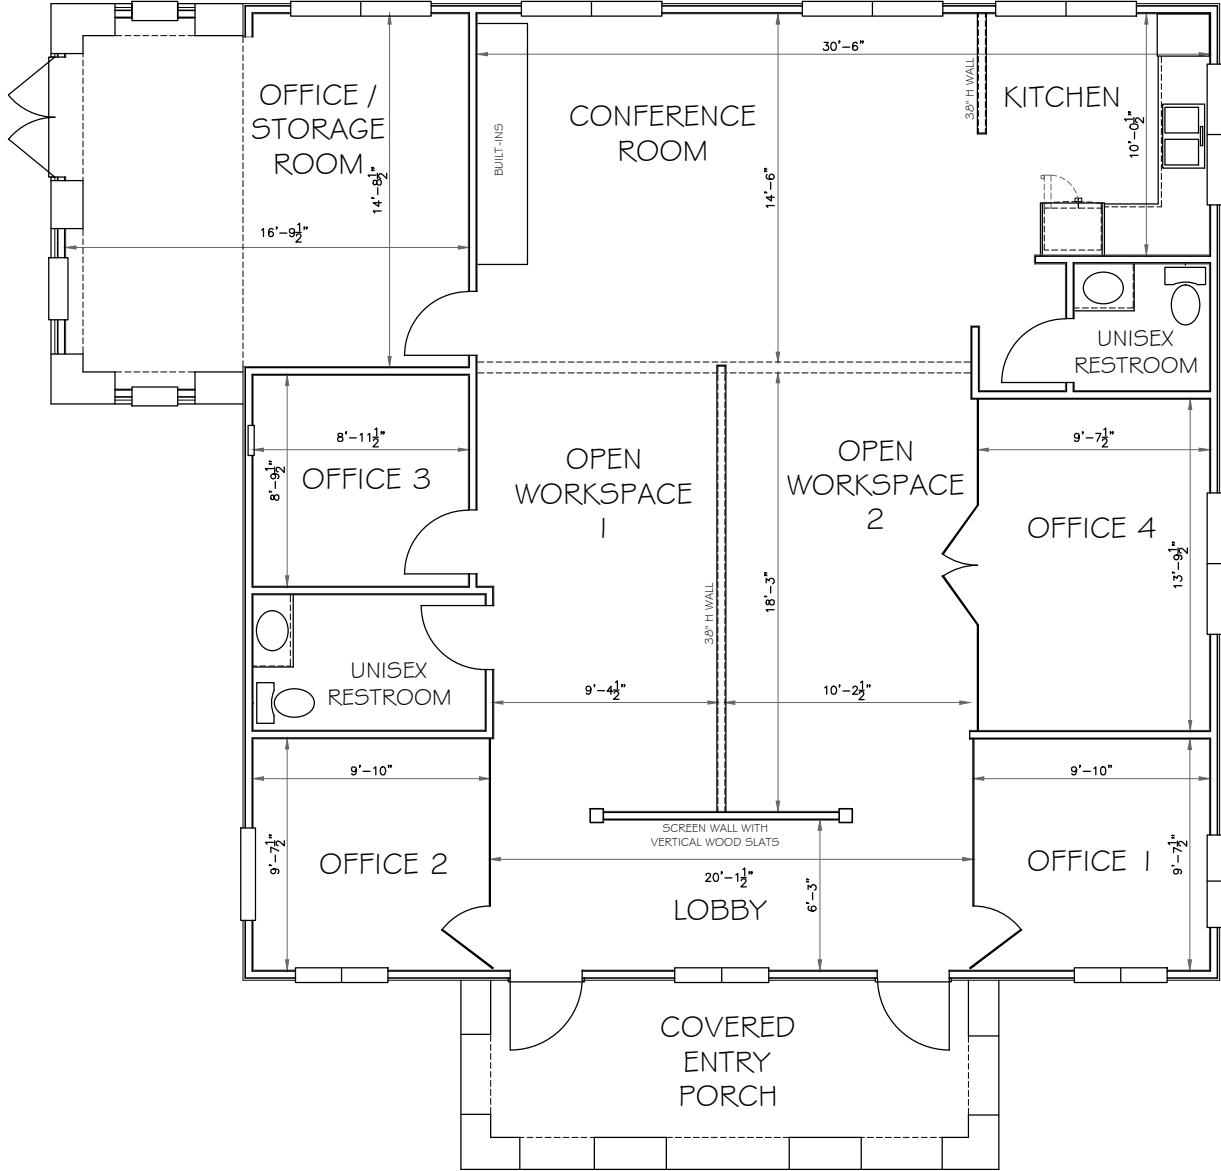


AS-BUILT FLOOR PLAN

SCALE: 1/8" = 1'-0" When Printed on 11X17 Paper

LEASE SPACE - 1791 SQFT
COV. ENTRY PORCH - 177 SQFT

Center Lake Business Park
Building 300
Dripping Springs, TX

Jeff Overman CPRD
11512 Trinity Hill Drive
Austin, Texas 78753
(512) 472-0975

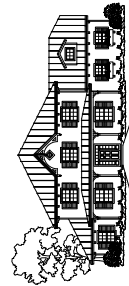

OvermanCustomDesign.Com

THIS PLAN IS NOT TO BE
REPRODUCED, COPIED,
OR MODIFIED.

CONCEPTUAL DRAWING
ONLY. NOT FOR
CONSTRUCTION.

DATE:
June 22, 2026

Review dates:
6-22-26

JOB NO.:
2606-1487-4211
© 2026 Jeffrey D. Overman
All Rights Reserved

DRWG. NO.:
A.101

JEFFREY D. OVERMAN, CPRD, #TX-452

PRELIMINARY - NOT FOR CONSTRUCTION