

FOR LEASE | 2035 CORTE DEL NOGAL, CARLSBAD CALIFORNIA 92011

CAMINO WEST

CORPORATE PARK



INTRODUCTORY
LEASE RATE!* | YEAR 1: \$1.50/RSF

CBRE

*THIS LEASE INCENTIVE IS OFFERED FOR NEW LEASES FOR SUITES 165, 200 & 250 ONLY (WITH A 3 YEAR MINIMUM TERM). EXCLUDES RENEWALS AND EXPANSIONS OF EXISTING TENANTS.

PROPERTY FEATURES



Newly Renovated
Common Areas &
Restrooms



Great Accessibility:
Less Than 5 Min. From
I-5 & Less Than 1 Mile
From El Camino



Building & Monument
Signage Available



On-Site Cafe



Brand New Spec Suites:
Ready For Immediate
Tenant Occupancy



Above Standard Parking
(4.8/1,000 USF)



Less Than 1 Mile To
Additional Retail
Amenities

 


Outdoor Collaborative
Areas

AVAILABILITIES

Lease Rate \$2.25/SF + Electricity

SUITE	SQUARE FEET	AVAILABLE
105	4,639 RSF	NOW
165*	2,597 RSF	NOW
200*	14,489 RSF (Divisible to 11,591 SF)	NOW
250*	5,861 RSF	NOW
275	4,648 RSF	NOW
250/275	10,509 RSF	NOW
280	961 RSF	NOW





**INTRODUCTORY LEASE RATE:
\$1.50/RSF + E IN YEAR 1***

(*\$2.25/RSF IN YEAR 2, \$2.35/RSF IN
YEAR 3 WITH 3% BUMPS THEREAFTER.
3 YEAR MINIMUM TERM.)

NEW PROPERTY UPGRADES

MODERN UPGRADES, COMMON AREAS, RESTROOMS & SHOWERS, OUTDOOR LOUNGE AREA

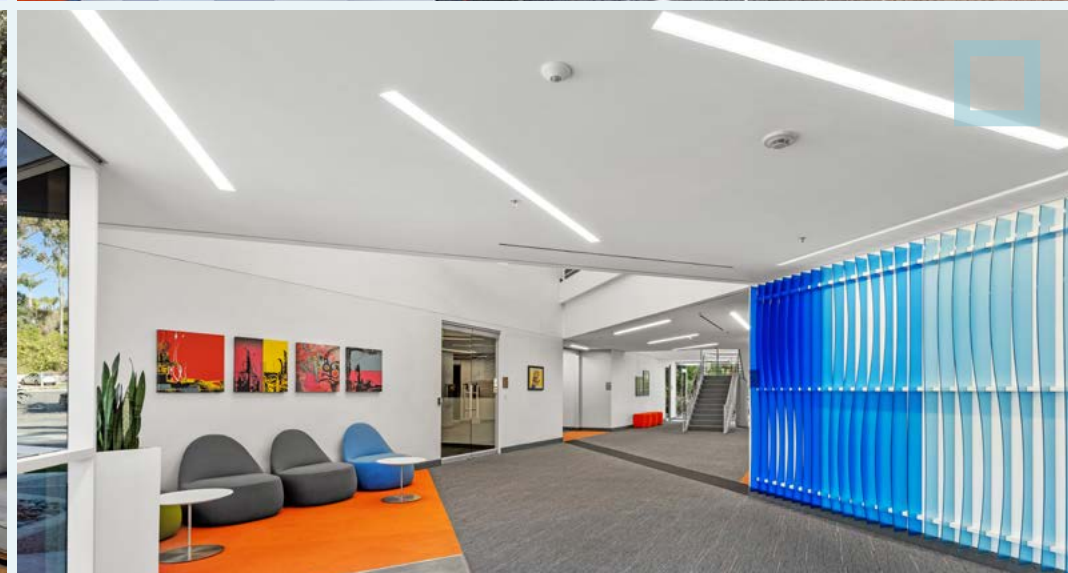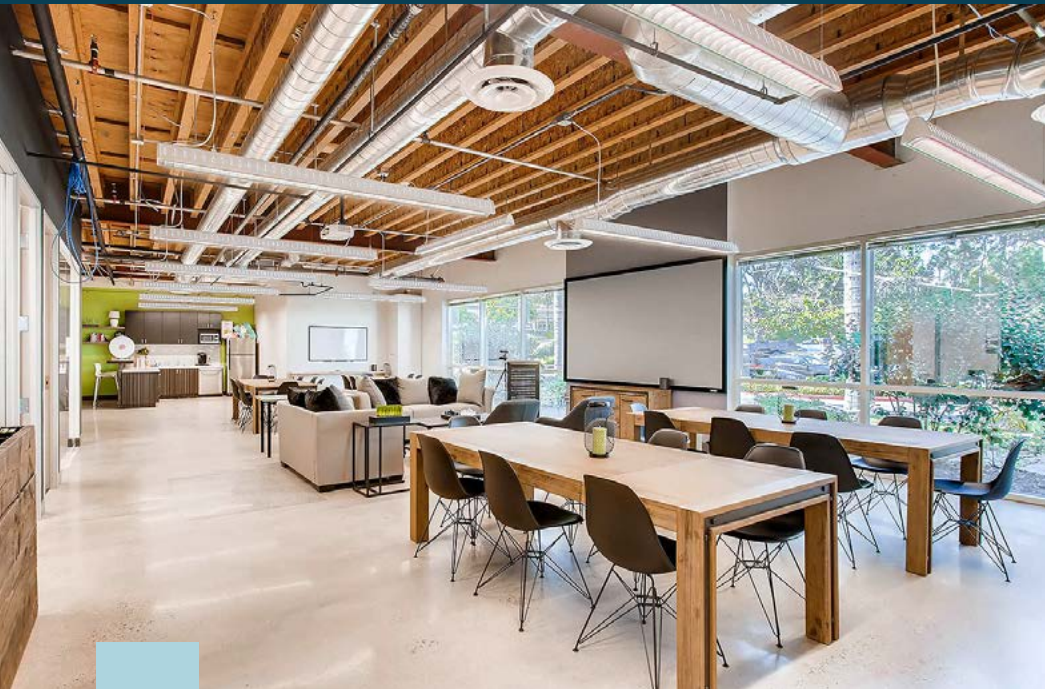

FLOOR PLANS





SUITE 105

AS-BUILT PLAN

RENTABLE SF	4,639 RSF
AVAILABILITY	NOW
SUITE DETAILS	• RECEPTION AREA
	• 4 PRIVATE OFFICES
	• STORAGE
	• SERVER ROOM
	• KITCHEN
	• LARGE OPEN OFFICE AREA



FIRST FLOOR

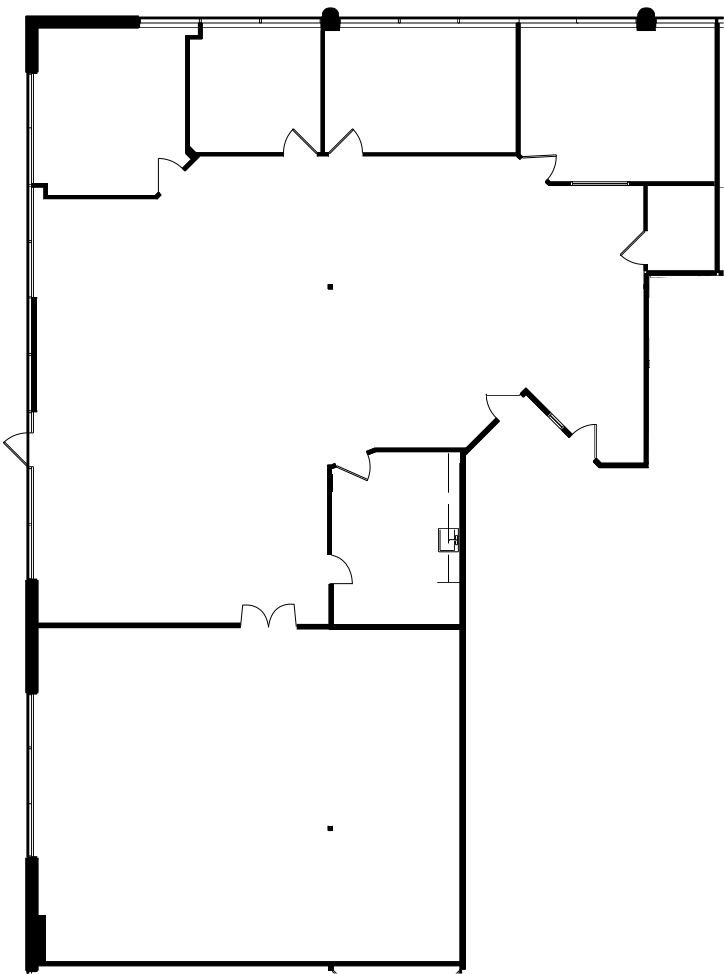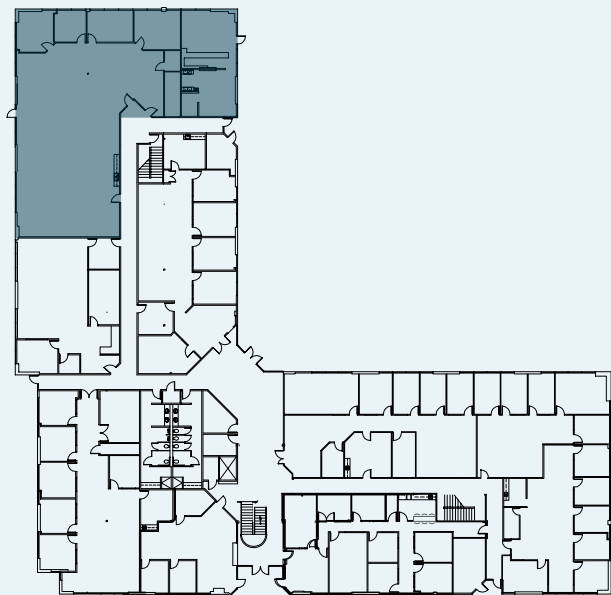

FLOOR PLANS




SUITE 165


AS-BUILT PLAN

RENTABLE SF	2,597 RSF
AVAILABILITY	NOW
SUITE DETAILS	• RECEPTION AREA
	• 7 PRIVATE OFFICES
	• 2 LARGE CONFERENCE ROOMS
	• SERVER ROOM
	• KITCHEN


AS-BUILT PLAN

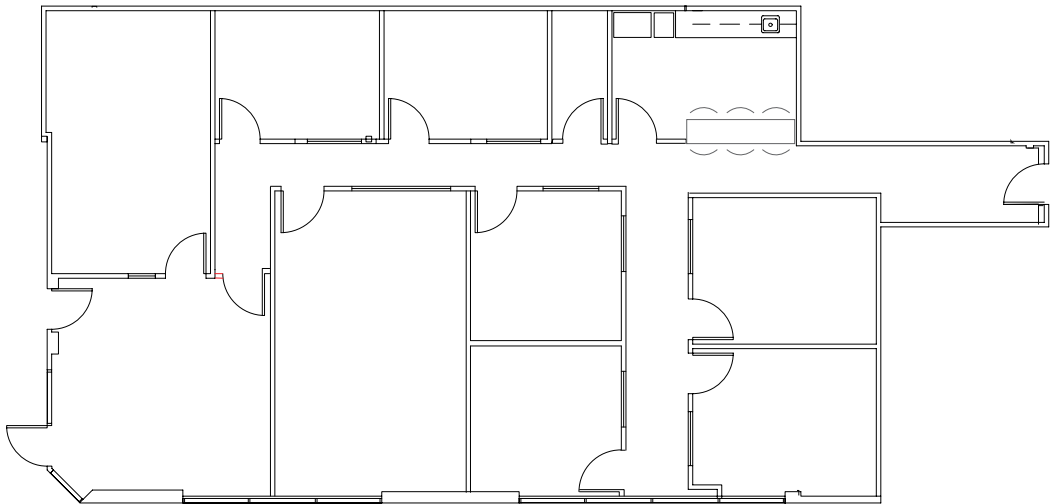

FIRST FLOOR

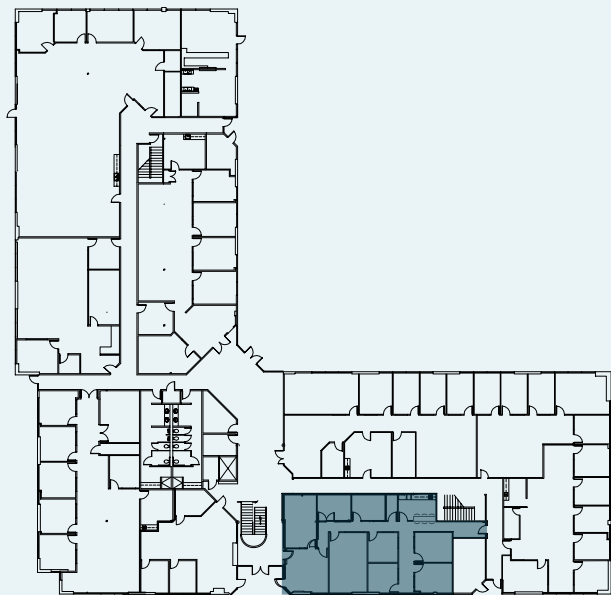

CONCEPTUAL PLAN

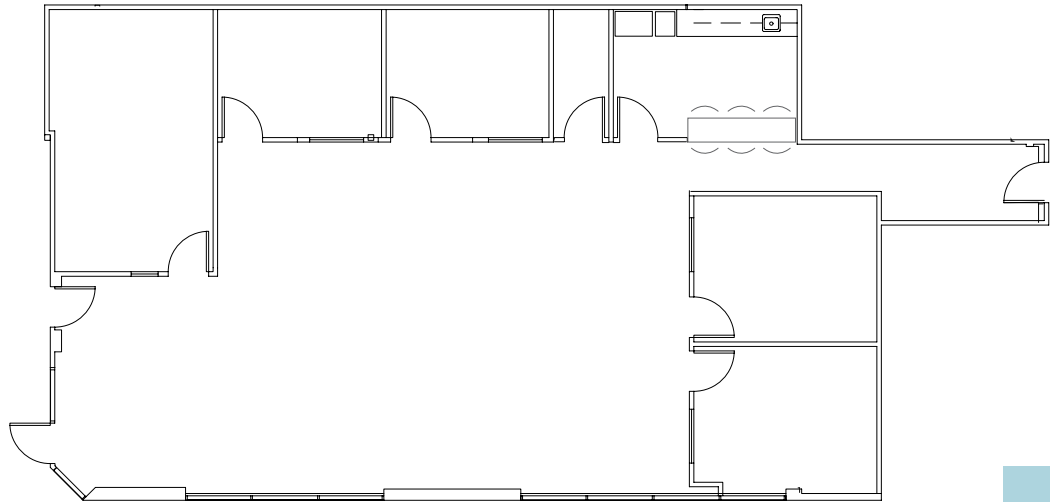

FLOOR PLANS





SUITE 200

AS-BUILT PLAN

RENTABLE SF	14,489 RSF (DIVISIBLE TO 11,591 SF)
AVAILABILITY	NOW
SUITE DETAILS	• RECEPTION AREA • 3 CONFERENCE ROOMS • 19 PRIVATE OFFICES • 1 SERVER ROOM • 3 STORAGE ROOMS • LARGE KITCHEN • OPEN OFFICE AREA

SECOND FLOOR

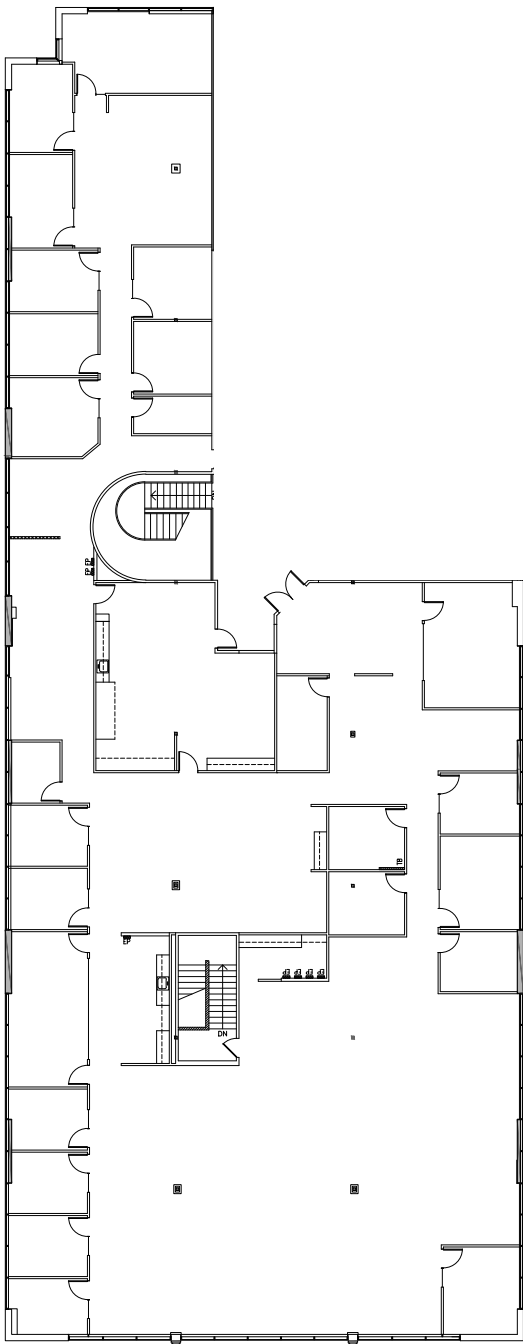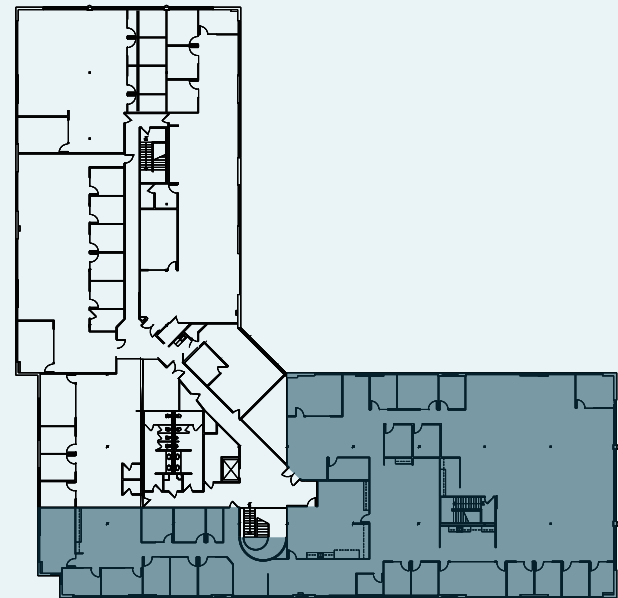

FLOOR PLANS





SUITE 250

AS-BUILT PLAN

RENTABLE SF	5,861 RSF
AVAILABILITY	NOW
SUITE DETAILS	• RECEPTION AREA • CONFERENCE ROOMS • PRIVATE OFFICES • OPEN OFFICE AREA



SECOND FLOOR

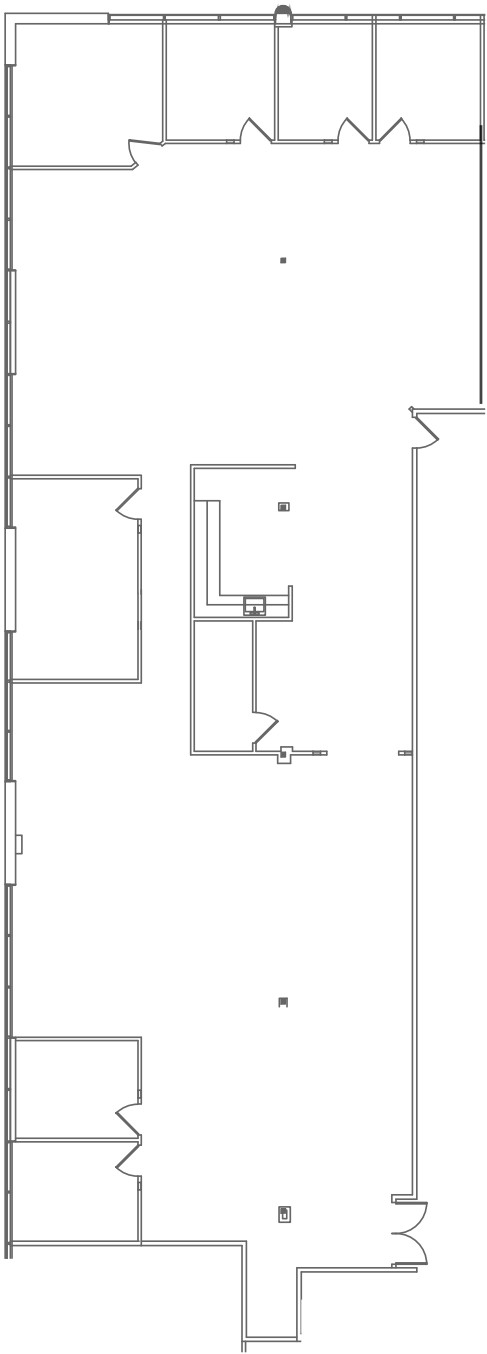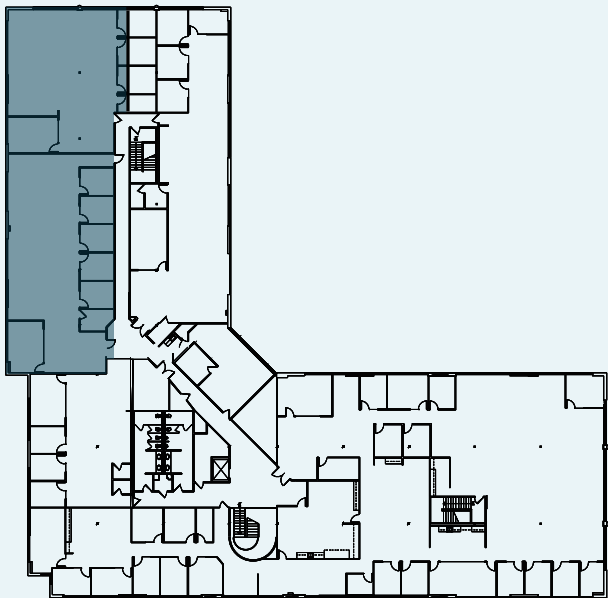

FLOOR PLANS





SUITE 275

AS-BUILT PLAN

RENTABLE SF	4,648 RSF
AVAILABILITY	NOW
SUITE DETAILS	• RECEPTION AREA
	• CONFERENCE ROOMS
	• PRIVATE OFFICES
	• OPEN OFFICE AREA

SECOND FLOOR

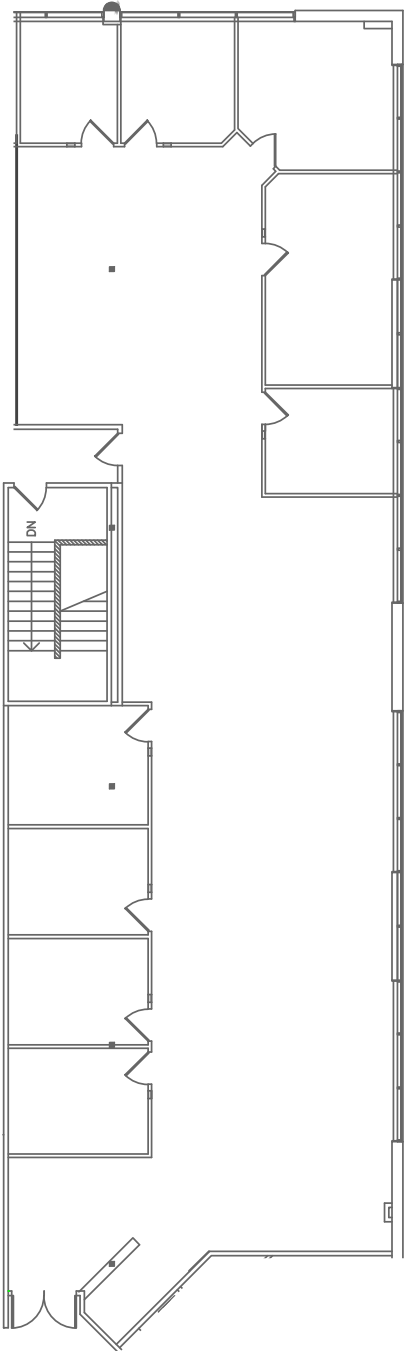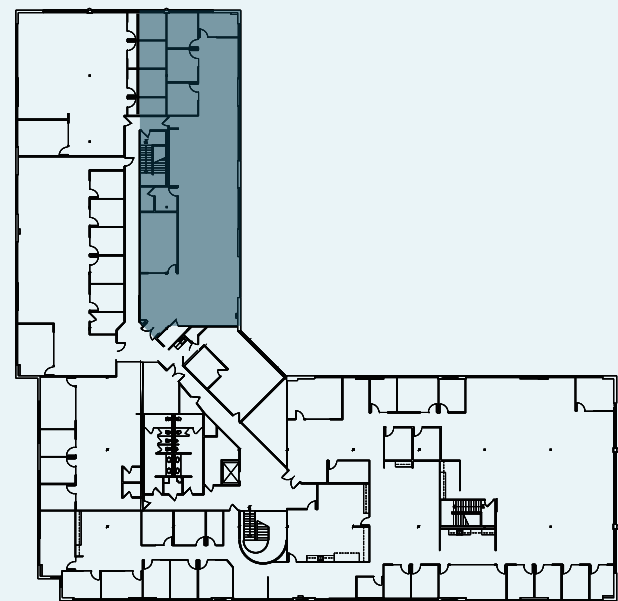



FLOOR PLANS



SUITE 250/275
CONTIGUOUS PLAN

RENTABLE SF	10,509 RSF
AVAILABILITY	NOW
SUITE DETAILS	• RECEPTION AREA
	• CONFERENCE ROOMS
	• PRIVATE OFFICES
	• OPEN OFFICE AREA

SECOND FLOOR

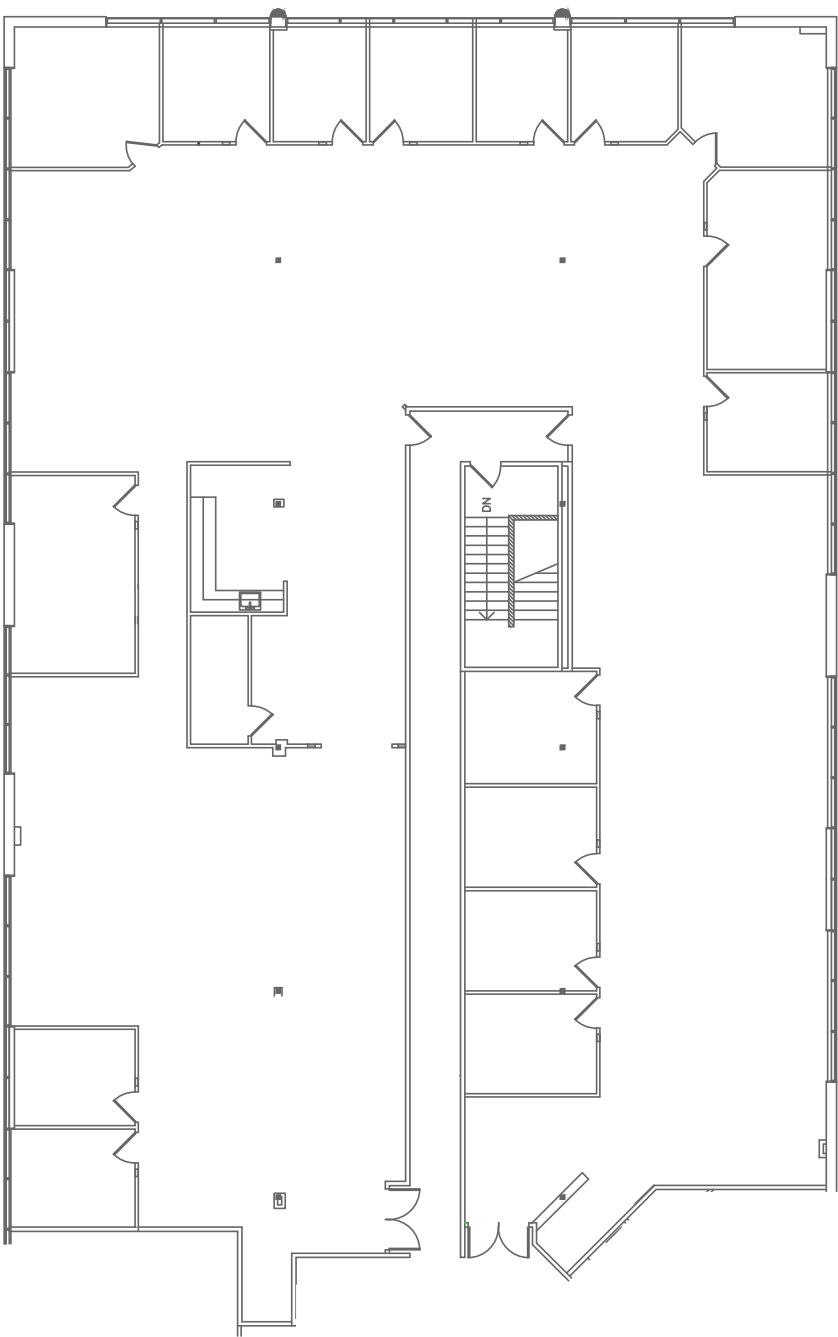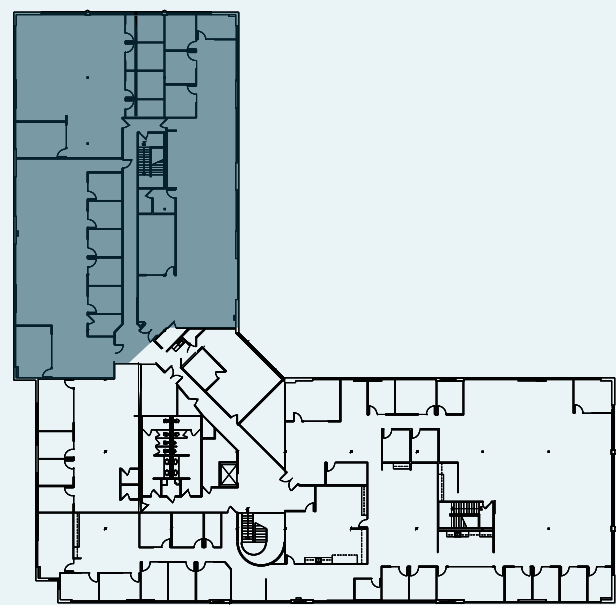

FLOOR PLANS





SUITE 280

AS-BUILT PLAN

RENTABLE SF	961 RSF
AVAILABILITY	NOW
SUITE DETAILS	• RECEPTION AREA
	• 1 PRIVATE OFFICE
	• BREAK ROOM
	• SERVER ROOM
	• OPEN OFFICE AREA



SECOND FLOOR

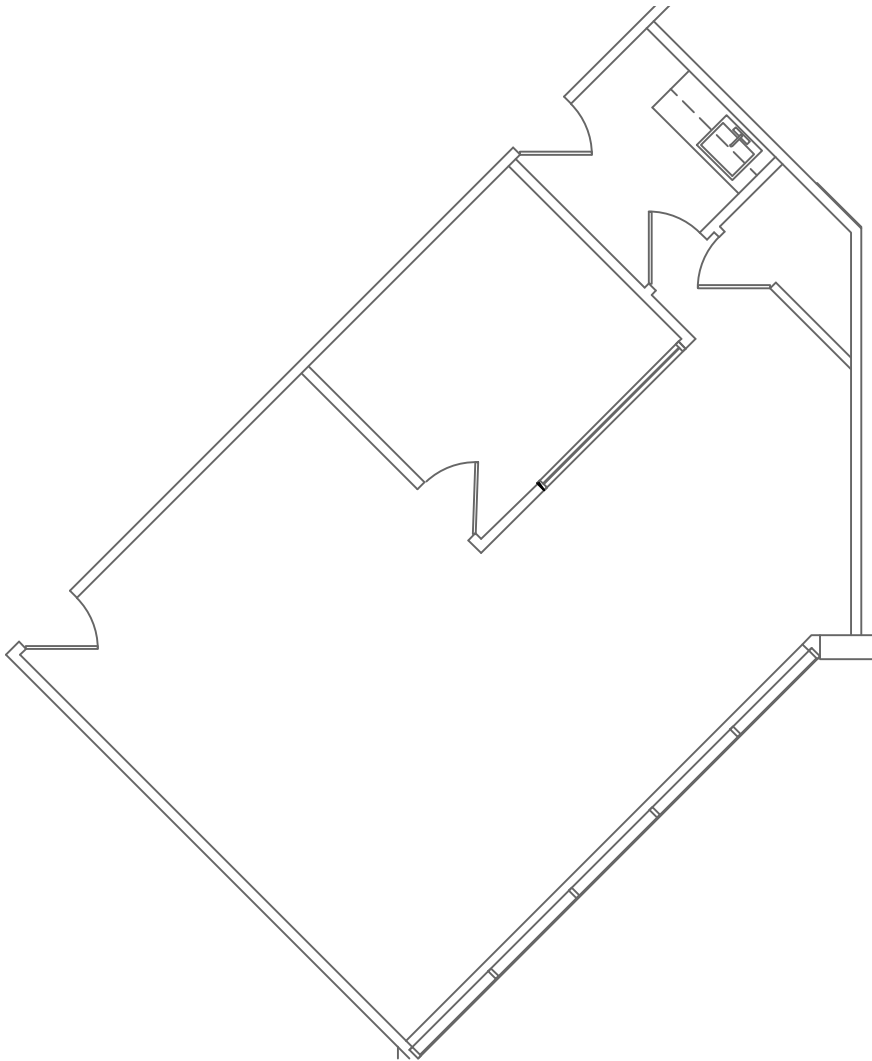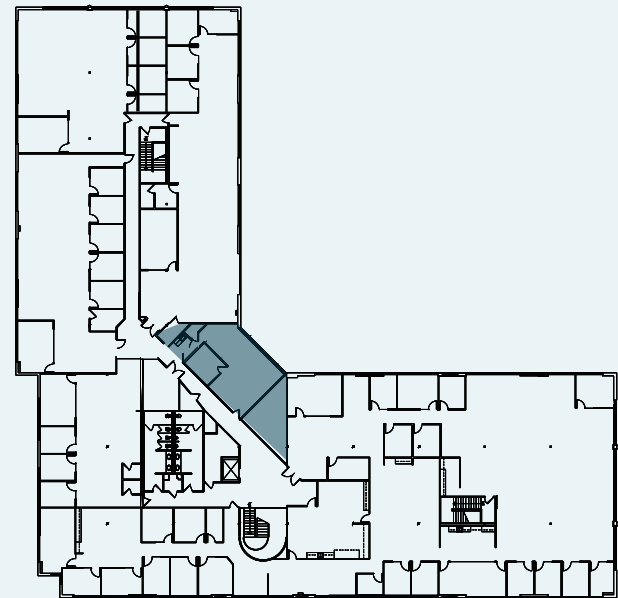



CONTACT US

MATTY SUNDBERG

Senior Vice President

+1 760 438 8518

matty.sundberg@cbre.com

Lic. 01257446

BOB COWAN

First Vice President

+1 760 438 8510

bob.cowan@cbre.com

Lic. 01838109

CAMINO WEST

CORPORATE PARK

© 2026 CBRE, Inc. All rights reserved. This information has been obtained from sources believed reliable but has not been verified for accuracy or completeness. You should conduct a careful, independent investigation of the property and verify all information. Any reliance on this information is solely at your own risk. CBRE and the CBRE logo are service marks of CBRE, Inc. All other marks displayed on this document are the property of their respective owners, and the use of such logos does not imply any affiliation with or endorsement of CBRE. Photos herein are the property of their respective owners. Use of these images without the express written consent of the owner is prohibited. CPM Camino West Corporate Park_brochure

CBRE