


Property Key




3904 Corporex Drive As Built Marketing Package
3904 Corporex Drive, Tampa, FL 33619

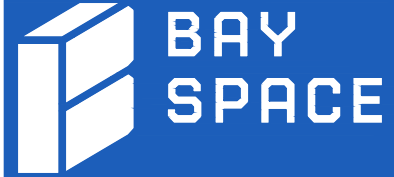

Building: 3
Suite: 350
Sheet: A-3


Scale: Not to Scale
Sheet Size: 8.5" x 11"
Not For Construction

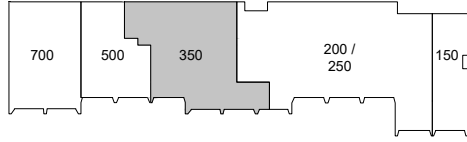

Total Area - 9,534 SF

Building Information

DECK HEIGHT:	17'-4"
CEILING HEIGHT:	8'-11"
CLEAR HEIGHT:	15'-11"
SPRINKLERED:	No

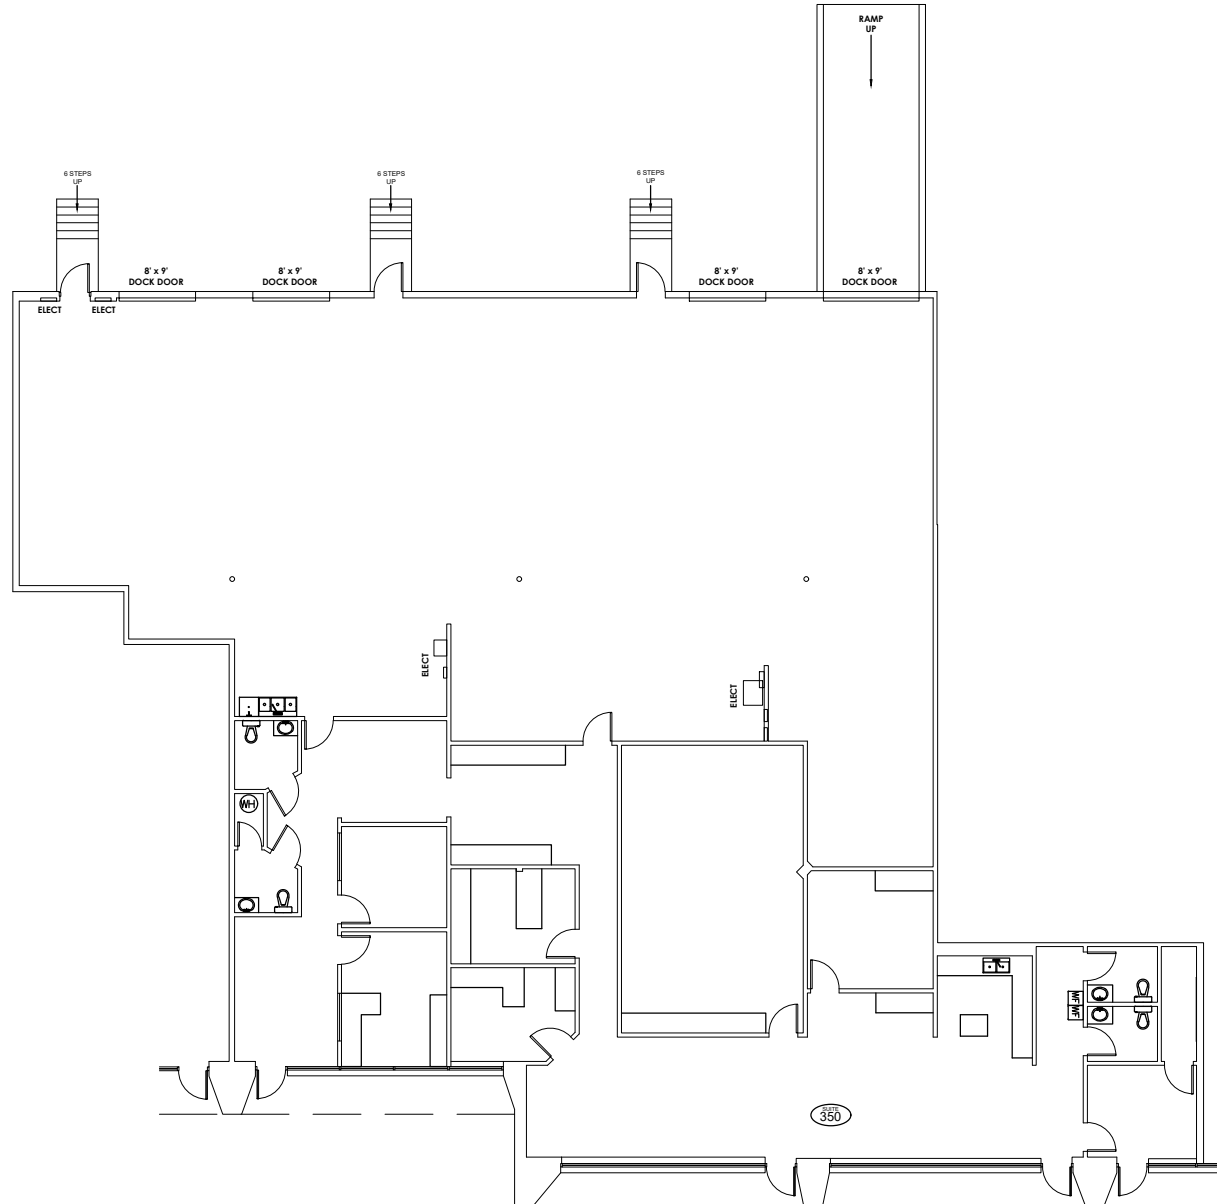

As Built Floor Plan for Marketing

