



Suite 1475 - As built

4,211 RSF

- 7 enclosed rooms
- Large training room or team room
- Kitchen
- Bright corner suite with double door identity
- Available now

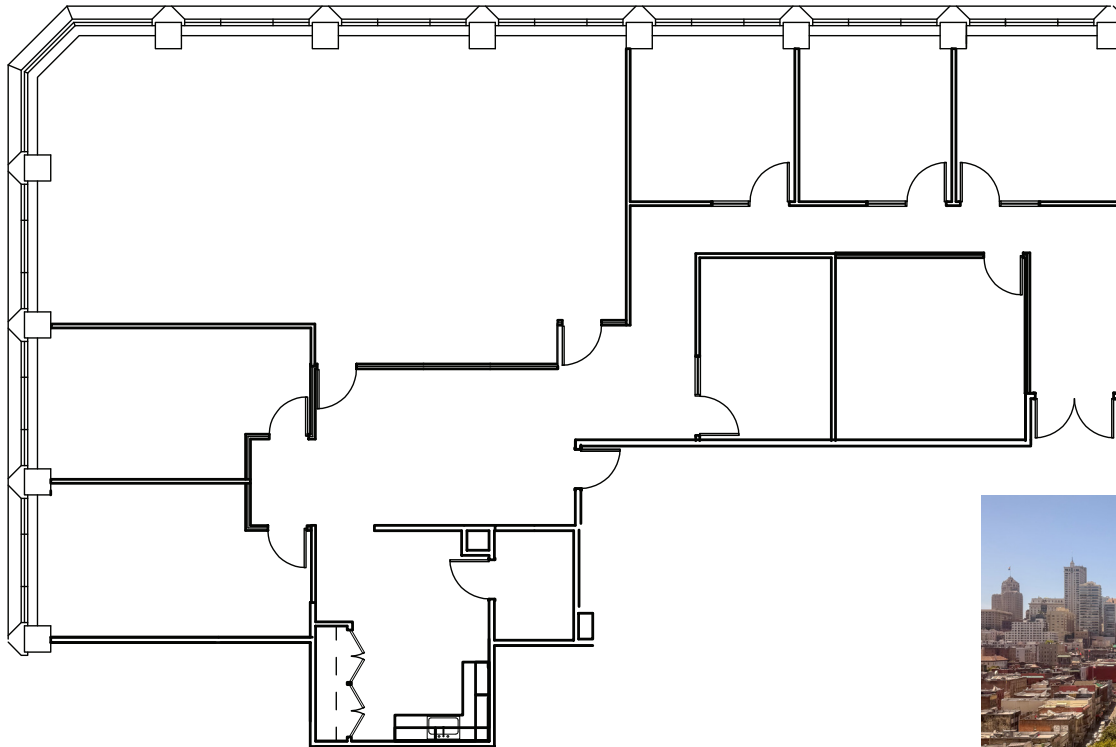

601

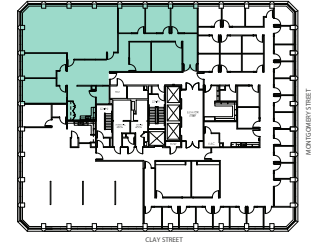

Kelly Glass
415.322.5062
kelly.glass@avisonyoung.com
RE Lic #01335179

Colton Hanley
415.913.8699
colton.hanley@avisonyoung.com
RE Lic #02089768

Elliot Ashkenazy
415.596.6886
elliot.ashkenazy@avisonyoung.com
RE Lic: 02280616

