

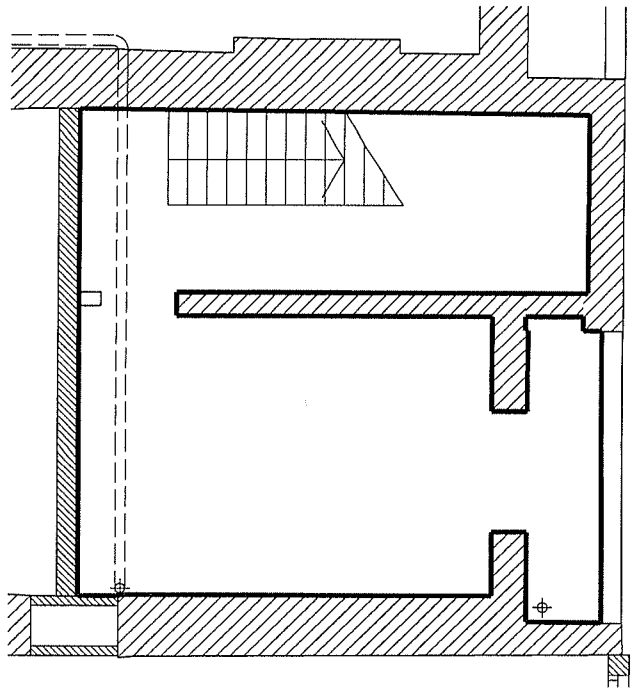


01
01/150
Floor Plan
84 Maddox Street
BASEMENT

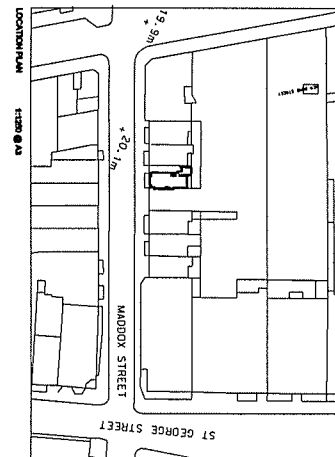


02
01/150
Floor Plan
84 Maddox Street
GROUND

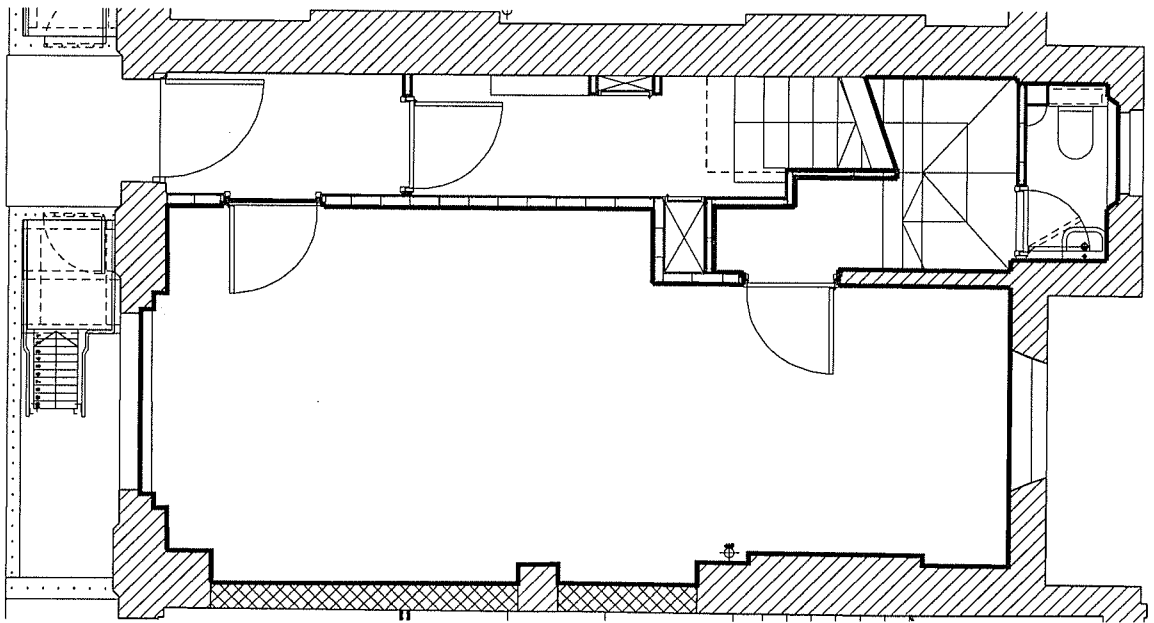

RECORD DRAWING

NO	DATE	BY	CHECKED
01	01.10.08	MS/PJ	
02	01.10.08	MS/PJ	
03	01.10.08	MS/PJ	
04	01.10.08	MS/PJ	

Eric Parry Architects
28-41 Essex Street
London EC2Y 6DG
Tel: 020 7463 1800
Fax: 020 7463 1801

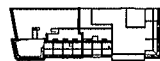

Scottish Widows
80 New Bond Street
General Arrangement - LEASE PLAN
GROUND & BASEMENT - 84 MADDOX ST

NO	DATE	BY	CHECKED
01	01/150	MS/PJ	

RD3