
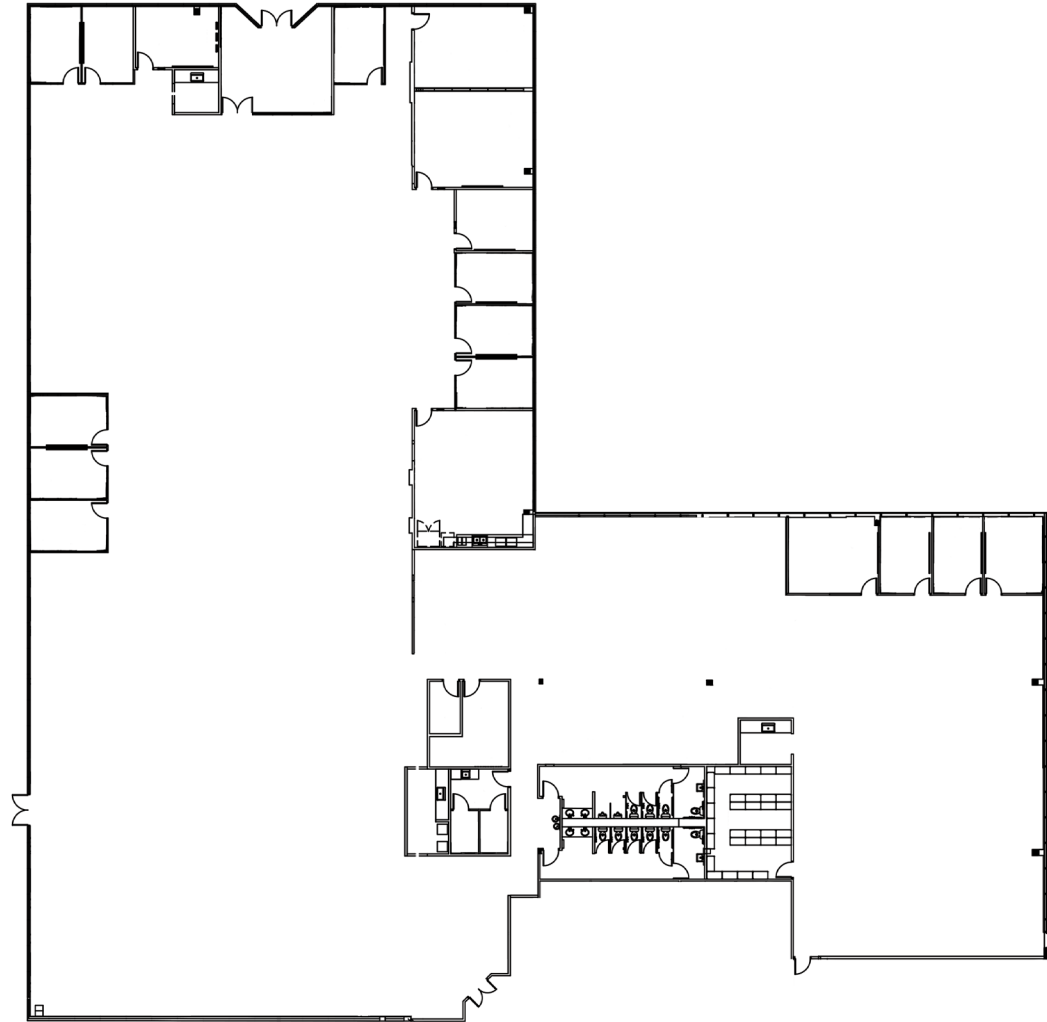


SPACE AVAILABLE

SUITE 150: 29,845 SF

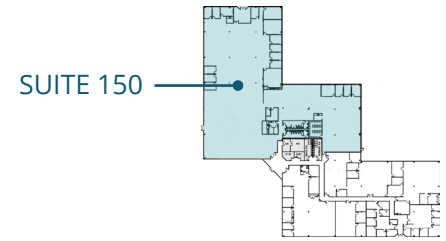

TAMPA INTERNATIONAL BUSINESS CENTER
5550 West Idlewild Ave
Tampa, FL 33634

No warranty or representation, expressed or implied, is made to the accuracy of information contained herein, and same is submitted subject to errors, change of price, rental or other conditions, withdrawal without notice, and to any special listing conditions imposed by our principals. PLANS NOT TO SCALE

MATT ALEXANDER
813.559.2006
Matthew.Alexander@FranklinSt.com

NICK POLO
Senior Associate
Nick.Polo@FranklinSt.com

FranklinStreet
Licensed Real Estate Broker | FranklinSt.com