



arcdimension

Tel: 214-388-9640
Email: info@arcdimension.com
www.arcdimension.com

Project Address
**9616 Archibald Av
Unit 2
Rancho Cucamonga, CA
91730**

ArcDimension ID
158666

Survey Date
1/31/2024

Surveyed by
BJ

Project Architect
BK


Date
2/9/2024

Sheet Number
A102

Notes
No further notes applicable.

While deemed reliable, no information on these as-built drawings should be relied upon without independent verification. These drawings are the property of ArcDimension. Use by a third-party without written authorization is prohibited.

TOTAL SQUARE FOOTAGE: 6,626 SQ FT
CALCULATED FROM OUTSIDE FACE OF EXTERIOR WALLS
AND CENTER OF DEMISING WALLS.
(LOBBY AND STAIRCASES EXCLUDED FROM SQ FT)

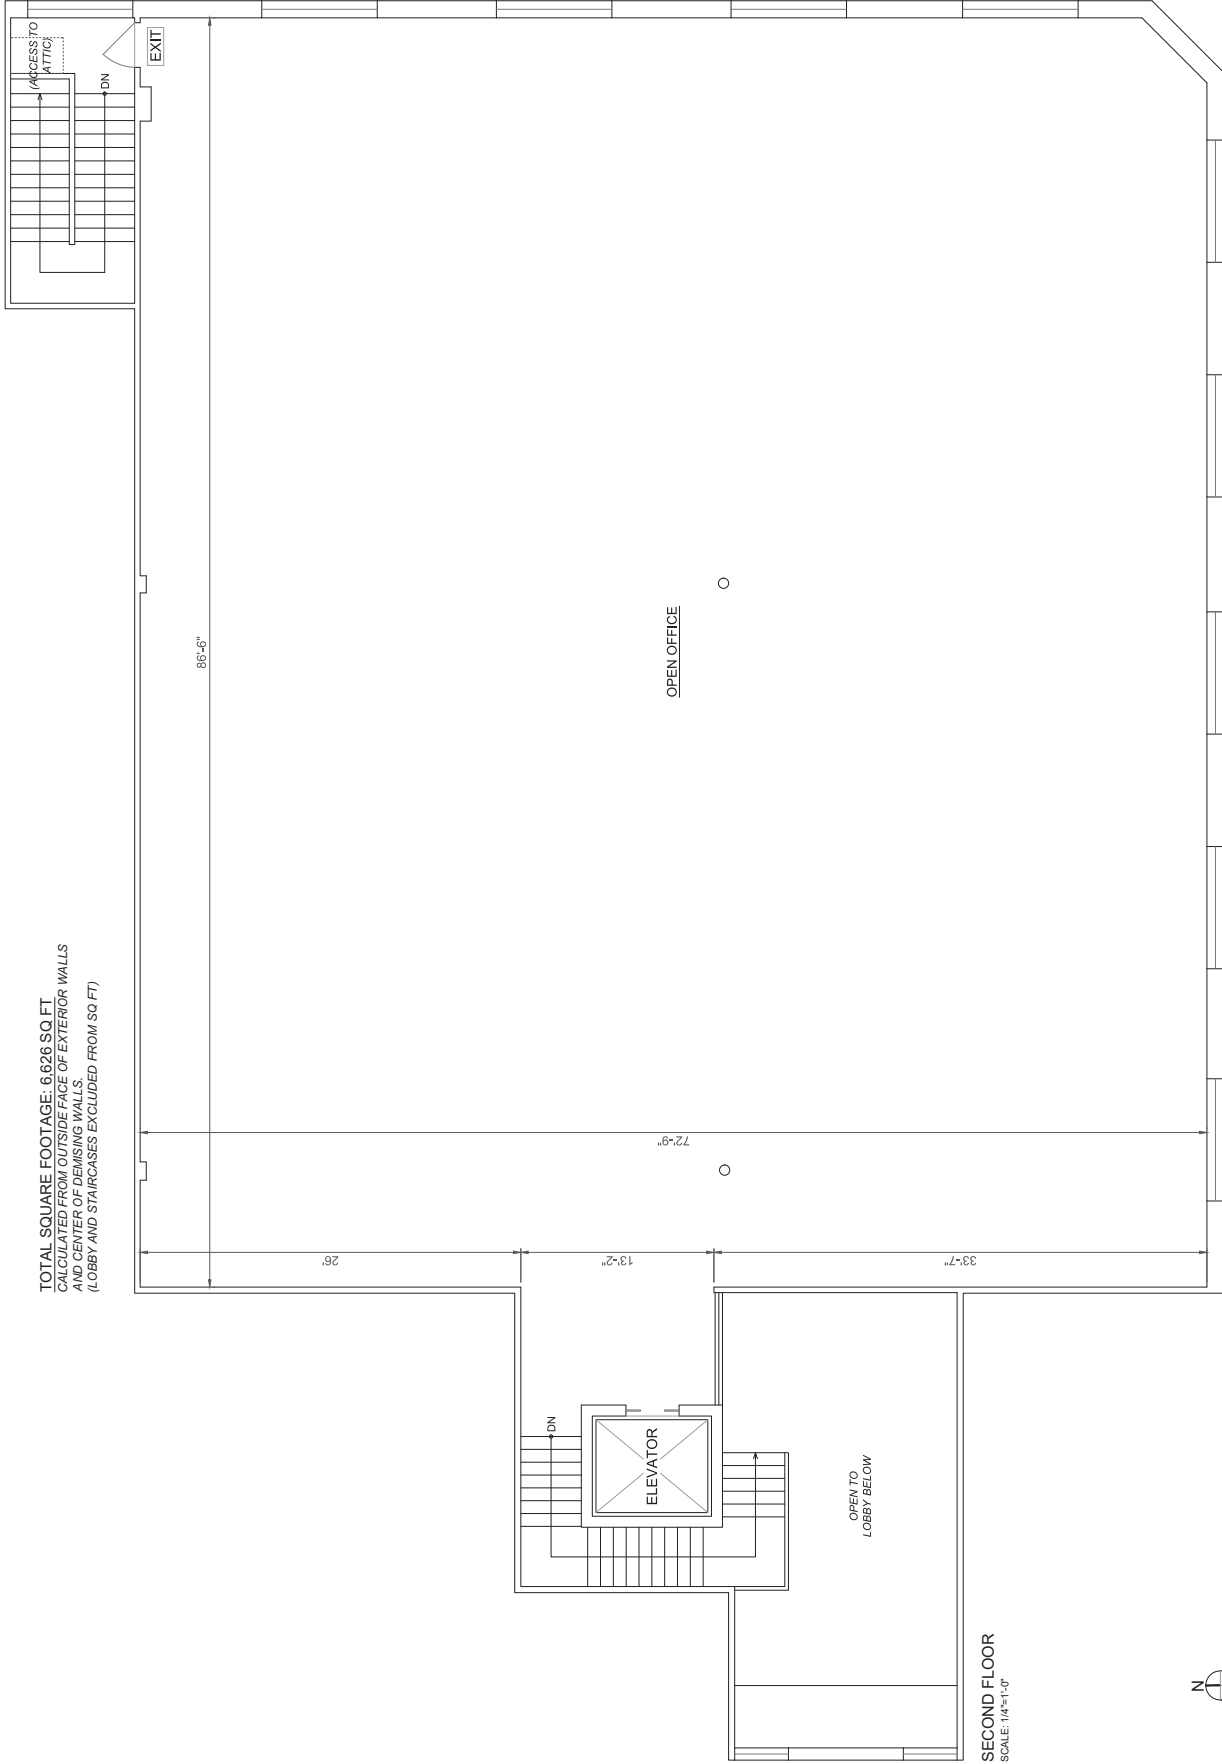

SECOND FLOOR
SCALE: 1/4"=1'-0"

