

Property Key




3904 Corporex Drive As Built Marketing Package
3904 Corporex Drive, Tampa, FL 33619



**BAY
SPACE**

Building: 2
Suite: 125
Sheet: A-6

Scale: Not to Scale
Sheet Size: 8.5" x 11"
Not For Construction

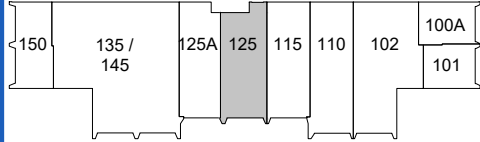

Total Area - 2,679 SF

Building Information

DECK HEIGHT:	N/A
CEILING HEIGHT:	8'-4"
CLEAR HEIGHT:	8'-4"
SPRINKLERED:	No

