
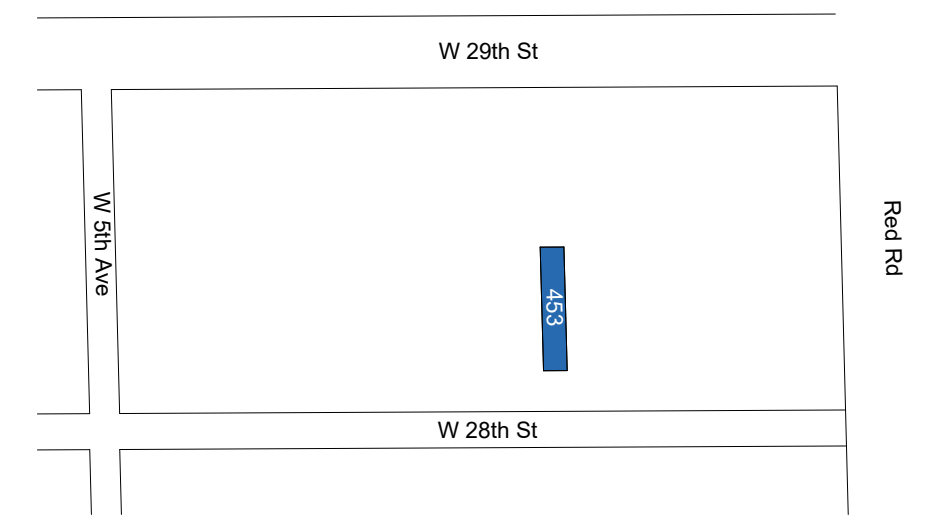


Property Key

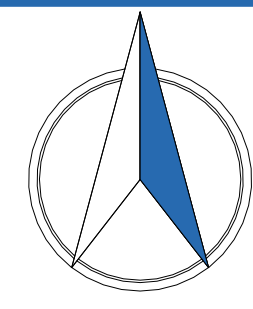


Hialeah Buildings

453 W 28h St, Hialeah, FL 33010

Building: 34

Suite: 453

Sheet **E1**

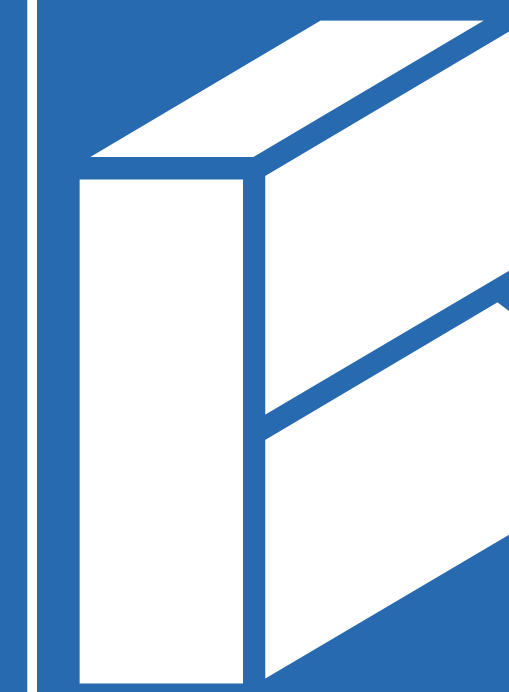

BAY SPACE

Description


Scale: Not to Scale
Sheet Size: 42" x 30"
Not For Construction

Usable Square Foot Analysis

	SQFT	BUILDING PERCENTAGE
Office Area	0	0 %
Warehouse Area	2000	100 %
Total Area	2,000	

Building Information

Deck Height:	16' - 0"
Clear Height:	13' - 8 1/2"
Ceiling Height:	7' - 10"
Sprinklered:	<input type="checkbox"/> Yes <input checked="" type="checkbox"/> No
Mechanical Area:	0 SQFT

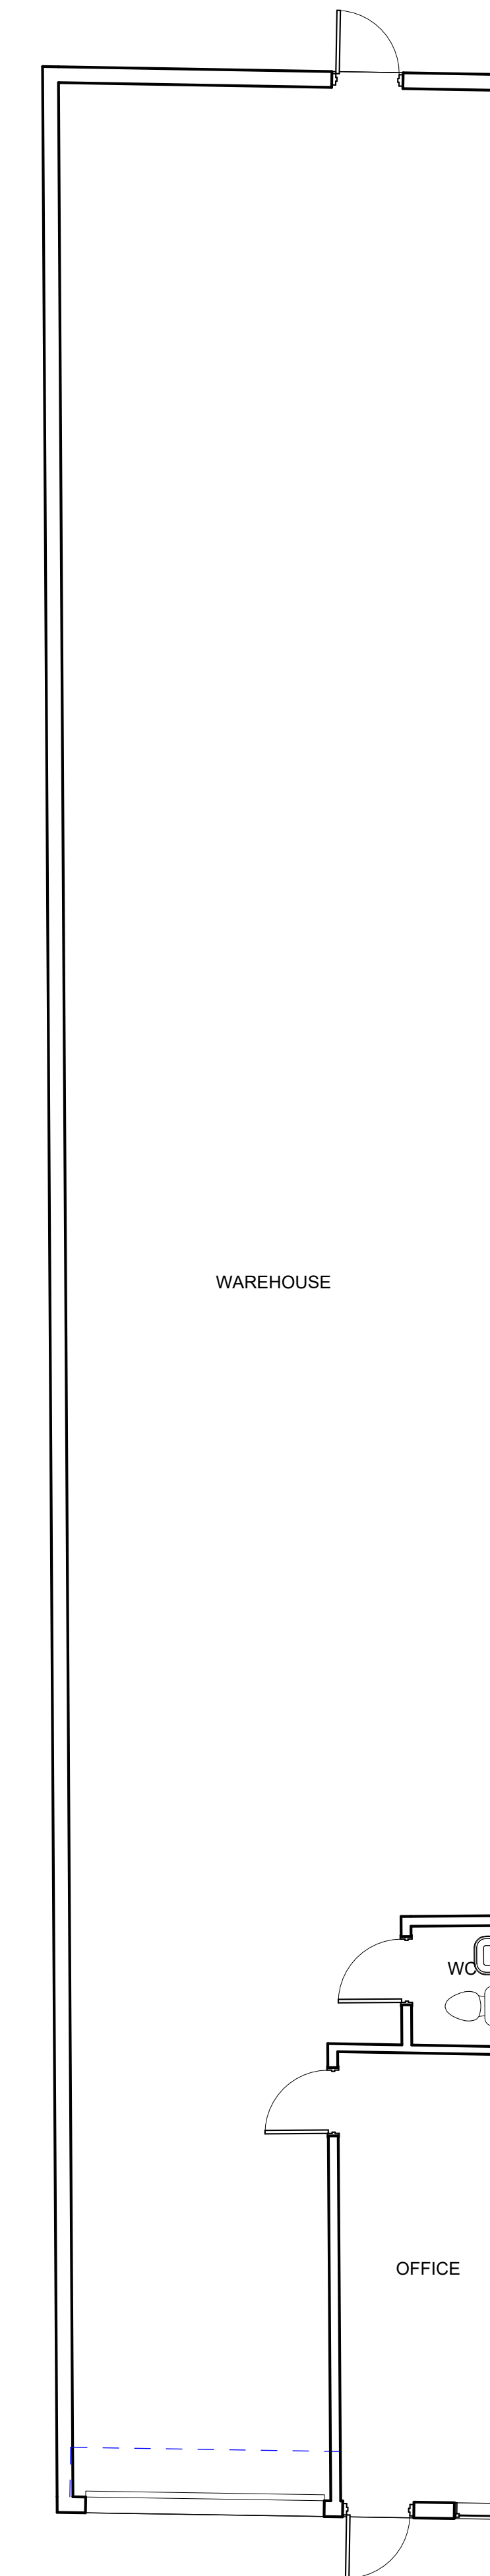

① 453
3/16" = 1'-0"

As Built Floor Plan for Marketing

