
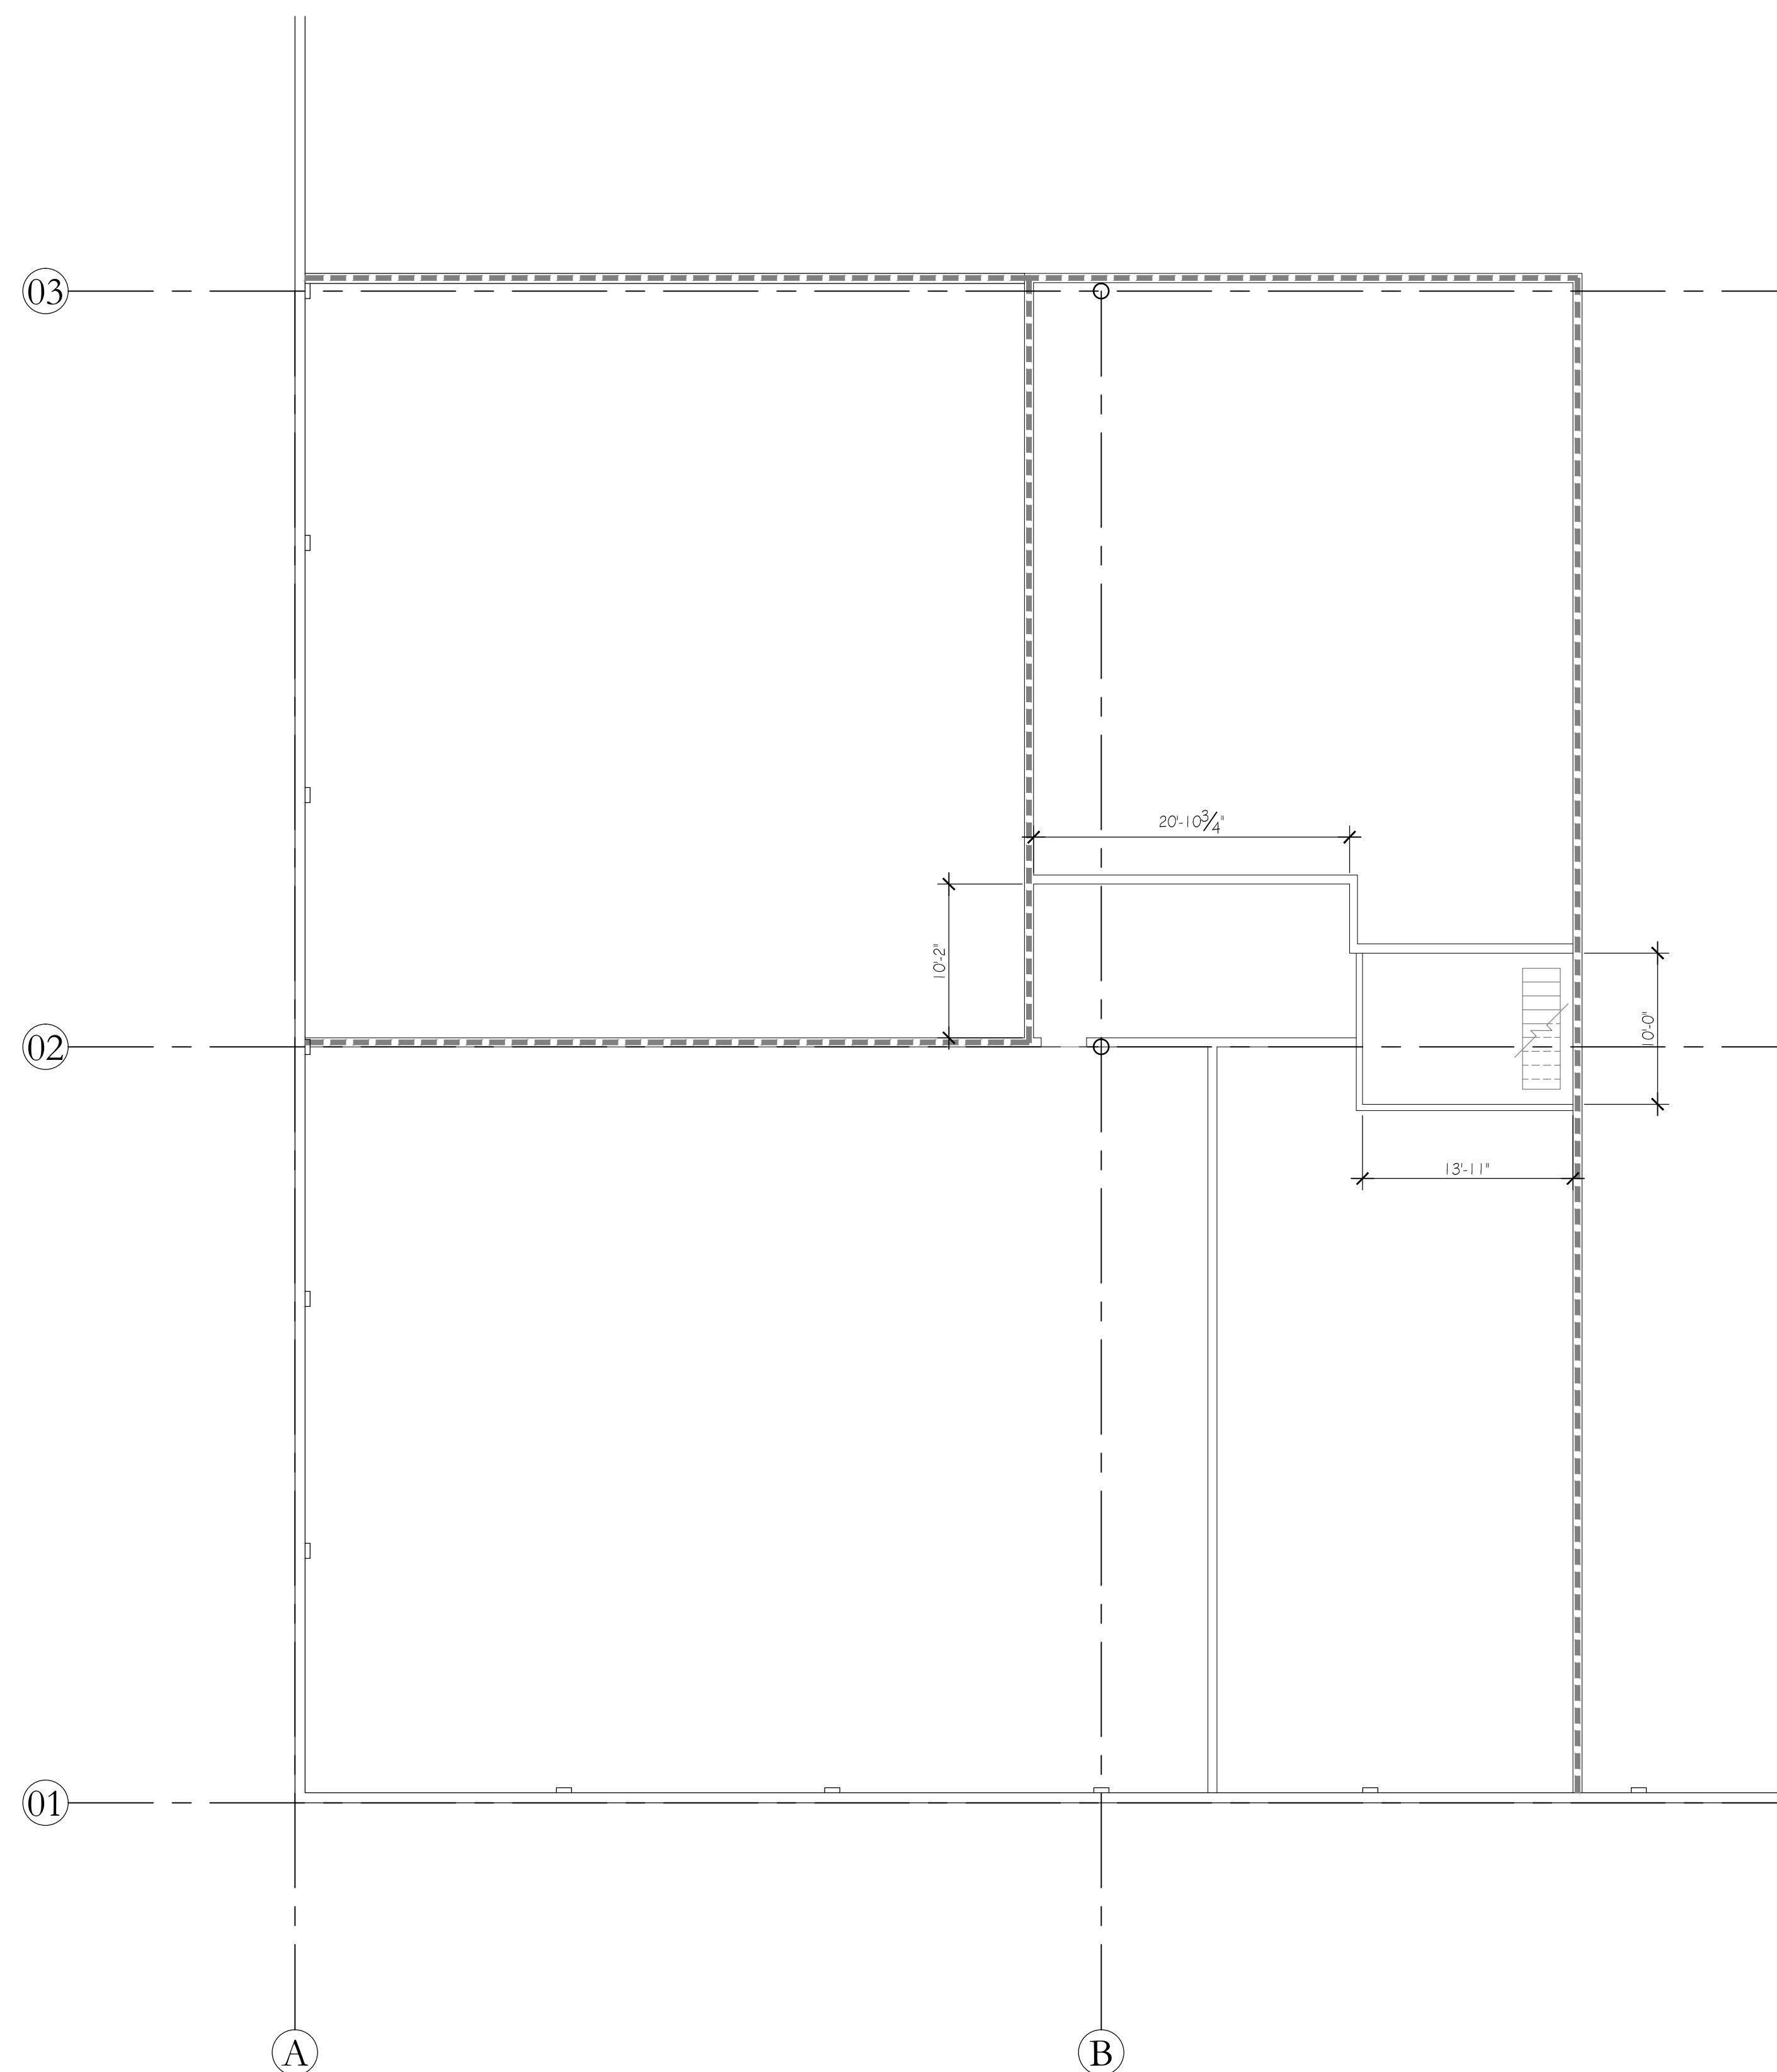


NO.	DATE	REVISION


AS-BUILT

Existing Conditions

2240 SW. 70th Ave., Suite 'A' & 'B'
Davie, Florida 33317

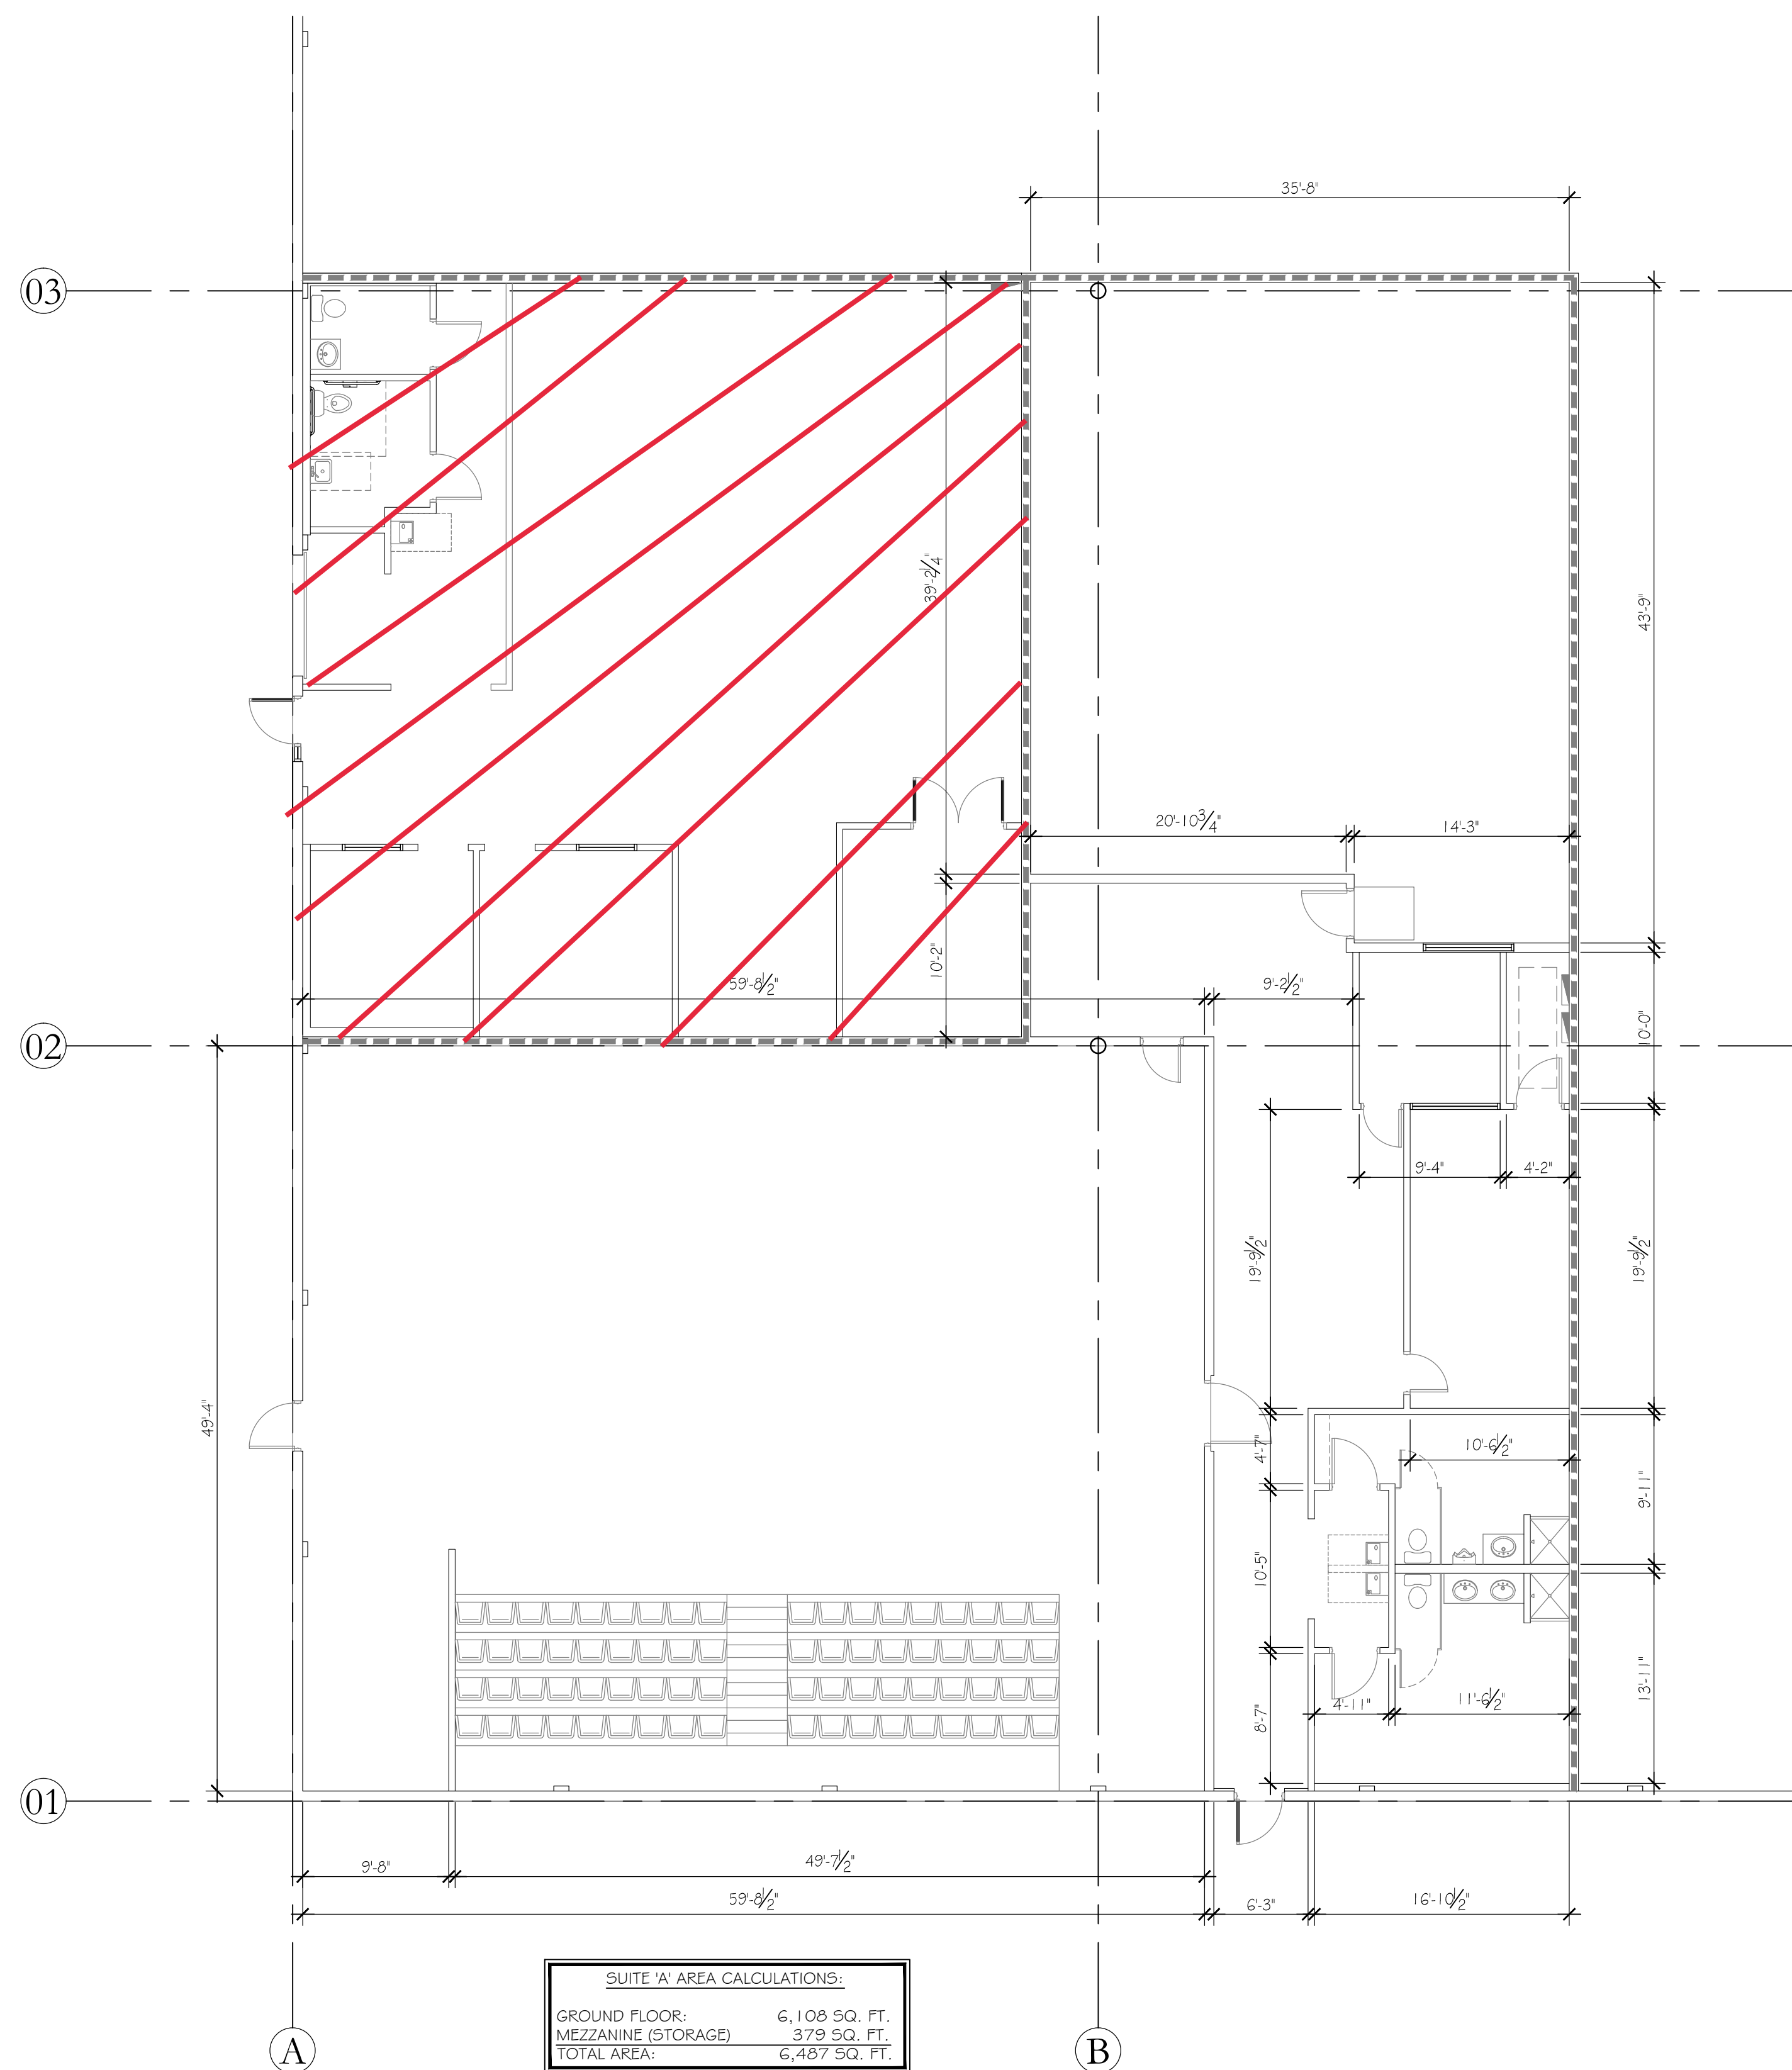

ADAM RYDZEWSKI
FLORIDA REGISTERED ARCHITECT
REGISTRATION NO. AR0002163

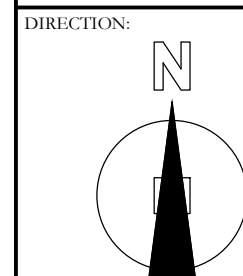

ISSUED DATE:
2021-02-04

DRAWN BY:
B.B.

DATE PRINTED:
2020-02-04

CHECKED BY:
A.R.

SCALE:
AS NOTED

PROJECT NO:
21-021

TITLE:
EXISTING FLOOR
PLAN AND MEZZ.
PLAN- SUITE 'A'

DRAWING NO:
A-1.0