


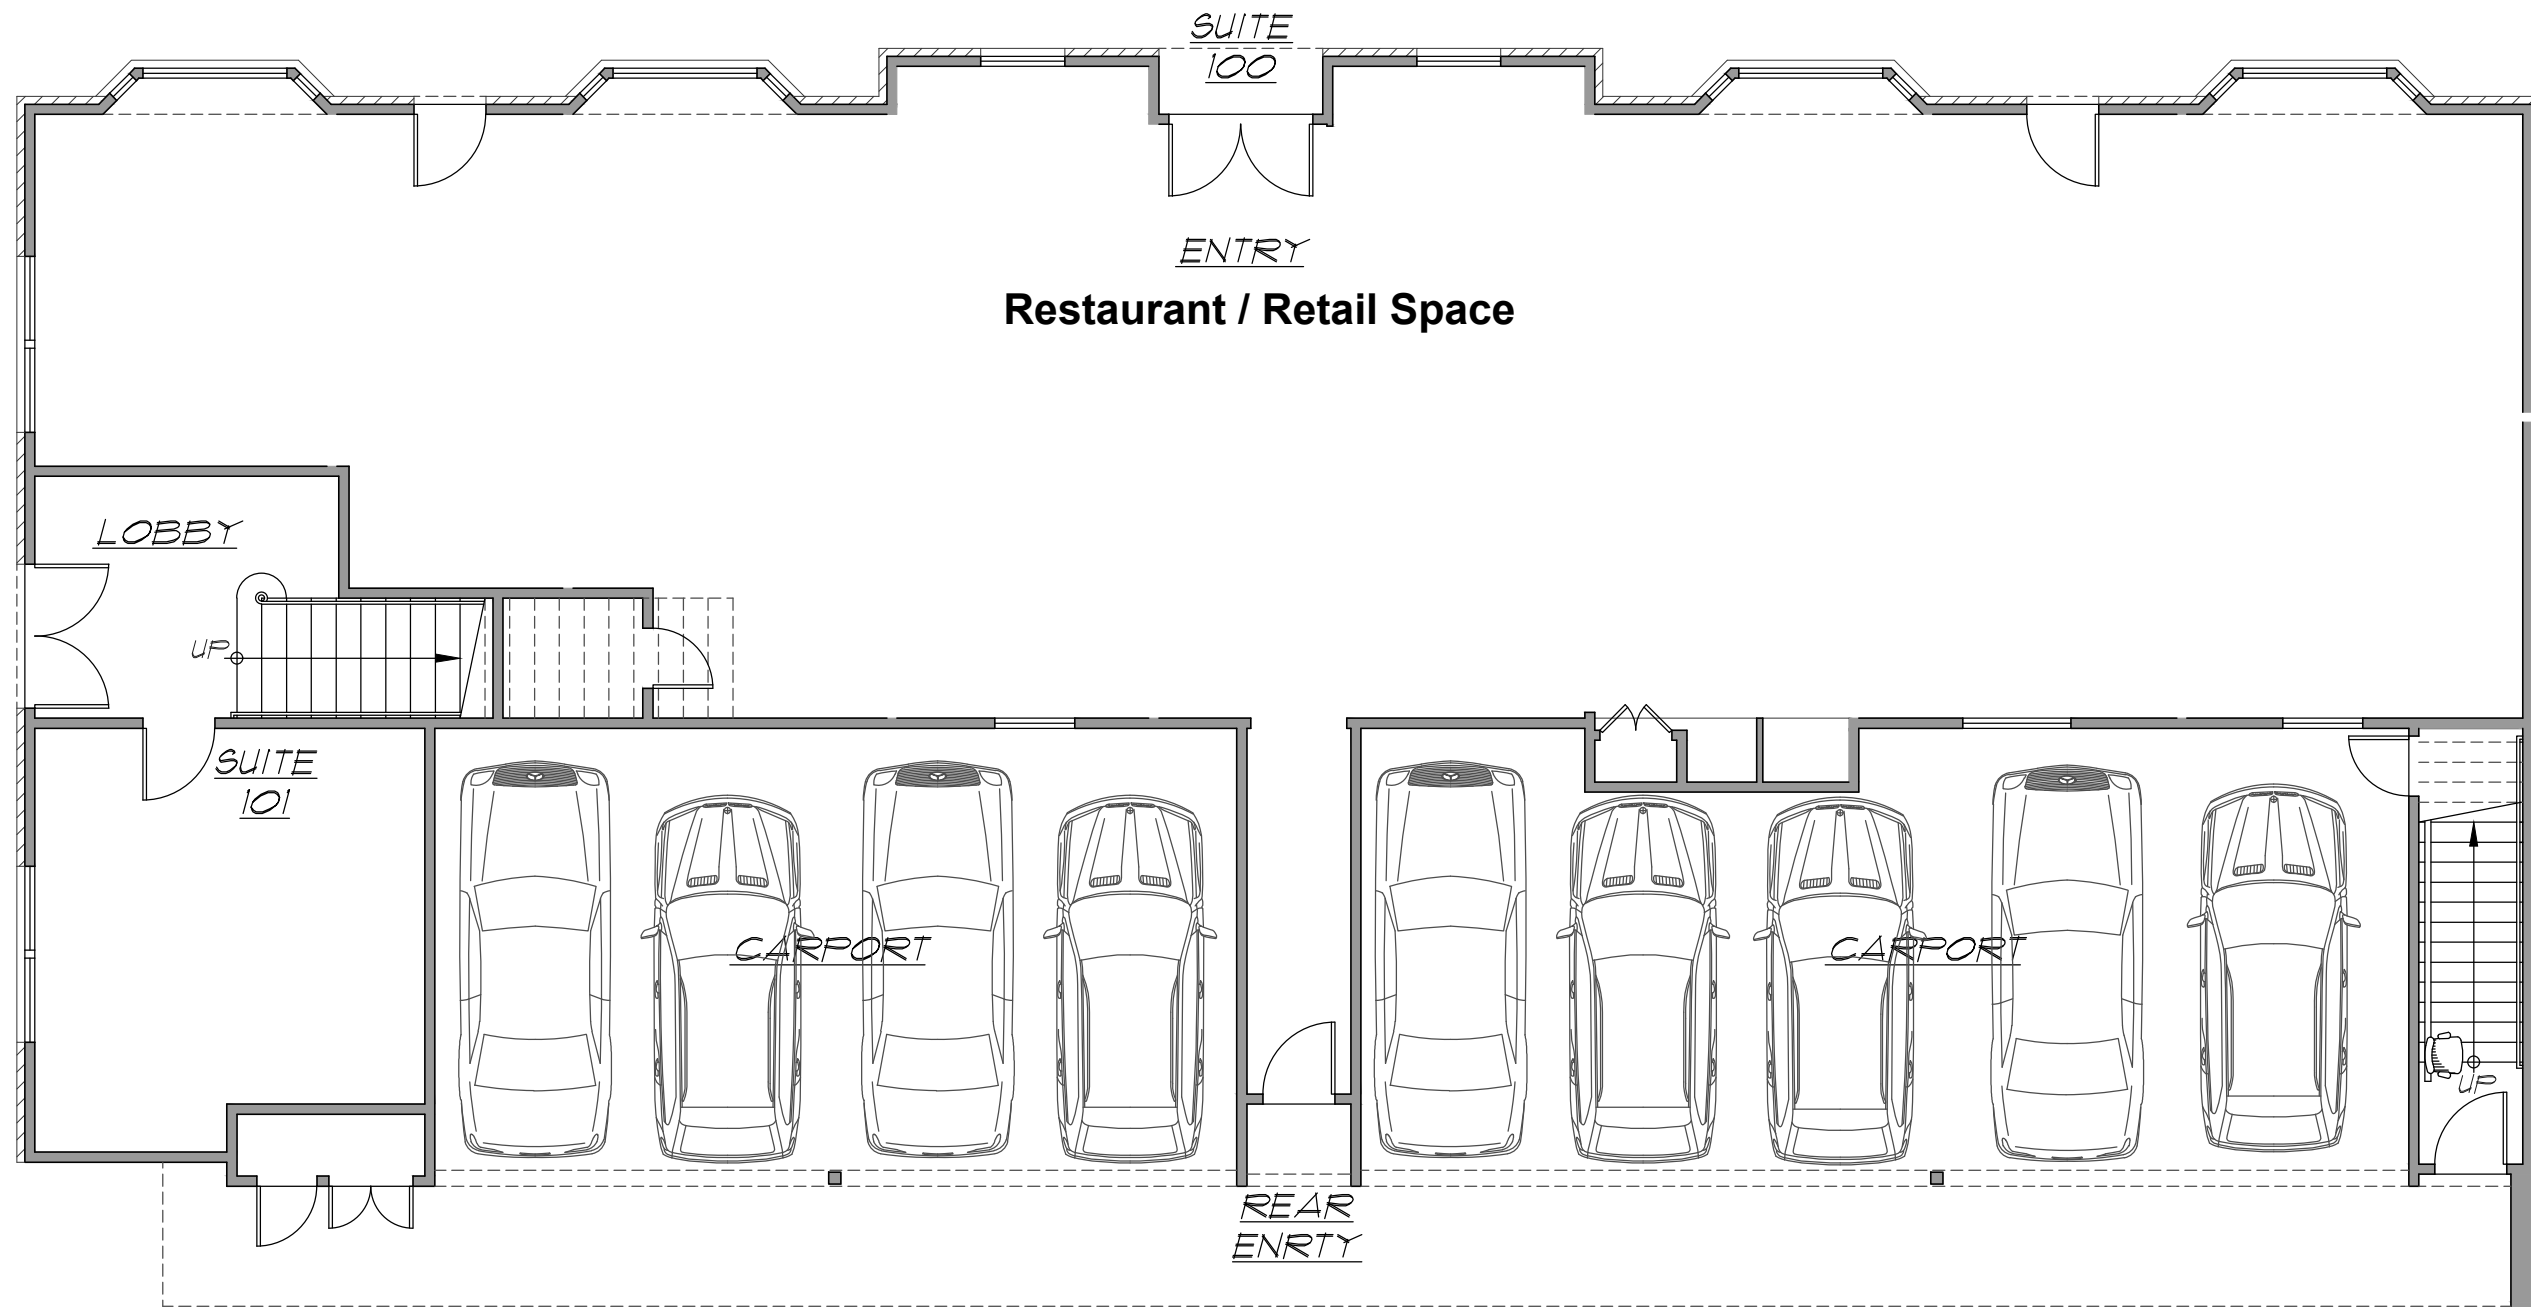

FIRST FLOOR PLAN
SCALE: $\frac{1}{8}" = 1'-0"$