


BOMA Rentable Square Footage			
Suite	Occupant Area	Load Factor	Rentable Square Footage
300-301	3399	1.15	3909
302	2763	1.15	3177
303	1954	1.15	2247
			9333

As-Built Drawings  
 SQUAREFOOT STUDIOS  
 3374 Wild Oak Lane  
 Escondido, CA 92027  
 (858) 201-8156

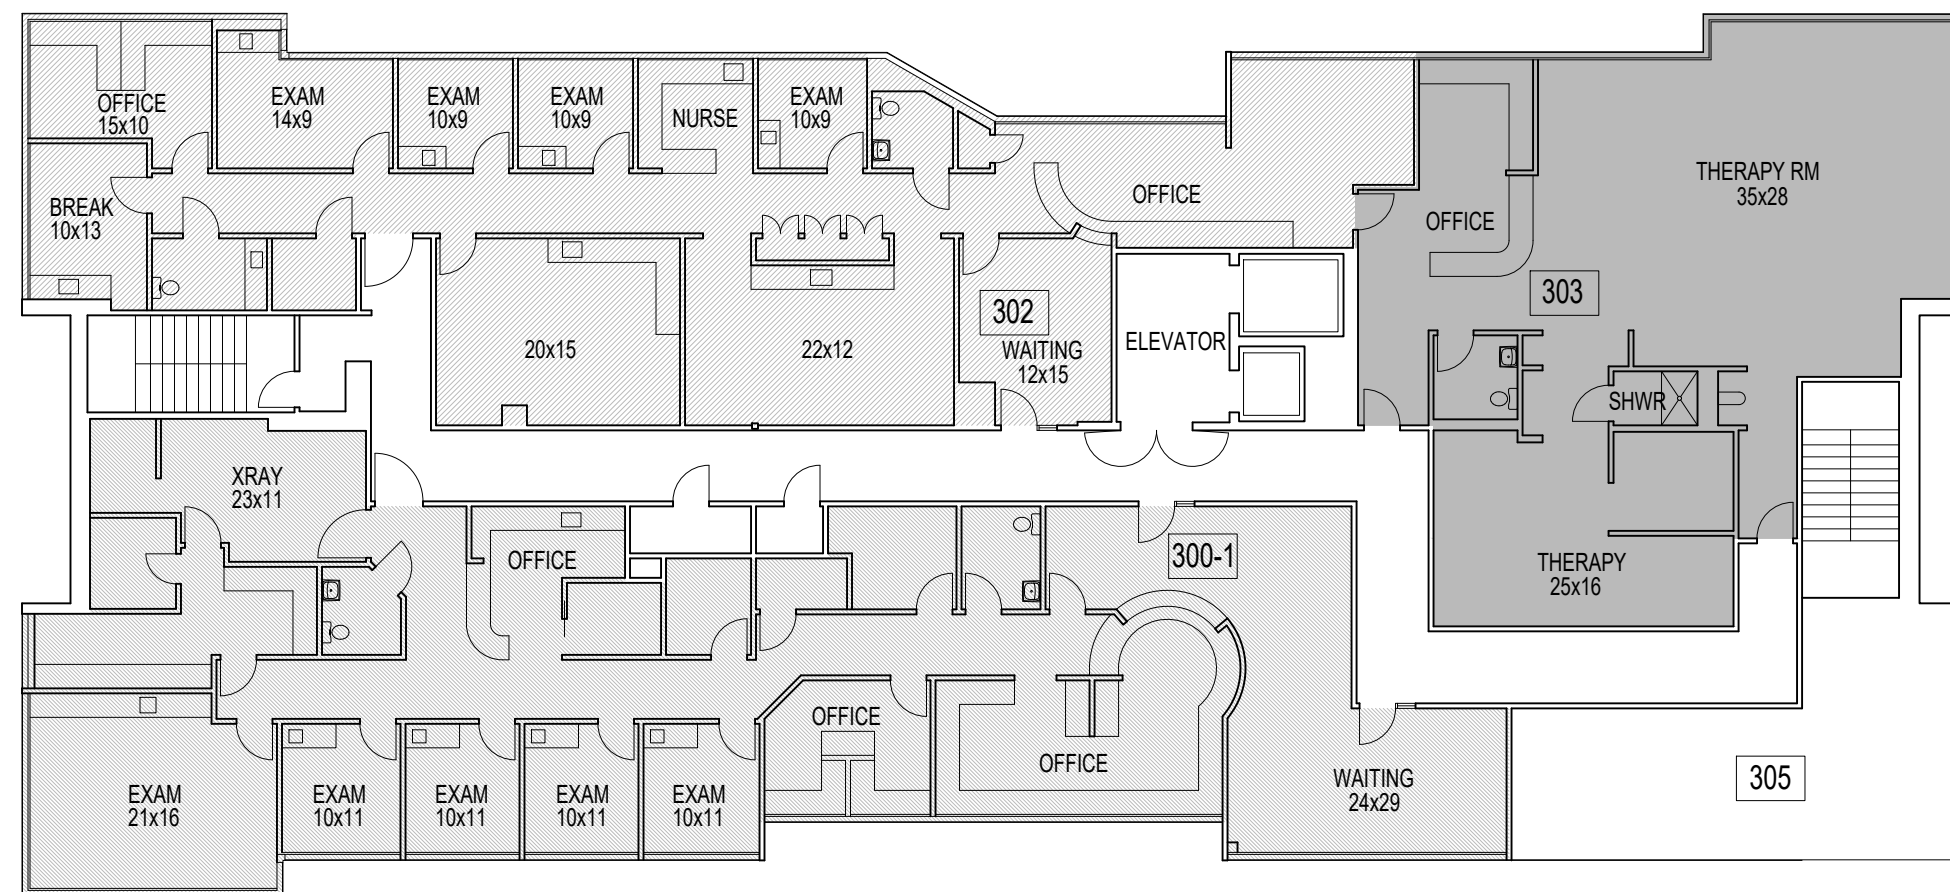

IPA Commercial Real Estate

BUILDING LOCATION  
 6485 Day St  
 Riverside

SHEET TITLE  
 Existing Plan

DATE: 3/30/21

SHEET NO.  
**X1**

THIRD LEVEL FLOOR PLAN

SCALE: 1/16"=1'-0"