


TOTAL APPROX: (SQFT)
3389

VIEW A


TOTAL APPROX: (SQFT)
135
VIEW B

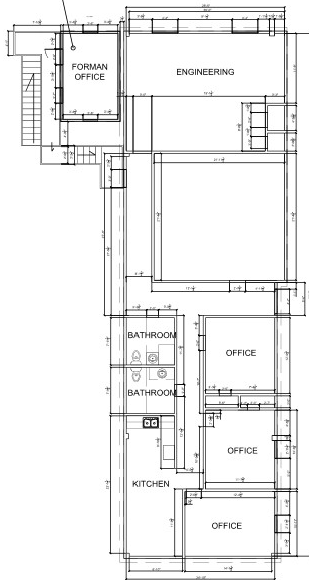

SECOND FLOOR

TOTAL APPROX: (SQFT)
2255

METAL SHOP / OFFICES

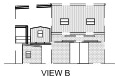

VIEW B



VIEW A




VIEW C

VIEW C

4 METAL SHOP & OFFICES - KEY ELEVATIONS
SCALE: N.T.S.

METAL SHOP / OFFICES

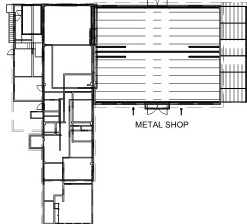

METAL SHOP

1 1ST - CONC. METAL SHOP BUILDING / OFFICES
SCALE: 3/16" = 1'-0"

2 2ND - CONC. METAL SHOP BUILDING / OFFICES
SCALE: 3/16" = 1'-0"

3 METAL SHOP & OFFICES - OVERALL
SCALE: N.T.S.