


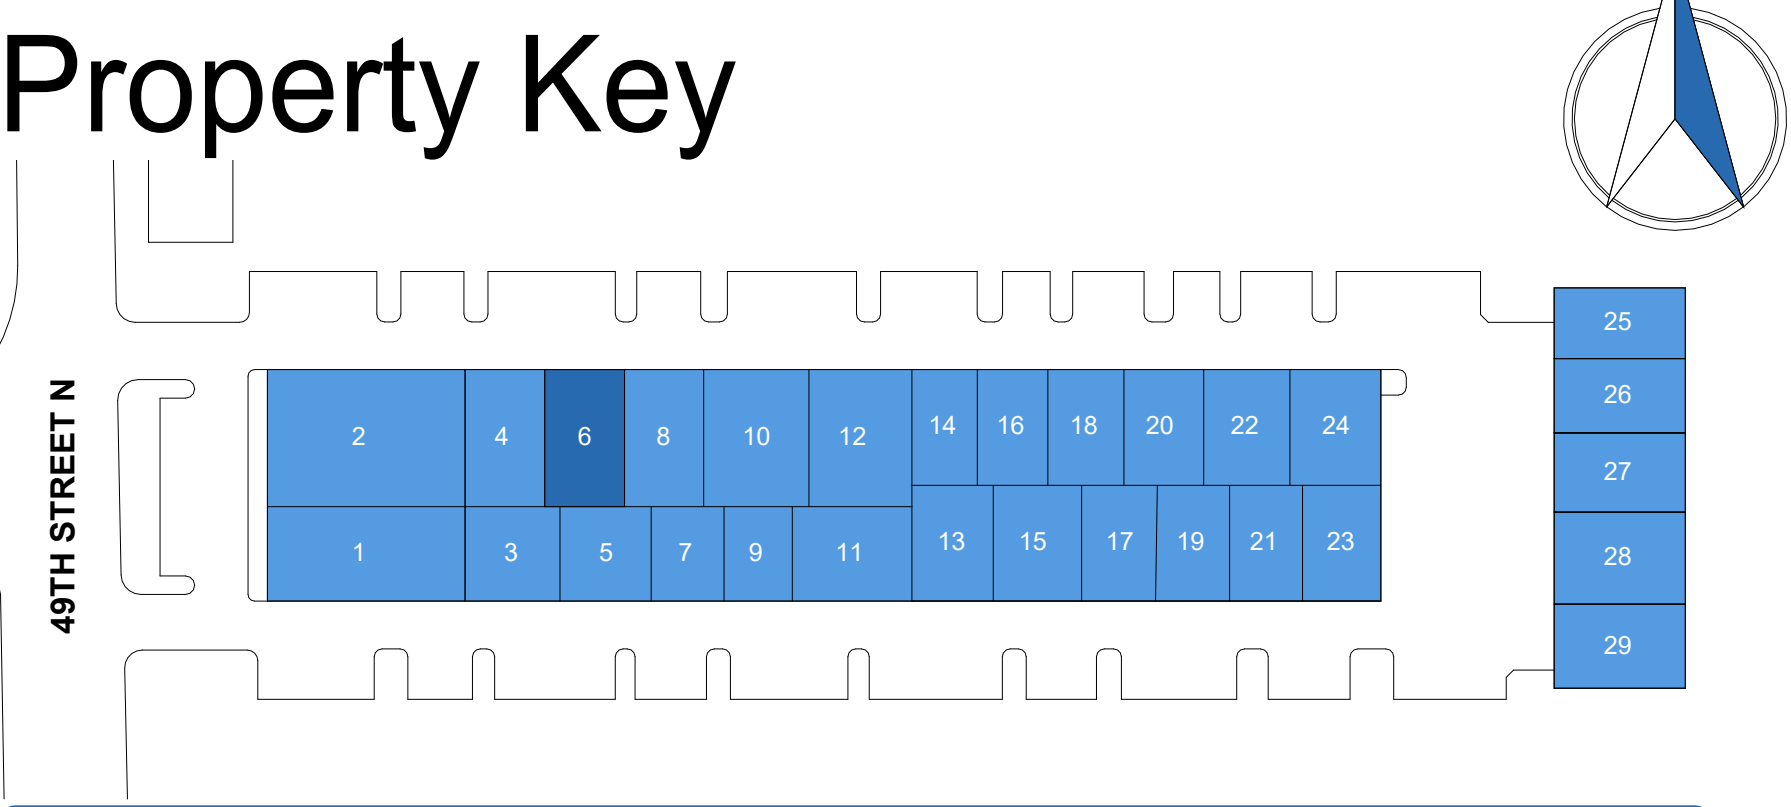

Clearwater As Built Marketing Package


14605, 49th Street N, Clearwater, FL 33762, US

Building: 1

Suite: 6

Sheet **E1**

Scale: Not to Scale
Sheet Size: 42" x 30"
Not For Construction

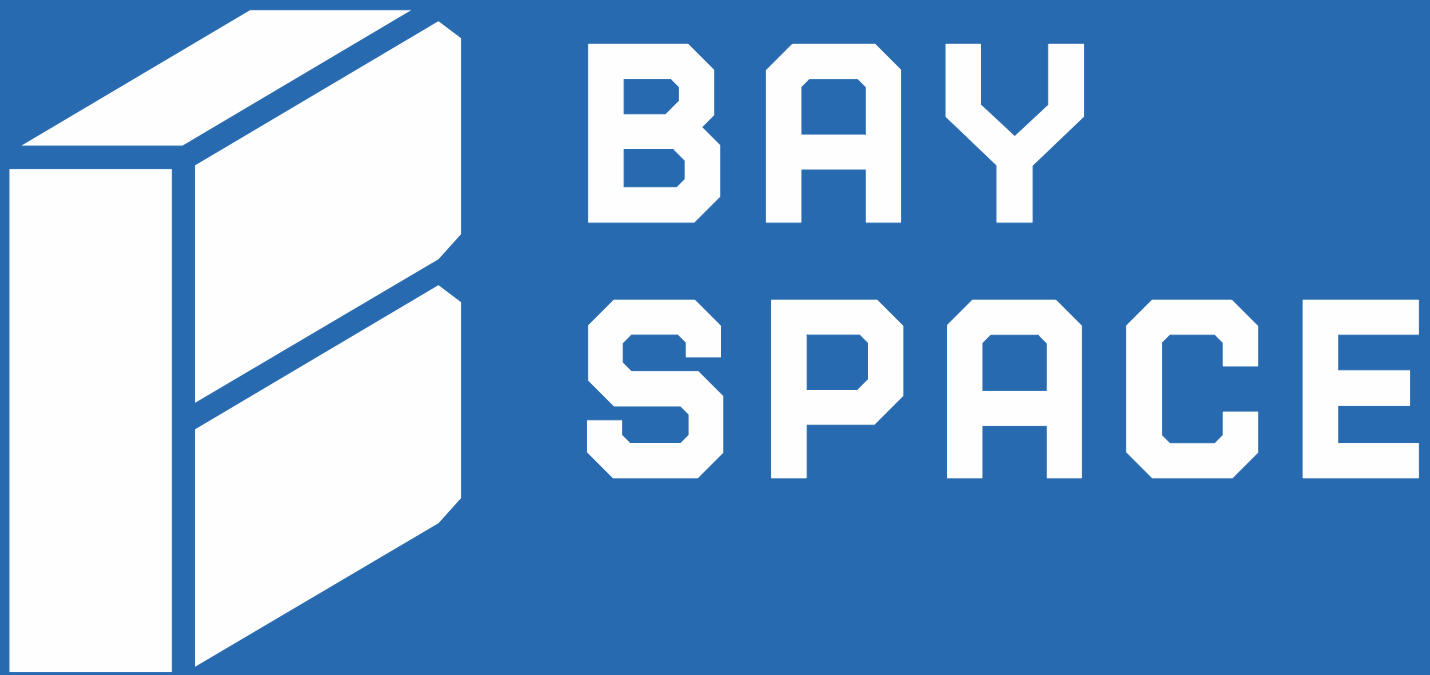

Usable Square Foot Analysis

Office Area		
Warehouse Area	1,580	
Total Area	1,580	

Building Information

Deck Height:	14' - 11 1/2"
Clear Height:	9' - 1 1/2"
Ceiling Height:	9' - 1 1/2"
Sprinklered:	☐ Yes ☒ No
Mechanical Area:	0 SQFT

