


2380 FORTUNE DRIVE • SUITES 110 & 120 • LEXINGTON, KENTUCKY 40509

As-built plan with rentable areas — each measured area grossed up 1.21% to reconcile to 12,000 rentable SF.

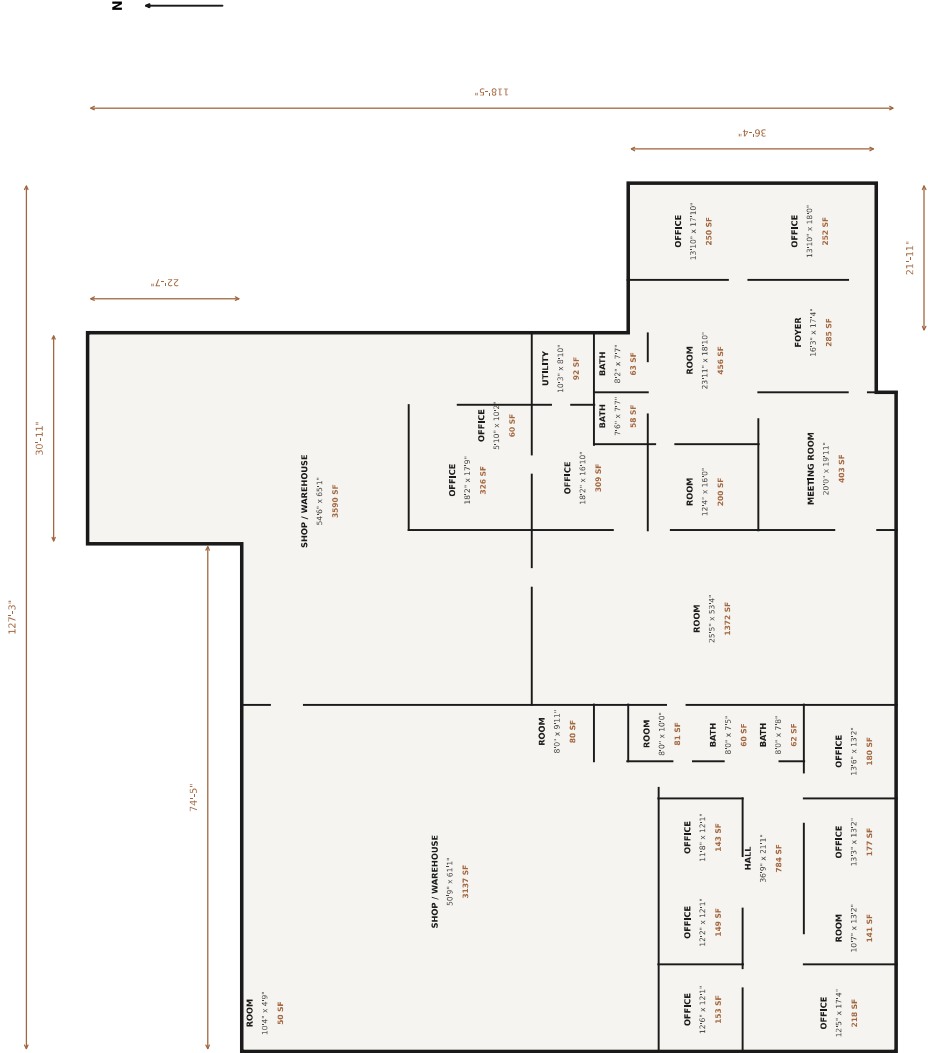

Geometry traced from the Culicassa plan; scale calibrated to four measured shop dimensions. Room figures are nominal (width x depth) grossed to rentable and overstated any room that is not a true rectangle. Measured gross 11,857 SF - Rentable 12,000 SF - Field verify all dimensions before design, permitting or construction.