


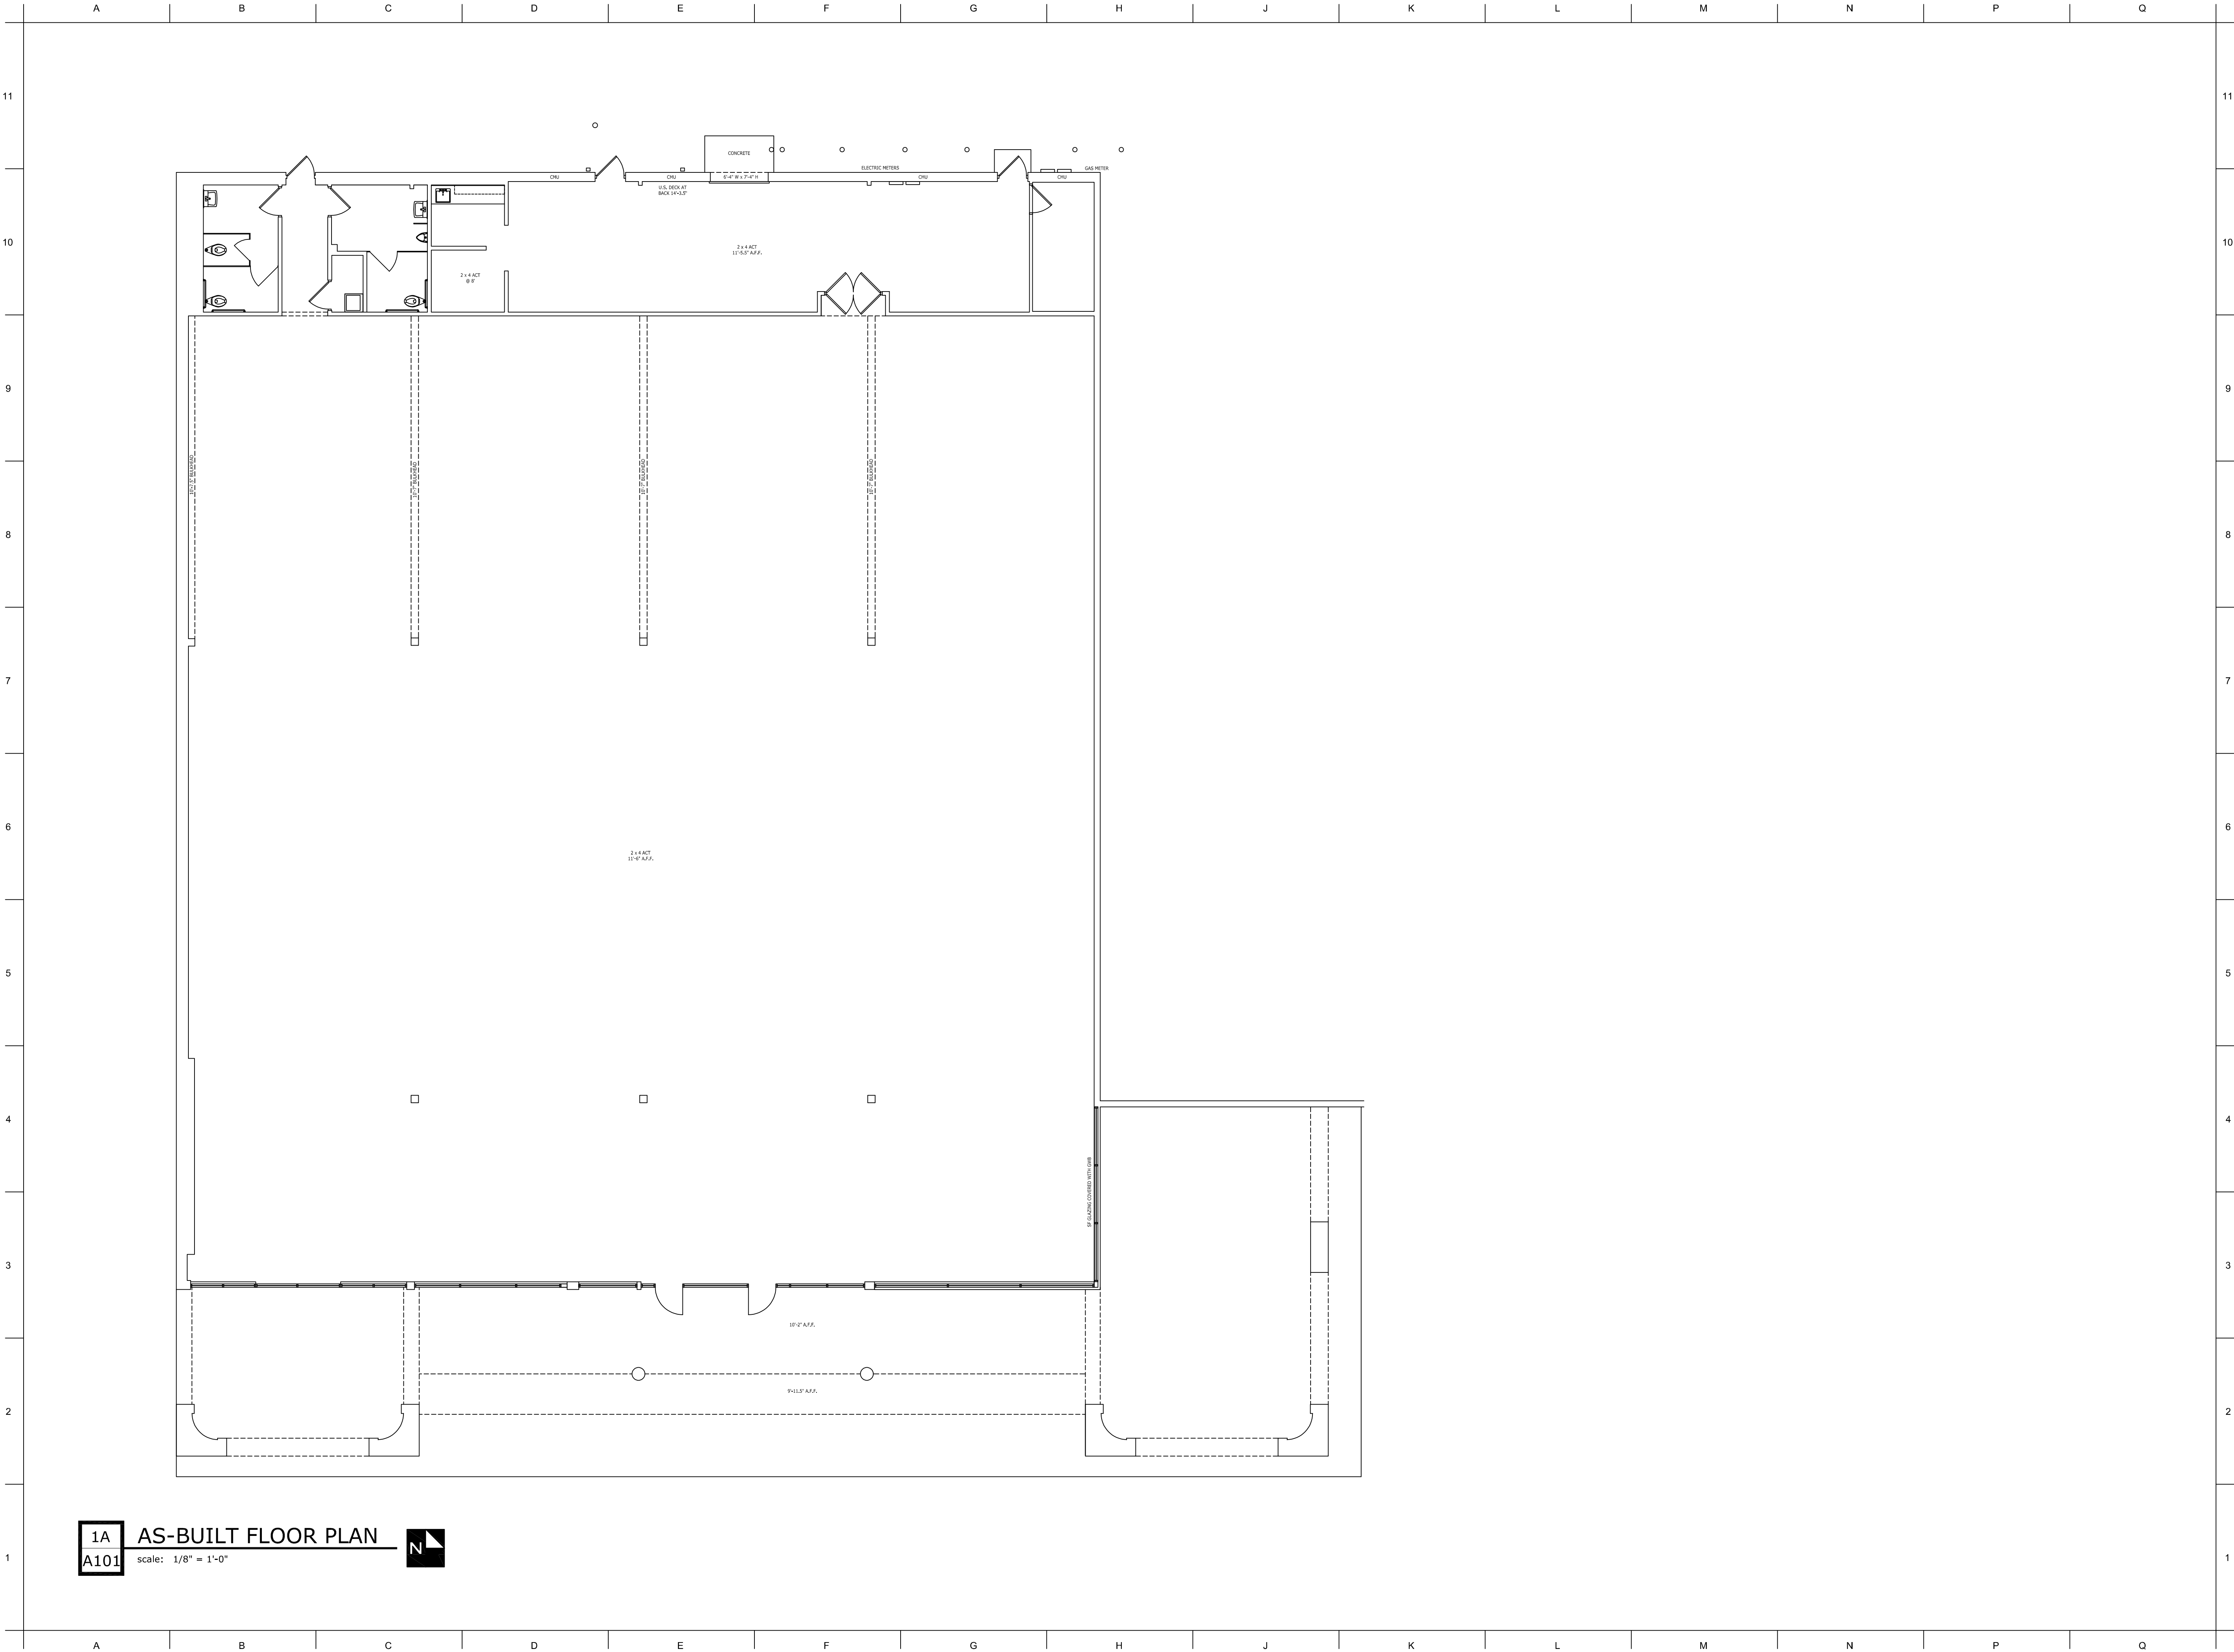

5039 S National Avenue | Springfield, MO 65810 | 417.887.6595

OWNER
BC WOOD PROPERTIES
321 HENRY STREET
LEXINGTON, KY 40508
(858)335-9663

PROJECT TEAM

PROFESSIONAL SEAL
BRENT M. STEVENS, AIA - Architect
KENTUCKY #8822

90% REVIEW SET
NOT FOR
CONSTRUCTION
11-XX-25

REVISIONS

NO.	DESCRIPTION	DATE

© 2026 H DESIGN GROUP, LLC
THIS DRAWING AND THE ARCHITECTURAL WORK REPRESENTED ARE OWNED BY H DESIGN GROUP, LLC. COPYRIGHT INCLUDES THIS DRAWING, AS WELL AS ALL COMPONENTS OF THE CONCEPTUAL DESIGN. REPRODUCTION OF ANY KIND IS STRICTLY PROHIBITED WITHOUT THE EXPRESSED WRITTEN CONSENT OF H DESIGN GROUP, LLC.

PROJECT TITLE
PARTY CITY AS-BUILT

PROJECT ADDRESS:
127 W TIVERTON WAY SUITE 120
LEXINGTON, KY 40503

PROJECT NO.: 26-025
DRAWN BY: PCB
REVIEWED BY: BMS
DATE: 03-23-2026

A101