



SHRTE 204-207

3033 30th CALEND AVENUE, COTIAWA, ON
(AS-BUILT FLOOR PLAN)

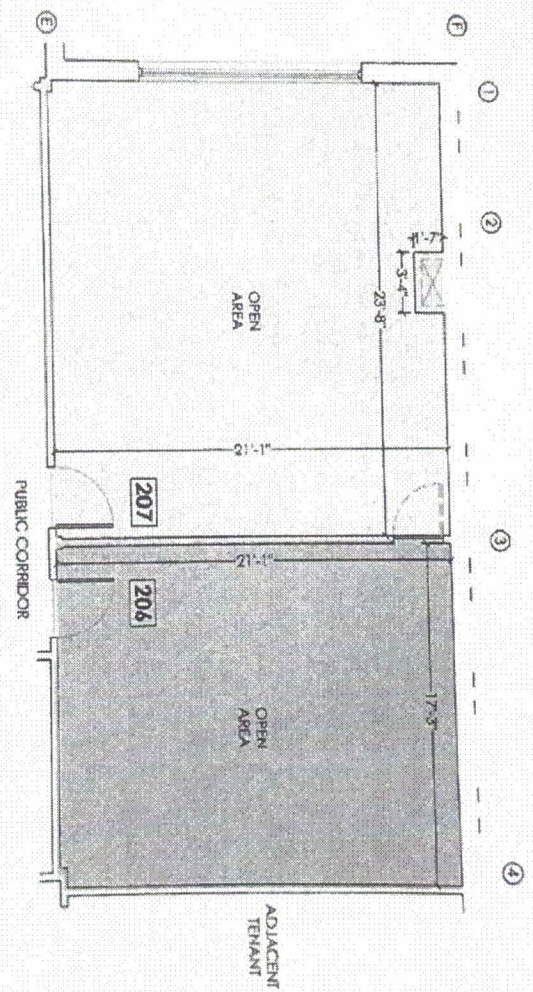

NOTE: SOME PARTS WERE NOT ACCESSIBLE TO MEASUREMENT

PREPARED BY: ECHOGRAPH.COM

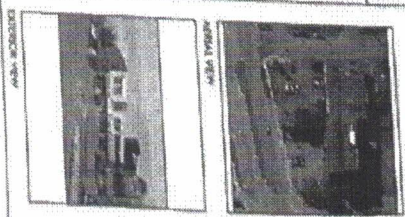

- LEGEND:**
- EXISTING WALLS
 - GLC ELECTRICAL
 - GLC ELECTRICAL PANEL
 - HOT WATER TANK
 - TRANSFORMER
 - TELECOMMUNICATIONS

REVISIONS:

- 1. INITIAL VERIFICATION OF DRAWING
- 2. INITIAL VERIFICATION OF DRAWING
- 3. INITIAL VERIFICATION OF DRAWING
- 4. INITIAL VERIFICATION OF DRAWING
- 5. INITIAL VERIFICATION OF DRAWING
- 6. INITIAL VERIFICATION OF DRAWING
- 7. INITIAL VERIFICATION OF DRAWING
- 8. INITIAL VERIFICATION OF DRAWING
- 9. INITIAL VERIFICATION OF DRAWING
- 10. INITIAL VERIFICATION OF DRAWING

DATE: September 13, 2016

PROJECT: 3033 30th CALEND AVENUE, COTIAWA, ON

DRAWING SCALE: 1/8" = 1'-0"

