



356 Main Street
Center Moriches, N.Y. 11934
Phone: (631) 400-9173

THESE PLANS ARE INSTRUMENTS OF SERVICE AND ARE THE PROPERTY OF THE ARCHITECT. INSTRUMENTS WILL BE PHOTOGRAPHED.

NO COPIES OF THIS PLAN MAY BE LOANED ASSUMING ANY OTHER COPIES WILL BE MADE WITHOUT THE WRITTEN CONSENT OF THE PRINCIPAL OF KODAK ARCHITECTURE. VIOLATION OF THIS ORDER WILL BE PROSECUTED TO THE FULL EXTENT OF THE COPYRIGHT LAWS HAVING JURISDICTION.

GENERAL CONTRACTORS TO VERIFY ALL CONDITIONS AND DIMENSIONS AT PREMISES DISCREPANCIES SHALL BE REPORTED TO THE ARCHITECT PRIOR TO COMMENCEMENT OF ANY WORK.

REVISIONS

[illegible]

DRAWING DISTRIBUTION


[illegible]

PROPOSED LEGALIZATION OF
INTERIOR RENOVATION FOR:
NETWORK TECHNOLOGY SOLUTIONS, INC.,
100 NEW SOUTH RD
HICKSVILLE, NY

PLAYING TITLE

AS-BUILT PLAN

DESIGN BY:	JBU
CHECKED BY:	GSU
SCALE:	AS SHOWN
DATE:	3-17-26
DRAWING NO.	
A-100.00	
PROJECT NO.	2615N

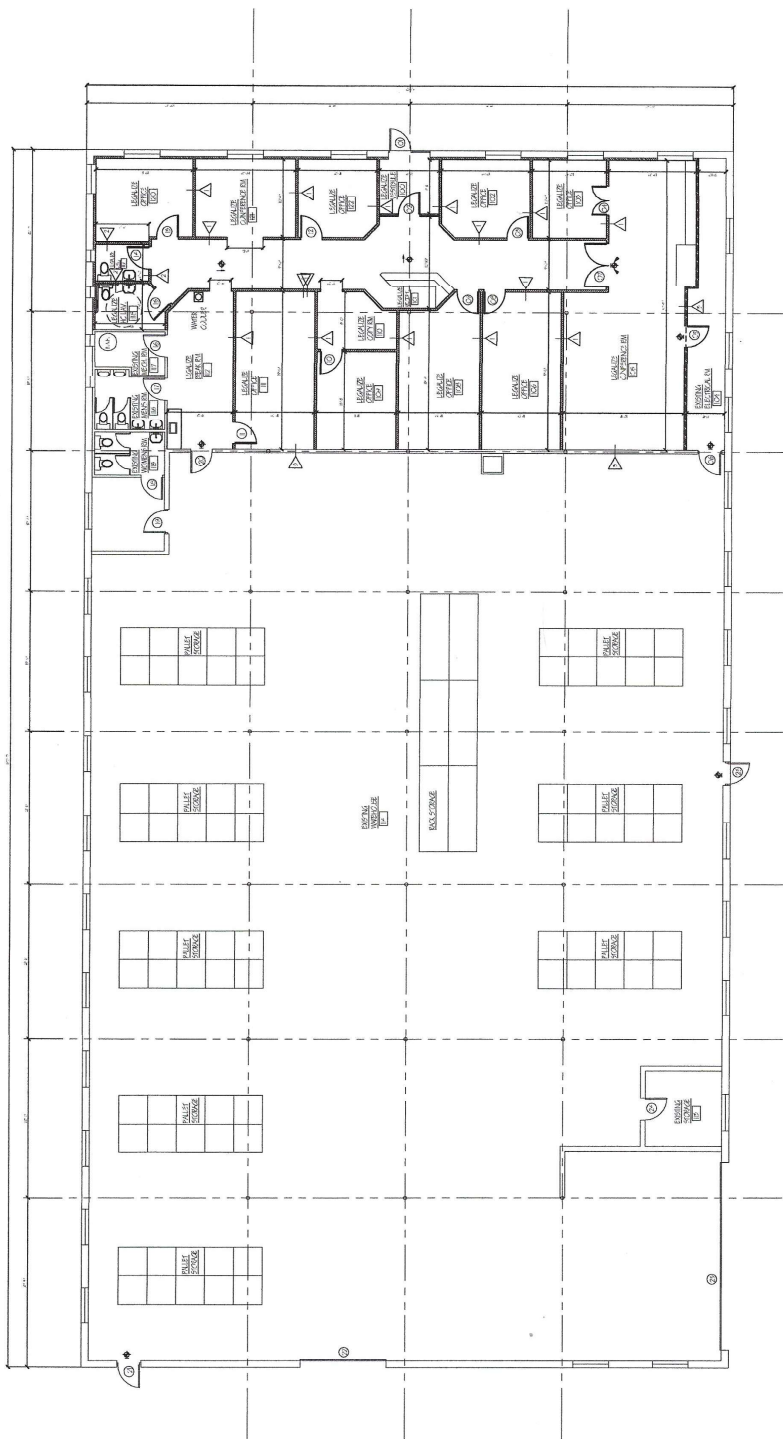

AS-BUILT FLOOR PLAN

SCALE: 1/8" = 1'-0"

PARTITION LEGEND

	EXISTING PARTITION
	EXISTING PARTITION TO BE REMOVED
	NEW PARTITION TO BE LEGAL DEED
	EXISTING 2 HIRE BAYED PARTITION
	EXISTING FOUNDATION WALLS