


41 40 39 38 37 36 35 34 33 32 31 30 29 28 27 26 25 24 23 22 21 20 19 18 17 16 15 14 13 12 11 10 9 8 7 6 5 4 3 2 1

011103 - NMO10
DRAWING NUMBER

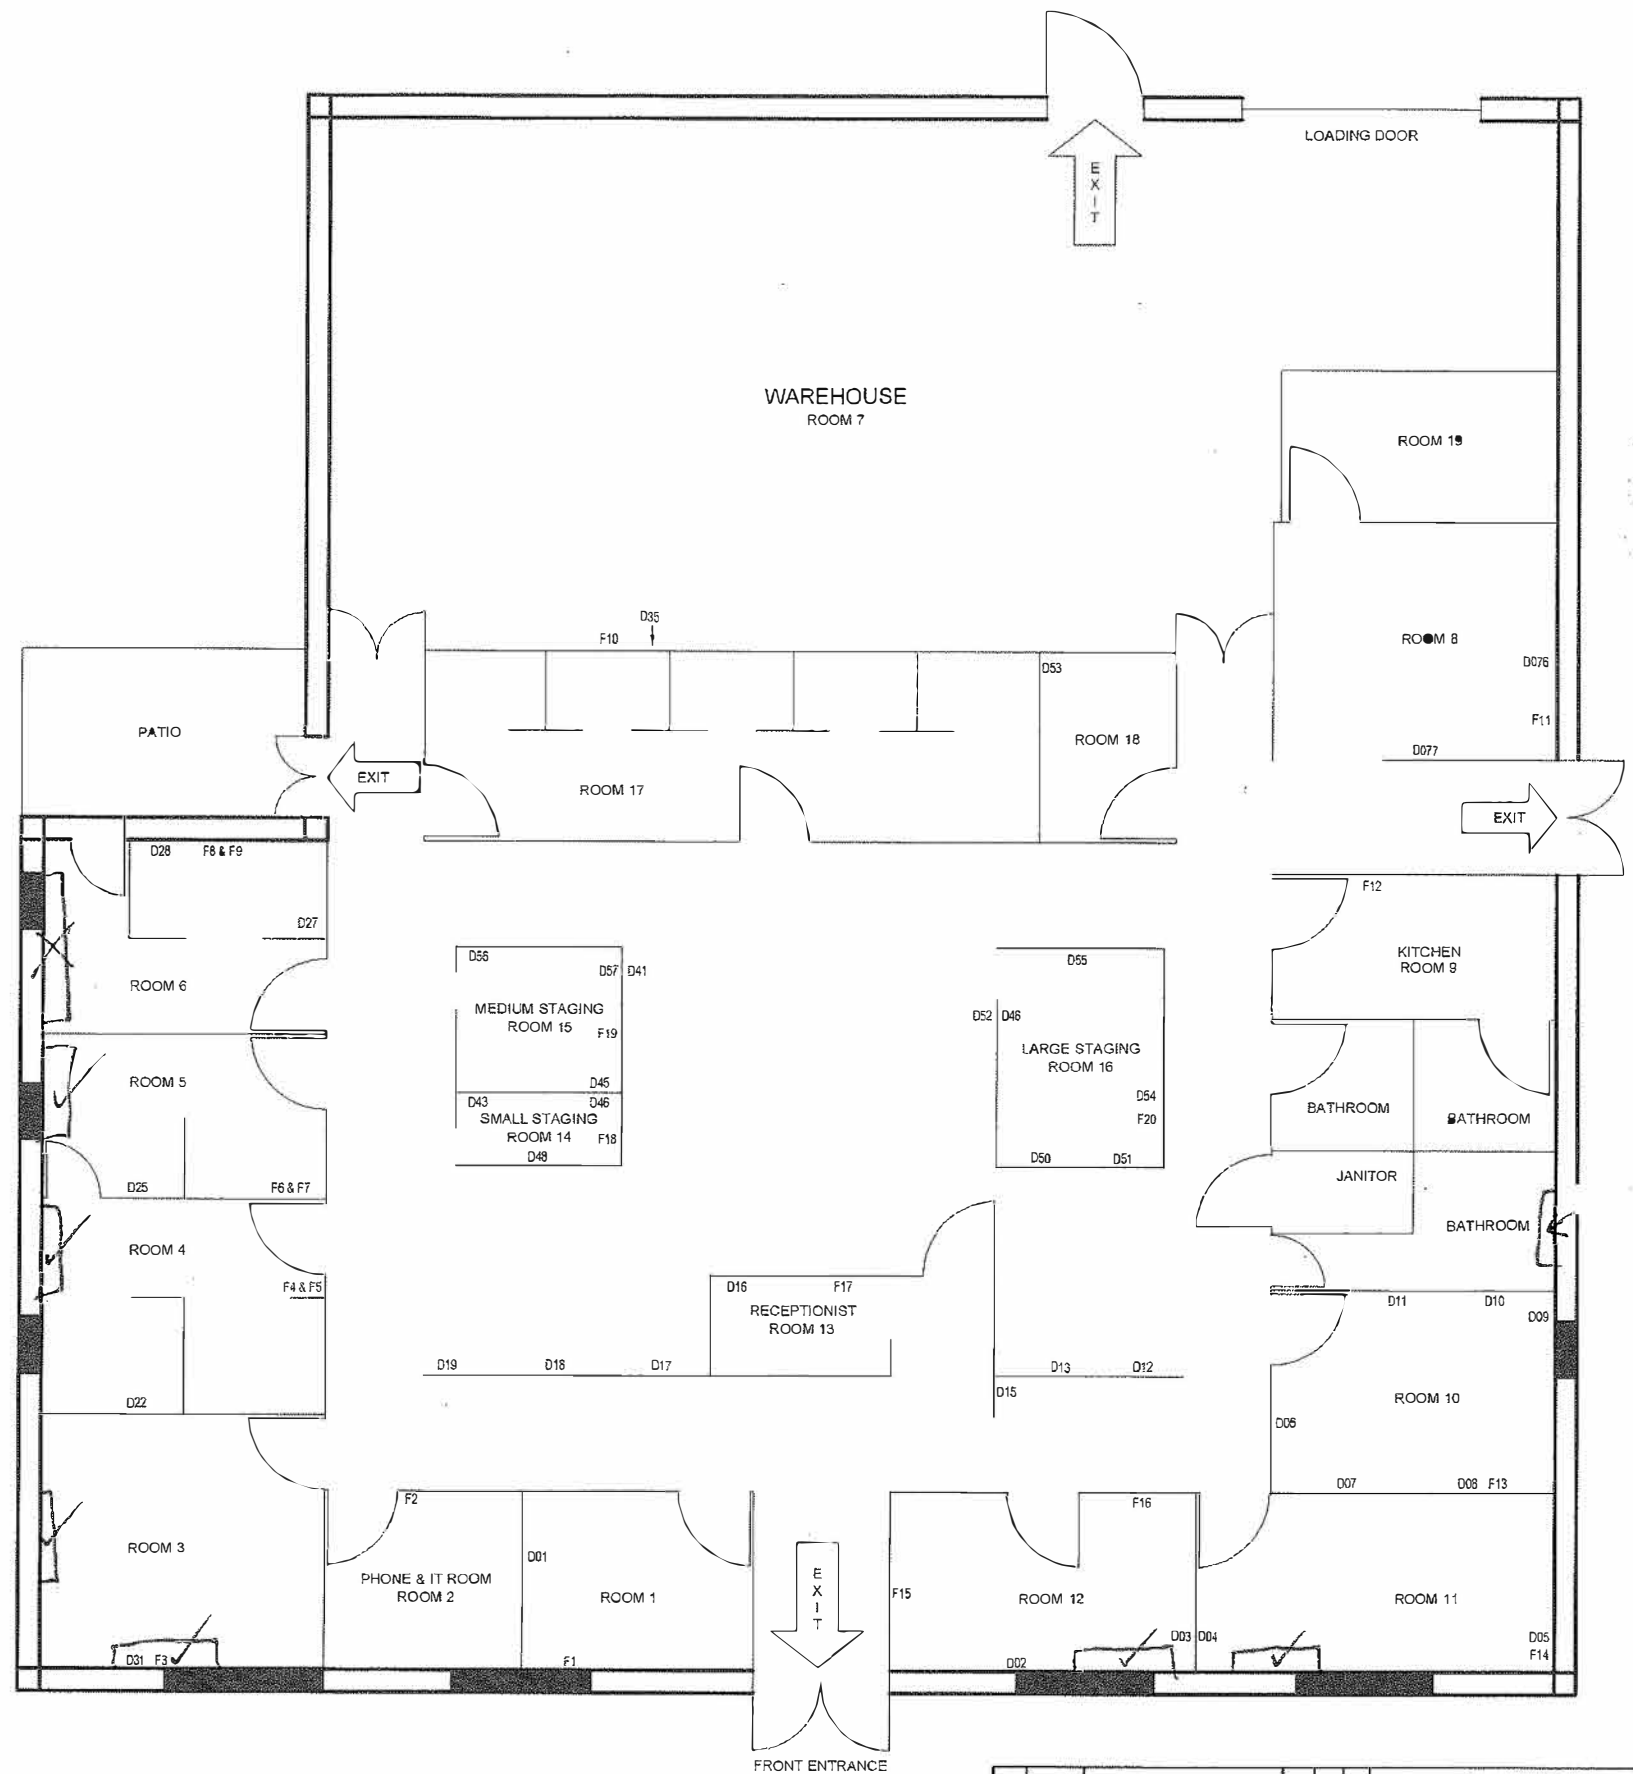

A
B
C
D
E
F
G
H
I
J
K
L
M
N
O
P
Q
R
S
T
U
V
W
X
Y
Z

DRAWING NUMBER
QTOWN - COMMO

NO.	DATE	DESCRIPTION	BY	CHKD	APPD
0	04/03/13	AS BUILT	J.M.L.	J.M.L.	

THIS DRAWING IS OUR PROPERTY AND ALL THE INFORMATION CONTAINED THEREIN IS TO BE KEPT CONFIDENTIAL BY THE RECEPTOR AND NOT TO BE USED OR DISCLOSED TO ANY OTHER PERSON, FIRM OR CORPORATION WITHOUT OUR EXPRESS CONSENT. AND THE RECEPTOR SHALL NOT BE USED, DIRECTLY OR INDIRECTLY, IN CONNECTION WITH OUR WORK. ALL RIGHTS OF DESIGN OR INVENTION ARE RESERVED.

DESIGNED BY	J. LAVERE	DATE	04/03/13	DRAWN BY	J. MCKINLEY
CHECKED BY	J. MCKINLEY	SCALE	NONE	PROJECT NO.	DEX120126

REV. A