

COMMERCIAL - Review Set

Address: 124 E COSTILLA ST COLORADO SPRINGS
Plan Track #: 44433 Received: 21-mar-2007

Required Departments (10) (SHELLEY)

Description:

INTERIOR REMODEL - CHG OF USE (CIGAR BAR)

64183-10-022

App Dis N/A By

Contractor: T-BONE CONSTRUCTION, INC.

Sets of Plans: 1

Permit # 624594 Zone C6 City / County

APPROVED FOR CONSTRUCTION

Date 05.03.07

By al

Plan-Check Fee: 0.00

(0)

Code

031BC05 PPRB11

Occupancy Class

B, A2, M

Type of Construction

VB

Floor or # of stories

1

Square-Feet/Floor

2705

Occupancy Load

144

Fire Sprinkled for:

() Area

() Height

() Bsmt

() 1-Hr Sub

() Occ/Use

() Other

() N/A

Mixed Use () Acc. () Separate () N/A () Combined () N/A

Fire Wall () Yes () No Largest Area

Horizontal Assembly: () Structure () Drop Clg

Alt. Fire Hazm/HP

Fire:

Page: 1

Enumeration [X] [] [] []
Zoning/Planning [X] [] [] []
Construction [X] [X] [] []
Mechanical [X] [] [] []
Plumbing [X] [X] [] []
Electrical [X] [X] [] []
Fire [X] [] [] []
Hazmat/High Pil [] [] [] []
Waste Water Div [X] [X] [] []
Water Division [X] [X] [X] []
Health Dept [X] [] [] []

mk 3-21-07

Plan 2 12/11/07

4/16/07 to 4-20-07

4/21/07 see other set

mk 3-21-1 mk 4-11-7

22 March 07 see other set mk 4-11-7

SLE 3-21-7 see other set SLE 4-11-7

mk 4-23-07 Fully Sprinkled

mk 4-23-07

mk 4-23-07

LD 4/30/07 Contact Air quality if asbestos is found

mk 4/30/2007

mk 4/30/2007

See Stamp

Signage is not approved with this plan. A separate sign permit is required. Contact Development Review at 2920 International Circle. See 200 sign plan applications.

Disapproved by Utilities Development Services

☐ CS Fire Department approval of the RBD plans set is required prior to Water RBD approval by Utilities Development Services.

☐ Water civil construction plans must be approved by Utilities Development Services and included in the RBD plan set.

☐ Waste water civil construction plans must be approved by Utilities Development Services and included in the RBD plan set.

☐ Plumbing plans must specify a Reduced Pressure Backflow Device.

☐ Additional information is required. Please call _____ at _____

☒ Call Michael Truitt at 648-3683

To schedule appointments or for general information, please call 719.668.8259.

- Construction
- Mechanical
- Plumbing
- Electrical
- Fire



MICHAEL E. HARVEY, P.E., LLC
MECHANICAL CONSULTING ENGINEER
21041 Sandhollow Circle
Las Vegas, NV 89134
P: 720-851-8855 / F: 720-851-8833



Design & Development
Consultants @

(719) 570-1455
1880 VANDERBILT BLVD., SUITE 100
SAN DIEGO, CA 92108

THE COBALT CLUB

06-0132

NOTICE
THIS DOCUMENT IS THE PROPERTY OF T-BONE CONSULTANTS. IT IS TO BE USED ONLY FOR THE PROJECT AND SITE SPECIFICALLY IDENTIFIED HEREON. IT IS NOT TO BE REPRODUCED, COPIED, OR TRANSMITTED IN ANY FORM OR BY ANY MEANS, ELECTRONIC OR MECHANICAL, INCLUDING PHOTOCOPYING, RECORDING, OR BY ANY INFORMATION STORAGE AND RETRIEVAL SYSTEM, WITHOUT THE WRITTEN PERMISSION OF T-BONE CONSULTANTS.

REVISED


THE COBALT CLUB
BASEMENT & FIRST MECHANICAL PLANS

330 S. NEVADA


DATE: 4/5/07
DRAWN BY: MEH

SHEET #
M2

2 of 2

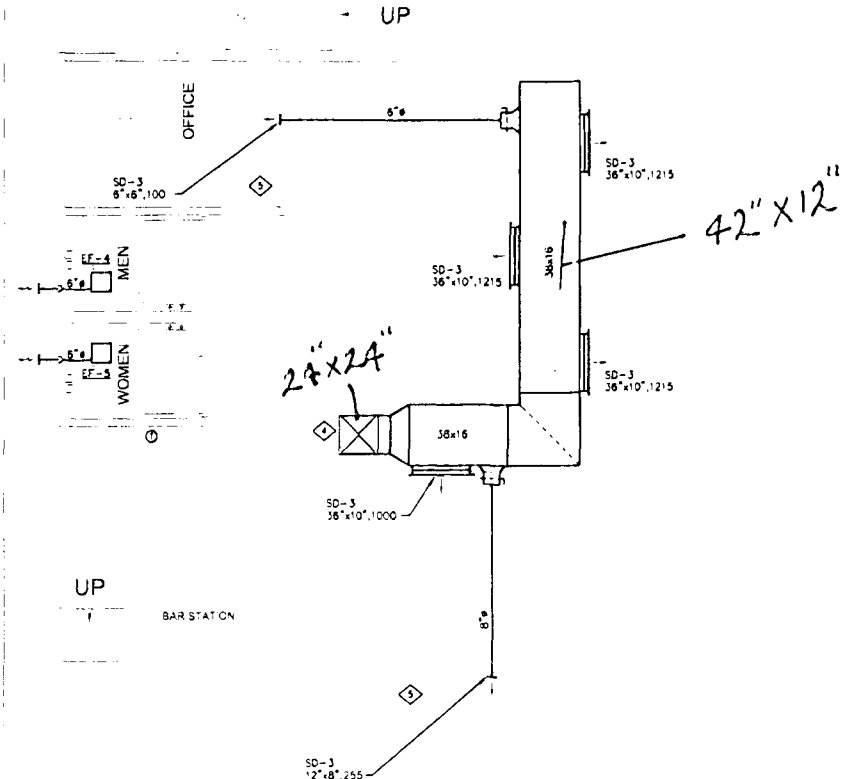

BASEMENT HVAC PLAN
SCALE: 1/4" = 1'-0"

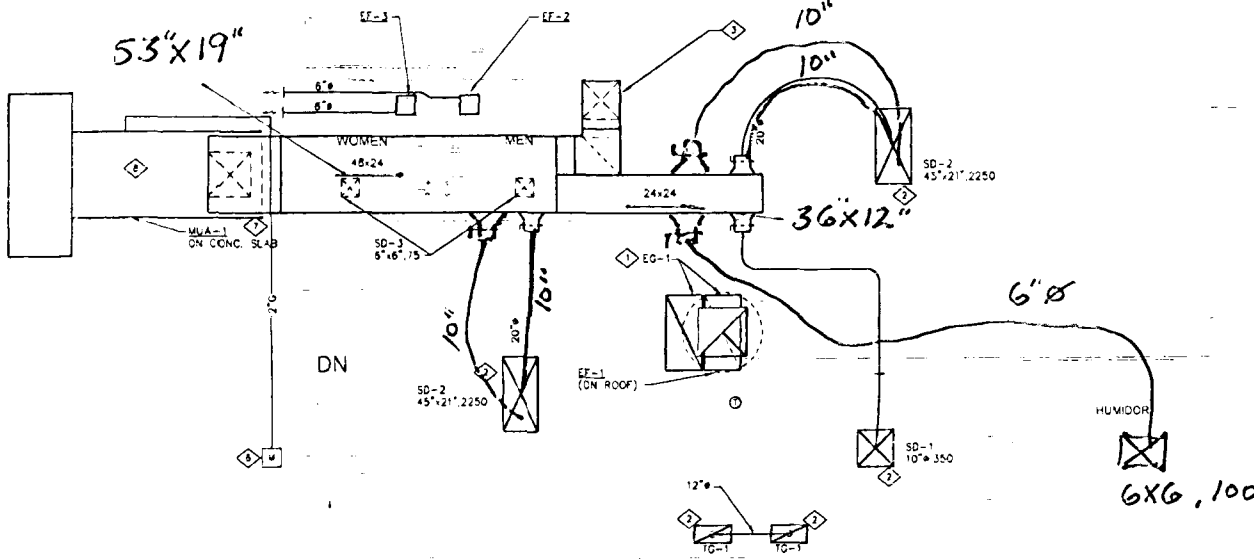

FIRST FLOOR HVAC PLAN
SCALE: 1/4" = 1'-0"

GENERAL NOTES:

- COORDINATE FLOOR AND/OR ROOF PENETRATIONS WITH G.C. AND STRUCTURAL ENGINEER.
- CONTRACTOR TO REMOVE (E)ABANDONED IN PLACE RTU'S ASSOCIATED CURBS AND DUCTWORK.
- COORDINATE LOCATION OF (N)MUA'S ON ROOF WITH (E)EQUIPMENT AND (E)GAS PIPING. RELOCATE (E)GAS PIPING AS REQUIRED.

WORK NOTES:

- TRANSITION AS REQUIRED FOR CONNECTION TO EXHAUST GRILLE EG-1. COORDINATE LOCATION W/CEILING GRID.
- COORDINATE LOCATION OF GRID WITH (N)CEILING GRID.
- 24"x24" S.A. DUCT DOWN IN CHASE BY G.C.
- 24"x24" S.A. DUCT UP.
- PROVIDE TG-2, 12"x12" BOTH SIDES OF DOOR.
- (N)GAS METER. COORDINATE WITH UTILITY COMPANY FOR GAS LOAD OF 1310 CFH AT 1/4" W.C.
- SUPPORT DUCTWORK AS REQUIRED ALONG EXTERIOR OF BUILDING.
- VERIFY FINAL LOCATION OF UNIT WITH G.C. PRIOR TO PLACEMENT. MAINTAIN REQUIRED CLEARANCES FROM INTAKES INTO BUILDING PER CODE.

REGIONAL BLDG. DEPT
APR 11 2007
APPROVED BY RLK



REGIONAL BLDG. DEPT.

OCT 23 2007

APPROVED BY TCC

Calvin Design
OK

PROJECT: 187, 188, 189, 999, 1000

T-BONE
CONSTRUCTION INC.
GENERAL CONTRACTOR

THE COBALT CLUB
TENANT FINISH


06-0132


NOTICE:

THIS DRAWING CONTAINS MATERIAL AND INFORMATION WHICH MAY NOT BE REPRODUCED WITHOUT WRITTEN CONSENT OF T-BONE CONSTRUCTION, INC. THESE DRAWINGS ARE THE PROPERTY OF T-BONE CONSTRUCTION AND ITS REPRESENTATIVES. THESE DRAWINGS HAVE NOT BEEN PREPARED FOR ANY OTHER PURPOSE THAN TO INDICATE THE GENERAL CONCEPTS OF THE INDICATED PROJECT. T-BONE CONSTRUCTION, INC.

CP	SHEET #		TENANT REMODEL	REVISION
			COVER SHEET	
			124 "E" COSTILLA STREET	
	DRAWN BY: JAC	CHK BY: DATE: 3/20/07		

REGIONAL BLDG. DEPT.
APR 20 2007

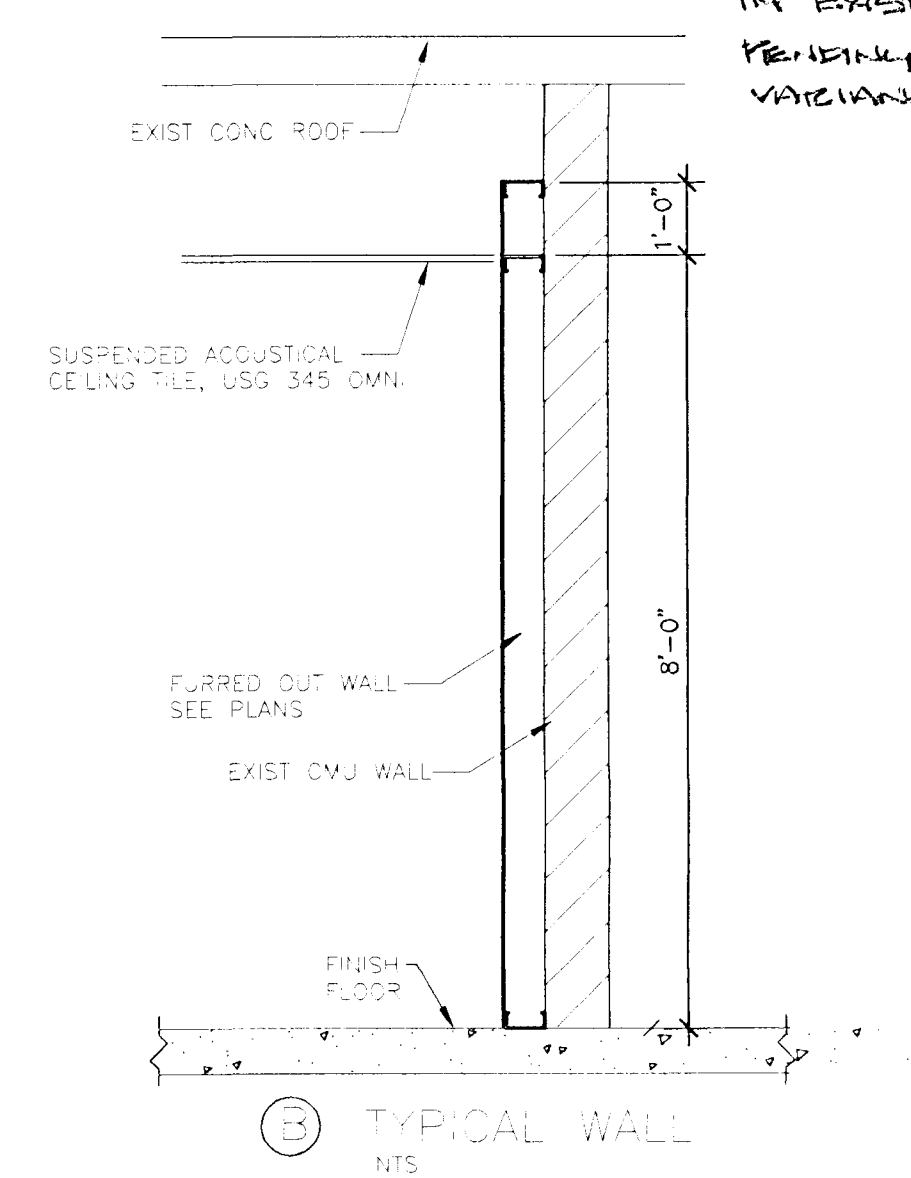

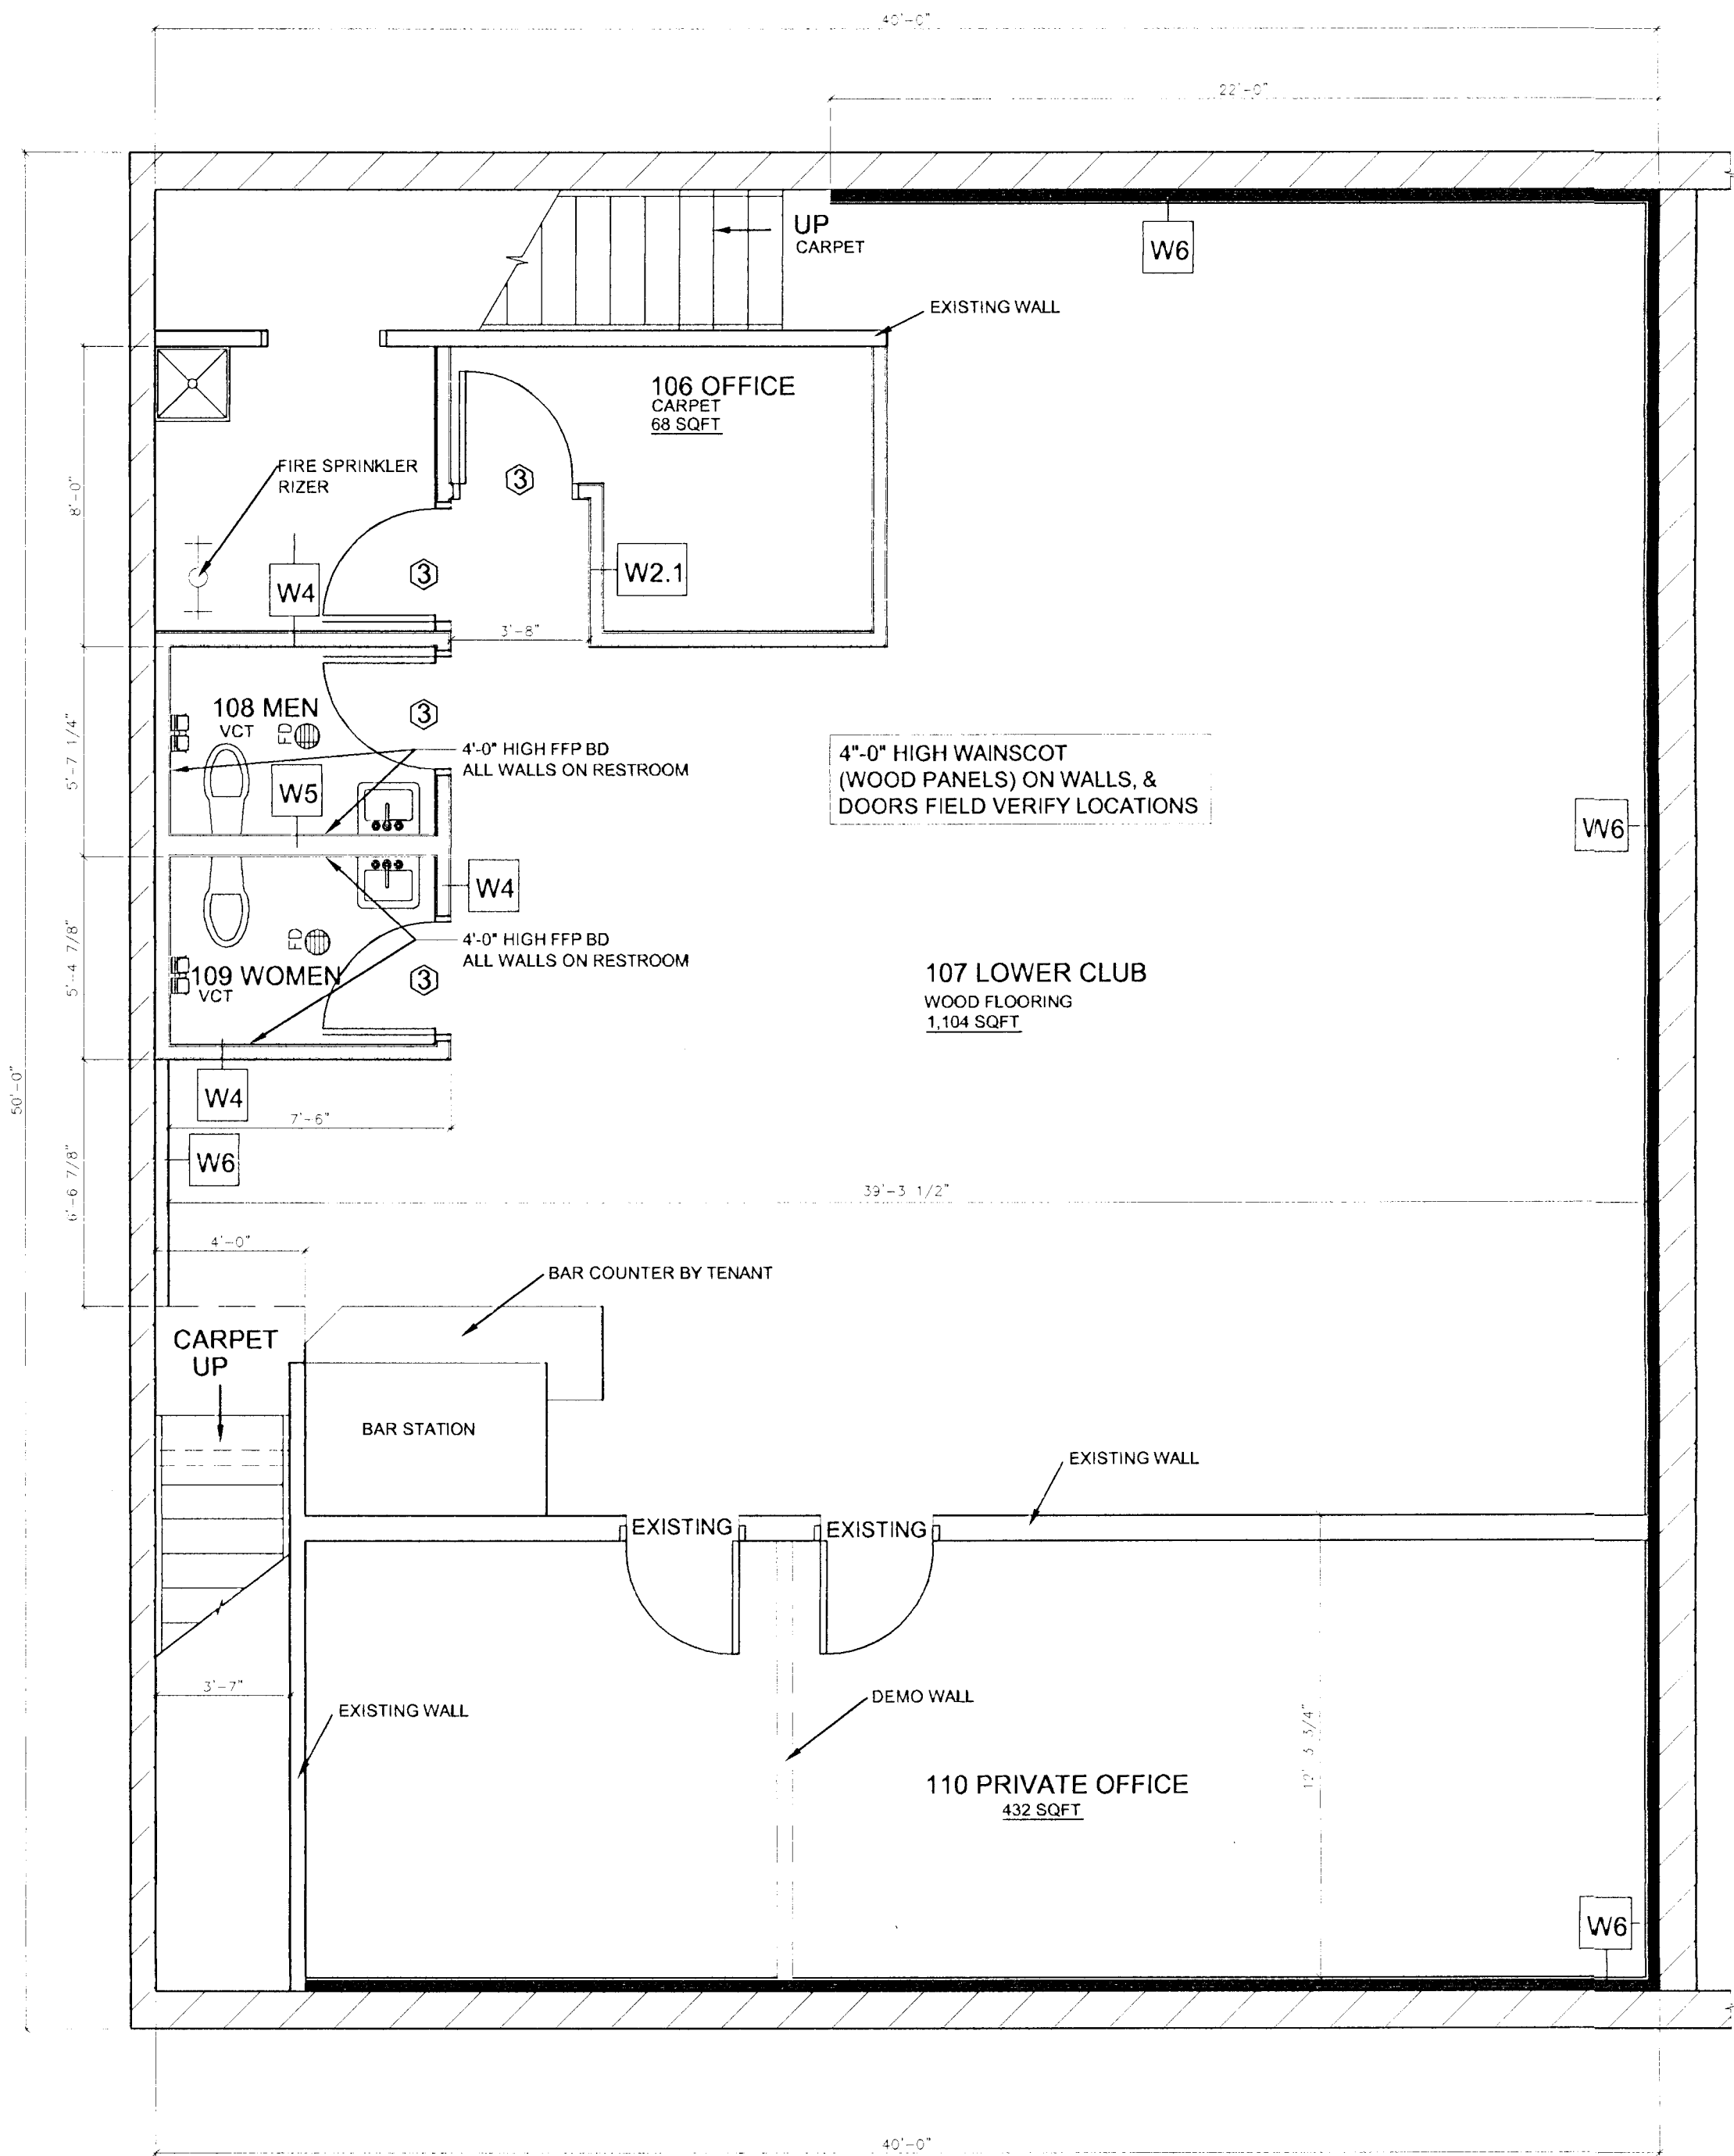

BASEMENT FLOOR PLAN

SCALE: 1/4"=1'-0"

WALL SCHEDULE		
WALL NUMBER	WALL DESCRIPTION	NOTES
W1 EXIST.	25 GA. 3 5/8" METAL STUDS @ 16" O.C. W/ 5/8" TYPE "X" GYP.BD. BOTH SIDES TO 12" ABOVE CEILING W/ R-19 SOUND BATT INSULATION	
W2	2X4 WOOD STUDS @ 16" O.C. W/ 5/8" TYPE "X" GYP.BD. BOTH SIDES TO 12" ABOVE CEILING	NEW WALL PATCH AND PAINT
W2.1	SAME AS W2, W/ 3 5/8" MTL STUDS	
W3	2X4 WOOD STUDS @ 16" O.C. W/ 5/8" TYPE "X" GYP.BD. ONE SIDES, 1X CEDAR PLANKS, TYP INSIDE OF HUMIDOR	NEW WALL PATCH AND PAINT
W3.1	2X4 WOOD STUDS @ 16" O.C. W/ 1X CEDAR PLANKS, TYP INSIDE OF HUMIDOR	
W4	25 GA. 6" METAL STUDS @ 16" O.C. W/ 5/8" GREEN GYP.BD. ONE SIDE. 5/8" TYPE "X" OTHER SIDE	NEW WALL PATCH AND PAINT
W5	25 GA. 3 5/8" METAL STUDS @ 16" O.C. W/ 5/8" GREEN GYP.BD. EACH SIDE	NEW WALL PATCH AND PAINT
W6	25 GA. 3 5/8" METAL STUDS @ 16" O.C. W/ 5/8" TYPE "X" GYP.BD. ONE SIDE, TO 12" ABOVE CEILING	NEW WALL PATCH AND PAINT

DOOR & FRAME SCHEDULE							
DOOR NO.	DOOR			FRAME		NOTES	
	DESCRIPTION	MAT.	FIN.	GLAZING	MAT. FIN.		
1	3'-0" X 7'-0"	STOR		TEMP	M		
2	3'-0" X 6'-8"	SC	S&V		WD S&V	LOCK SET	
3	3'-0" X 6'-8"	SC	S&V		WD S&V	PRIVACY LOCK ADA SIGNAGE (MAIN FLOOR ONLY)	
4	3'-0" X 7'-0"	STOR		TEMP	M	LOCK SET	
5	3'-0" X 6'-8"	SC	S&V		WD S&V	OFFICE LOCK SET	

ABBREVIATIONS / SPEC'S.

PNT. PAINTED M. METAL DOOR
S&V STAIN & VARNISH STOR. STOREFRONT, TEMP./INSULATED
S.C. SOLID CORE WOOD DOOR WD WOOD
PROVIDE EXITING HARDWARE AS NEEDED
PROVIDE SIGNAGE "DOOR TO REMAIN OPEN DURING REGULAR BUSINESS HOURS"

REGIONAL BLDG. DEPT.
APR 16 2007
APPROVED BY: [Signature]

THE COBALT CLUB

BASEMENT PLAN

124 "E" COSTILLA STREET

DRAWN BY: JAG
CHK BY: [Signature]
DATE: 2/20/07

REVISIONS

3/19/07
3/23/07
E.M.

06-0132

NOTICE: [Text]

Design & Development Consultants @


T-BONE CONSTRUCTION GENERAL CONTRACTORS

(719) 570-1456
1330 VALLEY STREET
COLORADO SPRINGS, CO 80915


SHEET #

A2

DUCTWORK

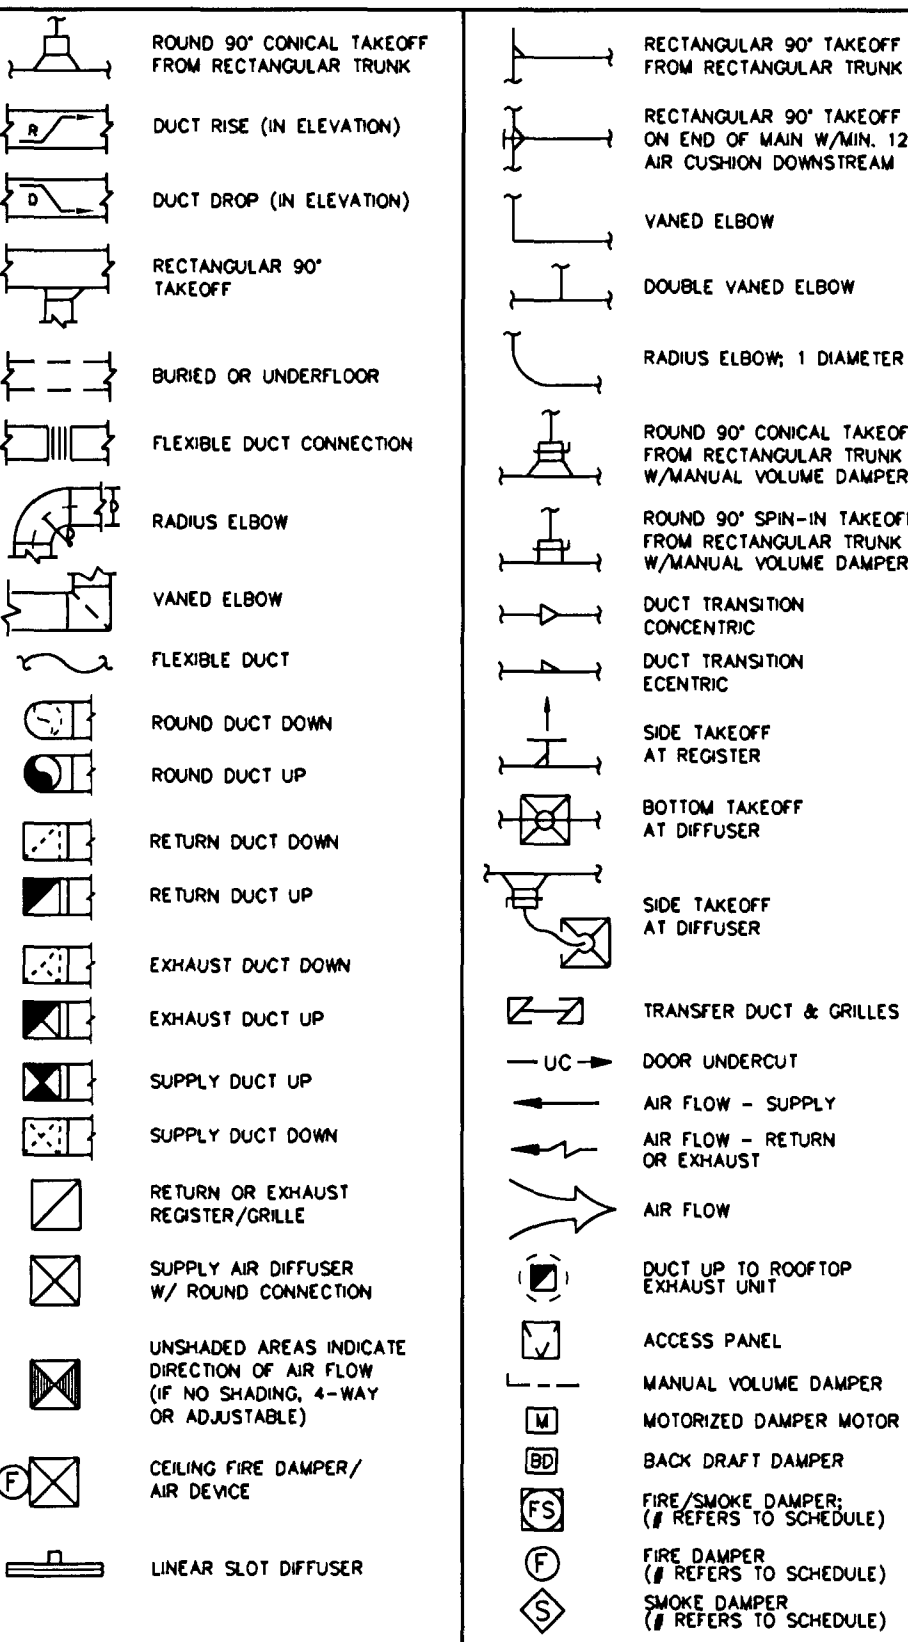

MISCELLANEOUS

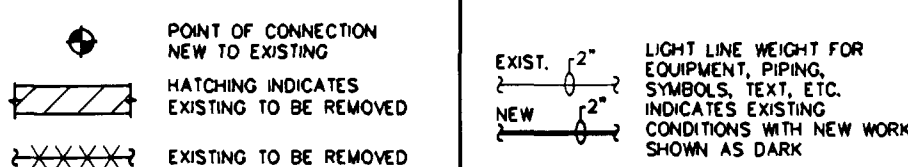

ABBREVIATIONS

AFF	ABOVE FINISHED FLOOR	OA	OUTSIDE AIR
AP	ACCESS PANEL	RA	RETURN AIR
DIA. D	DIAMETER	SA	SUPPLY AIR
EA	EXHAUST AIR	TYP	TYPICAL
MA	MIXED AIR	(N)	NEW
MD	MOTORIZED DAMPER	(E)	EXISTING
MVD	MANUAL VOLUME DAMPER	(R)	RELOCATED
NIC	NOT IN CONTRACT		

HVAC GENERAL NOTES:

- THE EQUIPMENT SPECIFIED ON THE DRAWINGS HAVE BEEN SELECTED AS THE BASIS DESIGN. THE USE OF REVIEWED OR SPECIFIED EQUALS SHALL BE COORDINATED BY THE CONTRACTOR AS TO SPACE REQUIREMENTS, EQUIPMENT DIMENSIONS AND PERFORMANCE.
2. (E) INDICATES EXISTING, (N) INDICATES NEW MATERIAL, (F) INDICATES FUTURE.
3. ♦ INDICATES POINT OF CONNECTION OF NEW TO EXISTING.
4. COORDINATE ALL DIFFUSER AND GRILLE LOCATIONS WITH ARCHITECTURAL REFLECTED CEILING PLAN AND ELECTRICAL DRAWINGS.
5. DRAWINGS ARE DIAGRAMMATIC AND SHOW THE GENERAL DESIGN, ARRANGEMENT AND EXTENT OF SYSTEMS. DO NOT SCALE DRAWINGS NOR USE AS SHOP DRAWINGS. WHERE ALTERNATE ROUTING, OFFSETS AND TRANSITIONS ARE REQUIRED FOR COORDINATION OF ALL WORK, THIS CONTRACTOR SHALL MAKE CHANGES WITHOUT ADDITIONAL COSTS.
6. CONTRACTOR SHALL NOT SHUT-OFF/PUT OUT OF SERVICE ANY SYSTEMS/SERVICES WITHOUT FIRST COORDINATING ALL DOWNTIME WITH OWNER'S PERSONNEL.
7. ALL EQUIPMENT SHALL BE INSTALLED IN ACCORDANCE WITH MANUFACTURER'S RECOMMENDATIONS UNLESS SPECIFICALLY DIRECTED OTHERWISE.
8. CONTRACTOR SHALL BE RESPONSIBLE FOR LOCATION AND INSTALLING SLEEVES, INSERTS AND SUPPORTS AS REQUIRED FOR HIS WORK AND /OR CORE DRILL REQUIREMENTS.
9. CONTRACTOR SHALL CLOSELY COORDINATE NEW MECHANICAL WITH ALL NEW AND EXISTING MECHANICAL, ELECTRICAL, ARCHITECTURAL AND STRUCTURAL MEMBERS.
10. ALL MECHANICAL SYSTEMS SHALL BE INSTALLED IN ACCORDANCE WITH CURRENT VERSION OF INTERNATIONAL BUILDING CODE, INTERNATIONAL FIRE CODE, INTERNATIONAL MECHANICAL CODE, AND INTERNATIONAL PLUMBING CODE; INCLUDING LOCAL AMENDMENTS.
11. CONTRACTOR SHALL PROVIDE SUBMITTALS ON ITEMS LISTED IN MECHANICAL EQUIPMENT SCHEDULE TO THE ENGINEER FOR REVIEW PRIOR TO THE ORDER, PURCHASE OR INSTALLATION OF THESE SAME ITEMS.
12. CONVENTIONS USED IN THE PRESENTATION OF THE CONTRACT DOCUMENTS:
 - A. CFM IS AT ALTITUDE OF PROJECT.
 - B. STATIC PRESSURES AND AIR PRESSURE DROPS ARE AT SEA LEVEL.
 - C. HEATING AND COOLING CAPACITIES ARE AT ALTITUDE OF PROJECT.
 - D. HORSEPOWERS ARE CORRECTED FOR ALTITUDE.
 - E. NATURAL GAS INPUTS ARE AT SEA LEVEL.
13. ALL EXISTING EQUIPMENT TO BE REMOVED SHALL HAVE ALL RELATED HOUSEKEEPING PADS, PIPING, CONTROLS, GAUGES, ELECTRICAL SERVICE, HANGERS, SUPPORTS AND ANY MISCELLANEOUS RELATED SERVICE OR PARTS REMOVED COMPLETELY.
14. CONTRACTOR SHALL USE SMACNA STANDARDS FOR DUCT CONSTRUCTION.
15. ALL DUCT DIMENSIONS ARE OUTSIDE DIMENSIONS. ALL RECTANGULAR SUPPLY AND RETURN, RIGID ROUND SUPPLY AND RETURN DUCTWORK SHALL BE WRAPPED WITH MINIMUM 2" THICK-.075 LB/CU. FT DENSITY DUCTWRAP WITH VAPOR BARRIER (MIN. R-VALUE .5). LOW PRESSURE ROUND FLEXIBLE DUCT TO BE 1½" THICK INSULATED AND A MAXIMUM OF 8 FT. LONG WITH VAPOR BARRIER. SUPPLY AIR AND RETURN AIR DUCTWORK LOCATED WITHIN THE CONDITIONED SPACE IS NOT REQUIRED TO BE INSULATED. ALL EXPOSED DUCTWORK SHALL BE INSULATED WITH 2" (R-8) INSULATION. *# jacketed if external insulation.*
16. MOUNT THERMOSTAT AT 42° ON CENTER ABOVE FINISHED FLOOR UNLESS OTHERWISE NOTED. *ADA REQUIREMENT. # shall comply w/IECC 05*
17. GUARANTEE-CONTRACTOR SHALL REPLACE ANY WORK OR MATERIAL INSTALLED OR FURNISHED UNDER THIS CONTRACT WHICH DEVELOPS DEFECTS, EXCEPT FOR NORMAL WEAR, WITHIN ONE (1) YEAR AFTER CERTIFICATE OF COMPLETION IS SECURED.
18. TESTING, ADJUSTING AND BALANCING-TOTAL SYSTEM BALANCE SHALL BE PERFORMED IN CONFORMANCE WITH NEBB PREPARED STANDARD PRACTICES FOR TESTING, BALANCING AND ADJUSTING OF ENVIRONMENTAL SYSTEMS. SUBMIT TEST REPORTS, FOR TESTING, ADJUSTING AND BALANCING. *Provide balance report w/ inspection of it's*
19. NATURAL GAS PIPING ABOVE GROUND TO BE OF THE FOLLOWING MATERIALS: PIPING 2½" AND SMALLER TO BE SCHEDULE 40 BLACK SEAMLESS STEEL PIPE PER ASTM A53. PIPING 2" AND SMALLER TO HAVE MALLEABLE IRON SCREWED FITTINGS (150 LB CLASS) WITH THREADED JOINTS USING JOINT COMPOUND RESISTANT TO GAS-AIR MIXTURE. PIPING 2½" AND LARGER TO USE 150LB CLASS SEAMLESS CARBON STEEL WELDING FITTINGS WITH BUTT WELDED JOINTS.

GRILLES, REGISTERS & DIFFUSER SCHEDULE

[illegible]

REMARK NOTES:

FAN SCHEDULE

[illegible]


REMARK NOTES:

- ① SUPPORT FROM STRUCTURE. INTERLOCK WITH ROOM LIGHT SWITCH. INTERLOCK BY E.C. COORDINATE REQUIREMENTS WITH E.C. PROVIDE W/SPEED CONTROL SWITCH.
- ② TERMINATE VENT THRU WALL WITH MANUFACTURER'S VENT KIT.
- ③ INTERLOCK WITH MAKE UP AIR UNIT.
- ④ VERIFY LOCATION WITH STRUCTURAL ENGINEER PRIOR TO SETTING EQUIPMENT.

MAKE-UP AIR UNIT SCHEDULE

[illegible]

- ① PROVIDE WITH FILL AND DRAIN KIT. WATER CONNECTION BY OTHERS.
- ② PROVIDE WITH STARTER, REMOTE CONTROL PANEL, HEAT/COOL INLET AIR SENSOR.
- ③ PROVIDE STAINLESS STEEL HEAT EXCHANGER.
- ④ PROVIDE AN AIR FLOW PROVING SWITCH WITH THE MAKE-UP AIR UNIT TO PREVENT THE GAS VALVES FROM OPENING PRIOR TO PROOF OF FLOW.

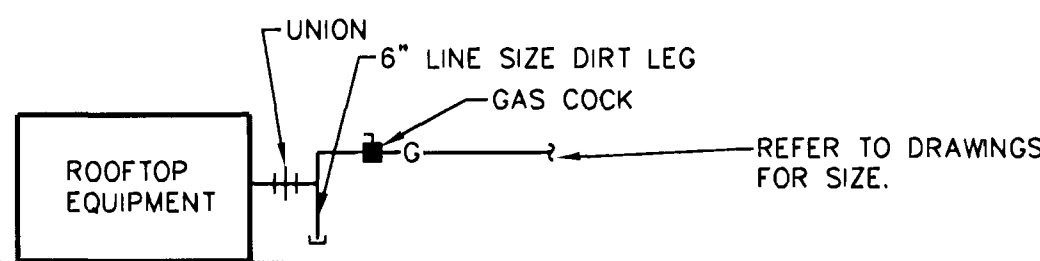

TYPICAL GAS TO MUA DETAIL

NOT TO SCALE

MICHAEL E. HARVEY, P.E., LLC
MECHANICAL CONSULTING ENGINEER
 21041 Saddleback Circle
 Parker, CO 80138
 P: 720-851-6555 / F: 720-851-6633

P: 720-851-6555 / F: 720-851-6633

Development

*Design & Development
Consultants @*

THE COBALT
CLUB

06-0132

NOTICE:
THIS DRAWING CONTAINS MATERIAL AND INFORMATION WHICH MAY NOT BE REPRODUCED WITHOUT WRITTEN PERMISSION OF T-BONE CONSTRUCTION, INC. THESE DRAWINGS ARE INTENDED TO BE USED ONLY BY T-BONE CONSTRUCTION AND ITS REPRESENTATIVES. THESE DRAWINGS HAVE NOT BEEN PREPARED FOR ANY OTHER PURPOSE THAN TO INDICATE THE GENERAL LAYOUT AND FEATURES OF THE INDICATED PROJECT.

REVISÉ

THE COBALT CLUB
BASEMENT MECHANICAL PLAN

DRAWN BY:	CHK BY:	DATE:
-----------	---------	-------

DRAWN BY:



SHEET #

M1

1 of 2

REGIONAL BLDG. DEPT
APR 11 2007
APPROVED BY RLK



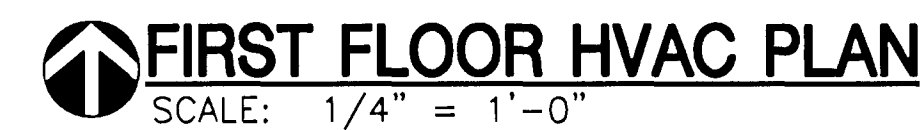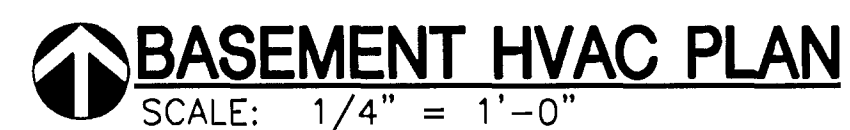

1. COORDINATE FLOOR AND/OR ROOF PENETRATIONS WITH G.C. AND STRUCTURAL ENGINEER.
2. CONTRACTOR TO REMOVE (E)ABANDONED IN PLACE RTU'S ASSOCIATED CURBS AND DUCTWORK.
3. COORDINATE LOCATION OF (N)MUA'S ON ROOF WITH (E)EQUIPMENT AND (E)GAS PIPING. RELOCATE (E)GAS PIPING AS REQUIRED.

- ① TRANSITION AS REQUIRED FOR CONNECTION TO EXHAUST GRILLE EG-1. COORDINATE LOCATION W/CEILING GRID.
- ② COORDINATE LOCATION OF GRD WITH (N)CEILING GRID.
- ③ 24"x24" S.A. DUCT DOWN IN CHASE BY G.C.
- ④ 24"x24" S.A. DUCT UP.
- ⑤ PROVIDE TG-2, 12"x12" BOTH SIDES OF DOOR.
- ⑥ (N)GAS METER. COORDINATE WITH UTILITY COMPANY FOR GAS LOAD OF 1310 CFH AT 14" W.C.
- ⑦ SUPPORT DUCTWORK AS REQUIRED ALONG EXTERIOR OF BUILDING.
- ⑧ VERIFY FINAL LOCATION OF UNIT WITH G.C. PRIOR TO PLACEMENT. MAINTAIN REQUIRED CLEARANCES FROM INTAKES INTO BUILDING PER CODE.

REGIONAL BLDG. DEPT
APR 11 2007
APPROVED BY RLK



*Design & Development
Consultants @*
(719) 570-1456
1330 VALLEY STREET
COLORADO SPRINGS, CO 80915

THE COBALT
CLUB

70-0132

THIS DRAWING CONTAINS MATERIAL AND INFORMATION WHICH MAY NOT BE REPRODUCED WITHOUT WRITTEN CONSENT OF T-BONE CONSTRUCTION, INC. THESE DRAWINGS ARE INTENDED TO BE USED ONLY BY T-BONE CONSTRUCTION AND ITS REPRESENTATIVES. THESE DRAWINGS HAVE NOT BEEN PREPARED FOR ANY OTHER PURPOSE THAN TO INDICATE THE GENERAL PLACEMENT AND FEATURES OF THE INDICATED PROJECT. T-BONE CONSTRUCTION, INC.

1000

THE COBALT CLUB BASEMENT & FIRST MECHANICAL PLANS

DATE: 4/5/07

МЕР
ЧЛЕН БУ:

MEH
DRAWN BY:

HEET #

M2

of 2


PLUMBING FIXTURE SCHEDULE

KEY	DESCRIPTION	CONNECTIONS					
		TRAP	W	V	CW	T/HW	G
EW	30 GAL. ELECTRIC WATER HEATER MAX HOT WATER TEMP. AT 110 DEG. F.	--	--	--	3/4"	3/4"	--
FD	FLOOR JR.SMITH SERIES 2110 WITH NICKLE DRAIN BRONZE STRAINER.	--	2"	2"	--	--	--
L1	WALL HUNG LAVATORY FALCET (ADA)	2"	2"	2"	1/2"	1/2"	--
WC1	FLOOR MOUNTED - WATER CLOSET (ADA) ENLONGATED BOWL WITH OPEN FRONT SEAT COVER	3"	3"	2"	1/2"	1/2"	--
SLP	ZOELLER (OR EQUAL) DUPLEX SEWAGE LIFT PUMP, 65 GPM	--	3"	--	--	--	--
MS	MOP SINK FAUCET W/ VACUUM BREAKER	2"	2"	2"	1/2"	1/2"	--


GENERAL NOTES

- ALL WORK SHALL BE DONE IN COMPLIANCE WITH THE 03 IBC, 03 MECHANICAL (MC), 2003 PLUMBING CODES (UPC), 2003 INTERNATIONAL ENERGY CONSERVATION CODE (IECC) AND ALL AMENDMENTS OF THE LOCAL REGIONAL BUILDING DEPARTMENT AGENCY.
- ALL MECHANICAL EQUIPMENT SHALL BE LABELED AS TO THE AREA(S) SERVED.
- THIS DRAWING IS DIAGRAMMATIC IN NATURE AND DOES NOT NECESSARILY SHOW EVERY REQUIRED OFFSET AND FITTING. FIELD COORDINATE EXACT PIPE & DUCT ROUTING WITH BUILDING ARCHITECTURE, STRUCTURE AND OTHER TRADES.
- REFER TO ARCH DWGS FOR EXACT LOCATIONS OF PLUMBING FIXTURES.
- PROVIDE CLEAN OUTS AT ALL SINKS, BOTH SIDES PER TABLE 7-6 OF 2000 UPC. PROVIDE CLEANOUTS ON ALL BRANCH DRAIN LINES THAT EXCEED 5'0" IN LENGTH (TYP).
- ALL DROPS SERVING MORE THAN ONE FIXTURE SHALL BE 3/4" MINIMUM.
- ALL PIPE SIZES, UNLESS OTHERWISE INDICATED SHALL BE:
COLD WATER 3/4"
HOT WATER 3/4"
VENT 2"
WASTE 4"
GAS 3/4"
- ALL PIPING PENETRATIONS THROUGH RATED WALLS AND CEILINGS SHALL BE SEALED AROUND PIPE IN ACCORDANCE WITH 2003 IBC.
- MAXIMUM HOT WATER OUTLET TEMPERATURE TO PUBLIC LAVATORIES TO BE 110°.
- CLEARLY LABEL ALL PIPING REGARDING USE AND DIRECTION OF FLOW.
- ALL TIE-INS TO EXISTING SYSTEMS SHALL BE COORDINATED WITH THE OWNER PRIOR TO THE START OF WORK. IN ADDITION, ANY INTERRUPTIONS TO SERVICES MUST BE SCHEDULED WITH THE OWNER.

WATER HEATER SCHEDULE

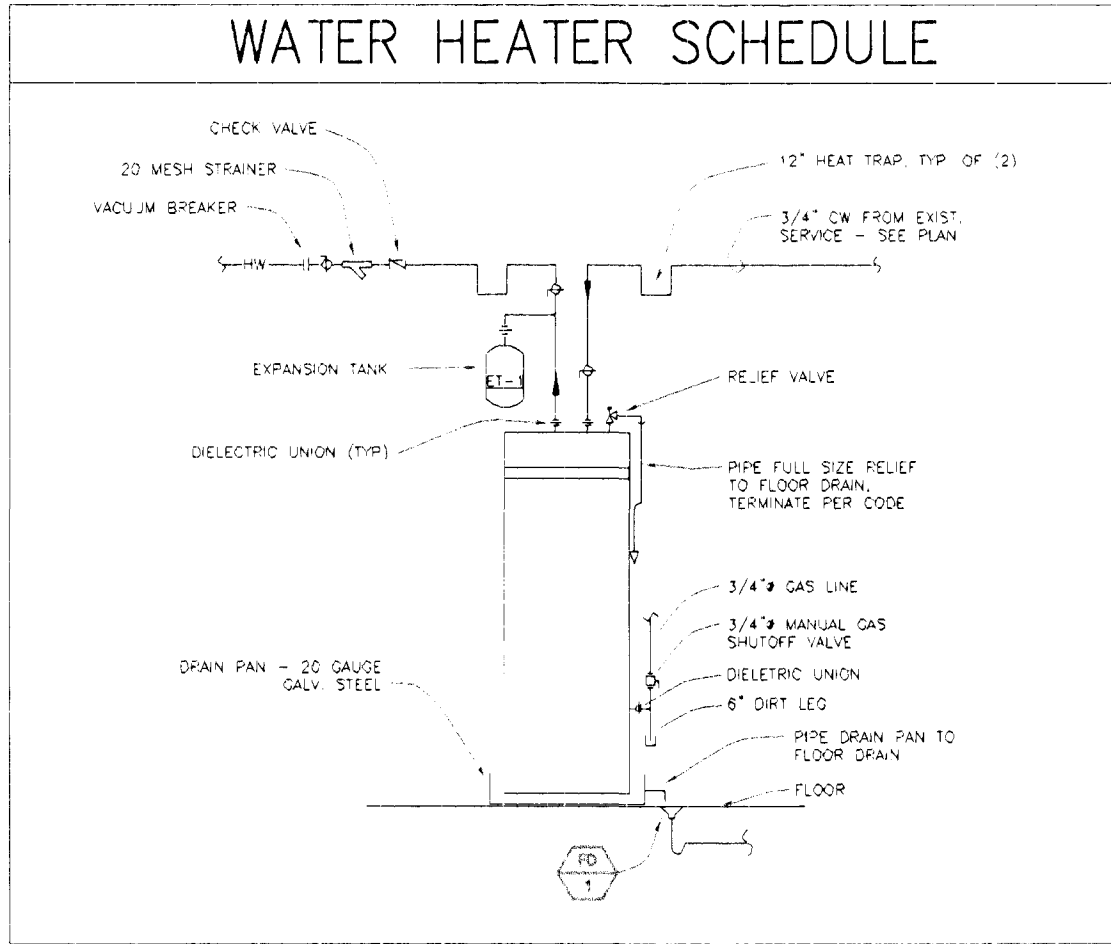

DUPLEX SEWAGE PUMP SCHEDULE

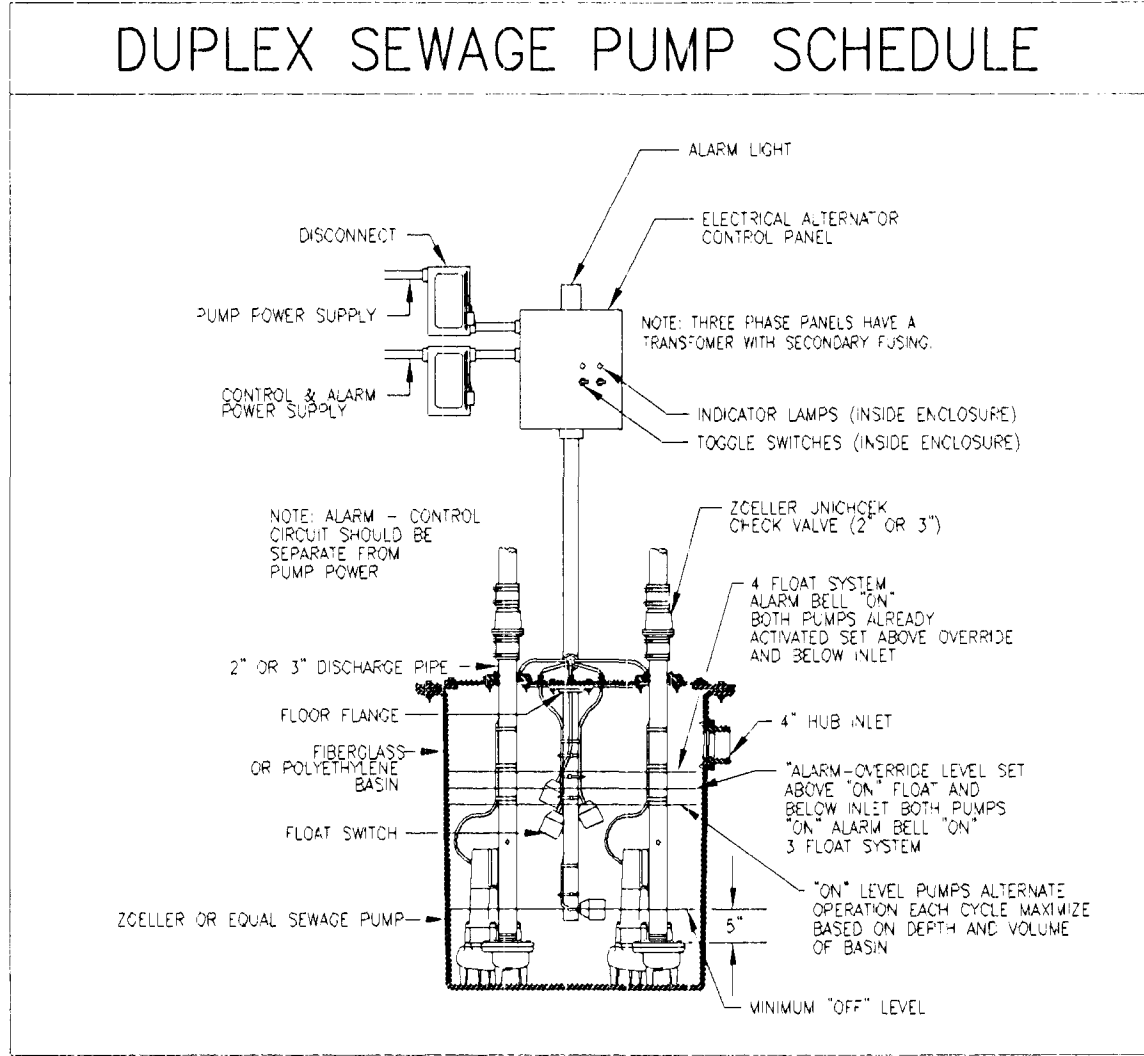

PLUMBING LEGEND



ABBREVIATION	DESCRIPTION
S. OR W.	SEWER/WASTE ABOVE GRADE
S. OR W.	SEWER/WASTE BELOW GRADE OR FLR.
S.	EXISTING SEWER MAIN
V.	VENT
C.W.	COLD WATER PIPE
H.W.	HOT WATER PIPE
H.W.R.	HOT WATER RETURN PIPE
C.D.	CONDENSATE DRAIN PIPE
G.	GAS
P.O.C.	POINT OF CONNECTION
G.V.	GATE VALVE
D.S.	DOWNSPOUT
R.D.	ROOF DRAIN
P.G.	PROPANE GAS PIPE
W.H.A. W/AP	WATER HAMMER/ARRESTOR W/ACCESS PANEL
F.CO.	FLOOR CLEANOUT
W.CO.	WALL CLEANOUT
Y.CO.	YARD CLEANOUT
A.P.	ACCESS PANEL
DN.	DOWN
ABV.	ABOVE
BEL.	BELOW
GRD.	GRADE
FLR.	FLOOR
AFG.	ABOVE FINISH GRADE
FCO.	FLOOR CLEANOUT
WCO.	WALL CLEANOUT
GCO.	GROUND CLEANOUT
VTR.	VENT THROUGH ROOF

WATER FIXTURE CALCULATIONS

FIXTURE	NUMBER OF FIXTURES	FIXTURE UNITS	TOTAL FIXTURE UNITS
WATER CLOSET (F.T.)	5	x 4	= 20
MOP SINK	1	x 3	= 3
F.D.	5	x 2	= 10
SINK	3	x 1	= 3
TOTAL COLD WATER FIXTURE UNITS			36
DEMAND			36 GPM
MAX. DEVELOPED LENGTH			100'
SIZE: 3/4" METER			

NOT PART OF TENANT

BATHROOMS ARE PART OF TENANT

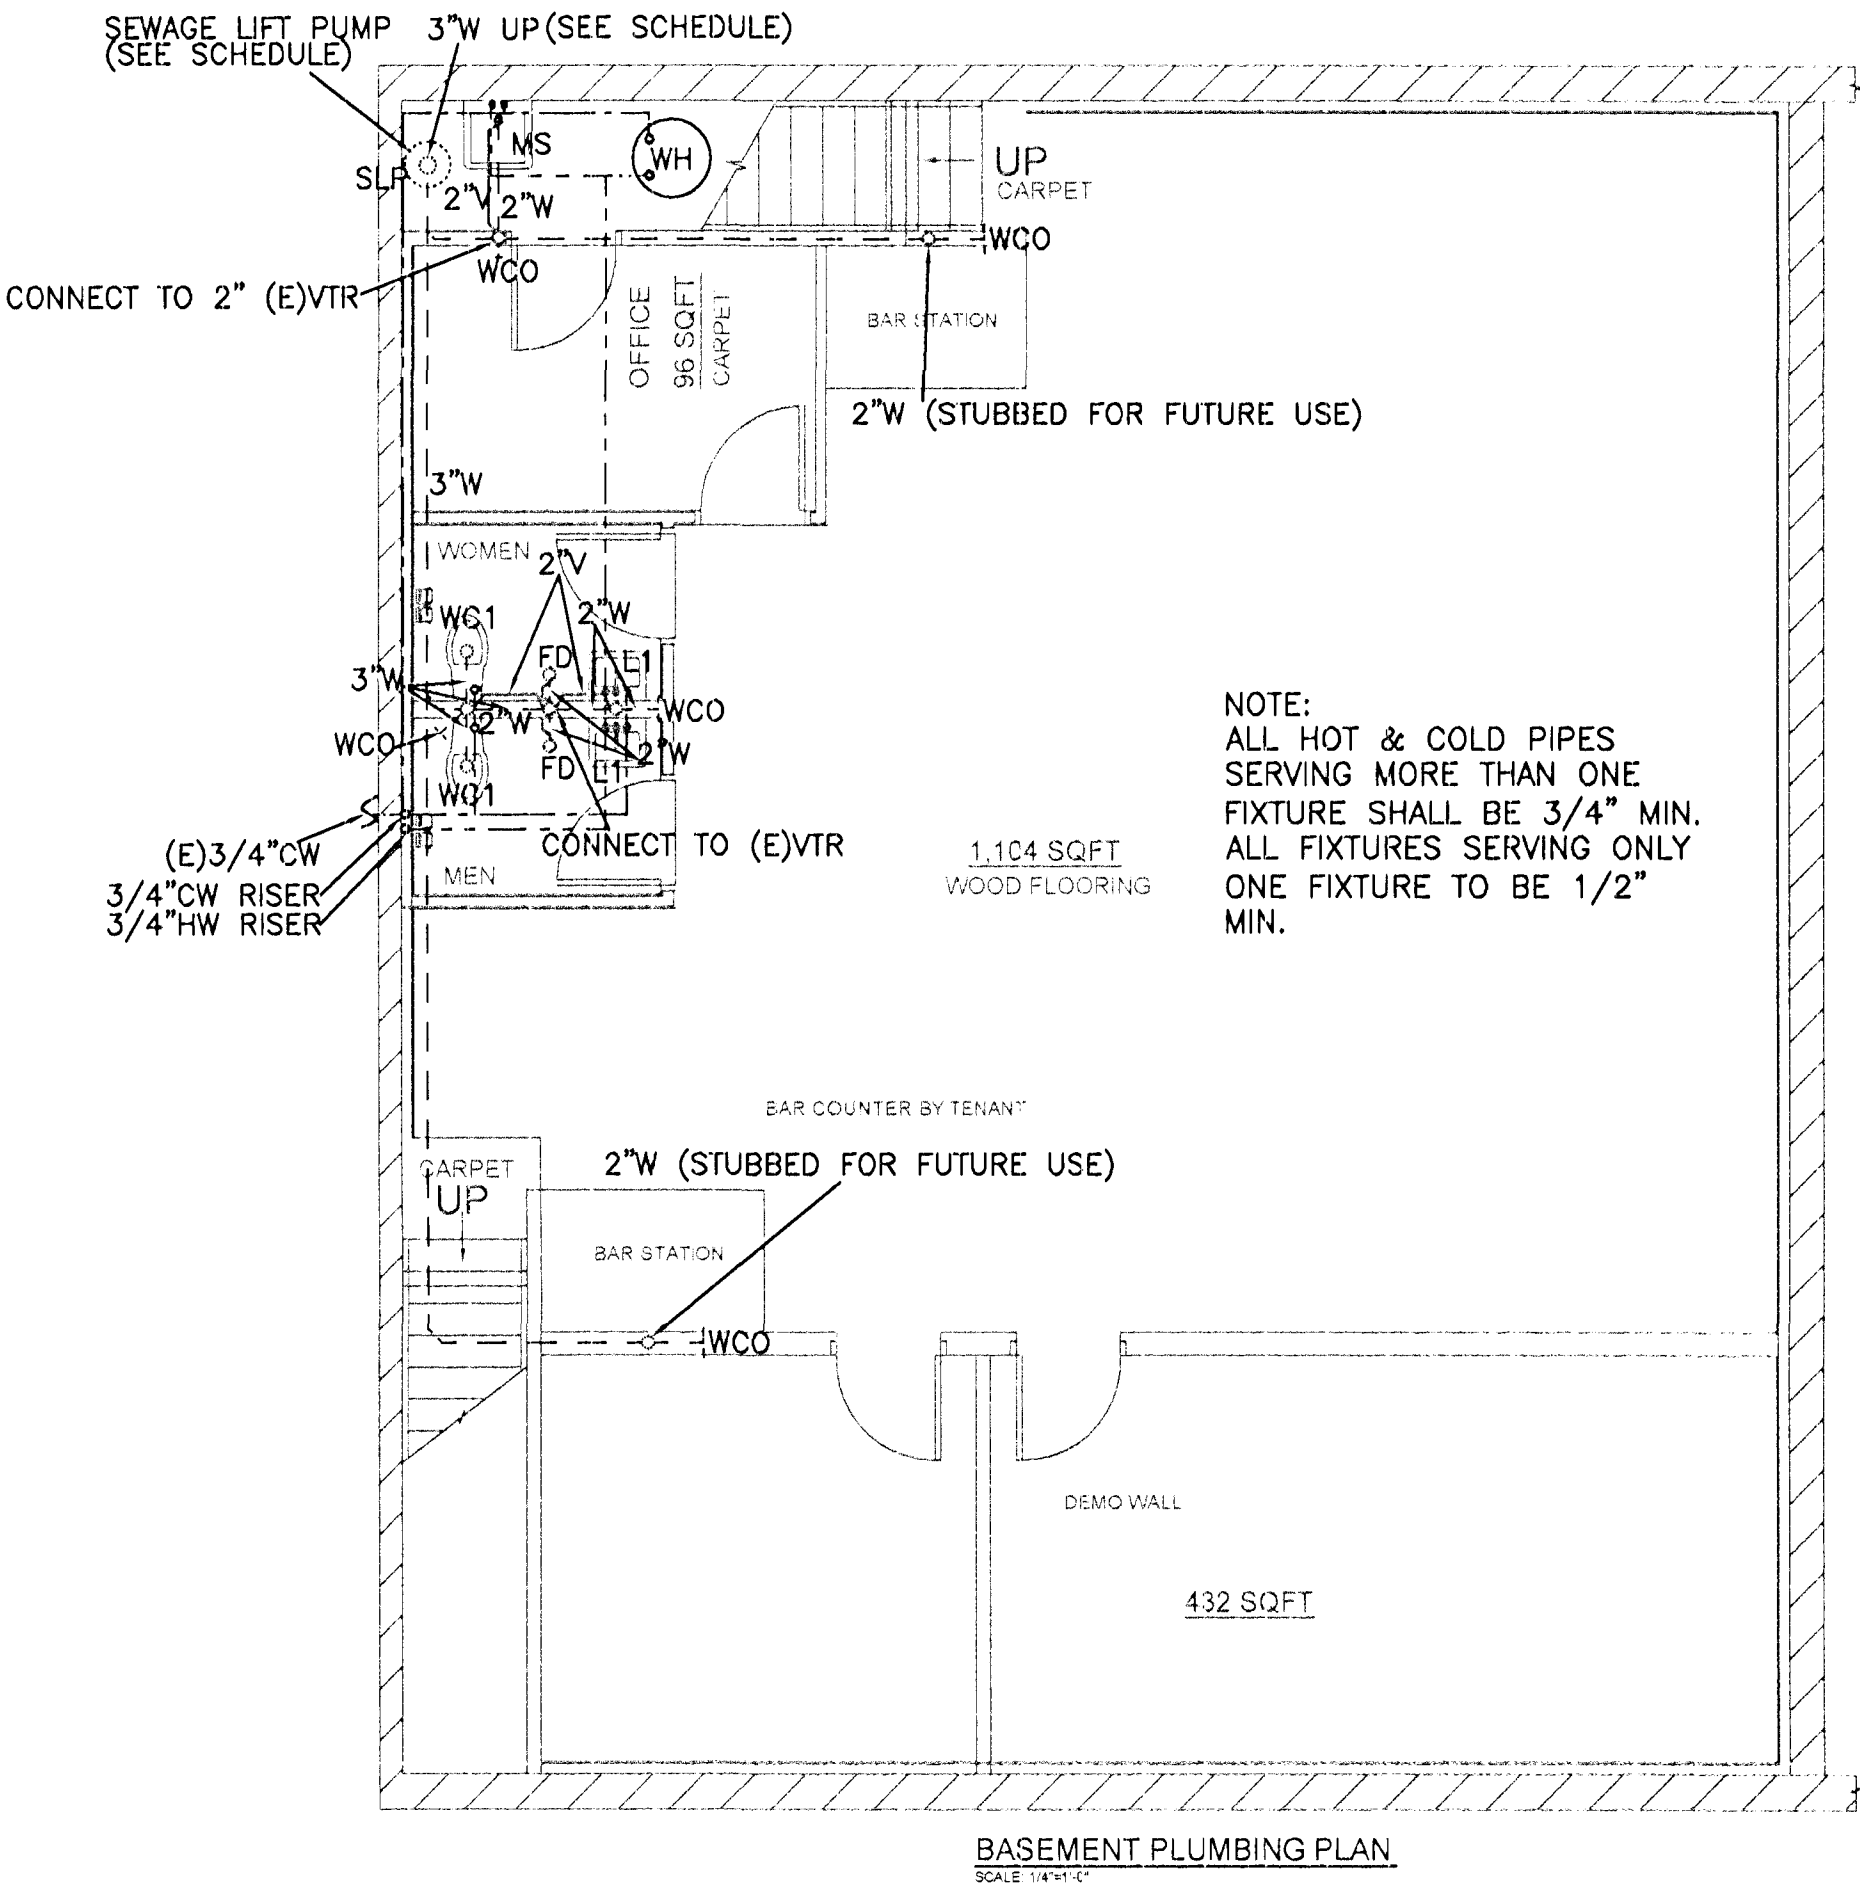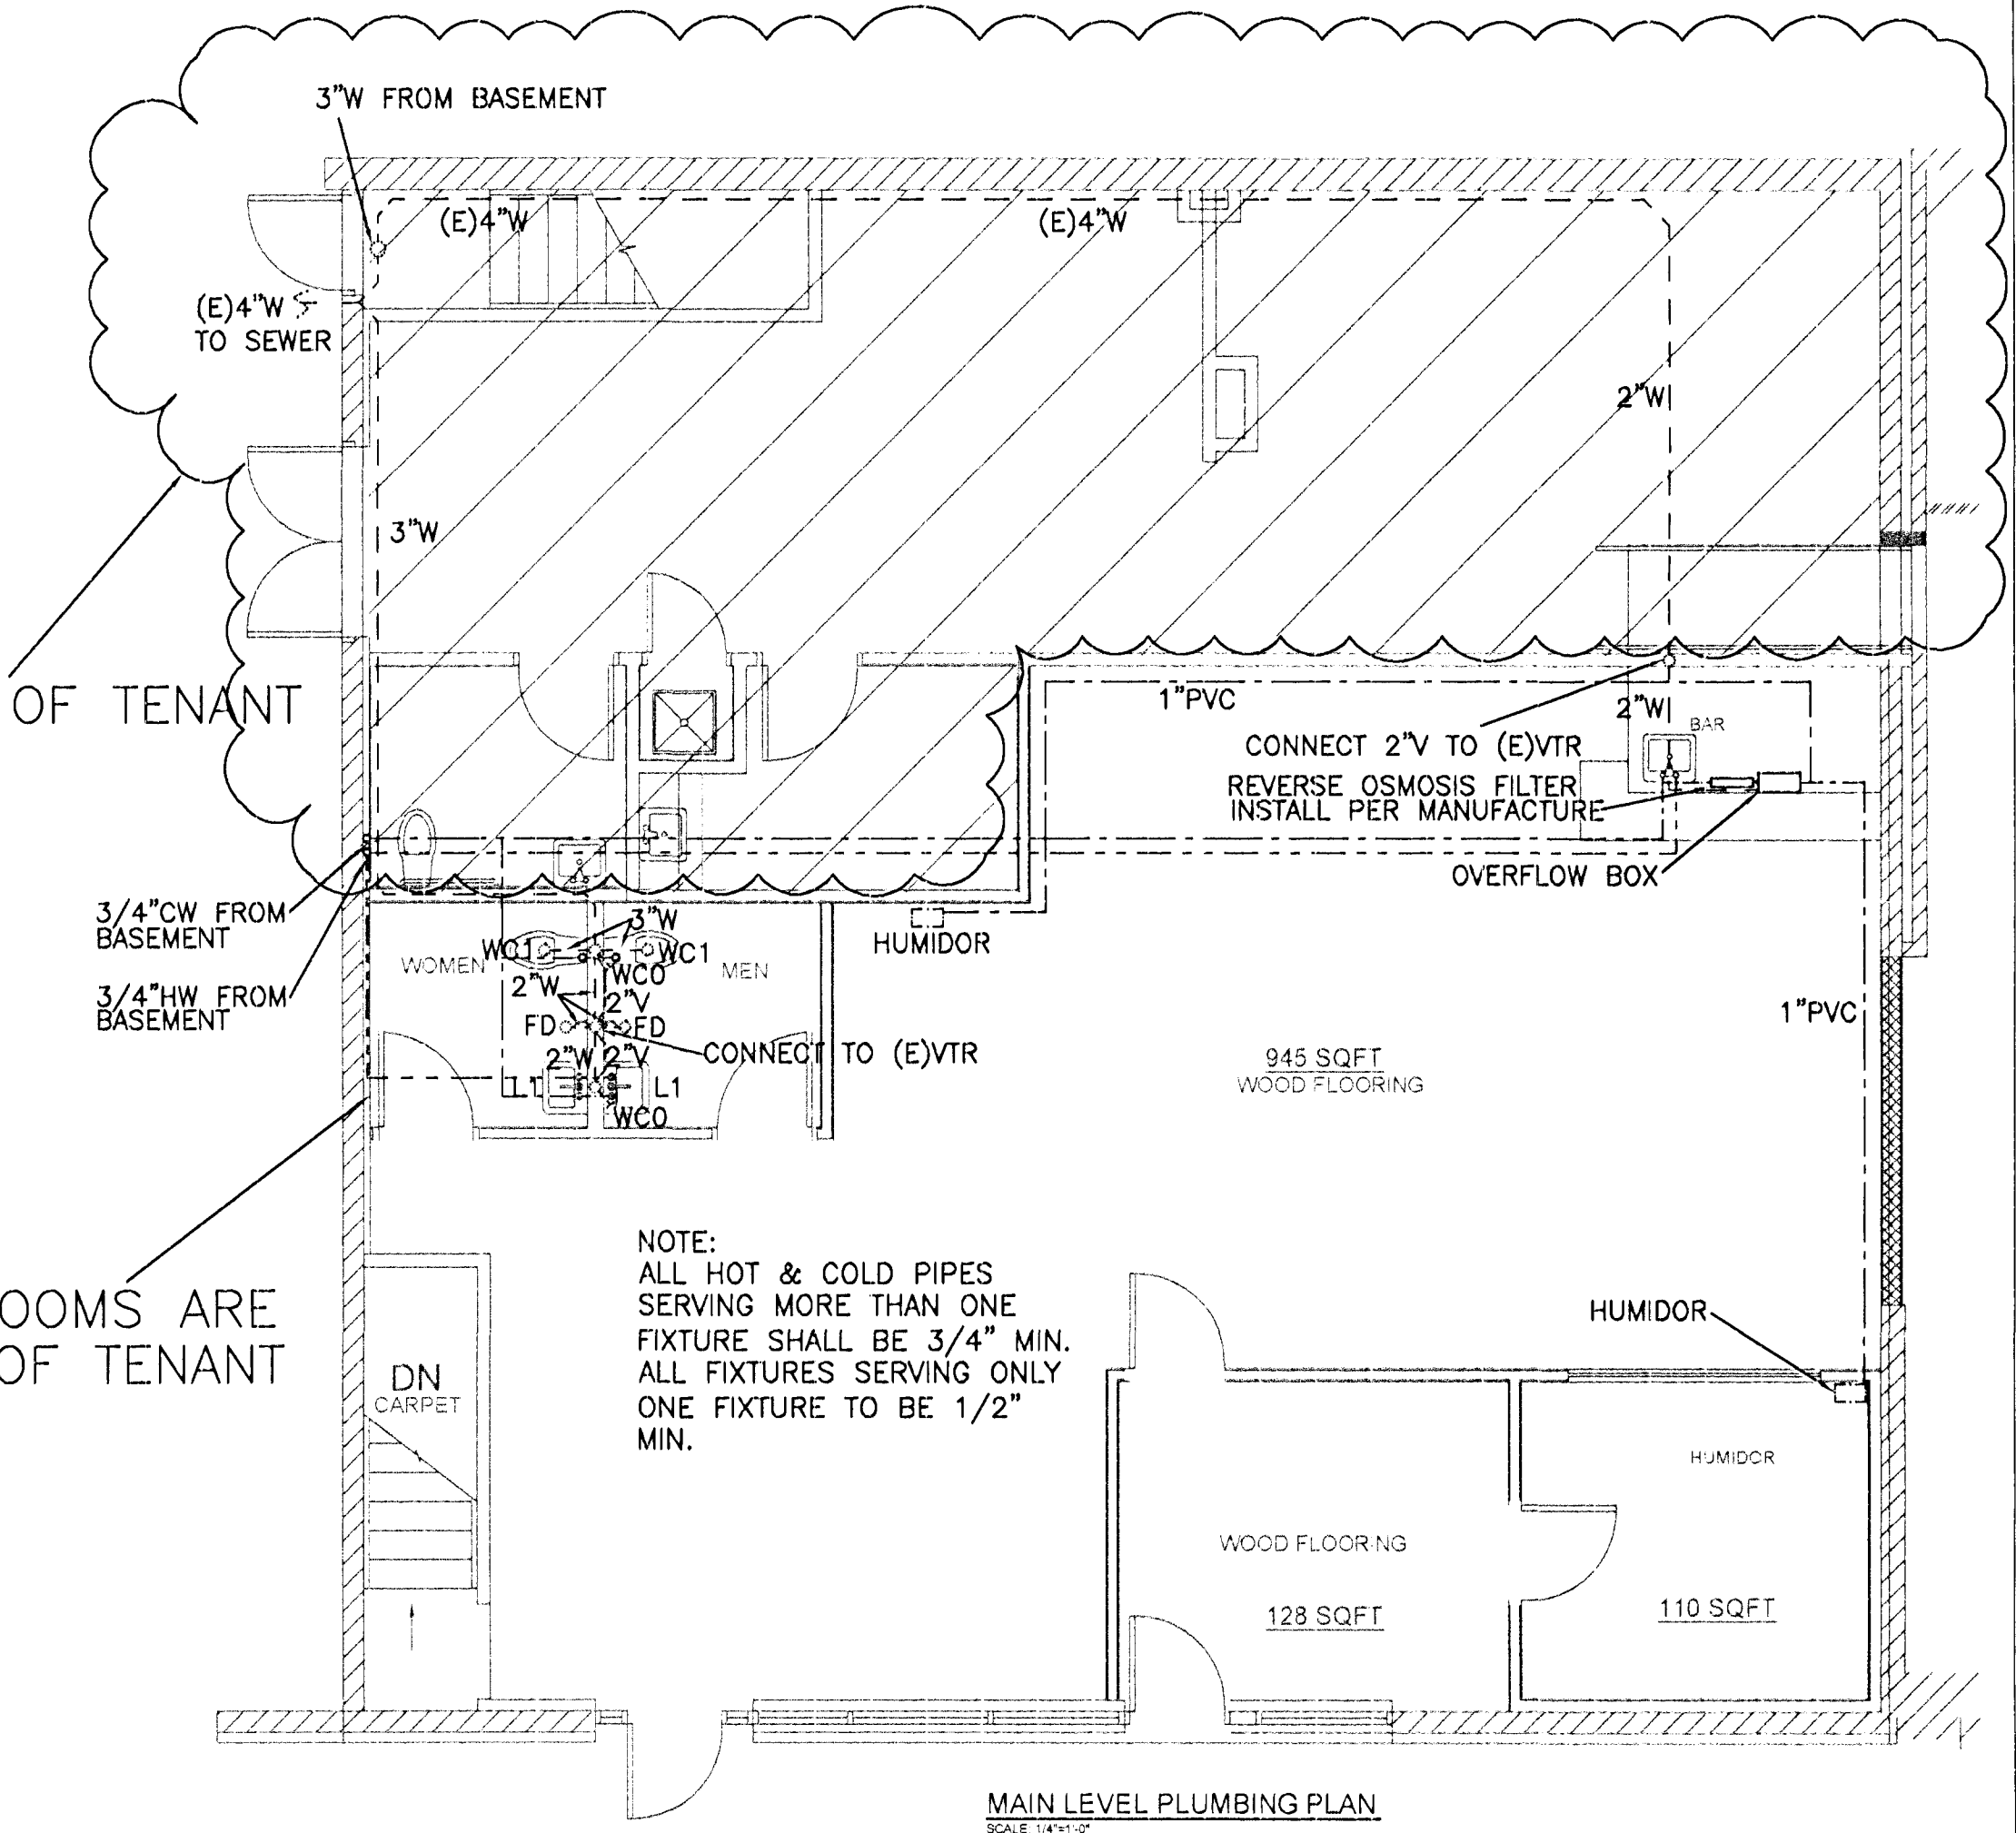

T-BONE
CONSTRUCTION INC.
GENERAL CONTRACTOR

Design & Development
Consultants @

(719) 570-1456
1530 VALLEY STREET
COLORADO SPRINGS, CO 80905

COBALT CLUB

06-0132

REVISIONS

TENANT REMODEL

124 E. COSTILLA

DRAWN BY: MS

DATE: BP 03/07/07

CHK BY: BP

SHEET #

P1

REGIONAL BLDG. DEPT
APR 11 2007
APPROVED BY RLK

KEY	SYMBOLS	LAMPS	DESCRIPTION	MANUFACTURER	MOUNTING	REMARKS
a		3-FLUORESCENT 32 W COOL WHITE T-8	2x4 LAY-IN TROFFERS	METALUX/HUBBELL LITHONIA	RECESSED	STANDARD ACRYLIC LENS
b		2-FLUORESCENT 32 W COOL WHITE T-8	1x4 WRAP AROUND	METALUX/HUBBELL LITHONIA	RECESSED	STANDARD ACRYLIC LENS
c		45 W HALOGEN	KEYLESS PORCELAIN	METALUX/HUBBELL LITHONIA	SURFACE	OWNER SELECTED
d		2-13W FLUORESCENT COMPACT FLUORESCENT	SURFACE MOUNTED FIXTURE	SEAGUL LIGHTING-B923-12 OR EQUAL	SURFACE	WHITE ACRYLIC LENSE
e		75 W METAL HALIDE	EXTERIOR WALL PACK	METALUX/HUBBELL LITHONIA	BACKET	
f		45W HALOGEN	RECESSED CAN		RECESSED	OWNER SELECTED
g		3 X 35W HALOGEN	HANGING PENDANT LIGHTS		SUSPENDED	OWNER SELECTED
h		3 X 40WPAR30 HALOGEN	TRACK LIGHTS		SURFACE	OWNER SELECTED

ELECTRICAL LEGEND

- K** POWER PANELBOARD "K" MOUNT TOP 8'-0" ABOVE FINISHED FLOOR. SEE PANELBOARD SCHEDULE FOR EQUIPMENT CONTAINED IN PANELBOARD AND PANELBOARD RATINGS.
- J** JUNCTION BOX SIZE AND USE AS REQUIRED. CONDUIT SHALL OVERLAP THE BOX EDGE BY 1/2" WHERE RECESSED IN WALL WITH CONCRETE/CLG. WING.
- 4"** SQUARE JUNCTION BOX.
- EXIT** SIGN "X" INDICATES FIXTURE TYPE, "C" INDICATES CEILING MOUNTED, "W" INDICATES WALL MOUNTED, "S" INDICATES SINGLE FACE, "D" INDICATES DOUBLE FACE. PROVIDE DIRECTIONAL ARROWS AS INDICATED ON PLANS. UNIT EQUIPPED WITH BATTERY BACK-UP.
- 200V** OUTLET OR SPECIAL PURPOSE OUTLET.
- 0** ISOLATED GROUND TYPE DUPLEX RECEPTACLE, 125V, 20A IN ORANGE COLOR - MOUNT 3" ABOVE BACKPLASH AT WORK COUNTERS AND 22" ABOVE FINISHED FLOOR UNLESS OTHERWISE NOTED. PROVIDE HUBBELL OR LEVITON COMMERCIAL SPECIFICATION GRADE.
- 0P** DUPLEX RECEPTACLE - 125V, 20A MOUNT 3" ABOVE BACKPLASH AT WORK COUNTERS AND LAUNDRIES AND 22" ABOVE FINISHED FLOOR UNLESS OTHERWISE NOTED. PROVIDE HUBBELL OR LEVITON COMMERCIAL SPECIFICATION GRADE.
- 0P** QUADRUPLUX CONVENIENCE OUTLET - 125V, 20A MOUNT 22" ABOVE FINISHED FLOOR UNLESS OTHERWISE NOTED. HUBBELL OR LEVITON COMMERCIAL SPECIFICATION GRADE.
- 0M** MISCELLANEOUS MECHANICAL EQUIPMENT, HEATER, HEATER UNIT, HEATER.
- 4-A** COMBINATION EXT. SIGN AND EMERGENCY LIGHTING UNIT, BATTERY BACK-UP POWERED. EMERGENCY LIGHTING UNIT, BATTERY BACK-UP POWERED.
- 0** CANDLELIGHT/DOWNLIGHT FIXTURE, "A" IS THE FIXTURE TYPE IN THE FIXTURE SCHEDULE. "S" INDICATES WHICH SWITCH CONTROLS THE FIXTURE, AND "X" INDICATES WHICH PANELBOARD CIRCUIT THE FIXTURE IS FED FROM.
- 0** FLUORESCENT LIGHTING FIXTURE, "A" IS THE FIXTURE TYPE IN THE FIXTURE SCHEDULE. "S" INDICATES WHICH SWITCH CONTROLS THE FIXTURE, AND "X" INDICATES WHICH PANELBOARD CIRCUIT THE FIXTURE IS FED FROM.
- 0** FLUORESCENT LIGHTING FIXTURE WITH BUILT IN EMERGENCY BATTERY PACK TO PROVIDE LIGHTING WHEN NORMAL POWER IS NOT AVAILABLE. PROVIDE UNLIMITEED "HOT" CONDUCTOR FROM SAME CIRCUIT FIXTURE IS ON TO BATTERY PACK IN ORDER TO ALLOW NORMAL SWITCHING OF LIGHT FIXTURE WITHOUT DISCONNECTING BATTERY PACK.
- CONDUIT AND CONDUCTORS CONCEALED IN CEILING EXTEND TO PANELBOARD "K". CROSS HATCHES INDICATE NUMBER OF #12 AWG CONDUCTORS.
- CONDUIT UNDERGROUND.
- UNDERGROUND - "K" INDICATES PANELBOARD. "1-3" INDICATES CIRCUIT NO.
- MARKS INDICATE NO. OF #12 CONDUCTORS IN 3/4" CONDUIT - "P" PHASE, "N" NEUTRAL, "G" GROUND. NO MARKS INDICATE 2 OR MORE CIRCUITS SHARE A COMMON NEUTRAL. THE "HOT" CONDUCTORS MUST BE CONNECTED TO DIFFERENT PHASES IN THE PANELBOARD.
- POINT OF SALE (POS) SYSTEM OUTLET.
- TELEPHONE OUTLET MOUNT 18" ABOVE FINISHED FLOOR UNLESS NOTED OTHERWISE. EXTEND 1" DMPY CONDUIT FROM OUTLET BOX AS INDICATED AND TERMINATE WITH SINGLE GANG DEVICE RING.
- TELEPHONE DATA OUTLET MOUNT 18" ABOVE FINISHED FLOOR UNLESS NOTED OTHERWISE. EXTEND 1/4" DMPY CONDUIT FROM OUTLET BOX AS INDICATED AND TERMINATE WITH BUSING. PROVIDE TWO CATEGORY 5A 4-PAIR, NON-PLENUM CABLES TO EACH OUTLET. PROVIDE 4" SQUARE BOX WITH FACE PLATE WITH TWO CAT 5A RJ-45 JACKS AT EACH OUTLET LOCATION. LABEL ONE JACK FOR "VOICE" AND ONE JACK FOR "DATA" AT EACH LOCATION. DATA CABLE SHALL BE "ORANGE", VOICE CABLE SHALL BE "WHITE" IN COLOR. EACH VOICE RUN SHALL TERMINATE AT EXISTING TELEPHONE BACKBOARD (TBB). EACH DATA RUN SHALL TERMINATE AT OWNER PROVIDED EQUIPMENT. FINAL CONNECTIONS BY OWNER. TEST AND CERTIFY EACH VOICE / DATA CABLE. PROVIDE TEST RESULTS TO OWNER.
- LOCAL WALL SWITCH, SINGLE POLE MOUNT 48" ABOVE FINISHED FLOOR. "D" INDICATES OWNER SWITCH. SPECIFICATION GRADE HUBBELL OR LEVITON.
- LOCAL WALL SWITCH, 3 WAY, MOUNT 48" ABOVE FINISHED FLOOR.
- LOCAL WALL SWITCH, SINGLE POLE, KEY OPERATED, MOUNT 48" ABOVE FINISHED FLOOR.
- FUSED DISCONNECT SWITCH, "60" INDICATES SWITCH SIZE, "120" INDICATES FUSE SIZE, HEAVY DUTY "HP" RATED, PROVIDE NEMA 3R ENCLOSURE OUTDOORS. FUSE PER MANUFACTURER'S EQUIPMENT.
- NON-FUSED DISCONNECT SWITCH, "60" INDICATES SWITCH SIZE, HEAVY DUTY "HP" RATED, PROVIDE NEMA 3R ENCLOSURE OUTDOORS.
- MANUAL MOTOR STARTER WITH THERMAL OVERLOAD PROTECTION SAME MOUNTING HEIGHT ABOVE FINISHED FLOOR AS WALL SWITCH.
- A.C. MOTOR "1/3" INDICATES HORSEPOWER.
- TELEPHONE BACKBOARD 8" x 4" x 5/8" THICK FIRE RESISTIVE PLUMB, MOUNT TOP OF THE PLUMB 8'-0" ABOVE FINISHED FLOOR. INSTALL #8 SOLID COPPER GROUND TO NEAREST BUILDING STEEL. PROVIDE 1-120V, 20A DUPLEX RECEPTACLE ON DESIGNATED CIRCUIT. PAINT WITH 2 COATS OF FIRE RESISTIVE PAINT.
- DUCT SMOKE DETECTOR, 1-SUPPLY AIR DUCT, 1-RETURN AIR DUCT, SUPPLIED BY FIRE ALARM CONTRACTOR. ELECTRICAL CONTRACTOR TO WIRE THE DUCT SMOKE DETECTORS TO SHUT DOWN THE RTU IN THE EVENT EITHER SUPPLY OR THE RETURN DUCT DETECTOR GOES INTO ALARM.
- FIRE ALARM PULL STATION MOUNT 48" A.F.F.
- FIRE ALARM COMBINATION AUDIO/VISUAL HORN STROBE DEVICE, MOUNT 80" A.F.F.
- FIRE ALARM SMOKE DETECTOR.
- FIRE ALARM HEAT DETECTOR.
- FIRE ALARM VISUAL ONLY STROBE DEVICE, MOUNT 80" A.F.F.
- FIRE ALARM TAMPER SWITCH.
- FIRE ALARM FLOW SWITCH.
- FIRE ALARM CONTROL PANEL, MOUNT TOP 8'-0" A.F.F.
- REMOTE ANNUNCIATOR PANEL FOR FACP, MOUNT TOP AT 8'-0" A.F.F.

ELECTRICAL GENERAL NOTES


1. BASE BUILDING SPECIFICATIONS, DRAWINGS AND LATEST REVISION OF CONTRACT DOCUMENTS FOR ELECTRICAL WORK SHALL APPLY TO ELECTRICAL DRAWINGS.
2. ALL WORK SHALL BE DONE IN COMPLIANCE WITH THE TENANT FINISH SPECIFICATIONS, DRAWINGS AND LATEST REVISIONS OF ALL NATIONAL CODES SUCH AS THE NEC, NFPA AND ALL APPLICABLE LOCAL CODES AND ORDINANCES.
3. GENERAL SCOPE OF WORK REQUIRES INSTALLATION OF NEW LIGHTING FIXTURES, ELECTRICAL DEVICES AND EQUIPMENT.
4. ELECTRICAL CONTRACTOR SHALL VISIT SITE AND EXAMINE DRAWINGS OF OTHER TRADES ON THIS PROJECT, ARCHITECTURAL AND MECHANICAL, TO DETERMINE ANY ADDITIONAL WORK THAT MAY BE REQUIRED FOR A COMPLETE AND OPERATIONAL ELECTRICAL INSTALLATION AND SHALL INCLUDE AN ALLOWANCE FOR THIS WORK IN HIS BID.
5. CONTRACTOR SHALL BE HELD RESPONSIBLE FOR VERIFICATION OF EXISTING JOB CONDITIONS PRIOR TO BID. NO ADDITIONAL COSTS SHALL BE AWARDED TO THE SUCCESSFUL CONTRACTOR OR HIS SUBCONTRACTORS, AFTER BIDS HAVE BEEN SUBMITTED AND CONTRACTS AWARDED, FOR FAILURE TO VERIFY EXISTING JOB CONDITIONS. DISCREPANCIES BETWEEN ACTUAL FIELD CONDITIONS AND CONTRACT DOCUMENTS SHALL BE BROUGHT TO THE ENGINEER'S ATTENTION FOR ALTERNATIVE METHODS OF INSTALLATION. THREE(3) DAYS MINIMUM PRIOR TO BIDDING THIS JOB TO ALLOW FOR ISSUANCE OF CLARIFICATIONS.
6. SPICES ON #8 OR SMALLER SHALL BE WITH "SCOTCH-LOCK" SPRING CONNECTORS. FOR LARGER SIZE CONDUCTORS USE SOLDERLESS CONNECTORS.
7. OUTLET BOXES SHALL BE APPROVED TYPE.
8. THE CONDUIT SYSTEM AND ALL CONDUCTING WIRE ENCLOSURES SHALL BE SECURELY BONDED TOGETHER.
9. WIRING INSIDE THE BUILDING AND ABOVE GROUND SHALL BE COPPER, TYPE THIN/THIN, WIRING IN CONDUIT, UNDERGROUND OR IN DAMP LOCATIONS SHALL BE COPPER, TYPE THIN, MINIMUM SIZE CONDUCTOR SHALL BE NO. 12 GAUGE SOLID NO. 8 GAUGE AND LARGER STRANDED, WHERE AUTHORIZED USE OF MC TYPE FLEXIBLE CABLE IS INSTALLED IN LIEU OF WIRE AND CONDUIT, FULL SIZE GROUND WIRE SHALL BE RUN WITH CURRENT-CARRYING CONDUCTORS.
10. PROVIDE TYPE-WRITTEN UPDATED PANEL, DOOR DIRECTORIES FOR ALL AFFECTED PANELS REFLECTING ALL CIRCUITS WITH THEIR ACCURATE DESTINATIONS.
11. RECEPTACLES 120V DUPLEX GROUNDING TYPE, SHALL BE APPROVED TYPE.
12. SWITCHES SHALL BE TOGGLE TYPE AND APPROVED TYPE.
13. COVER PLATES SHALL BE PLASTIC, COLOR TO MATCH. PROVIDE BLANK COVER PLATES FOR ALL UNUSED OR DAMAGED JUNCTION BOXES (NEW & EXISTING).
14. PREPARE AND MAINTAIN AT JOB SITE ACCURATE UPDATED "AS BUILT" DRAWINGS.
15. ALL ELECTRICAL EQUIPMENT, DEVICES, CIRCUITING, ETC. SHOWN DIAGRAMMATICALLY ONLY, ELECTRICAL CONTRACTOR SHALL BE RESPONSIBLE FOR ACTUAL LOCATION AND WIRING AVOIDING MECHANICAL AND OTHER EQUIPMENT.
16. ALL NEW MATERIALS INSTALLED IN CEILING PLENUM SHALL BE U.L. LISTED CLASS I RATED, FOR LOW VOLTAGE CABLE OR CONDUCTORS NOT IN CONDUIT. INSULATION HAS TO MEET NON-TOXICITY REQUIREMENTS.
17. FURNISH AND INSTALL LIGHTING FIXTURES COMPLETE WITH LAMPS, BALLASTS, AND REQUIRED MOUNTING HARDWARE. PRIOR TO ORDERING FIXTURES, VERIFY MOUNTING METHODS AND FINISHES.
18. SEE LEGEND, LIGHTING AND POWER NOTES, MECHANICAL AND ARCHITECTURAL DRAWINGS FOR SUPPLEMENTAL INFORMATION ON LOCATIONS, MOUNTING HEIGHTS, ETC. DIMENSIONS ON ARCHITECTURAL DRAWINGS TAKE PRECEDENCE OVER THE ELECTRICAL DRAWINGS.
19. WALL MOUNTED RECEPTABLES, TELEPHONE AND DATA OUTLETS SHALL BE MOUNTED AT 18" A.F.F. UNLESS OTHERWISE NOTED.
20. CIRCUIT BREAKERS SHALL BE MOLDED CASE TYPE WITH THERMAL MAGNETIC TRIPS WITH FRAME SIZE, NUMBER OF POLES AND TRIP SETTING AS SHOWN.
21. PANELS - SHALL BE BOLT-ON TYPE WITH QUICK-MAKE, QUICK-BREAK CIRCUIT BREAKERS, THERMAL MAGNETIC TRIPS WITH FRAME SIZE, NUMBER OF POLES AND TRIP SETTING AS SHOWN ON PLANS. ALL PANELS SERVING COMPUTERS, ISOLATED GROUND SHALL BE FURNISHED WITH ISOLATED GROUND BUS.
22. UNLESS OTHERWISE INDICATED, ALL WIRING FOR BRANCH CIRCUITS SHALL BE # 12 AWG PROTECTED BY 20 AMP CIRCUIT BREAKERS. IF DISTANCE FROM PANEL TO FIRST OUTLET IS 75 FEET OR GREATER FOR 120V CIRCUIT OR 150 FEET OR GREATER FOR 277V CIRCUITS # 10 WIRING SHALL BE INSTALLED.
23. ELECTRICAL CONTRACTOR SHALL COORDINATE EXACT LOCATIONS OF ALL MECHANICAL EQUIPMENT WITH MECHANICAL DRAWINGS.
24. THE SUB-CONTRACTOR SHALL ARRANGE FOR ALL INSPECTIONS WHEN THEY BECOME DUE AND SHALL NOT COVER ANY WORK UNTIL APPROVED BY THE INSPECTION AUTHORITY.
25. ELECTRICAL CONTRACTOR SHALL MAINTAIN ALL WORKING CLEARANCES FOR ALL ELECTRICAL EQUIPMENT PER N.E.C. REQUIREMENTS.
26. WHERE LIGHT FIXTURES LOCATIONS INTERFERE WITH DUCT OR CEILING SUPPORTS, RELOCATE SUPPORTS, IF IMPOSSIBLE, CONTACT ARCHITECT. USE END CONNECTOR LIGHT FIXTURES UNDER LOW DUCT WORK.
27. INDEPENDENTLY SUPPORT FLEXIBLE WHIPS FOR ALL NEW OR RELOCATED FIXTURES FROM THE GRID SUPPORT SYSTEM.
28. COORDINATE ALL MECHANICAL EQUIPMENT LOCATIONS AND SPECIFICATIONS WITH MECHANICAL CONTRACTOR PRIOR TO ROUGH-IN. PROVIDE FUSED OR NON-FUSED DISCONNECT SWITCHES AS REQUIRED BY THE MANUFACTURERS SPECIFICATIONS.
29. LABEL RECEPTABLES COVERPLATES WITH PANEL DESIGNATION AND CIRCUIT NUMBERS WHERE RECEPTABLES ARE BEING FED FROM MORE THAN ONE CIRCUIT.
30. CONNECT EXIST LIGHTS AND FLUORESCENT EMERGENCY LIGHTS AS SHOWN.
31. VERIFY CLEARANCE OF BEAM, DUCT WORK, ETC. IN CEILING SPACE BELOW AND X-RAY FOR CONDUIT AND REBAR IN SLAB BEFORE CORE DRILLING. CONTACT ARCHITECT IMMEDIATELY IF ANY CLEARANCE PROBLEMS OCCUR.

SERVICE GROUNDING DETAIL


NOT TO SCALE

NOTES:


1. WHEN AVAILABLE, CONTRACTOR SHALL PROVIDE ALL GROUNDING MEANS INDICATED. CONTRACTOR SHALL REFER TO ELECTRICAL INE LINE DIAGRAM FOR GROUNDING ELECTRODE CONDUCTOR SIZE. CONTRACTOR SHALL REFER TO ELECTRICAL SPECIFICATIONS FOR SPECIFICS OF GROUNDING SYSTEM INSTALLATION AND MATERIALS.
2. THE GROUNDING ELECTRODE CONDUCTOR SHALL BE RUN CONTINUOUS FROM THE SWITCHBOARD GROUND BUS AND TERMINATED AS DIRECTED BY LOCAL INSPECTION AUTHORITY. THE GROUNDING ELECTRODE CONDUCTOR SHALL BE FROM THE GROUND SOURCE DESIGNATED BY THE INSPECTION AUTHORITY. EACH GROUNDING ELECTRODE CONDUCTOR SHALL BE IDENTIFIED AS TO ITS SOURCE OR DESTINATION IN THE GROUNDING SYSTEM.

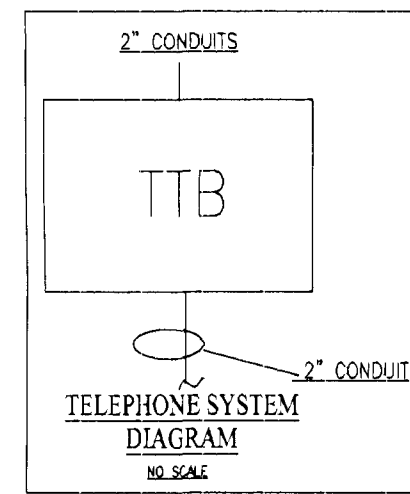

Code	Description	Load VA	Dem	5088	Load Summary
1	Lighting	4265	125%	5338	Ph A
2	Rec up to 10,000	10000	100%	10000	Ph B
3	Rec over 10,000	1080	50%	540	
4	Motor	N/A	100%	N/A	
5	Smallest Motor	6000	125%	7500	
6	Heater	3400	100%	3400	Connected
7	Chiller	N/A	85%	N/A	Code Demand
8	Other	600	100%	600	
9	Sub Panel	N/A	100%	N/A	Code demand
					75 A

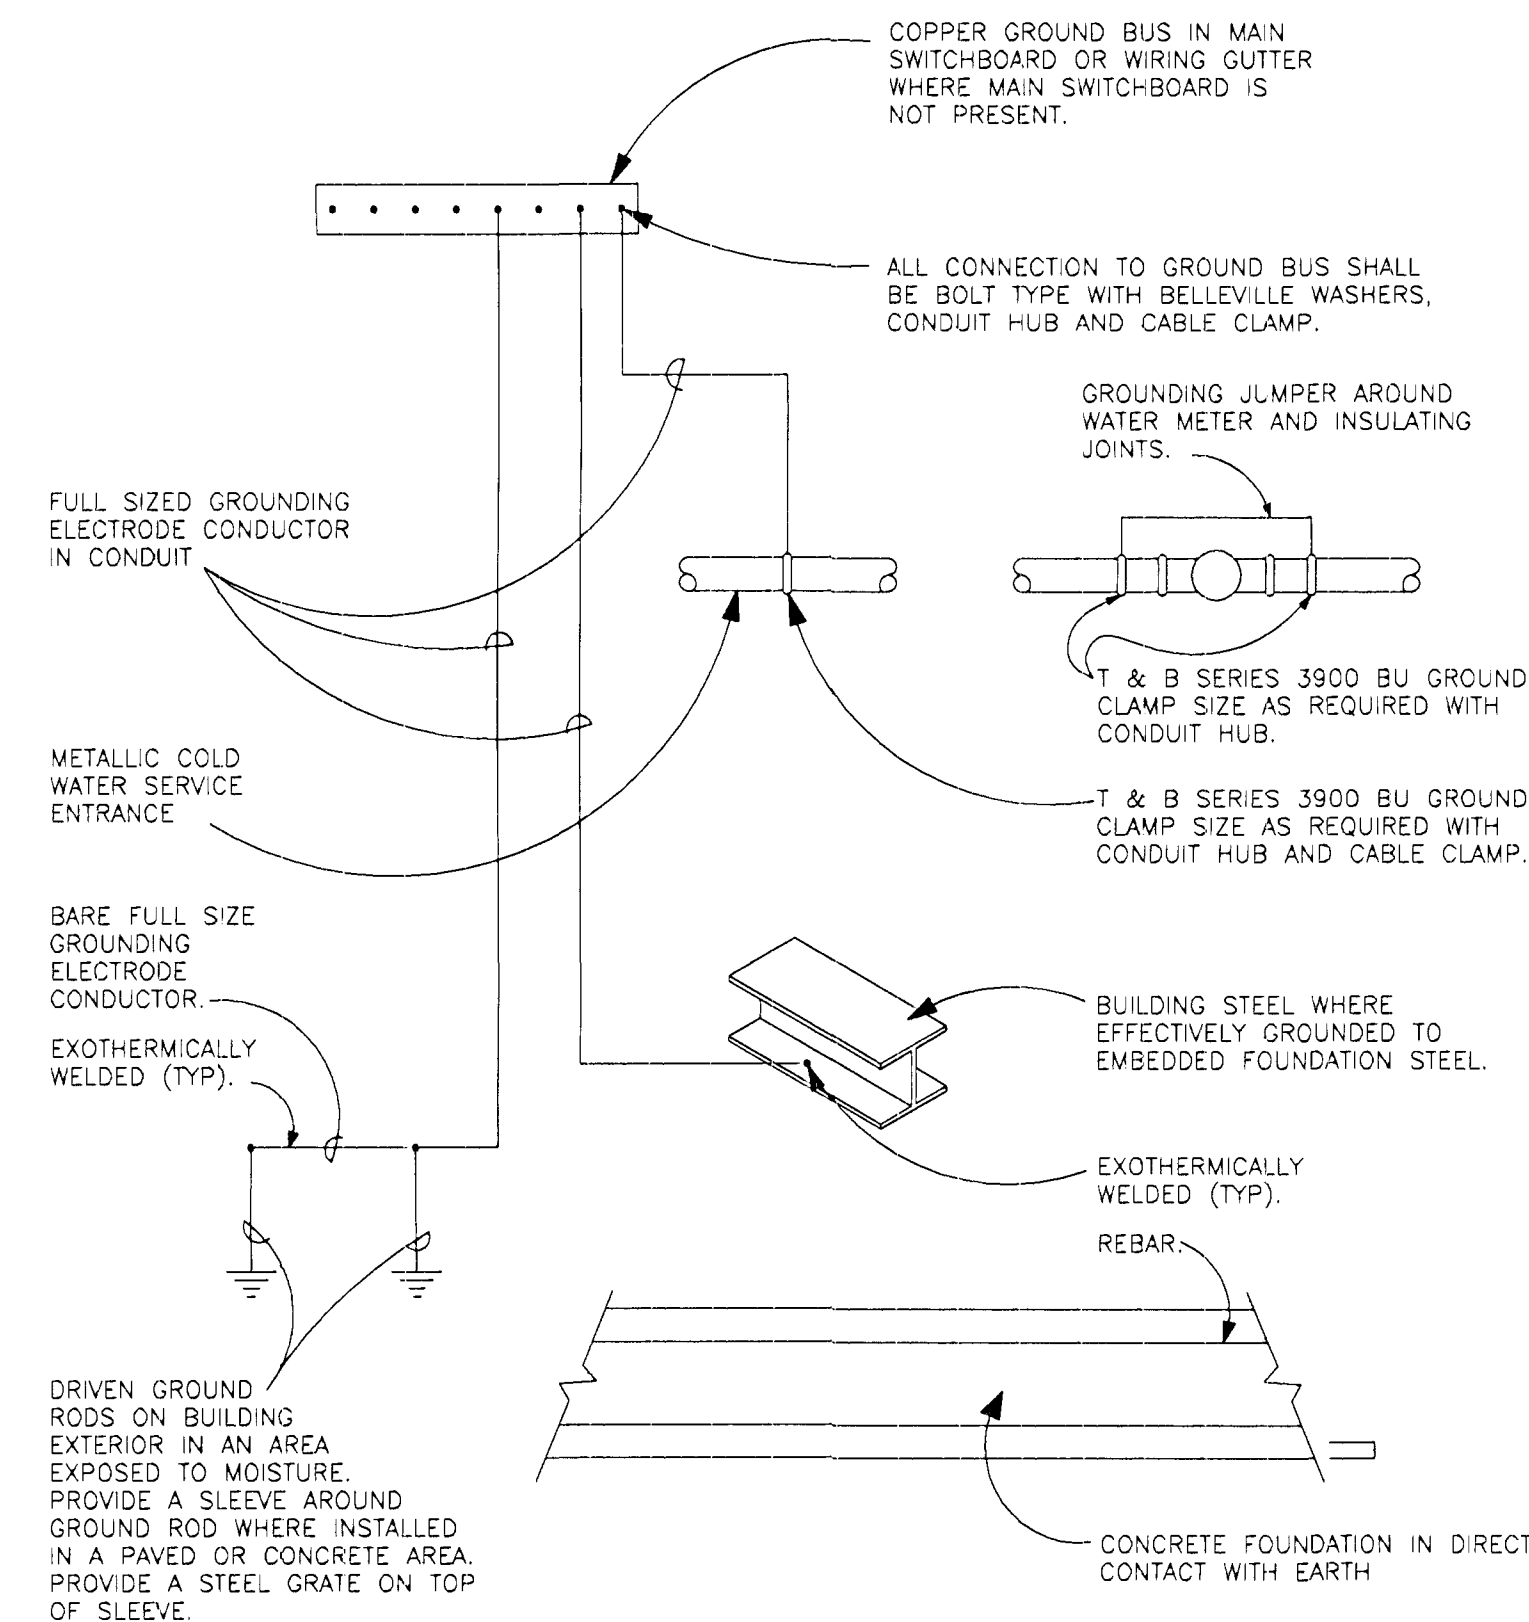

RISER DIAGRAM


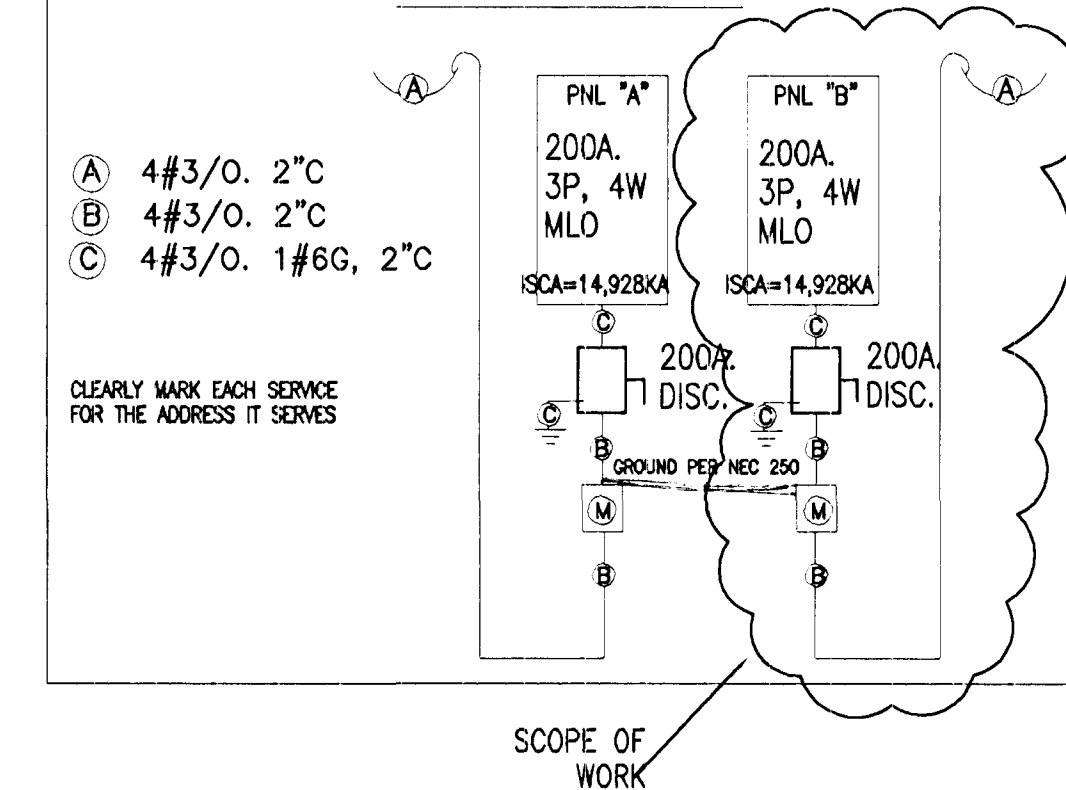


Calculation of Fault Current

Fault SCA Source = TA Primary Infinite
SCA Available = Infinite
Length Units = Feet
Motor Load = None
Motor SCA = None
Motor SCA Treatment = Motor SCA Not Included
System Voltage = 208
System Phase = 3 Phase
<u>Transformers</u>
<u>Name</u> <u>PH</u> <u>Size</u> <u>PH/V</u> <u>Sec/VZ</u> <u>SCA,3PH</u>
TA-T-1 3-PH150 12470 208 12 34,698
<u>Name</u> <u>Cond</u> <u>Cable Size</u> <u>Qty</u> <u>Feet</u> <u>SCA,3PH</u>
S/F F-1
None 3/c, CU 3/0 1 65 15,065

Main Feeders

Name	Cond	Cable Size	Qty	Feet	SCA,3PH
F1 PNL "A"	EMT	3/c, CU	3/0	1	14,928
F2 PNL "B"	EMT	3/c, CU	3/0	1	14,928

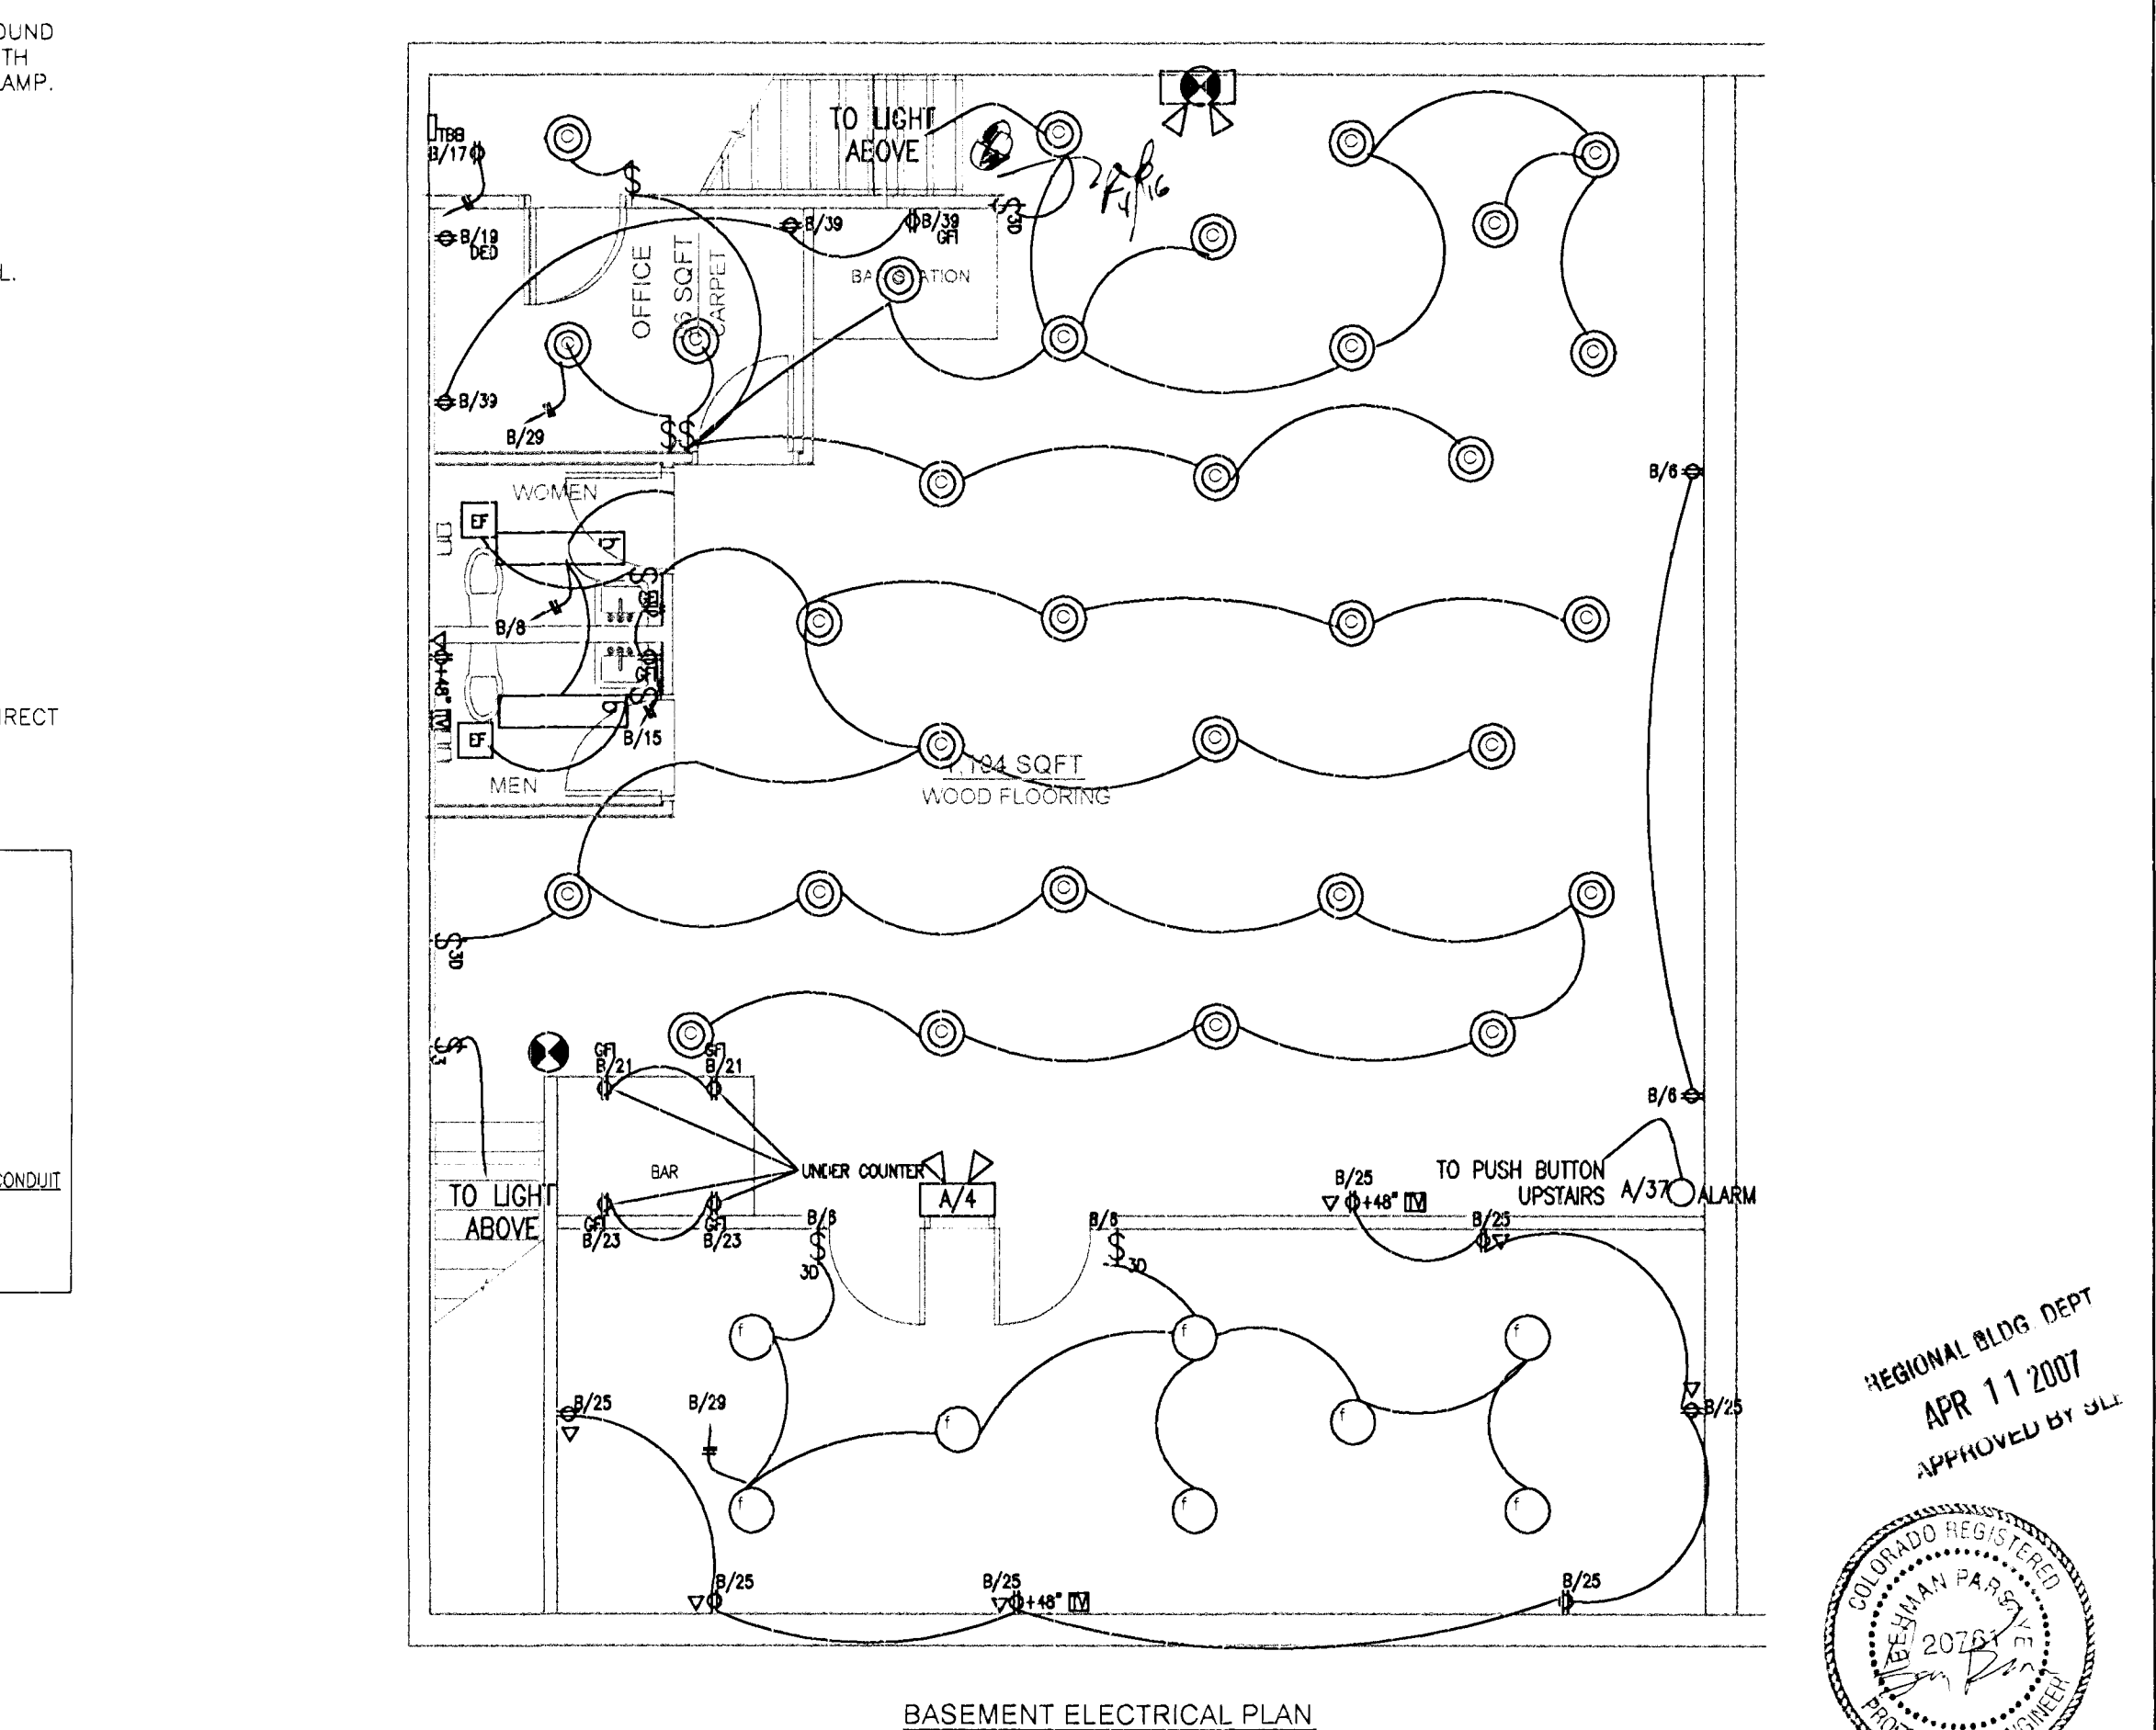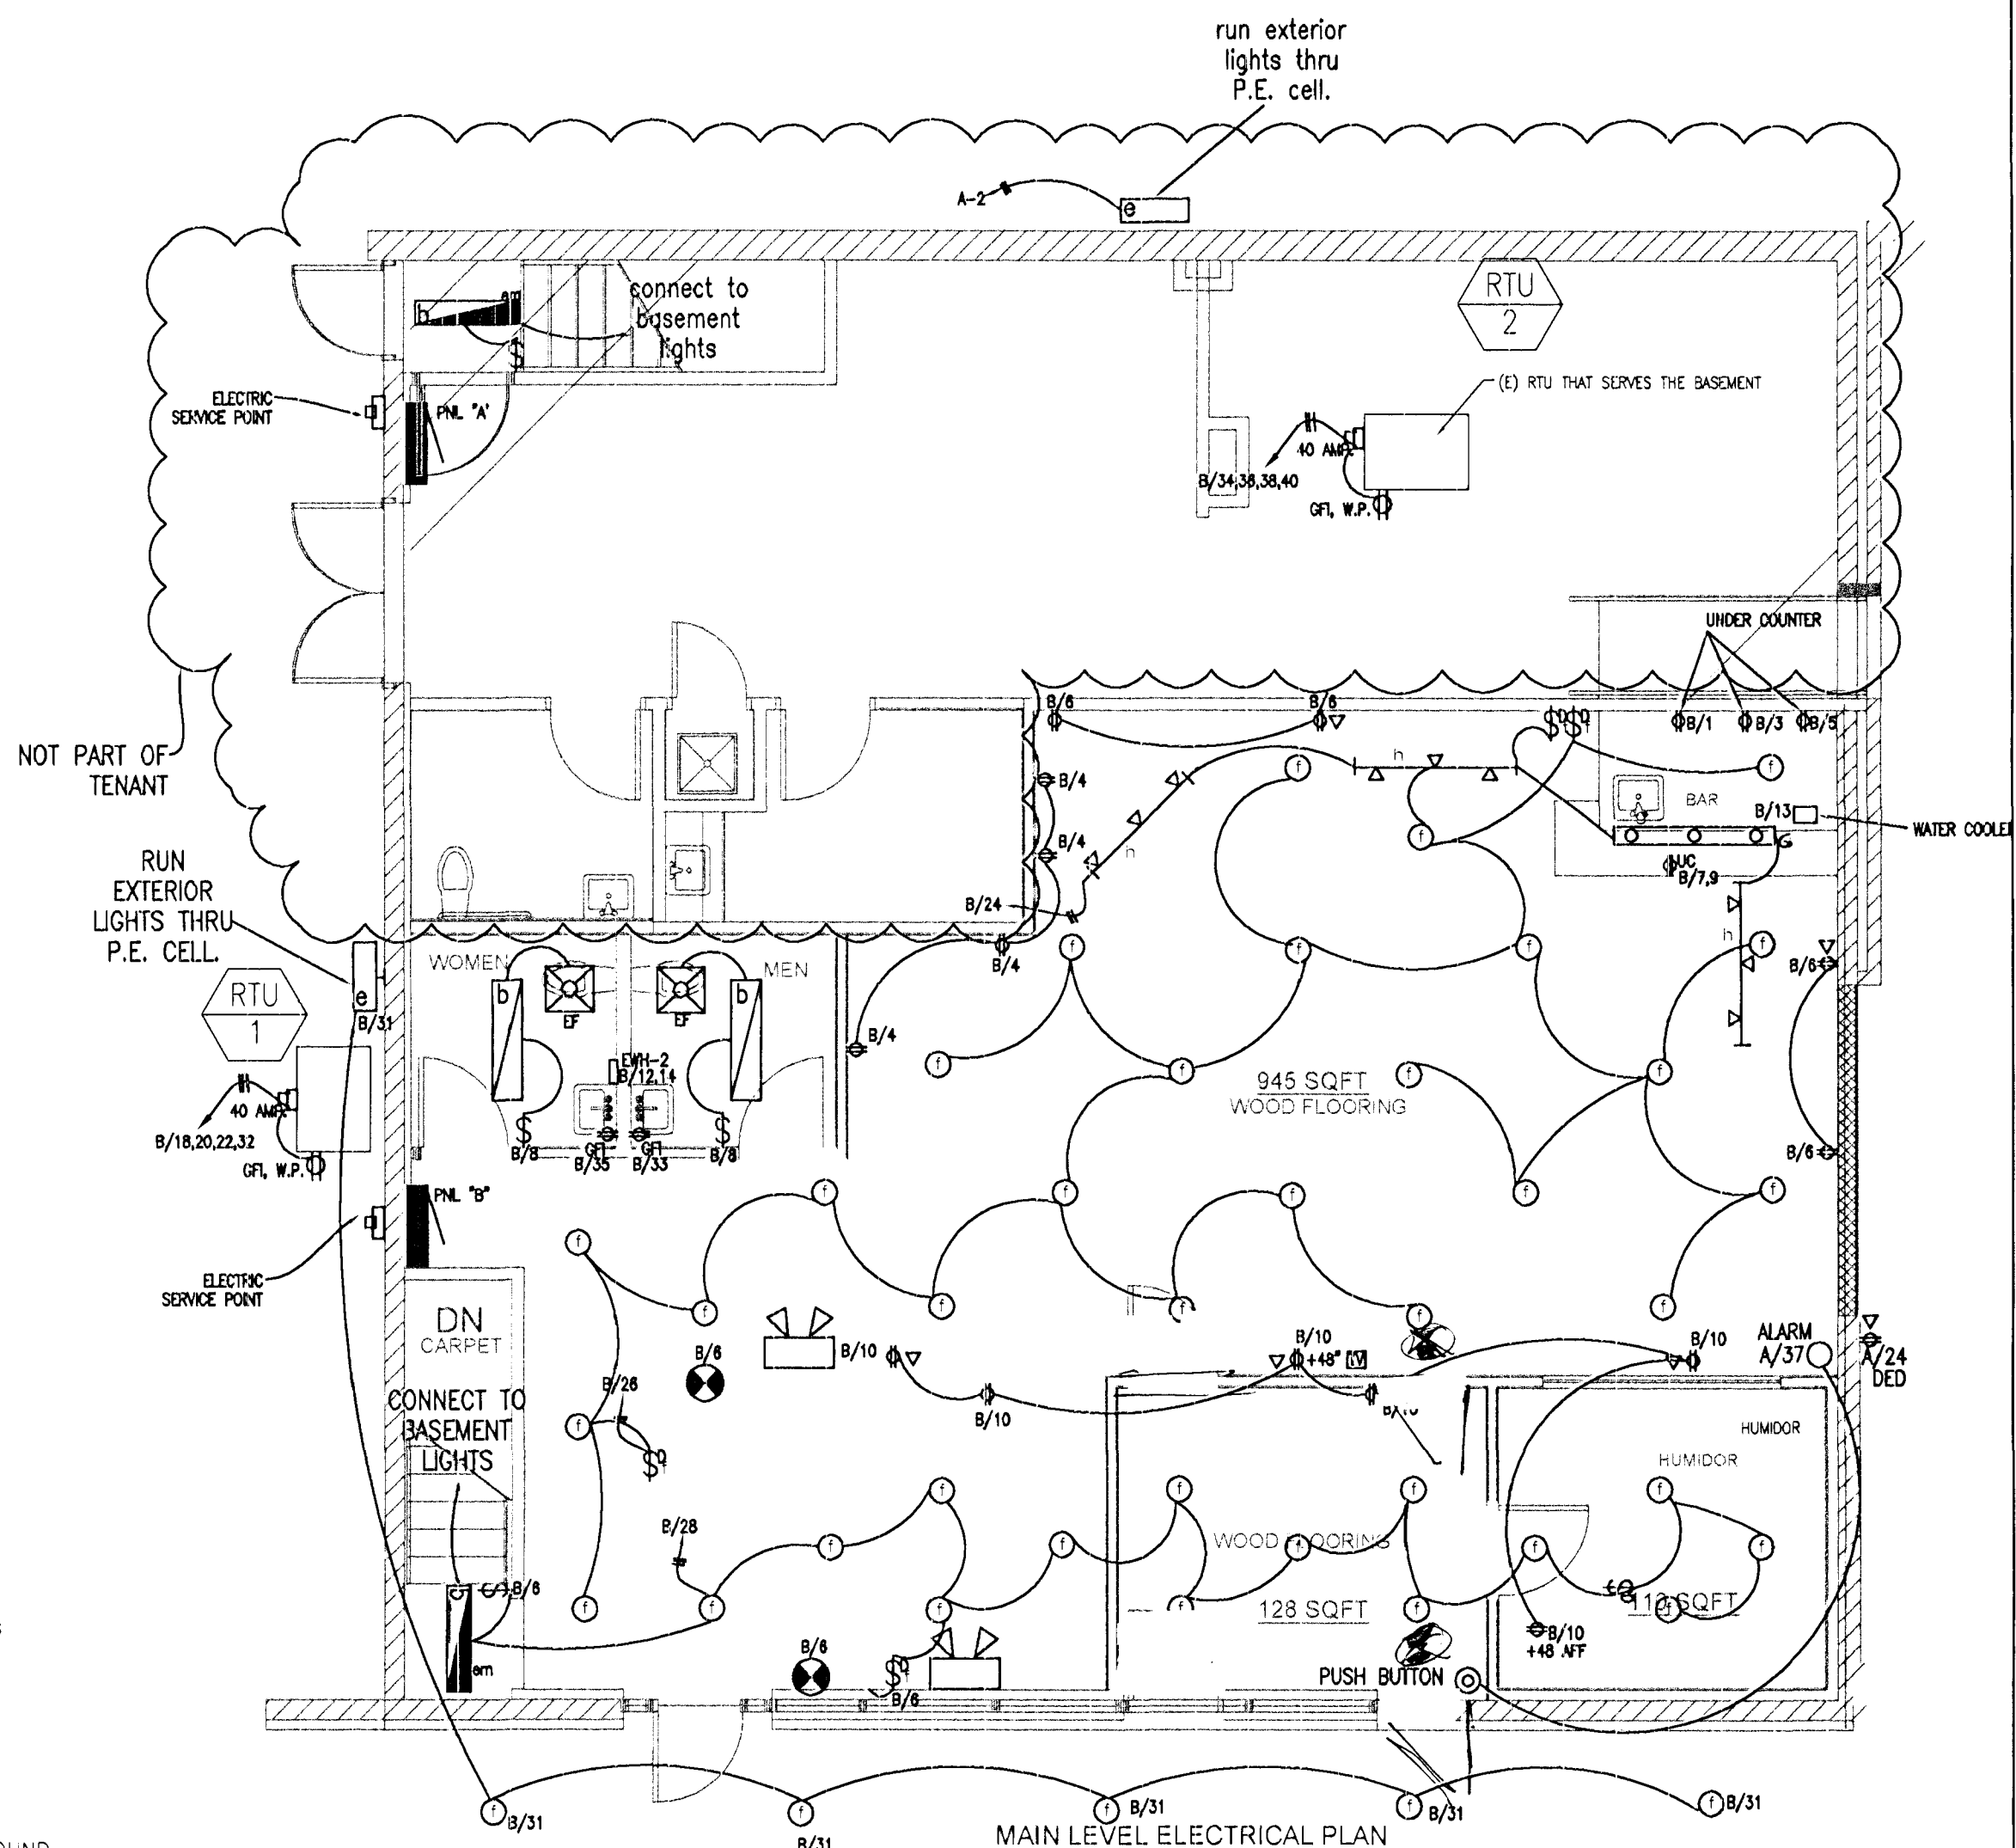

T-BONE
CONSTRUCTION INC.
GENERAL CONTRACTOR

Design & Development Consultants @

(719) 570-1456
1530 VALLEY STREET
COLORADO SPRINGS, CO 80916

COBALT CLUB

06-0132

NOTICE: THE OWNER, CONTRACTOR, ARCHITECT, AND ENGINEER SHALL BE RESPONSIBLE FOR THE ACCURACY OF THE INFORMATION PROVIDED IN THIS DOCUMENT. THE CONTRACTOR SHALL BE RESPONSIBLE FOR THE ACCURACY OF THE INFORMATION PROVIDED IN THIS DOCUMENT. THE CONTRACTOR SHALL BE RESPONSIBLE FOR THE ACCURACY OF THE INFORMATION PROVIDED IN THIS DOCUMENT.

REVISION

TENANT REMODEL

124 E. COSTILLA ST

DRAWN BY: MS

DATE: 04/02/07

CHECK BY: SP

SHEET #

E1

APPROVED BY: [Signature]

REGIONAL BLDG DEPT
APR 11 2007
APPROVED BY: [Signature]


4-2-07

ELECTRICAL LEGEND

K	POWER PANELBOARD "K" MOUNT TOP 6'-0" ABOVE FINISHED FLOOR. SEE PANELBOARD SCHEDULE FOR EQUIPMENT CONTAINED IN PANELBOARD AND PANELBOARD RATINGS.
⊙	JUNCTION BOX. SIZE AND USE AS REQUIRED. COVERPLATE SHALL OVERLAP THE BOX EDGE BY 1/2" WHERE RECESSED IN WALL WITH CONCEALED WIRING.
□	4" SQUARE JUNCTION BOX.
X S W C	EXIT SIGN. "X" INDICATES FIXTURE TYPE. "C" INDICATES CEILING MOUNTED. "W" INDICATED WALL MOUNTED. "S" INDICATES SINGLE FACE. "D" INDICATES DOUBLE FACE. PROVIDE DIRECTIONAL ARROWS AS INDICATED ON PLANS. UNIT EQUIPPED WITH BATTERY BACK-UP.
⊕	208V OUTLET OR SPECIAL PURPOSE OUTLET.
⊕	ISOLATED GROUND TYPE DUPLEX RECEPTACLE. 125V, 20A IN ORANGE COLOR - MOUNT 3" ABOVE BACKSPASH AT WORK COUNTERS AND 22" ABOVE FINISHED FLOOR UNLESS OTHERWISE NOTED. PROVIDE HUBBELL OR LEVITON COMMERCIAL SPECIFICATION GRADE.
⊕ GFI	DUPLEX RECEPTACLE - 125V, 20A MOUNT 3" ABOVE BACKSPASH AT WORK COUNTERS AND LAVATORIES AND +22" ABOVE FINISHED FLOOR UNLESS OTHERWISE NOTED. GFI INDICATES GROUND FAULT CIRCUIT INTERRUPTER TYPE. WP INDICATES WEATHERPROOF COVER HUBBELL OR LEVITON COMMERCIAL SPECIFICATION GRADE.
⊕ GFI WP	QUADRUPLUX CONVENIENCE OUTLET - 125V, 20A MOUNT +22" ABOVE FINISHED FLOOR UNLESS OTHERWISE NOTED. HUBBELL OR LEVITON COMMERCIAL SPECIFICATION GRADE.
⊕ GFI WH	MISCELLANEOUS MECHANICAL EQUIPMENT. WH=WATER HEATER, UH=UNIT HEATER.
⊕ GFI E	COMBINATION EXIT SIGN AND EMERGENCY LIGHTING UNIT, BATTERY BACK-UP POWERED.
⊕ GFI E	EMERGENCY LIGHTING UNIT, BATTERY BACK-UP POWERED.
30 X	CANLIGHT/DOWNLIGHT FIXTURE. "A" IS THE FIXTURE TYPE IN THE FIXTURE SCHEDULE. "G" INDICATES WHICH SWITCH CONTROLS THE FIXTURE; AND "3" INDICATES WHICH PANELBOARD CIRCUIT THE FIXTURE IS FED FROM.
A 30	FLUORESCENT LIGHTING FIXTURE. "A" IS THE FIXTURE TYPE IN THE FIXTURE SCHEDULE. "G" INDICATES WHICH SWITCH CONTROLS THE FIXTURE; AND "3" INDICATES WHICH PANELBOARD CIRCUIT THE FIXTURE IS FED FROM.
A 30	FLUORESCENT LIGHTING FIXTURE WITH BUILT IN EMERGENCY BATTERY PACK TO PROVIDE LIGHTING WHEN NORMAL POWER IS NOT AVAILABLE. PROVIDE UNSWITCHED "HOT" CONDUCTOR FROM SAME CIRCUIT FIXTURE IS ON TO BATTERY PACK IN ORDER TO ALLOW NORMAL SWITCHING OF LIGHT FIXTURE WITHOUT DISCHARGING BATTERY PACK.
—	CONDUIT AND CONDUCTORS CONCEALED IN CEILING EXTEND TO PANELBOARD "K". CROSS HATCHES INDICATE NUMBER OF #12 AWG CONDUCTORS
—	CONDUIT UNDERGROUND
—	HOME RUN - K INDICATES PANELBOARD
K-1,3,5	1,3,5 INDICATE CIRCUIT NOS
—	MARKS INDICATE NO. OF #12 CONDUCTORS IN 3/4" CONDUIT - =PHASE, =NEUTRAL, =GROUND
—	NO MARKS INDICATE 2 #12 #120. WHEN 2 OR MORE CIRCUITS SHARE A COMMON NEUTRAL THE HOT CONDUCTORS MUST BE CONNECTED TO DIFFERENT PHASES IN THE PANELBOARD.
△	POINT OF SALE (POS) SYSTEM OUTLET.
△	TELEVISION OUTLET MOUNT 18" ABOVE FINISHED FLOOR UNLESS NOTED OTHERWISE. EXTEND 1" EMPTY CONDUIT FROM OUTLET BOX AS INDICATED AND TERMINATE WITH BUSHING. PROVIDE NYLON PULL CORD IN EACH CONDUIT. PROVIDE 4" SQUARE BOX WITH SINGLE GANG DEVICE RING.
△	TELEPHONE/DATA OUTLET MOUNT 18" ABOVE FINISHED FLOOR UNLESS NOTED OTHERWISE. EXTEND 3/4" EMPTY CONDUIT FROM OUTLET BOX ABOVE CEILING AND TERMINATE WITH BUSHING. PROVIDE TWO CATEGORY 5e, 4-PAIR, NON-PLENUM CABLES TO EACH OUTLET. PROVIDE 4" SQUARE BOX WITH FACE PLATE WITH TWO CAT 5e, RJ-45 JACKS AT EACH OUTLET LOCATION. LABEL ONE JACK FOR "VOICE" AND ONE JACK FOR "DATA" AT EACH LOCATION. DATA CABLE SHALL BE "ORANGE"; VOICE CABLE SHALL BE "WHITE" IN COLOR. EACH VOICE RUN SHALL TERMINATE AT EXISTING TELEPHONE BACKBOARD (TBB). EACH DATA RUN SHALL TERMINATE AT OWNER PROVIDED EQUIPMENT. FINAL CONNECTIONS BY OWNER. TEST AND CERTIFY EACH VOICE / DATA CABLE. PROVIDE TEST RESULTS TO OWNER.
S0	LOCAL WALL SWITCH, SINGLE POLE MOUNT +48" ABOVE FINISHED FLOOR. "D" INDICATES DIMMER SWITCH. SPECIFICATION GRADE HUBBELL OR LEVITON.
S1	LOCAL WALL SWITCH, 3 WAY, MOUNT +48" ABOVE FINISHED FLOOR
S4	LOCAL WALL SWITCH, SINGLE POLE, KEY OPERATED, MOUNT +48" ABOVE FINISHED FLOOR
30	FUSED DISCONNECT SWITCH. "60" INDICATES SWITCH SIZE. "30" INDICATES FUSE SIZE. HEAVY DUTY "HP" RATED, PROVIDE NEMA 3R ENCLOSURES OUTDOORS. FUSE PER NAMEPLATE OF EQUIPMENT.
30	NON-FUSED DISCONNECT SWITCH. "30" INDICATES SWITCH SIZE. HEAVY DUTY "HP" RATED, PROVIDE NEMA 3R ENCLOSURES OUTDOORS.
1/3	A.C. MOTOR "1/3" INDICATES HORSEPOWER.
TBB	TELEPHONE BACKBOARD 4' X 4' 3/4" THICK FIRE RESISTIVE PLYWOOD. MOUNT TOP OF THE PLYWOOD 6'-0" ABOVE FINISHED FLOOR. INSTALL #6 SOLID COPPER GROUND TO NEAREST BUILDING STEEL. PROVIDE 1-120V, 20A, DUPLEX RECEPTACLE ON DEDICATED CIRCUIT. PAINT WITH 2 COATS OF FIRE RESISTIVE PAINT.
⊕	DUCT SMOKE DETECTOR. 1-SUPPLY AIR DUCT, 1-RETURN AIR DUCT, SUPPLIED BY FIRE ALARM CONTRACTOR. ELECTRICAL CONTRACTOR TO WIRE THE DUCT SMOKE DETECTORS TO SHUT DOWN THE RTU IN THE EVENT EITHER SUPPLY OR THE RETURN DUCT DETECTOR GOES INTO ALARM.
F	FIRE ALARM PULL STATION MOUNT 48" A.F.F.
⊕	FIRE ALARM COMBINATION AUDIO/VISUAL HORN STROBE DEVICE. MOUNT 80" A.F.F.
⊕	FIRE ALARM SMOKE DETECTOR.
⊕	FIRE ALARM HEAT DETECTOR.
⊕	FIRE ALARM VISUAL ONLY STROBE DEVICE. MOUNT 80" A.F.F.
⊕	FIRE ALARM TAMPER SWITCH.
⊕	FIRE ALARM FLOW SWITCH.
FACP	FIRE ALARM CONTROL PANEL, MOUNT TOP 6'-0" A.F.F.
RAP	REMOTE ANNUNCIATOR PANEL FOR FACP. MOUNT TOP AT 6'-0" A.F.F.

ELECTRICAL GENERAL NOTES

1. BASE BUILDING SPECIFICATIONS, DRAWINGS AND LATEST REVISION OF CONTRACT DOCUMENTS FOR ELECTRICAL WORK SHALL APPLY TO ELECTRICAL DRAWINGS.
2. ALL WORK SHALL BE DONE IN COMPLIANCE WITH THE TENANT FINISH SPECIFICATIONS, DRAWINGS AND LATEST REVISIONS OF ALL NATIONAL CODES SUCH AS THE NEC, NFPA AND ALL APPLICABLE LOCAL CODES AND ORDINANCES.
3. GENERAL SCOPE OF WORK REQUIRES INSTALLATION OF NEW LIGHTING FIXTURES, ELECTRICAL DEVICES AND EQUIPMENT.
4. ELECTRICAL CONTRACTOR SHALL VISIT SITE AND EXAMINE DRAWINGS OF OTHER TRADES ON THIS PROJECT, ARCHITECTURAL AND MECHANICAL, TO DETERMINE ANY ADDITIONAL WORK THAT MAY BE REQUIRED FOR A COMPLETE AND OPERATIONAL ELECTRICAL INSTALLATION AND SHALL INCLUDE AN ALLOWANCE FOR THIS WORK IN HIS BID.
5. CONTRACTOR SHALL BE HELD RESPONSIBLE FOR VERIFICATION OF EXISTING JOB CONDITIONS PRIOR TO BID. NO ADDITIONAL COSTS SHALL BE AWARDED TO THE SUCCESSFUL CONTRACTOR OR HIS SUBCONTRACTORS, AFTER BIDS HAVE BEEN SUBMITTED AND CONTRACTS AWARDED, FOR FAILURE TO VERIFY EXISTING JOB CONDITIONS. DISCREPANCIES BETWEEN ACTUAL FIELD CONDITIONS AND CONTRACT DOCUMENTS SHALL BE BROUGHT TO THE ENGINEER'S ATTENTION FOR ALTERNATIVE METHODS OF INSTALLATION THREE(3) DAYS MINIMUM PRIOR TO BIDDING THIS JOB TO ALLOW FOR ISSUANCE OF CLARIFICATIONS.
6. SPLICES ON #8 OR SMALLER SHALL BE WITH "SKOTCH-LOCK" SPRING CONNECTORS. FOR LARGER SIZE CONDUCTORS USE SOLDERLESS CONNECTORS.
7. OUTLET BOXES SHALL BE APPROVED TYPE
8. THE CONDUIT SYSTEM AND ALL CONDUCTING WIRE ENCLOSURES SHALL BE SECURELY BONDED TOGETHER.
9. WIRING INSIDE THE BUILDING AND ABOVE GROUND SHALL BE COPPER, TYPE THHN/THWN. WIRING IN CONDUIT, UNDERGROUND OR IN DAMP LOCATIONS SHALL BE COPPER, TYPE THWN. MINIMUM SIZE CONDUCTOR SHALL BE NO. 12 GAUGE SOLID NO. 6 GAUGE AND LARGER STRANDED. WHERE AUTHORIZED USE OF MC TYPE FLEXIBLE CABLE IS INSTALLED IN LIEU OF WIRE AND CONDUIT. FULL SIZE GROUND WIRE SHALL BE RUN WITH CURRENT-CARRYING CONDUCTORS.
10. PROVIDE TYPE-WRITTEN UPDATED PANEL DOOR DIRECTORIES FOR ALL AFFECTED PANELS REFLECTING ALL CIRCUITS WITH THEIR ACCURATE DESTINATIONS.
11. RECEPTACLES 120V DUPLEX GROUNDING TYPE, SHALL BE APPROVED TYPE.
12. SWITCHES SHALL BE TOGGLE TYPE AND APPROVED TYPE.
13. COVER PLATES SHALL BE PLASTIC, COLOR TO MATCH. PROVIDE BLANK COVER PLATES FOR ALL UNUSED OR DAMAGED JUNCTION BOXES (NEW & EXISTING)
14. PREPARE AND MAINTAIN AT JOB SITE ACCURATE UPDATED " AS BUILT" DRAWINGS.
15. ALL ELECTRICAL EQUIPMENT, DEVICES, CIRCUITING, ETC, SHOWN DIAGRAMMATICALLY ONLY, ELECTRICAL CONTRACTOR SHALL BE RESPONSIBLE FOR ACTUAL LOCATION AND WIRING AVOIDING MECHANICAL AND OTHER EQUIPMENT.
16. ALL NEW MATERIALS INSTALLED IN CEILING PLENUM SHALL BE U.L. LISTED CLASS I RATED FOR LOW VOLTAGE CABLE OR CONDUCTORS NOT IN CONDUIT. INSULATION HAS TO MEET NON-TOXICITY REQUIREMENTS.
17. FURNISH AND INSTALL LIGHTING FIXTURES COMPLETE WITH LAMPS, BALLASTS, AND REQUIRED MOUNTING HARDWARE. PRIOR TO ORDERING FIXTURES, VERIFY MOUNTING METHODS AND FINISHES.
18. SEE LEGEND, LIGHTING AND POWER NOTES, MECHANICAL AND ARCHITECTURAL DRAWINGS FOR SUPPLEMENTAL INFORMATION ON LOCATIONS, MOUNTING HEIGHTS, ETC. DIMENSIONS ON ARCHITECTURAL DRAWINGS TAKE PRECEDENCE OVER THE ELECTRICAL DRAWINGS.
19. WALL MOUNTED RECEPTACLES, TELEPHONE AND DATA OUTLETS SHALL BE MOUNTED AT 18" A.F.F. UNLESS OTHERWISE NOTED.
20. CIRCUIT BREAKERS SHALL BE MOLDED CASE TYPE WITH THERMAL MAGNETIC TRIPS WITH FRAME SIZE, NUMBER OF POLES AND TRIP SETTING AS SHOWN.
21. PANELS- SHALL BE BOLT-ON TYPE WITH QUICK-MAKE, QUICK-BREAK CIRCUIT BREAKERS, THERMAL MAGNETIC TRIPS WITH FRAME SIZE, NUMBER OF POLES AND TRIP SETTING AS SHOWN ON PLANS. ALL PANELS SERVING COMPUTERS, ISOLATED GROUND SHALL BE FURNISHED WITH ISOLATED GROUND BUS.
22. UNLESS OTHERWISE INDICATED, ALL WIRING FOR BRANCH CIRCUITS SHALL BE # 12 AWG PROTECTED BY 20 AMP CIRCUIT BREAKERS. IF DISTANCE FROM PANEL TO FIRST OUTLET IS 75 FEET OR GREATER FOR 120V CIRCUIT OR 150 FEET OR GREATER FOR 277V CIRCUITS # 10 WIRING SHALL BE INSTALLED.
23. ELECTRICAL CONTRACTOR SHALL COORDINATE EXACT LOCATIONS OF ALL MECHANICAL EQUIPMENT WITH MECHANICAL DRAWINGS.
24. THE SUB-CONTRACTOR SHALL ARRANGE FOR ALL INSPECTIONS WHEN THEY BECOME DUE AND SHALL NOT COVER ANY WORK UNTIL APPROVED BY THE INSPECTION AUTHORITY.
25. ELECTRICAL CONTRACTOR SHALL MAINTAIN ALL WORKING CLEARANCES FOR ALL ELECTRICAL EQUIPMENT PER N.E.C. REQUIREMENTS.
26. WHERE LIGHT FIXTURES LOCATIONS INTERFERE WITH DUCT OR CEILING SUPPORTS, RELOCATE SUPPORTS. IF IMPOSSIBLE, CONTACT ARCHITECT. USE END CONNECTOR LIGHT FIXTURES UNDER LOW DUCT WORK.
27. INDEPENDENTLY SUPPORT FLEXIBLE WHIPS FOR ALL NEW OR RELOCATED FIXTURES FROM THE GRID SUPPORT SYSTEM.
28. COORDINATE ALL MECHANICAL EQUIPMENT LOCATIONS AND SPECIFICATIONS WITH MECHANICAL CONTRACTOR PRIOR TO ROUGH-IN. PROVIDE FUSED OR NON-FUSED DISCONNECT SWITCHES AS REQUIRED BY THE MANUFACTURERS SPECIFICATIONS.
29. LABEL RECEPTACLES COVERPLATES WITH PANEL DESIGNATION AND CIRCUIT NUMBERS WHERE RECEPTACLES ARE BEING FED FROM MORE THAN ONE CIRCUIT.
30. CONNECT EXIT LIGHTS AND FLUORESCENT EMERGENCY LIGHTS AS SHOWN.
31. VERIFY CLEARANCE OF BEAM, DUCT WORK, ETC, IN CEILING SPACE BELOW AND X-RAY FOR CONDUIT AND REBAR IN SLAB BEFORE CORE DRILLING. CONTACT ARCHITECT IMMEDIATELY IF ANY CLEARANCE PROBLEMS OCCUR.

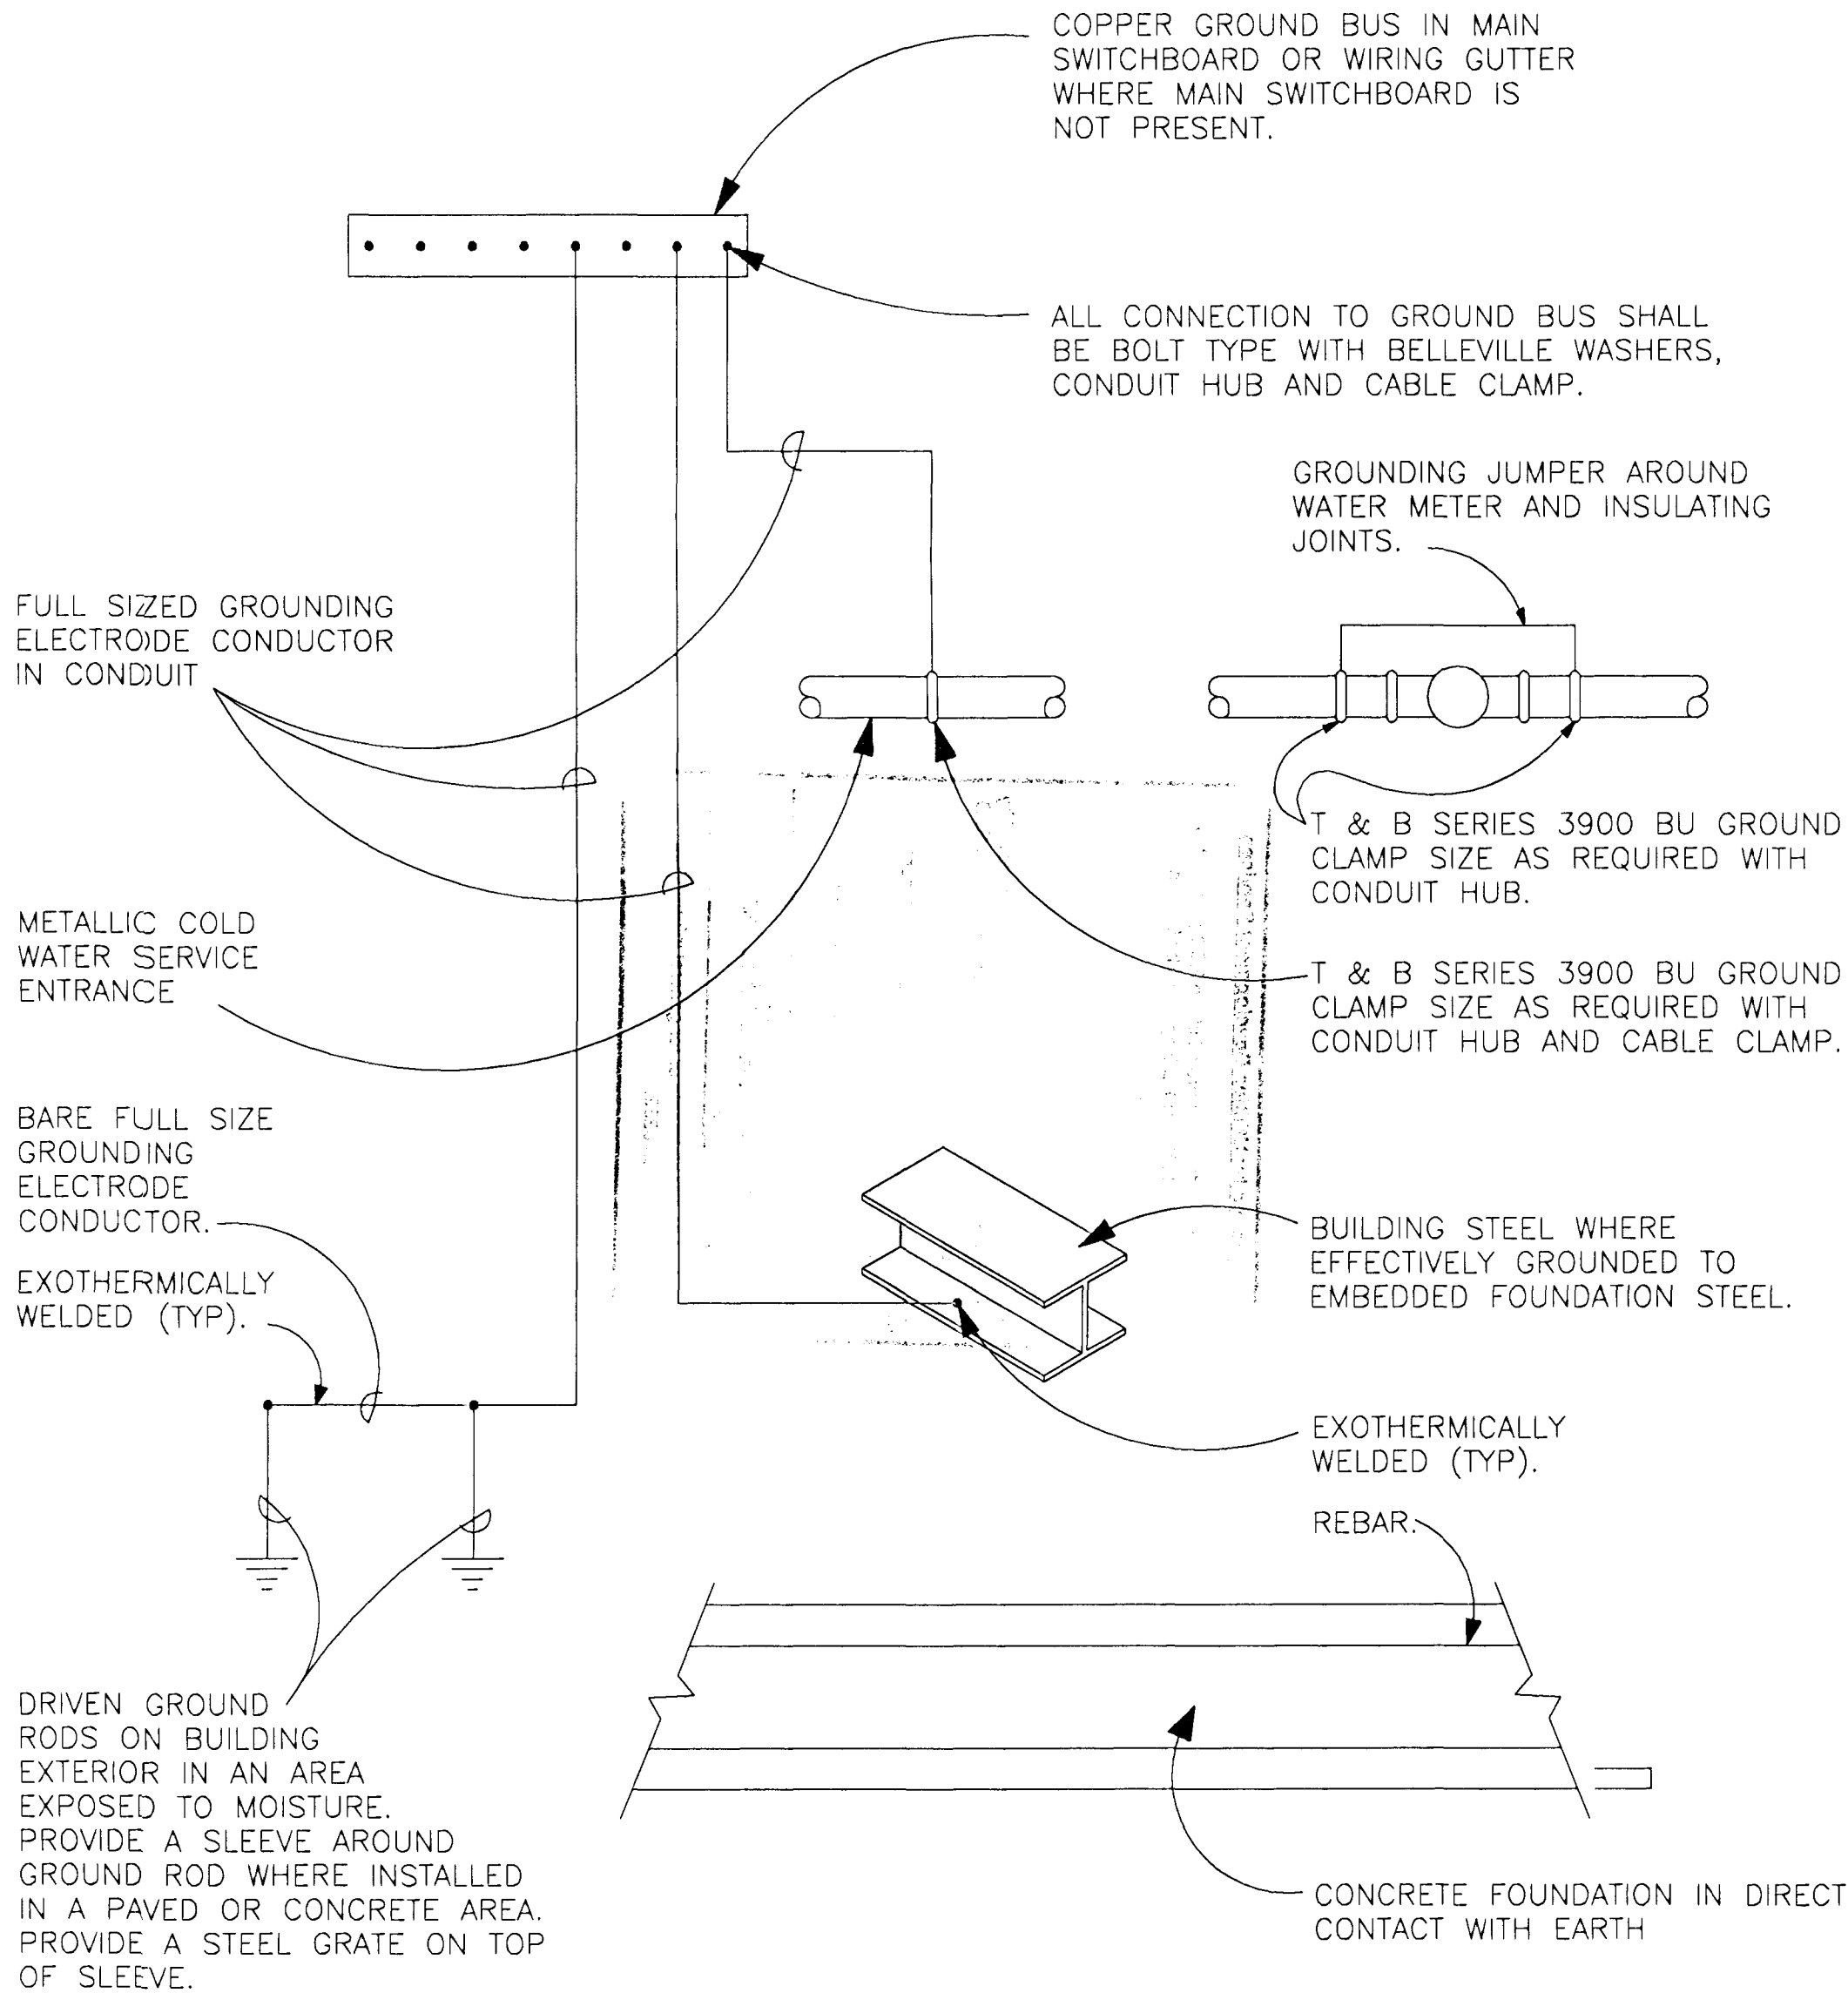

SERVICE GROUNDING DETAIL

NOT TO SCALE

NOTES:

1. WHEN AVAILABLE, CONTRACTOR SHALL PROVIDE ALL GROUNDING MEANS INDICATED. CONTRACTOR SHALL REFER TO ELECTRICAL INE LINE DIAGRAM FOR GROUNDING ELECTRODE CONDUCTOR SIZE. CONTRACTOR SHALL REFER TO ELECTRICAL SPECIFICATIONS FOR SPECIES OF GROUNDING SYSTEM INSTALLATION AND MATERIALS.
2. THE GROUNDING ELECTRODE CONDUCTOR SHALL BE RUN CONTINUOUS FROM THE SWITCHBOARD GROUND BUS AND TERMINATED AS DIRECTED BY LOCAL INSPECTION AUTHORITY. THE GROUNDING ELECTRODE CONDUCTOR SHALL BE FROM THE GROUND SOURCE DESIGNATED BY THE INSPECTION AUTHORITY. EACH GROUNDING ELECTRODE CONDUCTOR SHALL BE IDENTIFIED AS TO ITS SOURCE OR DESTINATION IN THE GROUNDING SYSTEM.



T-BONE
GENERAL CONTRACTOR

Design & Development Consultants @

1330 VALLEY STREET
COLORADO SPRINGS, CO 80915
(719) 570-1456

COBALT CLUB

06-0132

NOTICE:
THIS DRAWING IS THE PROPERTY OF T-BONE GENERAL CONTRACTOR. IT IS TO BE USED ONLY FOR THE PROJECT AND SITE SPECIFICALLY IDENTIFIED HEREON. IT IS NOT TO BE REPRODUCED, COPIED, OR TRANSMITTED IN ANY FORM OR BY ANY MEANS, ELECTRONIC OR MECHANICAL, INCLUDING PHOTOCOPYING, RECORDING, OR BY ANY INFORMATION STORAGE AND RETRIEVAL SYSTEM, WITHOUT THE WRITTEN PERMISSION OF T-BONE GENERAL CONTRACTOR. VIOLATION OF THIS NOTICE IS SUBJECT TO LEGAL ACTION.

REVISIONS

TENANT REMODEL

124 E. COSTILA


DRAWN BY: b.p. 2/08/07

DATE: 2/08/07

CHECK BY: b.p.

SHEET #

E2

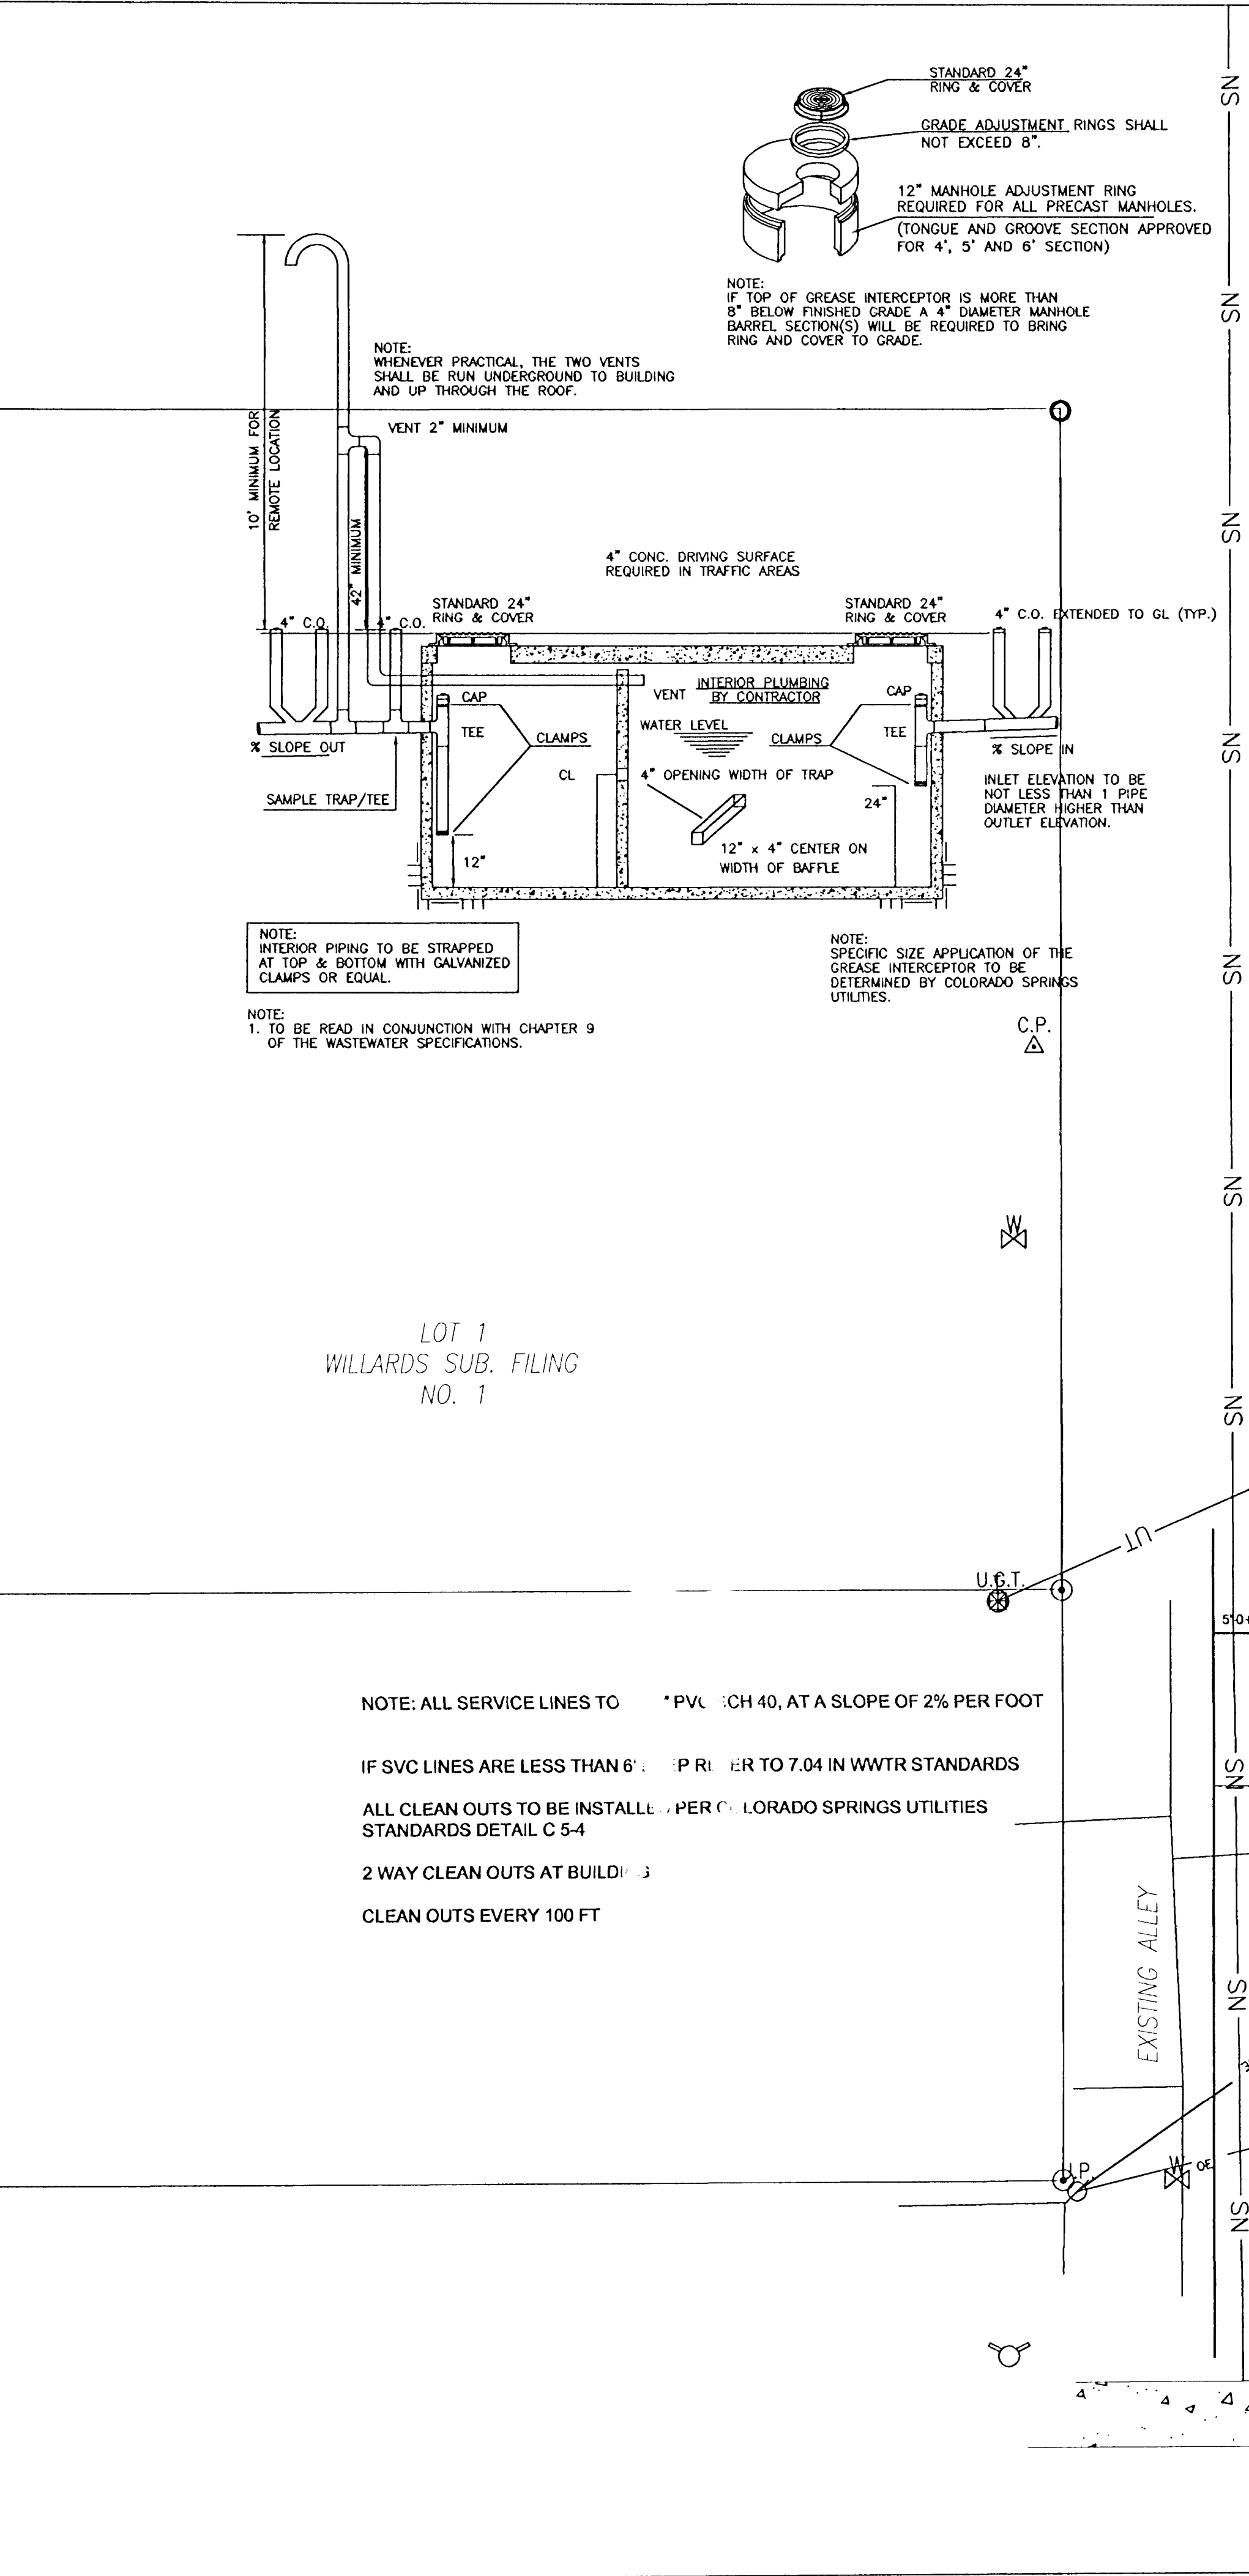


UTILITIES SERVICE PLAN

General Notes for Sanitary Sewer Line


The Contractor shall notify the Colorado Springs Utilities, Dispatch (668-4426) 48 hours prior to the start of construction to outline methods of construction, materials to be used, construction staking.

1. Wastewater service to be located in the center of the lot, or the center of the driveway for a flag lot. (per Wastewater detail drawing C 5-1)
Note: Alternate service location, is only with the approval of Colorado Springs Utilities shown on Wastewater detail drawing C 5-1
2. Sanitary Sewer service to be installed a minimum of 7 feet into the property unless otherwise shown, Water service lines shall be installed to the property line i.e. curb stop box, See Note 8 below.
3. Property end of all sewer service to be marked with a 2"x4"x12 foot wood post extending vertically from flow-line
4. Water service to be marked with a 2"x4"x6 foot wood post extending 4 foot below finish grade.
5. Gas service to be installed at 3 feet above the water service unlessw otherwise shown, or as directed in the field, by the Colorado Springs Utility Inspector.
6. Final location of all sewer, water anf gas service to be approved in the field by the Colorado Springs Utility Inspector.
7. Utility locations, whether or not shown on this plan, in no way relieves the contractor from the responsibility of calling for and obtaining utility locations from the appropriate authorities prior to beginning excavation.
8. Contractor to install water service curb stop box at the Property Line of the street
9. Water service specifies 30" minimum distance between water taps and 36" minimum from any given water joint, and expansion loops. For multiple services in a common trench, maintain a minimum of 6" between service lines and service line can not be crossed. (Note: Maintain 6' separation between Fire line and service tap connections)
10. Sanitary Sewer service connections to be connected at a minimum of 5 feet from any manhole on the main line and 2 feet between taps center eo center.

SIGNED: *Richard D. Friele* DATE: *June 19/2007* FIMS MAP NO: *H-35 1573873*
COLORADO SPRINGS UTILITIES
WASTE WATER SERVICE APPROVAL
PROJECT NO: *2007-081*/RMS NO: *1573873*
DEVELOPMENT PLAN NO: _____

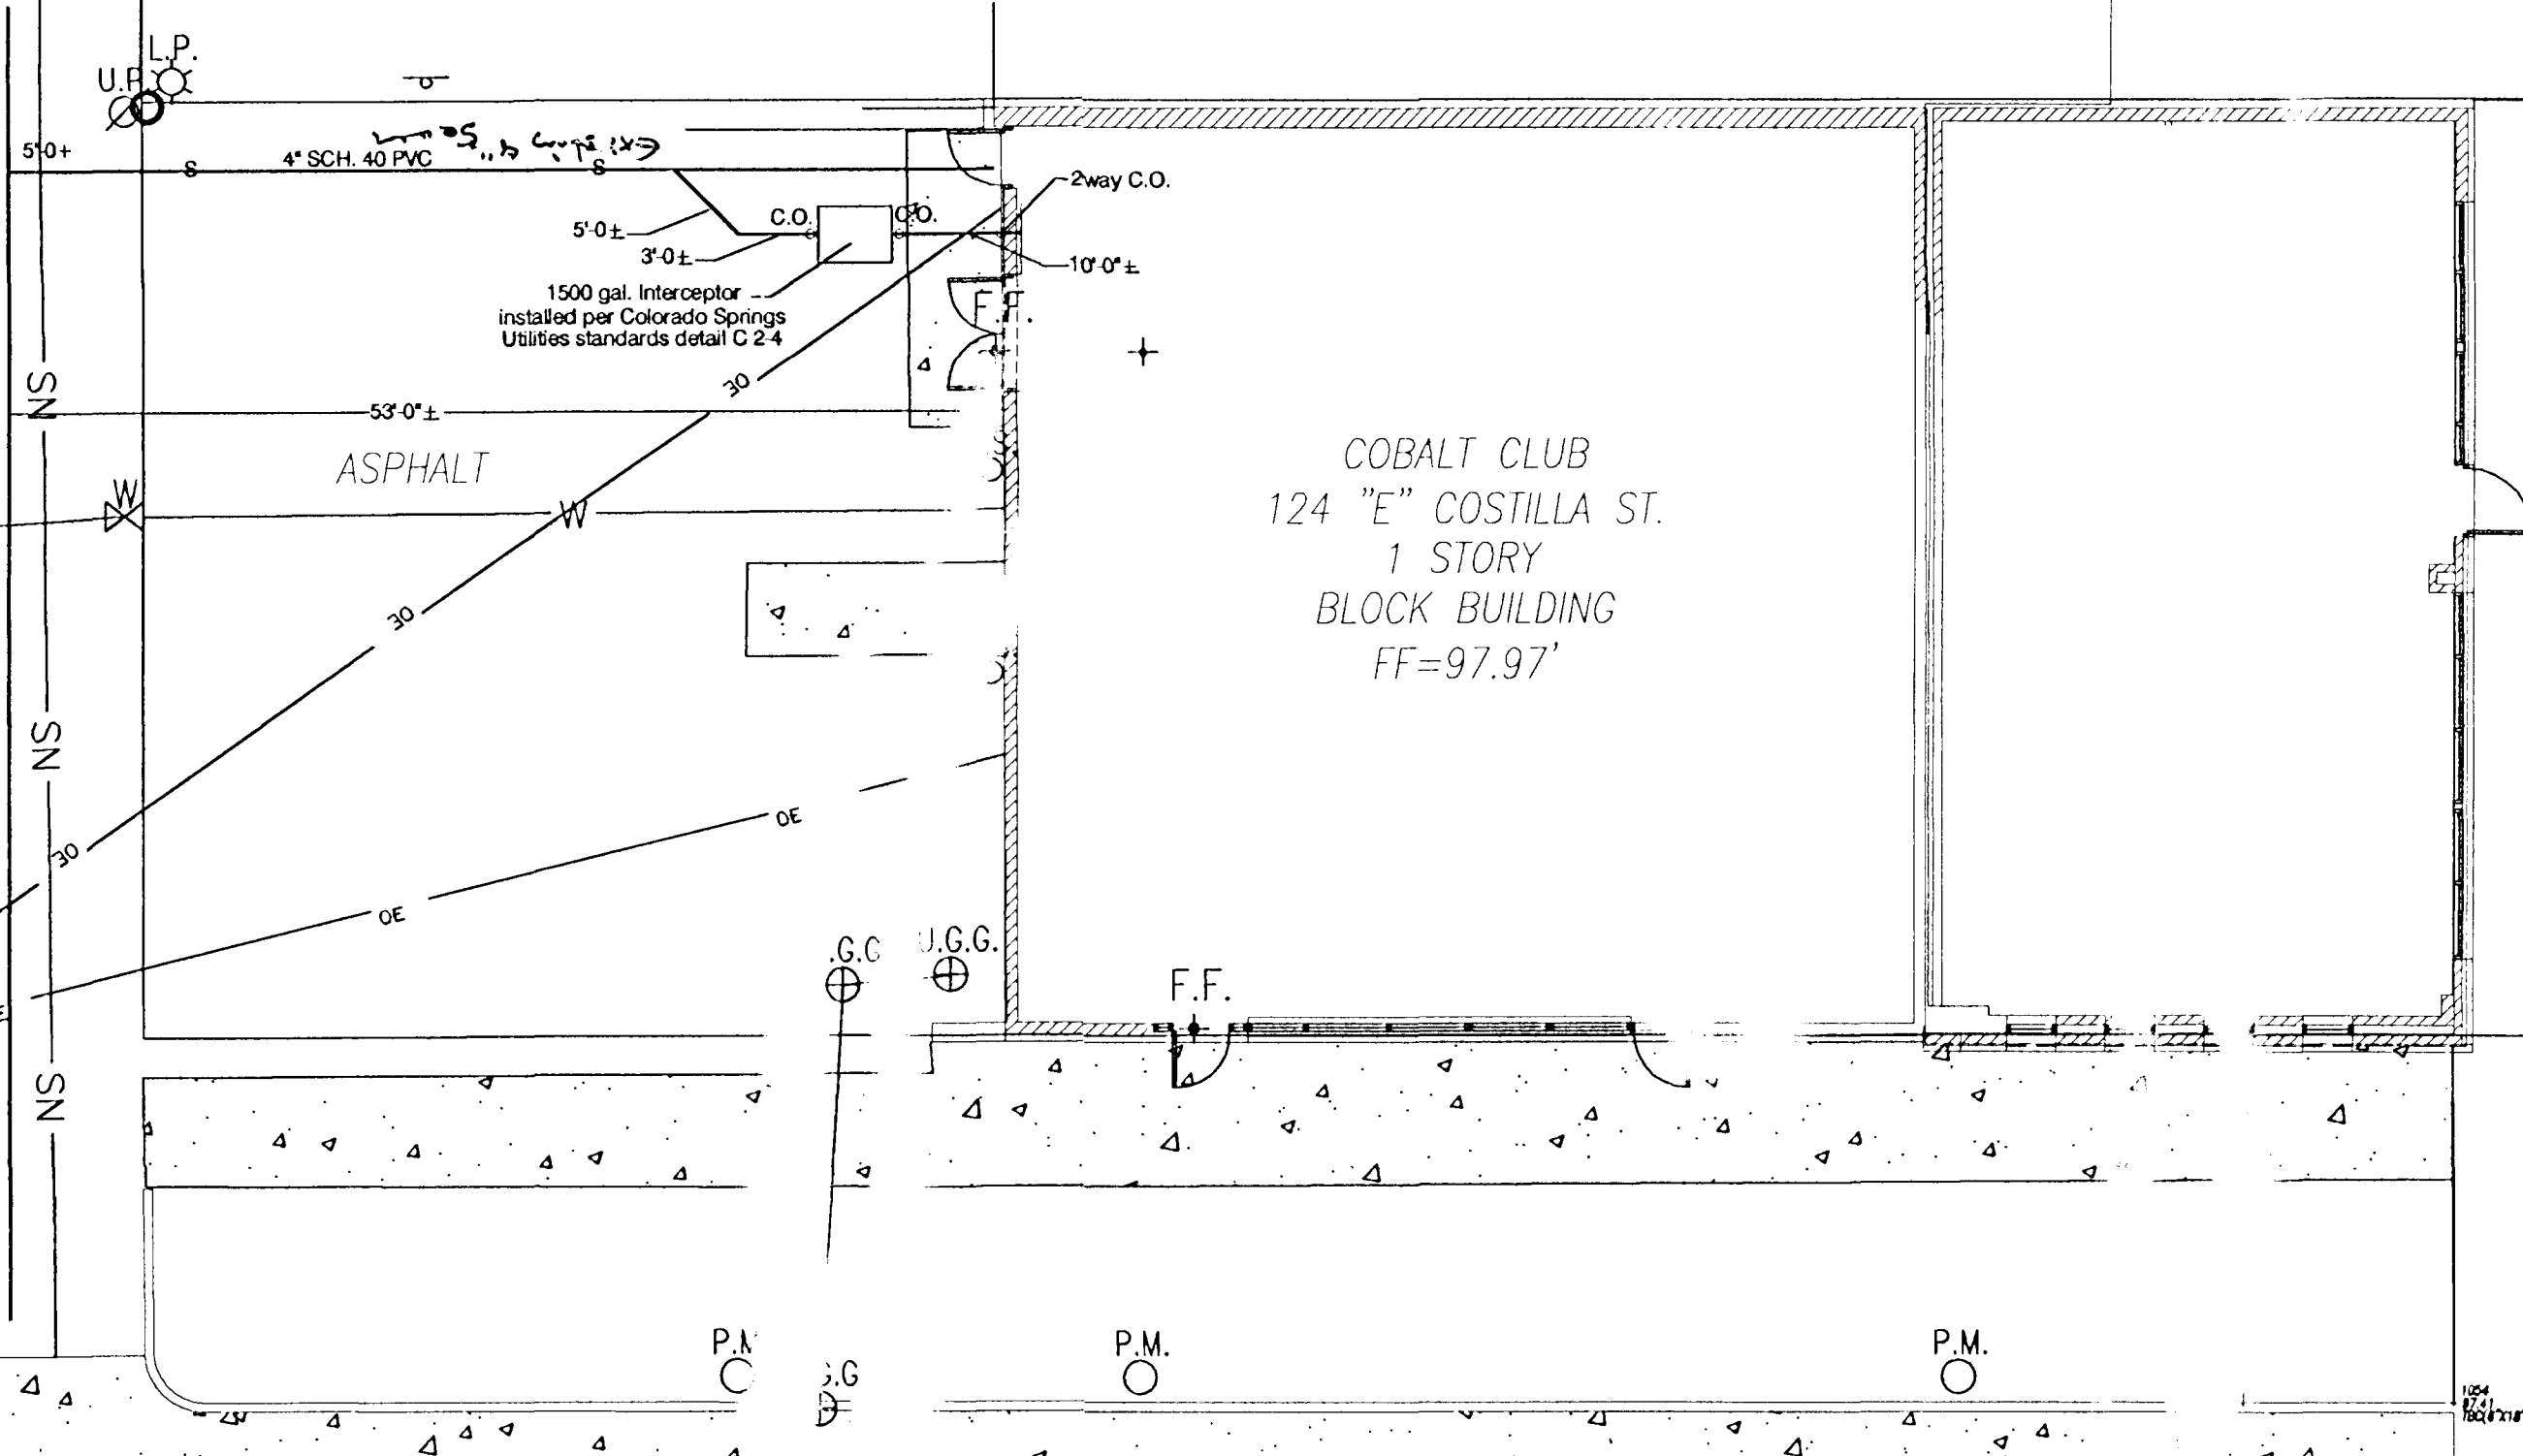

VICINITY MAP

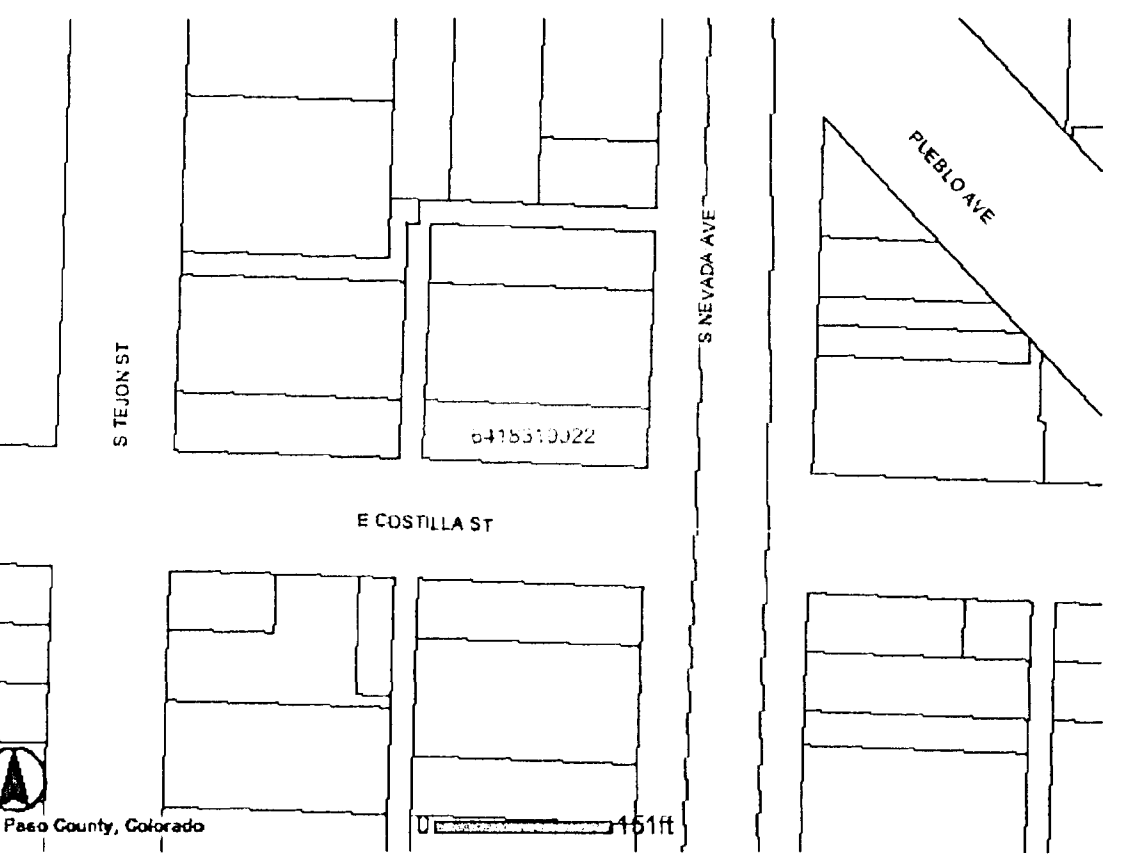

CHINA BUFFET
LOT 6
BLOCK 122
TOWN OF COLORADO
SPRINGS

LOT 5
BLOCK 122
TOWN OF COLORADO
SPRINGS



SCALE 1"=10'-0"

RECEIVED
JUN 19 2007
APPROVED BY TCC

Permit Number *024594*
Plan Number *044533*
Address *124 E. COSTILLA*
Code Description



Design & Development
Consultants @
(719) 570-1456
1333 VALLEY STREET
COLORADO SPRINGS, CO 80915

THE COBALT
CLUB

06-0132

NOTICE:
THIS PLAN IS A PRELIMINARY DESIGN AND IS NOT TO BE USED FOR CONSTRUCTION. THE CONTRACTOR SHALL BE RESPONSIBLE FOR OBTAINING ALL NECESSARY PERMITS AND APPROVALS FROM THE APPROPRIATE AGENCIES. THE CONTRACTOR SHALL BE RESPONSIBLE FOR OBTAINING ALL NECESSARY PERMITS AND APPROVALS FROM THE APPROPRIATE AGENCIES. THE CONTRACTOR SHALL BE RESPONSIBLE FOR OBTAINING ALL NECESSARY PERMITS AND APPROVALS FROM THE APPROPRIATE AGENCIES.

REVISED
3/19/07

THE COBALT CLUB
UTILITIES SERVICE PLAN
124 "E" COSTILLA STREET
DRAWN BY: *JAG* CHECK BY: *6/15/07*

SHEET #
U1



Design & Development
Consultants @
(719) 570-1456
1330 VALLEY STREET
COLORADO SPRINGS, CO 80915


THE COBALT
CLUB

06-0132
NOTICE:
THIS DRAWING, MATERIAL, AND INFORMATION
IS THE PROPERTY OF T-BONE CONSTRUCTION, INC.
AND IS TO BE USED ONLY FOR THE PROJECT AND
LOCATION SPECIFICALLY IDENTIFIED HEREON.
ANY OTHER REUSE, REPRODUCTION, OR
TRANSMISSION OF THIS INFORMATION WITHOUT
THE WRITTEN PERMISSION OF T-BONE CONSTRUCTION, INC.
IS PROHIBITED.

REVISION	DATE	BY	DESCRIPTION
1	3/19/07	E.M.	3/23/07
2	5/30/07	E.M.	6/07/07 BP
3	6/07/07	BP	6/11/07 BP

THE COBALT CLUB	BASEMENT PLAN	124 "E" COSTILLA STREET	DRAWN BY: MS	CHECK BY: BP	DATE: 6/7/07
-----------------	---------------	-------------------------	--------------	--------------	--------------

SHEET #
P1

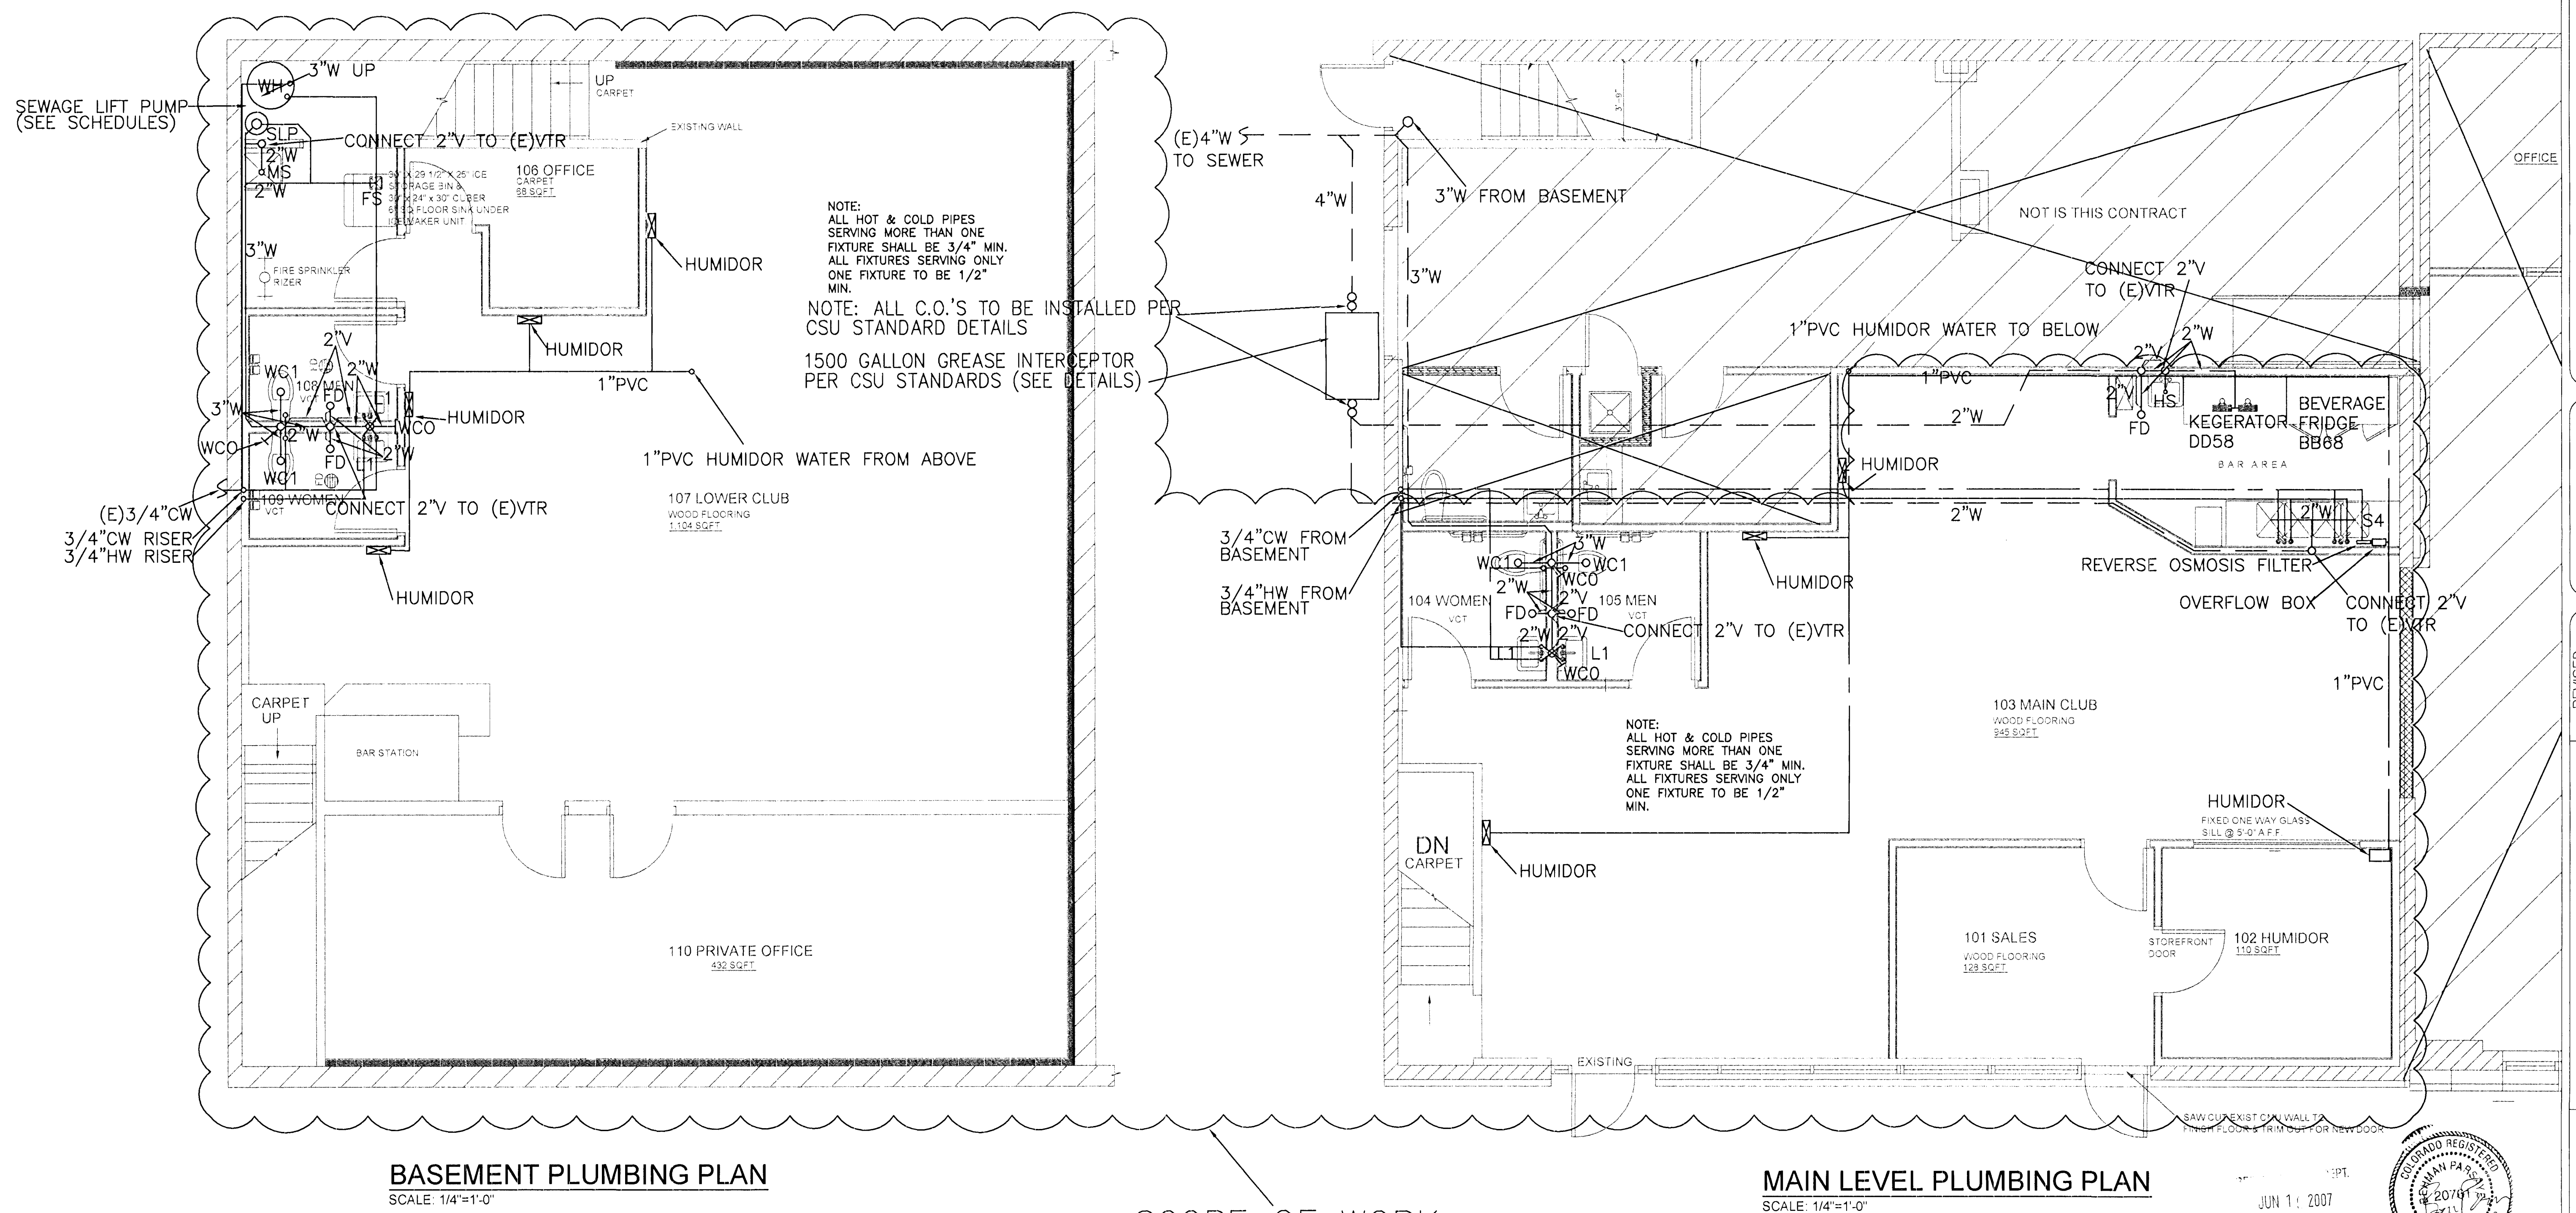

GENERAL NOTES

1. ALL WORK SHALL BE DONE IN COMPLIANCE WITH THE 03 IBC, 03 MECHANICAL (IMC), 2000 PLUMBING CODES (UPC), 2003 INTERNATIONAL ENERGY CONSERVATION CODE (IECC) AND ALL AMENDMENTS OF THE LOCAL REGIONAL BUILDING DEPARTMENT AGENCY.
2. ALL MECHANICAL EQUIPMENT SHALL BE LABELED AS TO THE AREA(S) SERVED.
3. THIS DRAWING IS DIAGRAMMATIC IN NATURE AND DOES NOT NECESSARILY SHOW EVERY REQUIRED OFFSET AND FITTING. FIELD COORDINATE EXACT PIPE & DUCT ROUTING WITH BUILDING ARCHITECTURE, STRUCTURE AND OTHER TRADES.
4. REFER TO ARCH DWGS FOR EXACT LOCATIONS OF PLUMBING FIXTURES.
5. PROVIDE CLEAN OUTS AT ALL SINKS, BOTH SIDES PER TABLE 7-6 OF 2000 UPC. PROVIDE CLEANOUTS ON ALL BRANCH DRAIN LINES THAT EXCEED 5'0" IN LENGTH (TYP).
6. ALL DROPS SERVING MORE THAN ONE FIXTURE SHALL BE 3/4" MINIMUM.
7. ALL PIPE SIZES, UNLESS OTHERWISE INDICATED SHALL BE:

COLD WATER	3/4"
HOT WATER	3/4"
VENT	2"
WASTE	4"
GAS	3/4"
8. ALL PIPING PENETRATIONS THROUGH RATED WALLS AND CEILINGS SHALL BE SEALED AROUND PIPE IN ACCORDANCE WITH 2003 IBC.
9. MAXIMUM HOT WATER OUTLET TEMPERATURE TO PUBLIC LAVATORIES TO BE 110°.
10. CLEARLY LABEL ALL PIPING REGARDING USE AND DIRECTION OF FLOW.
11. ALL TIE-INS TO EXISTING SYSTEMS SHALL BE COORDINATED WITH THE OWNER PRIOR TO THE START OF WORK. IN ADDITION, ANY INTERRUPTIONS TO SERVICES MUST BE SCHEDULED WITH THE OWNER.

KEY	DESCRIPTION	CONNECTIONS					
		TRAP	W	V	CW	T/HW	G
WH	30 GAL ELECTRIC WATER HEATER MAX HOT WATER TEMP. AT 110 DEG F.	--	--	--	3/4"	3/4"	--
FD	FLOOR JR. SMITH SERIES 2110 WITH NICKLE DRAIN & TRAP PRIMER	--	2"	2"	--	--	--
L1	WALL HUNG LAVATORY FAUCET (ADA)	2"	2"	2"	1/2"	1/2"	--
WC1	WATER CLOSET (ADA) OPEN FRONT SEAT	3"	3"	2"	1/2"	1/2"	--
SLP	ZOELLER (OR EQUAL) SEWAGE LIFT PUMP, 65 GPM	--	3"	--	--	--	--
S4	KITCHEN SINK STAINLESS STEEL 4 COMPARTMENT SINK, WITH DISPOSER, SINK GUARD	2"	2"	2"	1/2"	1/2"	--
HS	HAND SINK, WALL MOUNTED, TO BE PROVIDED BY OWNER	--	2"	--	1/2"	1/2"	--
FS	6"x6" FLOOR SINK /W GRATE TO BE PROVIDED BY OWNER	--	2"	--	--	--	--
GREASE INTERCEPTOR	1500 GALLON INTERCEPTOR	--	4"	2"	--	--	--
MS1	MOP SINK FAUCET W/ VACUUM BREAKER	2"	2"	2"	1/2"	1/2"	--

Diagram illustrating the components and connections for a Water Heater Schedule:

- CHECK VALVE
- 20 MESH STRAINER
- VACUUM BREAKER
- 12" HEAT TRAP, TYP. OF (2)
- 3/4" CW FROM EXIST. SERVICE - SEE PLAN
- EXPANSION TANK
- RELIEF VALVE
- DIELECTRIC UNION (TYP)
- PIPE FULL SIZE RELIEF TO FLOOR DRAIN TERMINATE PER CODE
- 3/4" GAS LINE
- 3/4" MANUAL GAS SHUTOFF VALVE
- DIELECTRIC UNION
- 6" DWT LEO
- PIPE DRAIN PAN TO FLOOR DRAIN
- FLOOR
- DRAIN PAN - 20 GAUGE GALV. STEEL
- TO 1

WATER FIXTURE CALCULATIONS				
FIXTURE	NUMBER OF FIXTURES		FIXTURE UNITS	TOTAL FIXTURE UNITS
WATER CLOSET (F.T.)	4	x	4	= 16
MOP SINK	1	x	3	= 3
F.D.	6	x	2	= 12
SINK	9	x	1	= 9
TOTAL, COLD WATER FIXTURE UNITS				40
DEMAND				40 GPM
MAX. DEVELOPED LENGTH				100'
SIZE: 3/4" METER				

PLUMBING LEGEND		
SYMBOL	ABBREV.	DESCRIPTION
	S OR W	SEWER/WASTE ABOVE GRADE
	S OR W	SEWER/WASTE BELOW GRADE OR FLR.
	S	EXISTING SEWER MAIN
	V	VENT
	C.W.	COLD WATER PIPE
	H.W.	HOT WATER PIPE
	H.W.R.	HOT WATER RETURN PIPE
	CD.	CONDENSATE DRAIN PIPE
	G	GAS
	P.O.C.	POINT OF CONNECTION
	G.V.	GATE VALVE
	D.S.	DOWNSPOUT
	RD	ROOF DRAIN
	PG.	PROPANE GAS PIPE
	WHA W/AP	WATER HAMMER/ARRESTOR W/ACCESS PANEL
	F.CO.	FLOOR CLEANOUT
	W.CO.	WALL CLEANOUT
	Y.CO.	YARD CLEANOUT
	A.P.	ACCESS PANEL
	DN.	DOWN
	ABV.	ABOVE
	BEL.	BELOW
	GRD.	GRADE
	FLR.	FLOOR
	AFG.	ABOVE FINISH GRADE
	F.CO.	FLOOR CLEANOUT
	W.CO.	WALL CLEANOUT
	G.CO.	GROUND CLEANOUT
	VTR.	VENT THROUGH ROOF

TO POWER SUPPLY
 DISCONNECT SWITCH
 VENT
 DUPLEX CONTROL PANEL
 UPPER GUIDE RAIL BRACKET
 HATCH ACCESS COVER
 LIFTING CABLE
 4" WASTE INLET PIPE
 WEIGHTED VARIABLE LEVEL FLOAT SWITCH
 4" WASTE
 INTERMEDIATE STABILIZER BRACKET
 RAIL PIPE
 4" WASTE
 SHUT OFF VALVE
 CHECK VALVE
 DISCHARGE PIPE MUST BE BELOW FROST LINE.
 4" WASTE
 NEMA 4X CONTROL PANEL
 CONDUIT SEAL
 18" MAX.
 ADDITIONAL CONDUIT SEAL WHEN REQ'D BY LOCAL CODES
 (6) HOCK CABLE/FLOAT BRACKET
 GUIDE RAILS 2" STD. GALV. PIPE
 ALARM LEVEL
 LAG LEVEL
 LEAD LEVEL
 OFF LEVEL
 RECOMMENDED FILLET - BOTTOM

TYPICAL RESTAURANT GREASE INTERCEPTOR

The drawing consists of two main parts: a side elevation on the left and a cross-section on the right. The side elevation shows two vent pipes, each labeled 'VENT 2" MINIMUM' and '42" MINIMUM'. A dimension line indicates a '10' MINIMUM FOR REMOTE LOCATION'. The cross-section shows the internal structure of the interceptor, including a '4" CONC. DRIVING SURFACE REQUIRED IN TRAFFIC AREAS', 'STANDARD 24" RING & COVER' at both ends, and '4" C.O. EXTENDED TO GL (TYP.)'. It also shows 'INTERIOR PLUMBING BY CONTRACTOR', 'VENT', 'WATER LEVEL', 'CLAMPS', 'TEE', 'CL', '12" x 4" CENTER ON WIDTH OF BAFFLE', and '4" OPENING WIDTH OF TRAP'. Slopes are indicated as '% SLOPE OUT' and '% SLOPE IN'. A 'SAMPLE TRAP/TEE' is shown on the left. A detailed inset at the top right shows the assembly of the 'STANDARD 24" RING & COVER', 'GRADE ADJUSTMENT RINGS SHALL NOT EXCEED 8"', and a '12" MANHOLE ADJUSTMENT RING REQUIRED FOR ALL PRECAST MANHOLES (TONGUE AND GROOVE SECTION APPROVED FOR 4", 6" AND 8" SECTION)'.

10' MINIMUM FOR REMOTE LOCATION

VENT 2" MINIMUM

42" MINIMUM

4" C.O.

STANDARD 24" RING & COVER

4" CONC. DRIVING SURFACE REQUIRED IN TRAFFIC AREAS

STANDARD 24" RING & COVER

4" C.O. EXTENDED TO GL (TYP.)

% SLOPE OUT

SAMPLE TRAP/TEE

CLAMP

TEE

CL

12"

VENT

INTERIOR PLUMBING BY CONTRACTOR

WATER LEVEL

CLAMPS

TEE

% SLOPE IN

4" OPENING WIDTH OF TRAP

12" x 4" CENTER ON WIDTH OF BAFFLE

24"

INLET ELEVATION TO BE NOT LESS THAN 1 PIPE DIAMETER HIGHER THAN OUTLET ELEVATION

NOTE: WHENEVER PRACTICAL, THE TWO VENTS SHALL BE RUN UNDERGROUND TO BUILDING AND UP THROUGH THE ROOF.

NOTE: IF TOP OF GREASE INTERCEPTOR IS MORE THAN 8" BELOW FINISHED GRADE A 4" DIAMETER MANHOLE BARREL SECTION(S) WILL BE REQUIRED TO BRING RING AND COVER TO GRADE.

STANDARD 24" RING & COVER

GRADE ADJUSTMENT RINGS SHALL NOT EXCEED 8"

12" MANHOLE ADJUSTMENT RING REQUIRED FOR ALL PRECAST MANHOLES (TONGUE AND GROOVE SECTION APPROVED FOR 4", 6" AND 8" SECTION)

NOTE: INTERIOR PIPING TO BE STRAPPED AT TOP & BOTTOM WITH GALVANIZED CLAMPS OR EQUAL

NOTE: SPECIFIC SIZE APPLICATION OF THE GREASE INTERCEPTOR TO BE DETERMINED BY COLORADO SPRINGS UTILITIES.

NOTE: TO BE READ IN CONJUNCTION WITH CSU CHAPTER 9 OF THE WASTEWATER SPECIFICATIONS.

(To be added to Service plans, ref: drawing C 5-1,2,3,4)

1. Wastewater services to be located in the center of the lot, or the center of the driveway for a flag lot. (per detail drawing C-5-1)
Note: Alternate service location, is only with the approval of Colorado Springs Utilities shown on drawing C-5-1.
2. Sanitary Sewer services to be installed a minimum of 7 feet into the property unless otherwise shown. Water service lines shall be installed to the property line i.e. curb stop box, see note 8 below.
3. All sewer services to be marked with a 2" x 4" x 12 foot wood post extending vertically from flow-line.
4. Water services to be marked with a 2" x 4" X 6 foot wood post extending 4 foot below finish grade.
5. Gas services to be installed at 3 feet above the water services unless otherwise shown, or as directed in the field, by the Colorado Springs Utility Inspector.
6. Final location of all sewer, water and gas services to be approved in the field by the Colorado Springs Utility Inspector.
7. Utility locations, whether or not shown on this plan, in any way releases the contractor from the responsibility of calling for and obtaining utility locations from the appropriate authorities prior to beginning excavation.
8. Contractor to install water service curb stop box at the Property Line of the street.
9. Water service specifies 30" minimum distance between water taps and 36" minimum from any given water joint, and expansion loops. For multiple services in a corridor maintain a minimum of 36" between service lines and service lines can not be crossed. (NOTE: Maintain 5' separation between fire line and service tap connections)
10. Sanitary Sewer service connections to be connected at a minimum of 5 feet from any manhole on the main line.

*Design & Development
Consultants @*
(719) 570-1456
1330 VALLEY STREET
COLORADO SPRINGS, CO 80915

THE COBALT CLUB

NOTICE:
THIS DRAWING CONTAINS MATERIAL AND INFORMATION WHICH MAY NOT BE REPRODUCED WITHOUT WRITTEN CONSENT OF T-BOONE CONSTRUCTION, INC. THESE DRAWINGS ARE INTENDED TO BE USED ONLY BY T-BOONE CONSTRUCTION AND ITS REPRESENTATIVES. ANY OTHER PURPOSE THAN TO INDICATE THE GENERAL PLACEMENT AND FEATURES OF THE INDICATED PROJECT T-BOONE CONSTRUCTION, INC.

THE COBALT CLUB	REVISED	3/19/07
BASEMENT PLAN		3/23/07 E.M.
		5/30/07 E.M.
		6/07/07 BP
124 "E" COSTILLA STREET		
DRAWN BY: MS	CHK BY: BP	DATE: 6/7/07

P2

6-14-07



COMcheck Software Version 3.3.1

Lighting Application Worksheet

2003 IECC

Report Date:

Data filename: G:\Cobalt club\Light-Calc.cck

Section 1: Allowed Lighting Power Calculation

A	B	C	D
	Floor Area	Allowed Watts / ft ²	Allowed Watts
Retail Sales, Wholesale Showroom	3235	1.5	4852
Total Allowed Watts =			4852

Section 2: Actual Lighting Power Calculation

A	B	C	D	E
Fixture ID : Description / Lamp / Wattage Per Lamp / Ballast	Lamp/ Fixture	# of Fixtures	Fixture Watt.	(C X D)
Linear Fluorescent 1: B: 48" T8 32W / Electronic	2	5	64	320
HID 1: C: Metal Halide 50W / Electronic	1	31	45	1395
HID 2: F: Metal Halide 50W / Electronic	1	46	45	2070
HID 3: G: Metal Halide 50W / Electronic	3	1	35	35
HID 4: H: Metal Halide 50W / Electronic	3	3	46	138
Total Actual Watts =				3958

Section 3: Compliance Calculation

If the Total Allowed Watts minus the Total Actual Watts is greater than or equal to zero, the building complies.

Total Allowed Watts = 4852
Total Actual Watts = 3958
Project Compliance = 894

Printed: PASSSES

REGIONAL BLDG. DEPT
APR 11 2007
APPROVED BY SLE

Lighting intended for 24 hour use.

- ☐ 10. Tandem wired one-lamp and three-lamp ballasted luminaires (No single-lamp ballasts).

Exceptions:

Electronic high-frequency ballasts; Luminaires on emergency circuits or with no available pair.

Section 4: Compliance Statement

Compliance Statement: The proposed lighting design represented in this document is consistent with the building plans, specifications and other calculations submitted with this permit application. The proposed lighting system has been designed to meet the 2003 IECC, Chapter 8, requirements in COMcheck Version 3.3.1 and to comply with the mandatory requirements in the Requirements Checklist.

Name - Title

Signature

Date

REGIONAL BLDG. DEPT
APR 11 2007
APPROVED BY SLE



T-BONE CONSTRUCTION, INC.
1330 Valley Street
Colorado Springs, CO 80915
(719) 570-1456 Fax (719) 591-5217

Brett Veltman

April 27, 2007

Paul Tice II, AICP
Land Use Review Manager
Planning and Community Development Department
City of Colorado Springs

Re: 124 E. Costilla St. (formerly known as 122 E. Costilla St.)


Paul,

Thank you for your response to my inquiry regarding parking requirements for 124 E. Costilla Street. Since receiving your note, I have been able to identify information that supports the property's restaurant history and, coupled with the calculations of the space included within the proposed private club, believe that we are entitled to approval as a continued restaurant use. Specifically, and in agreement with the two tests defined in your note:

1. The Cigar Bar ("private club") will occupy the same, or less, space (based on gross floor area) as the prior restaurant use. If this is the case the new use will require equal or less parking than the prior approved use and therefore not trigger parking compliance. The proposed private club utilizes approximately 3900 square feet of the building that has housed these restaurant operations: The Chicken Express, Six Flags International Cuisine, and Yen Ching, all of which were located at 122 E. Costilla Street and encompassed the entire building (approximately 5000 square feet... The Enumerations office at RBD assigned the current address, 124 E. Costilla St., upon our application for a building permit earlier this month.
2. The prior restaurant use was an **approved use**, i.e., received a building permit and/or CO to occupy the space. A Certificate of Occupancy (#2101) was issued for a restaurant use (Permit #28448) on April 25, 1972. Subsequent permits through 1987 provided continued upgrades to those uses. The last recorded use in the building, the Yen Ching restaurant, ceased operations in 1994 shortly after the current owner purchased the property. The property, as is verified by listings within the Polk Registry (attached), has remained vacant since that time.

As stated to you in my note of 4/24/07, all necessary approvals from RBD have been acquired for the construction of the Cobalt Club, except that of Zoning (Development Review Enterprise). We would appreciate an immediate review and approval of the building plans by the appropriate Colorado Springs planning agency so that the project may move forward.

Thank you for your direction in this matter. It is our belief that the proposed use is harmonious with existing zoning regulations and that the project should be approved as submitted.

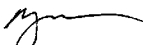
Michael Jones

7482 Merilee James F. & Carolyn M. [E]

+ MIRABEL LN ENDS 719-535-4620

7474 O Copeland Brandon M. [E]

Forbes Eric R. [E] 719-535-7844

Forbes Joshua J. [E] 719-535-7844

96 Reed Eric R. [E]

Williams Robert D. & Sandra L. [E]

HOUSEHOLDS 23

CORTE AMMO (FOUNTAIN)-FROM 1969

FOUNTAIN MESA [E]

+ZP CODE 80017 CAR-RT 0003

490 Pflanz Kathy A. [E]

490 Pflanz Eric R. & Jessica M. [E]

606 Carter Terry D. & Patricia L. [E]

510 Kurbach James D. & Patricia L. [E]

520 Payton George E. Jr. [E]

TIMBERLINE-ARCHERY sporting

529 Holmes Bruce P. [E]

538 Manzanares Eppie J. & Sue A. [E]

540 DeKey Timothy J. [E]

550 Reyes Roberto A. Sr. & Inez D. [E]

550 Verkey Laura L. [E]

560 Martin William C. [E]

570 Hughes Ray A. [E]

570 Bowers Gary A. [E]

570 Hughes Jennifer [E]

580 McNeely Lewis R. [E]

580 Meyer Todd A. [E]

590 Hyman Bradley A. [E]

599 Dahn Richard E. & Jennifer L. [E]

HOUSEHOLDS 18

CORTE HERMOSA (FOUNTAIN)

+ZP CODE 80017 CAR-RT 0003

500 Calvey Walter A. [E]

500 Calvey Walter A. [E]

508 Norie Ingrid F. [E]

515 Urbany Stephen J. Jr. [E]

515 Urbany Stephen J. Jr. [E]

+ZP CODE 80017 CAR-RT 0003

2108 Baxter Sherrie A. & David M. [E]

2109 Myers Darrel J. [E]

2109 Myers Darrel J. [E]

3025 Haymond Roger A. & Renee L. [E]

3030 Boon Charles D. & Kelly L. [E]

3045 Muse Kevin [E]

3050 Zimmerman Joshua J. & Abigail K. [E]

3055 Glanville Maury J. & Shirley A. [E]

3060 Martinez Jesus [E]

3065 Hodge Kenneth C. & Catherine L. [E]

3065 McLean Warren E. & Lucille J. [E]

3065 McLean Warren E. & Lucille J. [E]

Marvin Wu 719-382-6336
 Murray Sotile A & Myong H [E] 719-382-3925
 Markus Steven D [E] 719-382-4638
 Jero Ernesto A & Karen L [E] 719-382-4638
 Acropolis Lewis R [E] 719-382-4638
 Yancy Bradley A [E] 719-382-4638
 No Current Listing
 ESSES 1 HOUSEHOLDS 20

E HERMOSA (FOUNTAIN)
 CODE 8017 CAR-RT 0009
 Callaway Walter A [E] 719-382-8073
 Callaway Heather F 719-382-8073
 Doris Ingold F [E] 719-382-8815
 Jrbany Stephen J Jr [E] 719-382-0474
 Jhany Pally J 719-382-0474
 No Current Listing
 Thomas Howard E & Ann E [E] 719-382-4155
 Burge Ronald L [E] 719-382-7330
 No Current Listing
 Jarfield David L [E] 719-382-5444
 Jarfield Joseph V 719-382-5444
 Janner Louis J & Solie R [E] 719-382-5444
 Jc Michael L [E] 719-382-5444
 MTAIN MESA RD ENDS
 Javro Franks G [E] 719-382-8451
 MTAIN MESA RD INTERSECTS
 B Henry Claress J 719-382-7501
 No Current Listing
 HOUSEHOLDS 12

T SOL FOUNTAIN FROM 2129
 ITAIN MESA RD
 CODE 8017 CAR-RT 0003
 Fowler Gilbert K [E] 719-382-7028
 Fowler Jaye T & Sheila J [E] 719-382-7501
 No Current Listing
 Jrisol Wayne J & Susan K [E] 719-382-5327
 Jrisol Dale E [E] 719-382-5327
 Jrisol Sheri [E] 719-382-5327
 Thompson Melvin W & Sieglinda R [E] 719-382-7431
 N C LAMING carpet & rug
 cleaners 719-382-8800
 Phillips Fred M Jr & Margie L [E] 719-382-7366
 Snyder Junior L [E] 719-382-8013
 Deborja Samantha I [E] 719-382-0387
 Sockley Matthew J & Laurie J [E] 719-382-5301
 Taylor David L & Shirley A [E] 719-382-5301
 Taylor Thomas A [E] 719-382-7723
 Brown Carolyn J [E] 719-382-7723
 ESSES 1 HOUSEHOLDS 13

ITZ DR (COLORADO SPRINGS)-FROM
 CLIMAYO DR NORTHWEST
 CLIMAY AVE CONTINUES
 INTER DR CONTINUES
 CODE 8011 CAR-RT 0003
 Bacon Sherrie A & David M [E] 719-382-1982
 INTER DR REGNS
 WAYO DR INTERSECTS
 Myers David J [E] 719-487-3759
 Martinez Victor D & Freddie P [E] 719-382-7723
 Juvere Josue & Beverly J [E] 719-382-6649
 Martinez Angela A [E] 719-382-0296
 Anderson Tereza L [E] 719-382-0296
 Windle James E [E] 719-382-8539
 Windle Robert L [E] 719-382-8539
 Adams Loyola P [E] 719-382-7366
 Aduller Sanjanta 719-382-0476
 Benavidez Armando 719-382-0476
 Henrich Timothy A [E] 719-382-0476
 Wright Craig T 719-382-0476
 Gomez Jennifer R 719-382-0476
 Gomez Noe 719-382-0476
 Polk Kristie Christ P [E] 719-382-0476
 Omeron John A & Stephanie G [E] 719-382-0476
 Tomsha Christopher L [E] 719-382-0476
 Swan Anthony J & Marilyn [E] 719-382-0476
 ESSES 1 HOUSEHOLDS 13

Salomo Anya R 719-382-6336
 Saroni Terra 719-382-6336
 2234 No Current Listing
 2237 Henderson John R [E] 719-382-6336
 2238 Huff Dorothy A [E] 719-382-6336
 Matney James G [E] 719-382-6336
 2242 Hall James S & Ethel [E] 719-382-6336
 2246 [E] 719-382-6336
 + CORTEJA ALUMINUM 719-382-6336
 + FRONTIER DR ENDS 719-382-6336
 HOUSEHOLDS 29

CORTINA CR (COLORADO SPRINGS)-FROM
 5966 FLINTDRIDGE DR
 + CORTINA DR CONTINUES
 + ZIP CODE 80118 CAR-RT 0024
 3403 Thorpe James R & Earline A [E] 719-596-1290
 3413 Schubert Warren R Sr & Justine [E] 719-596-5800
 3423 Block James W & Joyce R [E] 719-596-9276
 3433 Houck Joseph E [E] 719-596-0108
 3436 Workman Ralph T & Connie L [E] 719-596-1906
 3443 No Current Listing
 3453 Stewart Joyce B & John T [E] 719-596-5872
 3456 Nelson Gregory J & Martha L [E] 719-596-5872
 3463 Wakeford Jeffrey D & Mary J [E] 719-596-4372
 3470 Warner Thomas M [E] 719-596-4372
 3473 Francis Henry L [E] 719-596-4372
 3476 Romboe Dennis L & Jan [E] 719-596-4372
 3483 Woods Robert L Jr & Ellen L [E] 719-596-4372
 3486 Ireland Charles E & Judith E [E] 719-596-8663
 3493 Chaffee John T & Rosita I [E] 719-596-4372
 3496 Garcia Juan G & Sara S [E] 719-596-4372
 HOUSEHOLDS 16

CORTINA DR (COLORADO SPRINGS)-FROM
 3154 CORTINA PL NORTHWEST
 + DEL RET DR CONTINUES
 + ZIP CODE 80118 CAR-RT 0024
 2910 Varavensavay Kenneth J [E] 719-277-0827
 2915 Patel Richard H & Gretchen V [E] 719-277-0827
 2930 O'Neill Pamela [E] 719-596-4916
 2935 Zander Tammy K [E] 719-596-4916
 2940 No Current Listing
 2945 Gaertan Rebecca L & Wayne R [E] 719-596-4916
 2950 Simoncelli John Jr [E] 719-596-4916
 2955 Huddleston John M & Jeannine R [E] 719-596-4916
 2960 Vizzini Douglas W & Kelly L [E] 719-596-4916
 2965 Connolly Michael J & Shirley D [E] 719-596-4916
 2975 No Current Listing
 2980 Leonard Merrill L & Geneva L [E] 719-596-4916
 3010 Tustin Warren S & Carol J [E] 719-596-1213
 3015 Pemberton Susan B [E] 719-596-1213
 3025 Raymond Roger A & Renee J [E] 719-596-1213
 3030 Beyer Charles D & Kathy [E] 719-596-8141
 3045 Vaughn Christopher [E] 719-596-8141
 3050 Zimmerman Joshua J & Nancy E [E] 719-596-8141
 3055 Glenn Michael J & Shirley D [E] 719-596-8141
 3060 Martinez Jesus [E] 719-596-8141
 3065 Sutton Kenneth C & Catherine L [E] 719-596-8141
 3075 Connolly Michael J & Shirley D [E] 719-596-8141
 3085 Martin Warren E & Lucille J [E] 719-596-8141
 3095 Martinez Victor D & Freddie P [E] 719-596-8141
 + DEL PAZ DR INTERSECTS
 + DEL PAZ DR CONTINUES
 3103 Scott Jeffrey R & Julie K [E] 719-596-8141
 3110 No Current Listing
 3125 Chestnut Dennis G [E] 719-596-8141
 3130 Brooks Lonnie E & Sherri M [E] 719-596-8141
 3135 Squigley Drew K & Vicki J [E] 719-596-8141
 + CORTINA PL ENDS
 3145 Campbell William C Jr & Mary B [E] 719-596-8141
 3154 Larson Phyllis E [E] 719-596-8141
 3165 No Current Listing
 3180 McKenzle Dennis P & Joan M [E] 719-596-8141
 3185 [E] 719-596-8141
 3190 [E] 719-596-8141
 3170 Taylor Richard C & Norma L [E] 719-596-8141
 HOUSEHOLDS 16

2210 Parent Richard D [E] 719-265-0301
 Parent Vincent M 719-265-0301
 3215 Dixon Roosevelt & Sara J [E] 719-548-8169
 3220 [E] 719-548-8169
 3225 Casati Stephen J [E] 719-548-8169
 3230 Vancura Charles E [E] 719-548-8169
 Vancura James B 719-548-8169
 3235 Skjerly Bradley W & Jean M [E] 719-548-8169
 3245 Brock Gary L & Jan A [E] 719-548-8169
 3250 [E] 719-548-8169
 3255 Wright Wendy E [E] 719-548-8169
 3255 Atchison Robert E [E] 719-548-8169
 Vogt Judith K [E] 719-548-8169
 3265 Goodie Steven M & Kristan L [E] 719-548-8169
 3270 Normie Rochelle N [E] 719-548-8169
 3275 McCo Corine J [E] 719-548-8169
 3285 [E] 719-548-8169
 3285 [E] 719-548-8169
 3290 Belford Carol L & J [E] 719-548-8169
 3295 No Current Listing
 3305 Ruston Robert H Jr & Carolyn G [E] 719-548-8169
 3310 Lewis Elwood J & Pamela P [E] 719-548-8169
 3320 Moore John J Jr [E] 719-548-8169
 3325 Battadillo Julie P [E] 719-548-8169
 Buchanan Steven S & Dan L [E] 719-548-8169
 3330 Kanzer Daniel D & Georgia C [E] 719-548-8169
 3340 Bigbee Bernice W Jr & Julie M [E] 719-548-8169
 3350 Campbell Timothy D & Mary J [E] 719-548-8169
 + GALENA DR INTERSECTS
 3360 [E] 719-548-8169
 Hudson Loraine R [E] 719-548-8169
 Dent Donald W & Margaret [E] 719-548-8169
 Oodham Michael R [E] 719-548-8169
 3390 No Current Listing
 + CORTINA CR INTERSECTS
 3410 Taylor Jack S Jr & Holly S [E] 719-548-8169
 3415 Horton Penelope S & William F [E] 719-548-8169
 3425 Lewis Max E & Carolyn A [E] 719-548-8169
 3430 Hall Mark L & Rita A [E] 719-548-8169
 3435 Asplinger Rebecca K Sr & Annabelle M [E] 719-548-8169
 3440 Cooke Nancy J [E] 719-548-8169
 3445 Bingham Dannie R & Lyssa S [E] 719-548-8169
 3450 Kikowski George P & Pearl A [E] 719-548-8169
 3460 Matthews Kerry R & Barbara J [E] 719-548-8169
 3465 [E] 719-548-8169
 3470 Hale William E & Karen L [E] 719-548-8169
 + FLINTDRIDGE DR INTERSECTS
 HOUSEHOLDS 78

CORTINA PL (COLORADO SPRINGS)-FROM
 3154 CORTINA DR NORTHWEST
 + ZIP CODE 80118 CAR-RT 0024
 3134 Black John J & Andrea G [E] 719-596-4874
 3135 [E] 719-596-4874
 3140 [E] 719-596-4874
 3145 [E] 719-596-4874
• ZIP CODE 80011 LAUREL PARK
5250 Weber Robert F Jr & Michelle L [H]
5250 Rivers Lionel R [H]
719-590-9889
Rivers Jose R Jr [H] 719-590-9889
5255 Hoover Susan R [H]
5265 Friens John R [H]
5270 Sanchez Teddy S Sr & Alberta C [H]
5275 Kendrick Jimmy W & Mary J [H]
• EVENING LIGHT CH INTERESTS

HOUSEHOLDS 6

COTTEMAN DR (COLORADO SPRINGS)-FROM
649 BRUNING CT EAST
• ZIP CODE 80911 CAR-RT C016
1115 Ford Robert J. & Brando D [H]
1125 Stables Jack & J & Deanna K [H]
1130 Rogers Mark [H]
1145 Stasits Andrew J. & Melissa A [H]
1155 Place William T. Jr & Donna J [H]
719-392-5857
• EVENING LIGHT CH INTERESTS

HOUSEHOLDS 5

E COSTILLA ST (COLORADO SPRINGS)
• ZIP CODE 80903 CAR-RT C023
101 COIDGE PATRICIA ALTECH
719-578-9912
• ZIP CODE 80903 CAR-RT C023
110 KINGS SCHEP restaurants
719-534-9135
1101 DORY DESIGN DECORATING
719-630-3981
113 Geisick Roy E [H]
119 CHEETAH PRINTING printers
719-473-7800

125 PATRICIA MAE GLOLO LANE
• OFFICE attorneys 719-575-9757
211 ASSISTANCE LEAGUE BARGAIN
BOX thrift shops 719-475-1029
220 • Maersk Mark
227 SOCIAL SECURITY DISABILITY
attorneys 719-620-5385
315 GAY & LESBIAN FUND FOR CO
foundation 719-473-4455
320 CLIFTON L BLACK ATTY AT LAW
attorneys 719-550-4529
LAW OFFICES attorneys
719-471-0300

330 CHAR'S SHIPPING SHOPPING
shipping agents 719-578-8654
5 • Decroy Kath
5 • Mayfield Jason R
• ZIP CODE 80903 CAR-RT C024
437 CROCKER MOTORCYCLE CO
motorcycles & motor accessories
719-577-0003
444 CONTINENTAL MATERIALS
nonclassified establishments
719-667-2020
DANIELS SAND CO sand & gravel
719-475-0700
TRANSIT MIX concrete ready mixed
719-533-0022
TRANSIT MIX CONCRETE CO
ready mixed concrete 719-475-0999
TRANSIT MIX DOOR DIV door
closers & checks 719-475-0100

520 BLADENWICKERS SAWCUTTING
CORING concrete 719-475-7873
EVEN PREISSER INC genl
contractors 719-424-2814
548 COLORADO SPRINGS WHOL
FLORIST florists 719-632-4874
705 • Lamb Charmaine
711 Gardner Tim & Beth [H]
719-634-5494
• Wallace Abby V [H]
• Padilla-Avila Felipe 719-520-1376
• Padilla Selvin A [H] 719-475-0341
• Padilla Avila F [H] 719-475-0341
B No Current Listing
719 Carey Alexander L [H]
A - B No Current Listing (2 Apts)
720 Young Sandra J [H] 719-328-1875
724 Copeland Patricia G [H]

728 Cook Carolyn [H]
• Günther Paul 719-227-0207
729 Longfellow Robert 719-390-6825
Longfellow Robert S 719-390-6825
S & L ROOFING INC roofing
contractors 719-390-6825
730 No Current Listing
733 MANAGEMENT SPECIALTIES INC
mngt serv 719-471-7417

748 • Rouse Charles 719-633-4038
752 • Wallace Brian L [H]
801 Landy Peter T [H] 719-635-1649
Landy Debra S [H] 719-635-1649
802 Rouse Vernon C & Edith [H]
• 807 • Dixon Shanon [H] 719-630-1111
809 Collins David M [H]
812 Stay Shirley L [H] 719-477-0326
Stay David S [H] 719-477-0326
813 Vanderkoof Dine E [H] 719-578-0591
Vanderkoof Berandine E [H] 719-578-0591

815 No Current Listing
816 Dekon Maria E [H]
• Dekon Samel
817 Myers James E [H]
Myers Hedwig [H]
820 Griffin Paul A [H] 719-633-0346
Griffin Randal L [H] 719-633-0346
823 102 No Current Listing
824 Wedor Liane [H] 719-522-1748
• Whittlock Garry [H]
826 Vandeyk Roberta P [H]
827 Rossignol Anthony J & Eileen E [H]
830 No Current Listing
831 Hankley Lonnie E & Joy L [H]
832 Walker Christine [H] 719-632-1251
834 Peltica Elva K [H] 719-632-5748
Peltica Adolfo [H] 719-632-5748
835 No Current Listing
839 McClure Andrew [H] 719-627-8792
A - B No Current Listing (2 Apts)
840 Hilliard Lee F [H]
841 Thompson Mary R [H]

847 Victor Dorothy J [H] 719-227-0897
• Victor Kenneth [H]
852 Phillips Kimberlee H [H]
719-630-0756
905 Maxwell Frederick R Sr & Delores M [H]
909 • Wedor Liane [H] 719-522-1748
912 Vanner Ob G & Edith [H]
719-633-8885
914 No Current Listing
915 Verboon Linda [H]
916 No Current Listing
920 Horton Stanley D & Sandra [H]
719-632-5191

921 Valenti Catherine R & Casey M [H]
924 Culbertson Leola J [H] 719-633-2815
928 Koscielski Janet K [H]
Koscielski Carl [H]
• Wackel Janet [H] 719-475-7733
927 Martinez Rosa C [H] 719-634-0212
931 Hassler Michelle R [H]
932 Barry Matthew R [H] 719-633-5866
933 Salazar Jose S [H] 719-634-5038
Salazar Louella L [H] 719-634-5038
934 • Laszar Paul [H] 719-633-4088
Spradling Florence V [H]
935 Weaver Chysanne L [H]
937 Donaldson Michael R & Kent L [H]
938 Wadell Clifford D & Theresa M [H]

941 Serotini Mary J [H] 719-633-0965
942 Fairbanks Craig R [H]
945 Weiss John [H] 719-522-2801
946 • Garcia Ray A [H]
947 Pritchard Carmen R & Tabitha [H]
719-567-0695
950 • Jopery Pamela [H]
1002 Chambers Carl S [H]
1008 Greenberg Peter [H]
1010 Gonzalez Terecia F [H]
719-575-5470
1012 Silvestre Francisco V Jr [H]
1014 • Toral Steve [H] 719-447-5798
1016 • Arias Danielle [H] 719-634-8600
1017 No Current Listing
1019 Davis Barbara J [H]
Davis Cordell K [H]
1020 Maravon Natcha M [H]
8090 Bolek Steve J [H]
1023 McCormick Donald E [H]
1024 Rush Benjamin J [H]

1025 Jones Wilma D [H] 719-447-8927
1028 - 1033 No Current Listing (2 Hs)
1034 Gutierrez Louise M [H]
BUSINESS 251 HOUSEHOLDS 100

719-633-6723
• BAHWATH ST INTERESTS
101 COLORADO SPRINGS BUILDING
DEPT government offices
719-327-2881
COLORADO SPRINGS
INSPECTIONS government offices
719-327-2880
EL CAMINO ST COUNTY BUILDING
PERMIT government offices-county
719-327-2880
108 COLORADO SPRINGS
ENGINEERING government offices
719-385-5977
212 COLORADO SPRINGS
PLANNING DEPT government offices
719-385-5982

• SIERMA MADE ST INTERESTS
• CMC ST INTERESTS
• 87TH ST CONTINUES
• ZIP CODE 80905 CAR-RT C009
830 ANTLERS AUTO ELECTRIC auto
electric serv 719-473-0579
870 A TRANSMISSION PARTS CO
transmissions-auto 719-442-0564
• 97TH ST INTERESTS
910 PEDESTAL CO genl contractors
719-578-8833
• 107TH ST INTERESTS
1019 Littleton Travel B [H]
719-471-1288
Littleton William E [H] 719-471-1288
• 117TH ST INTERESTS
121013 Wilson G & Joan E [H]
719-575-0911
1218 Robinson Anne [H]
1222 Stratton Dale R & Rosemary M [H]
• CHEVROET ST INTERESTS
1304 Mullin James J [H]
Mullin Gloria J [H]
1310 Silsberry Dan D [H]
719-475-2731

1314 Flag Charters [H]
Flag Robert W [H]
• MODOC ST INTERESTS
• ZIP CODE 80904 CAR-RT C019
1402 • Bassett Alan [H] 719-448-9213
1403 • Lamoreau Scott [H] 719-448-9213
1442 • Lovelace Pamela S 719-473-8533
Lovelace Kenneth P [H] 719-473-8533
• Vonquallen Kenneth H
Vonquallen Virginia M [H]
1443 • Lutz Fred W [H]
1458 • Smith James [H] 719-687-0487
1459 Edington Royce T [H] 719-473-5345
Edington Trisha K [H] 719-473-5345
1467 • Abernombie Mardee
719-633-5545
1468 • Abernombie Mardee
719-633-5545
1482 • Schinktel Peggy [H] 719-328-0221
1483 • Lowe Dana [H] 719-471-0174
Lowe Chris [H] 719-471-0174
1491 Wilting Stanley Jr [H]

1496 • Mackenzie Brian L
1499 Hughes James R & Lisa K [H]
1523 • Lampe John C & Christine
1530 • Wilson David & Amber
719-578-7863
1531 • Young Rosalinda [H] 719-634-6738
1538 • Schilling Glenn P & Joy W [H]
1546 • Gunter Kerry L [H] 719-475-7657
1547 Moore Barry J [H]
1548 • Johnson Brock [H] 719-475-7657
1554 • Choi Kang [H] 719-578-5947
1563 • Lin Yuchan
Lin Jian T [H]
1570 Reid Scott T [H] 719-635-8614
1571 Key Traphay S [H] 719-578-9679
Key Kelly [H] 719-578-9679
1579 • Trahey Stefania A [H]
Trahey Stephen E [H]
1587 Vannomson Scott [H]
1595 • Rose Donald [H]
1605 • Jackson Randall W & Teresa C [H]
1603 • Auburg John [H] 719-635-3223
1611 Greenwood Brad R & Summer J [H]
1612 • Barrett David [H] 719-632-0936
1619 • Vasterling Lawrence R & Jane W [H]
BUSINESS 251 HOUSEHOLDS 39

719-282-8278
COTTAGE DR (COLORADO SPRINGS)-FROM
8901 BELLOVE CR EAST
• ZIP CODE 80926 CAR-RT R033
3705 Yee Dave D & Carol C [H]
719-282-8278

3745 Zhong Hang [H]
3749 Debelski Dayne R & Yvette G [H]
719-282-3290
3755 No Current Listing
3760 Mast Isaac C & Elizabeth G [H]
719-282-1082
3785 Gaston James F & Kimberly A [H]
719-282-1156
3770 Matysavsky Stephen L & Mary C [H]
719-282-9061
3775 Kincaid William C & Cathy C [H]
719-282-0992
3779 Cassano William G Jr [H] 719-282-0114
3790 Pabich Paul J & Karen S [H]
719-282-0144
3785 Long James W & Mary R [H]
3789 Staley Anita S [H] 719-282-0967
3790 Walters Gary C & Corazon L [H]
719-282-0351
3795 Aldred Robert W & Jeanne M [H]
719-282-1729
• CHARTER ST INTERESTS
3801 SHADOW MOUNTAIN BAPTIST
CHURCH churches 719-281-1817
3802 Wiggins Donald A & Linda H [H]
3809 - 3810 No Current Listing (2 Hs)
3814 Turek David A & Shawnee L [H]
719-282-3324
3817 Lutz Scott H & Connie S [H]
3818 Kahler Eric & Jane [H] 719-282-0547
719-282-7888
3820 Thomas Ronald L & Tina E [H]
3825 • Clawson Anne [H] 719-282-0780
Tate Frank & Karla [H]
3830 Schumaker Patrick J & Tracy A [H]
719-281-5822
3833 Pahlstetter Joseph L & Kimberly J [H]
719-282-1931
3840 • Cavallero Laura A [H] 719-282-3010
Cavallero Thomas J [H] 719-282-3031
3841 Dürhm James R & Ok S [H]
3846 Stanek Mark E & Jane [H] 719-282-9681
3848 • Dürhm James R & Ok S [H]
3849 Hannan Daniel D & Monika R [H]
719-282-3565
3857 Bryant Samuel R & David J [H] 719-282-3528
• QUAIL GLEN ST INTERESTS
3901 Moudis Robert T & Junita L [H]
719-282-3183
3902 Gedding Aaron [H] 719-282-0349
3906 Grabenk Michael R & Deborah A [H]
719-282-1645
ROCKRIMMON CHURCH churches
719-282-9113
3909 Willis Johnnie H Jr & Gail E [H]
719-282-9183

• ALPINE VALLEY DR INTERESTS
3920 Fuller James M & Pamela L [H]
719-282-9445
• BELLOVE CR INTERESTS
• BELLOVE CR INTERESTS
• RAINWOOD DR INTERESTS
• RAINWOOD DR INTERESTS
BUSINESS 23 HOUSEHOLDS 41

COTTAGE GROVE CT (COLORADO SPRINGS)-FROM
7233 WOODY CREEK DR
• ZIP CODE 80911 CAR-RT R021
7240 Steiner Scott V & Roxanne H [H]
719-392-6840
7440 • Faraci Carla J [H] 719-390-7886
Faraci Yvette A [H] 719-390-7898
7445 Panchetti Charles D & Teresa E [H]
7446 Greer Edward J & Donna R [H]
719-392-2437
7465 Baupre Gerald M & Tamara D [H]
7466 Baupre Gerald M & Tamara D [H]
7480 Roettger William E & Fennee M [H]
719-392-5237
7485 • Williams Jayson B 719-392-2947
7485 Colby Mark W & Moris S [H]
719-392-8595
HOUSEHOLDS 10

719-282-3792
8840 Beene John M II & Pat [H]
8845 Strickland Stuart C [H]
8850 Weber Bruce R & Carol [H]
8855 McWain Walter S & S [H]
8860 McWain Walter S & S [H]
8865 Earl Shawn [H]
8870 Grigsby John F [H]
Grigsby Prissy A [H]
8901 Parker James W [H]
8910 Ortega Larry T [H]
Ortega Jeanette [H]
8915 Matlock Scott R [H]
8920 • Crawford John [H]
8930 No Current Listing
• BARRMORE DR INTERESTS
8940 Cox Donald R [H]
8945 • Crawford John [H]
8950 Pelton Christopher [H]
8955 Burtch Raymond [H]
8960 Kiebing Herbert [H]
8970 Holcomb Richard [H]
8975 Kong Joseph S [H]
8980 Tompkins Camille [H]
8990 No Current Listing
9010 McWain Walter S [H]
9015 Scatena Richard [H]
9020 Hill Deborah C [H]
9025 Butler James [H]
9030 Reeves Patricia [H]
9035 Salinas Gregory [H]
9040 Parsons David [H]
9045 Nang Catherine [H]
9050 Harry Gordon [H]
9055 Tarnow David [H]
9060 Taylor Peter W [H]
9065 Rios Robert [H]
9070 Kibouma Thomas [H]
9075 Fritz Brenda L [H]
9080 Neukem David [H]
9085 Bellis Addam P [H]
9090 Wasserman [H]
9095 McNeil Narciso [H]
9115 Hodge David B [H]
9120 Coughlin [H]
9130 Mayfield Peter [H]
9135 Abudrigo [H]
9140 Black Robert [H]
9150 • Watts Mon [H]
9160 Garza Juan [H]
9165 • Garza Juan [H]
9170 Whelan Gary [H]
9175 George Robert [H]
9180 Barr Joseph [H]
9185 Montgomery [H]
9190 Bryant Kenneth [H]
Bryant Carol [H]
9210 Keshler Lou [H]
9220 • Sany Sam [H]
9225 Ching Alexander [H]
9230 Jarral Lewis O [H]

9235 • Sany Sam [H]
9240 • Sany Sam [H]
9235 • Sany Sam [H]
9240 • Sany Sam [H]
9245 • Sany Sam [H]
9235 • Sany Sam [H]
9240 • Sany Sam [H]
9245 • Sany Sam [H]
9640 • S

No. 122 Street E. Costilla Street

Housekeeping Units _____

Lot W1/2 of 5

Rooms _____ Baths _____ Kitchen _____

Block 122 Addition Costilla St. Add'n.

Rooms _____ Baths _____ Kitchen _____

Zoning _____ Type of Use Restaurant (fin. only)

Rooms _____ Baths _____ Kitchen _____

Type of construction concrete

Rooms _____ Baths _____ Kitchen _____

Permit No. 27508 Date 11-10-71Plan No. 9892 Cost \$3,000.00

Mike Demetry/K. Palmer

Floor Area and Load

Bas. _____ sq. ft. _____ lbs. 4th _____ sq. ft. _____ lbs.

1st _____ sq. ft. _____ " 5th _____ sq. ft. _____ "

2nd _____ sq. ft. _____ " 6th _____ sq. ft. _____ "

3rd _____ sq. ft. _____ " Total _____ sq. ft.

DATE	PERMIT NUMBER	PLAN NUMBER	COUNCIL OR BOARD	CERTIFICATE OF OCCUPANCY	REMARKS
1-17-72	28448	9892			<i>Superstructure not present</i>
4/25/72	28448	2		2101	F2
2-28-72	E 43249	<i>Renovation</i>		122 E COSTILLA ST	P A 20540
5-4-72	E 44942	<i>Allen Electric</i>		01/30/84 RANALS PLBG & HTG INC	
2-14-72	H 21930	<i>Each</i>		122 E COSTILLA	P A 26172
2-15-72	H 21958	<i>Ciff</i>		04/03/84 RANALS PLBG & HTG INC	PLAN:
3-1-72	P 20126	"			

2 E COSTILLA
1/30/83 R & L ELECTRIC

010 E A 16985

2 E COSTILLA ST M A 17153
1/07/83 RANALS PLBG & HTG INC

2 E COSTILLA E A 19565
1/10/84 KISTLER ELECTRIC CO
PLAN: ✓

5-7-72 D 9920

Pikes Peak Regional Building Department

26-apr-2007 11


Address History: 122 E COSTILLA ST

Permit#	Date	D Contractor	Permit History S Description	Owner
121 E COSTILLA ST				
B12981	25-nov-1987	H GUILLORY PLUMBING & A		COLO SPGS REALITY
122 E COSTILLA ST				
A26172	03-apr-1984	F RANALS PLUMBING & HE F		RANALS PLBG & HTG IN

Compl#	Insp.-Date	Code	Inspector	Special Inspection History Description

Fire Prevention System - Plan Review

Unit	Address	Notes	Systems	Inspections	Electronic Documents
2007-0016					
CN 20070016-CN-1					
MEMORIAL HOSP					
MEMORIAL H					
YEN CHING - 2912					
YEN CHING - 3313					
Unit Status	Active				
Unit Type					
Business Name	YEN CHING				
Fire Department	0456 01 23.00 80903				
Fixed Property Usage	915 VACANT BUILDINGS				
Department ID					
Personnel	23.00				
Total Occupancy	0				
Occupant Load	0				
Manual Alarm					
Manual Alarm					
Assigned Station	01				
High Rise					
Fire Department					
Fire Department					
Fire Department					
Fire Department					

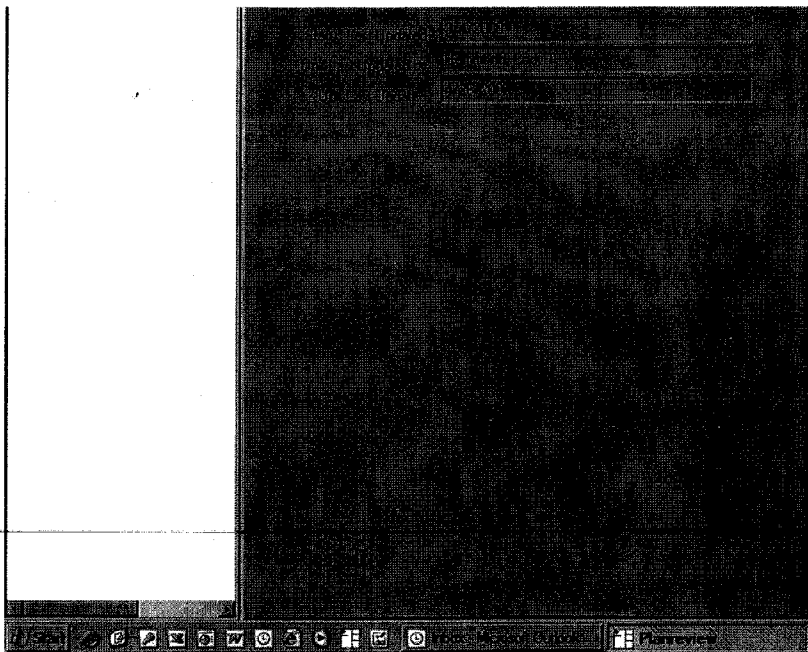

Williams Carol E. 598-3780
 463 Woods Robert L. 598-3780
 465 Ireland Judith E. 598-5663
 466 Charles John T. & Rosalia 598-5663
 467 Garcia Juan G. & Sara 598-5663
 468
 469
3500 Campelli Jimmy U. & Mary 595-0405
 3501
 3502
4000
 4001
 4002
1998, 1999, 2000, 2679, 26

Mazzel Sandra J
818 Deleon Santos J
819 Deleon Nani C
817 Myers James E
Myers Hedwig
820 Griffin Paul A & Leona
823 McDonald Anthony B
824 McPhoe Stephanie G
826 Vanduyke Roberta
827 Hartly Richard W
830 Lipich Charles L
Lipich Liane L
831 Lopez Carmen R
Lopez Joseph L
832 Uhlinger Ken D
Uhlinger Jennifer M
834 Pencia Adolis
835 Connors Kevin
839 Gerardo Roger L Jr
Gerardo Priscilla M
Graves Kenneth A

840	Anderson John A	576
841	Anderson Norman E	576
842	Victor Dorothy J	576
+S INSTITUTE ST INTERSECTS		
842	Walker Rosalie L	576
9050	Maxwell Delores	576
	(Maxwell Frederick	576
9050	Brown Jennifer	576
	Browne Elizabeth A	576
	Browne Larry V Sr	576
	B Not Verified	576
512	Vonner O B	576
	Vonner Edith	576
914	Culbertson Leta L	576
	Culbertson Thayne L	576
915	Sturtevant Donald M & Jeanne	576
	Smith Steve	576

9200	Horton Stan	
921	Valent Sean F & Catherine	
922-924	Not Verified (2 Hsa)	
926	Gomez Salvador L & Dolores	
927-928	Corra F & M	
929	Cienros Jesse S B	
932	Basz Matthew R B	
	Basz Dirk	
933	Salazar Joe S B	
	Salazar Maria M	
933 1/2	Montoya Linda	
934	Not Verified	
937	Donaldson Michael R & Kerri	
938	Garcia Theresa M	
	Garcia Daniel	
941	Serotini Mary K B	
942	Falkbanks Cray R B	

945	Davis Victor H D	508
948	Durkee Heidi M D	509
947	Byron Kelley A D	509
	Jensen Richard L	
	Modin Sheri L D	471
950	Martin Carl R D	471
951	McGee ST INTERACTS	471
3	1002 Chambers Carl S D	450
	1008 Webb Bradley C	532
7	1010 Gonzalez Terence F D	515
	1013 Meehan Joseph T Jr D	515
	Meehan Suzanne K	515
	1017 Rae Dennis M D	515
919	1019 Dan Barbara J D	515
1020	INTEGRITY LAWN SERVICE	545
	garden svcs	

1023 Marzaw Neiche M (B) 47
 Marzaw Arnold H
 1023 McCormick Donald E (B) 43
 McCormick Dorothy
 1024 Clark Michael S (B)
 Clark Kathleen R
 Thompson Winifred D (B) 43
 1026 Gamble Connie C (B) 40
 Gamble Wima D
 1028 PALMS LANDSCAPING (B)
 garden services
 1029 Moreno C
 10330 Martinez Rosalinda
 1034 Gutierrez Louise M (B)
 + COSTILLA ST E BEGINS
 + S HANCOCK AVE INTERSECTS

BUSINESSES 23 HOUSEHOLDS

W COSTILLA ST (COLORADO SPRINGS)-FROM 2 E COSTILLA ST WEST

+ S CASCADE AVE INTERSECTS

- ZIP CODE 80903 CAR-RT C003

140-Hlavac Dana P..... 632

- ZIP CODE 80903 CAR-RT C037

HLAVAC DANA P PG atty..... 632

- ZIP CODE 80903 CAR-RT C003

@Hohertz Robert M..... 632

@Shupp Gary L..... 654

ZIP CODE 80903 CAR-RT C003
VAHSOLTZ GEORGE R PG-
SVCS 632
WHITTIER SHUPP AND VANA
legal svcs 834
ZIP CODE 80903 CAR-RT C003
20 Hill Street M 5

7	80911
Madre 7	85-392-5764
48	68
42	47
46	39
41	26
40	95 391-2858
39	47
38	39
37	39
3190	4-87	79
3185	9-83	78
3175	Richard C Taylor	75-599-5179
3175	Don Jenkins	85-531-8768
	11-85	89
	3-87	87
3180	2-89	83
3185	2-85	73
3190	Pota Ittner	95-534-9083
	Peter Ittner	91-593-1357
	8-81	85
	3-78	51
3205	Richard D Parenti	92-280-9305
	12-81	72
3215	Barbara Dixon	91 598-8589
	7-77	44
3220	3-82	82
3225	3-82	122
3230	6-83	86
3230	Charles E Vancura	77-599-5311
	6-77	43
3235	Larry Blasen	95 592-0305
3245	Gary Brock	83-593-7061
	12-82	71
3250	3-87	92
	6-83	98
3255	Michael Harvey	92-522-0840
	6-82	87
3265	Michael Sullivan	93-535-9182
	4-83	108
3270	John Roberts	522-0627
	5-81	62
3275	1-80	59
3285	G J Simoneaux	95 599-4250
3290	Archie E Belford	75-599-3073
	J Belford	75-599-3059
	9-84	86
3295	6-94	NP
3300	Woody Lewis	94-548-8329
	6-84	85
3320	N S Schiller	92-280-8170
	5-81	89
3325	Heinz Fox	90-528-6361
	11-80	94
3330	Daniel Kanzler	84-593-7861
	3-84	72
3340	6-80	87
	7-80	87
3350	Tim D Campbell	86-593-0405
	12-87	75
3360	Jack L Hudson	75-598-9280
	5-75	33
3370	4-77	38
3380	2-86	135
3410	D Spurlough	91-522-1026
	11-89	101
3415	Wm F Horton Jr	79-598-3698
	7-78	74
3425	M A Lewis	95-533-0319
	5-84	147
	6-85	140
3430	4-84	142
	5-84	141
3435	John C Dejong	95-598-8962
	7-79	81
3440	Robert D Cooke	83-590-1837
	2-84	142
3445	5-82	91
	9-86	187
3450	George Kitkowski	91-594-9529
	6-80	138
3460	3-78	88
3465	11-81	125
3470	Michael Vaughan	88-531-8733
	12-88	23
	5-88	125
	78	RESIDENCE

3190	4-87	79
3185	9-83	78
3175	Richard C Taylor	75-599-5179
3175	Don Jenkins	85-531-8768
	11-85	89
	3-87	87
3180	2-89	83
3185	2-85	73
3190	Pota Ittner	95-534-9083
	Peter Ittner	91-593-1357
	8-81	85
	3-78	51
3205	Richard D Parenti	92-280-9305
	12-81	72
3215	Barbara Dixon	91 598-8589
	7-77	44
3220	3-82	82
3225	3-82	122
3230	6-83	86
3230	Charles E Vancura	77-599-5311
	6-77	43
3235	Larry Blasen	95 592-0305
3245	Gary Brock	83-593-7061
	12-82	71
3250	3-87	92
	6-83	98
3255	Michael Harvey	92-522-0840
	6-82	87
3265	Michael Sullivan	93-535-9182
	4-83	108
3270	John Roberts	522-0627
	5-81	62
3275	1-80	59
3285	G J Simoneaux	95 599-4250
3290	Archie E Belford	75-599-3073
	J Belford	75-599-3059
	9-84	86
3295	6-94	NP
3300	Woody Lewis	94-548-8329
	6-84	85
3320	N S Schiller	92-280-8170
	5-81	89
3325	Heinz Fox	90-528-6361
	11-80	94
3330	Daniel Kanzler	84-593-7861
	3-84	72
3340	6-80	87
	7-80	87
3350	Tim D Campbell	86-593-0405
	12-87	75
3360	Jack L Hudson	75-598-9280
	5-75	33
3370	4-77	38
3380	2-86	135
3410	D Spurlough	91-522-1026
	11-89	101
3415	Wm F Horton Jr	79-598-3698
	7-78	74
3425	M A Lewis	95-533-0319
	5-84	147
	6-85	140
3430	4-84	142
	5-84	141
3435	John C Dejong	95-598-8962
	7-79	81
3440	Robert D Cooke	83-590-1837
	2-84	142
3445	5-82	91
	9-86	187
3450	George Kitkowski	91-594-9529
	6-80	138
3460	3-78	88
3465	11-81	125
3470	Michael Vaughan	88-531-8733
	12-88	23
	5-88	125
	78	RESIDENCE

3190	4-87	79
3185	9-83	78
3175	Richard C Taylor	75-599-5179
3175	Don Jenkins	85-531-8768
	11-85	89
	3-87	87
3180	2-89	83
3185	2-85	73
3190	Pota Ittner	95-534-9083
	Peter Ittner	91-593-1357
	8-81	85
	3-78	51
3205	Richard D Parenti	92-280-9305
	12-81	72
3215	Barbara Dixon	91 598-8589
	7-77	44
3220	3-82	82
3225	3-82	122
3230	6-83	86
3230	Charles E Vancura	77-599-5311
	6-77	43
3235	Larry Blasen	95 592-0305
3245	Gary Brock	83-593-7061
	12-82	71
3250	3-87	92
	6-83	98
3255	Michael Harvey	92-522-0840
	6-82	87
3265	Michael Sullivan	93-535-9182
	4-83	108
3270	John Roberts	522-0627
	5-81	62
3275	1-80	59
3285	G J Simoneaux	95 599-4250
3290	Archie E Belford	75-599-3073
	J Belford	75-599-3059
	9-84	86
3295	6-94	NP
3300	Woody Lewis	94-548-8329
	6-84	85
3320	N S Schiller	92-280-8170
	5-81	89
3325	Heinz Fox	90-528-6361
	11-80	94
3330	Daniel Kanzler	84-593-7861
	3-84	72
3340	6-80	87
	7-80	87
3350	Tim D Campbell	86-593-0405
	12-87	75
3360	Jack L Hudson	75-598-9280
	5-75	33
3370	4-77	38
3380	2-86	135
3410	D Spurlough	91-522-1026
	11-89	101
3415	Wm F Horton Jr	79-598-3698
	7-78	74
3425	M A Lewis	95-533-0319
	5-84	147
	6-85	140
3430	4-84	142
	5-84	141
3435	John C Dejong	95-598-8962
	7-79	81
3440	Robert D Cooke	83-590-1837
	2-84	142
3445	5-82	91
	9-86	187
3450	George Kitkowski	91-594-9529
	6-80	138
3460	3-78	88
3465	11-81	125
3470	Michael Vaughan	88-531-8733
	12-88	23
	5-88	125
	78	RESIDENCE

3190	4-87	79
3185	9-83	78
3175	Richard C Taylor	75-599-5179
3175	Don Jenkins	85-531-8768
	11-85	89
	3-87	87
3180	2-89	83
3185	2-85	73
3190	Pota Ittner	95-534-9083
	Peter Ittner	91-593-1357
	8-81	85
	3-78	51
3205	Richard D Parenti	92-280-9305
	12-81	72
3215	Barbara Dixon	91 598-8589
	7-77	44
3220	3-82	82
3225	3-82	122
3230	6-83	86
3230	Charles E Vancura	77-599-5311
	6-77	43
3235	Larry Blasen	95 592-0305
3245	Gary Brock	83-593-7061
	12-82	71
3250	3-87	92
	6-83	98
3255	Michael Harvey	92-522-0840
	6-82	87
3265	Michael Sullivan	93-535-9182
	4-83	108
3270	John Roberts	522-0627
	5-81	62
3275	1-80	59
3285	G J Simoneaux	95 599-4250
3290	Archie E Belford	75-599-3073
	J Belford	75-599-3059
	9-84	86
3295	6-94	NP
3300	Woody Lewis	94-548-8329
	6-84	85
3320	N S Schiller	92-280-8170
	5-81	89
3325	Heinz Fox	90-528-6361
	11-80	94
3330	Daniel Kanzler	84-593-7861
	3-84	72
3340	6-80	87
	7-80	87
3350	Tim D Campbell	86-593-0405
	12-87	75
3360	Jack L Hudson	75-598-9280
	5-75	33
3370	4-77	38
3380	2-86	135
3410	D Spurlough	91-522-1026
	11-89	101
3415	Wm F Horton Jr	79-598-3698
	7-78	74
3425	M A Lewis	95-533-0319
	5-84	147
	6-85	140
3430	4-84	142
	5-84	141
3435	John C Dejong	95-598-8962
	7-79	81
3440	Robert D Cooke	83-590-1837
	2-84	142
3445	5-82	91
	9-86	187
3450	George Kitkowski	91-594-9529
	6-80	138
3460	3-78	88
3465	11-81	125
3470	Michael Vaughan	88-531-8733
	12-88	23
	5-88	125
	78	RESIDENCE

5-38 125	
79 RESIDENCE	
● CORTINA PL 8091N	
New Street-1972	
3130	1-80 1180 CT 48 #C.110 39
● THE WPC LOC 1180	
3130	NP
3134	John J Black . 92 #590-4874
	8-82 92
3138	Helen Melchior . 94 #538-0848
	8-82 94
	2-84 121
3142	C R Porter III . 92 #599-7394
	3-82 94
	Clar R Porter III . 90 #582-3484
	10-72 91
3146	Robert J White . 93 #588-2762
	10-72 91
	10-72 30
3150	William E Harper 79 #599-0890
	12-78 42
79 RESIDENCE	
● CORY PL 8091S	
New Street-1984	
3150	8080 CT 51 #C.E. 3
● THE WPC LOC 1180	
3150	NP

			80918
3235	Evan Hankins	.92	531-9443
	12-85	77	
3245	Gary Brock	83-593-7061	
3250			
	6-83	88	
3265	Michael Harvey	92-522-0640	
	6-82	87	
3265	Michael Sullivan	93-635-8162	
	4-83	108	
3270		NP	
3275	J W Himmelreich Jr		
		80-596-9712	
3285	Thomas Lyman	93-528-2419	
3280	Archie E Belford	75-599-3073	
		75-599-3068	
	6-84	66	
3295		NP	
3300	Woody Lewis	NP	548-8328
	1-84	85	
3320	N S Schiller	92-260-8170	
3325	Heinz Fox	90-528-6361	
	11-90	94	
3330	Daniel Kanzler	84-593-7961	
3340		7-50	87
3350	Tim D Campbell	86-593-0405	
	12-87	75	
	2-88	79	
3380	Jack L Hudson	75-598-9280	
3370		NP	
3380	Robert C Tesar	76-598-7569	
3410	D Spunick	91-522-1026	
	11-59	101	
3415	Wm F Horton Jr	70-598-3698	
3425	Rev Chas E Crosby	84-598-1374	
	8-88	98	
3430		4-84	142
3435		NP	
3440	Robert D Cooke	83-590-1837	
3445		NP	
3450	George Kitkowski	91-594-8520	
	6-80	138	
3460		NP	
3463		11-81	122
3470	Michael Vaughan	86-531-6733	
	12-86		
	5-88	125	

CORTINA PL 80910 New Street-1972

3130	NP	
3134	John J Black	92-590-487
	8-92	92
3138	Helen Melchior	84-536-964
	2-93	93
3142	C R Porter III	92-599-739
	C R Porter III	90-562-946
3146	Robert J White	93-598-275
3150	William E Harper	79-599-089

CORY PL 80915 New Street-1984

6800-5899 CT 51		\$C.E. 3
● THE BAPC LOG A-1		
6810	Michael Williams	93-560-963
	11-31 72	
	11-93 89	
6815	Drake Rinesmith	92-591-900
	2-89 65	
6820	Jasa Raffo	84-380-144
	4-92 47	
6830	Richard McWade	92-591-898
	4-82 83	
6835	Richard Easton	84-574-237
	8-94 115	
6840	Jon M Mender	91-593-825
	10-80 40	
6845	Jay Starkey	91-596-755
	3-84 47	
6850	Jds Peinings-Pohn	92-574-311
	8-84 72	
6855	Carla Sutherland	91-570-741
	3-82 76	

COSMIC LIGHT DR 80917 New Street-1985

5245	Tony Jean	92-550-1432
5250	L R Rhymer	85-596-0800
5255	Melissa Andreorrio	91-570-0701
5265	Steve Andreorrio	91-570-7057
5265	Cabin J Mallinson	91-596-0855

E COSTILLA ST 80963 From 400 S Cascade E

104	P Coolidge-Germer	92-578-9812
104	P Coolidge-Germer	91-578-9812
109	NP	
110	* Kings Chef	634-8135
111	* Pink Castle	634-8135
113	8-85 85	
113	* A&L Vells&Headops	678-9812
115	* H&M Vacuum Sales	NP
122	4-81 127	67 633-8255
211	Assistance League	90-475-1029
220	Deluxe Clnr&Lndry	83-633-8018
233	Thomas&Thom	88-578-5777
315	8-84 144	
318	Printers Personnel	82-520-0205
318	M R Bromley Atty	91-471-9300
318	* J E Kirschner Atty	91-471-9300
318	* C Migliccio Atty	91-471-9300
318	* J R Torbet Atty	91-471-9300
318	* M R Bromley Atty	91-471-9300
318	* J E Kirschner Atty	91-471-9300
318	* C Migliccio Atty	91-471-9300
318	* J R Renfrow Atty	90-471-9300
318	* J R Torbet Atty	90-471-9300
325	Stand-By Personnel	82-520-1800
325	* Stand-By Personnel	82-520-1800
325	* Stand-By Personnel	82-520-1800
328	2-88 98	
330	Chang Shing Ship	88-578-8654
437	Brass Bds Banfield	86-577-0003
444	* Downtown Dodge	86-577-0003
444	Daniels Send Co	70-475-0700
444	* Prosoft Intl Inc	83-638-1227
444	* Prosoft Intl Inc	83-638-1227
444	* Transit Mx Concr Co	NP
508	511 515 519	NP 638-3796
527	536 538	NP
548	* Colo Spg Whal Fr	83-632-4673
551	* Consolidated Growers	90-633-0384
551	ENT Fed Credit Un	91-574-1100
708	Douglas E Marchant	NP

505	511 515 519	NP	91 636-379
527	535 539	NP	
548*	Colo Spg Whlsl Fir	832-467	
	*Consolidtd Growers	80 633-038	
551	554	NP	
555*	ENT Fed Credit Un	91 574-110	
705		NP	

734	Marathon Grebenc	86-473-4552
737	R J McCoy	81-471-0348
738	Mary K Mitchell	91-635-3680
740	Elious Zenon	77-632-7542
743	K E Wilson	81-630-3803
746	E L Cole	80-634-0901
752	M C Gae	83-633-4548

733	Lonnie Kubik	-	836-8988
	Steven L Livengood	93	635-7116
	★ M P Marrison Atty	92	577-9258
	★ C F Hartman Const	83	634-4121
	★ Lonnie Kubik	92	836-8988
	★ Stephen Swift Atty	90	520-0116
	10-40	135	
734	Matthew Grebenc	-	473-4556
	12-93	47	
737	R J McCoy	92	471-0341
	9-92	27	
738	Monica K Mitchell	91	635-2881

738	Mary K. Mitchell	91-630-308
	12-85	80
	12-90	18
740	Elious Zenon	77-632-75
743		.NP
744	K E Wilson	II 630-36
746		.NP
748	E L Cole	90-834-09
752	M C Gee	--833-45
	10-86	53
	8-94	90
801	Peter T Landry	87-635-18

802	2-86	31	
	3-92	38	
	3-93	48	
807	L A Pollock	88	634-71
	4-88	41	
809			NP
812	Lessie Slay	81	473-62
	2-86	48	
	7-94	71	
813	815 816 817		NP
820	Paul A Griffin	79	633-03

823	NP	
824	Jay Rogers	■ 635-66
826	Roberts Vandyke	89-636-36
827	Richard W Hart	■ 633-69
	4-86	45
830	Charles L Lipich	■ 475-08
831	832	NP

902	Bernice Ross	54	532-3387
905	Dolores Maxwell	84	471-1510
906	Frederick Maxner	85	578-9758
908	Rebecca Pauli	82	832-0005
912	O B Vonner	63	633-8868
914			NP
915	Donald Sturtevant	85	475-7887
		11-84	47
		12-84	17
917			NP
920	Stan Horton		* 632-5181
921		11-83	65
922		8-83	23
924		4-83	23
928			NP
930	Corra F Martinez	90	634-5210
		1-88	31
		1-80	34
		5-80	35
931	Robert Cisneros	IX	520-9288
932	Matthew Basy		* 634-6725
		10-81	23
		9-84	60
933	Apartments		
932	Joe S Salazar	67	634-5036
934		7-84	87
937			NP
938		8-85	59
941	M Serotini	81	633-6099
942	Craig R Fairbanks	83	636-1677
943	Robert W Johnson	83	636-1678
945			NP
946	Barbara Ann Sears	83	634-3888
947	Eric A Menchaca	IX	638-7711
950		11-85	35
1002	Robert Hodge	IX	634-4261
		2-88	38
		1-84	40
1008		8-84	38
1010	Teresa F Gonzalez	87	642-5476
1013	C R Ramirez		* 442-4648
		6-84	67
1019			NP
1020	R Lewis	IX	473-3900
1021	W McCornick	83	638-5259
1024	Winifred Thompson		833-8680
1028			NP
1028	Nicole Moffitt		520-936
		10-88	38
		12-89	39
1033		11-86	83
1034		10-86	28
97	RESIDENCE	38	BUSINESS

W COSTILLA ST 80963 From 480 S Cascade W

800-1385 CT	24	HE 3
1	THE MAP	NP
12	* The Door Stop	89-634-1567
14	* R M Hohertz Atty	91-632-9422
14	* G L Shuapp Atty	91-634-4435
14	* Dana P Hievac PC	82-632-1459
14	* D L Lamborn Atty	83-471-1441
14	* Gary Shupp Atty	91-634-4435
14	* G R Vahneitz Atty	85-632-1145
15	17-11	NP
20	Sandy Hill	83-473-8813
22	* The Glass Door	85-630-6666
30	Capco	83-632-8722
30	* Capco Ceramic	83-632-8722
30	* Summit Const	85-633-8722
101	Regional Building	83-632-8722
101	See Building Dry	83-632-8722
125	* Tuxall Unim&Equip	75-636-5134
125	* Berwick Elec Co	83-632-7893
311	312	NP
316	Mrs R R Gonzales	68-634-7085
318	NP	
328	* A P Harley Sala Co	63-632-1137
327	NP	
328	* Beaver Log Homes	68-633-0181
331	NP	
332	* Sides General Ino	72-475-9311
7-94	156	

			80905
919*	Copstone Co		578-683
1019	W Littleton		81-471-128
1210	W A Ward		93-575-078
1211	4-81	20	
1218		NP	
1223*	Orion Herbal Prod	83	632-444
	*Pilgrim Hollins Ch	89	632-444
	*Rev D R Stratton	83	632-444
1304	James Mullin		86-632-478
	7-88	38	
1310	Dan Solisbury		- - 473-782
	3-81	12	
20	RESIDENCE	20	BUSINESS

COTTAGE DR 80963 New Street-1987

7400	Scott V Staines	81-471-1288
7400	Lovell S Twille	1-89 78
7440	Charles Ponck	12-83 105
7445	Charles Ponck	6-82 82
7460	Edward J Green	4-89 78
7465	Gerard M B	2-89 78

3765	8-83	185	
3770	5-82	23	
	8-82	181	
3775	Michi J Kepuratis	85-578-1923	
	11-82	23	
	3-83	149	
3779	Maj Wm Gessner	81-592-24	
	5-82	188	
3780	9-82	22	
	7-82	22	
	11-82	159	
3785	James W Long	7-82	159
	2-82	24	
	5-82	150	
3789	Anita Staley	6-82	23
	10-82	131	
3790	Gary C Walters	8-82	22
	5-82	148	
3795	Robert W Aldred	4-82	22
	7-82	141	
3801	M Laberge	9-88	100
3802	Mark Shriver	9-82	23
	12-82	150	
3808	H Ed Robertson	5-89	122
	7-82	146	
3810	Ravi K Gulati	8-82	23
	12-82	150	
3814	David Melezer	7-83	23
	10-83	138	
3817	Scott Lutz	4-91	114
	5-82	134	
3818	Jerry W Copeland	11-82	23
	3-83	127	
3820	R L Thomas	8-82	23
	12-82	136	
3825	11-89	118	
3830	P A Riley	9-82	23
	1-83	139	
3833	David J Kirk	5-87	80
	6-88	96	
	4-92	113	
3840	Bruce Young	5-83	23
	9-83	188	
3841	James R Durhan	9-87	23
	2-84	173	
3845	Dana Stanecok	8-83	161
	M Stanecok	6-81	24
3849	11-81	124	
	1-84	163	
3857	2-91	24	
	5-91	118	
3901	C O Herrington	8-87	23
	8-87	141	
3902	Brian Hill	7-83	23
	11-83	173	
	12-83	173	
3908	Michael Grebe	7-83	23
	10-83	166	
3909	J H Willis	6-88	105
	8-82	23	
3920	James M Fuller	8-82	115
	8-82	115	
33	RESIDENCE		

A AVE S

John Apricio .65-833-4859
Chris Haze .92-638-3009
12-23-92 498
A Lanzetta .61-632-4761
Carlos Hernandez H-577-4597
1-2-87 380
Pine Derrico .92-473-7483
David Lovato .84-473-1057
9-18-94 439
Ronald J. Jefferson 91-831-8393
James Meadows 91-630-7625
Fred Read .NP
10-12-93 420
NP
11-25-84 400
10-12-85 430
10-28-88 425
Martin Cardona .92-442-2325
Jesse Cienaros .92-634-8041
Roger E Smith .84-473-2048
Richard Cullen .92-630-1392
NP
Jimmie Windham 92-636-3854
Rocky Floyd Medina 92-678-8822
12-14-86 451
12-24-90 272
12-5-92 345
Julius L. Denning 91-635-7882
Jacobbi .91-578-8008
Ed Gingarich .79-471-4279
J Taylor .91-442-1521
7-14-93 425
Gerran H Smith Jr 61-634-0335
Fred Badial .91-833-9385
9-27-198 .NP
Warren W Sweet 75-632-4763
A Cutaran .89-471-9206
11-4-84 480
11-1-88 473
William D Brown 92-633-5630
9-25-88 .NP
James .83-633-2901
David V Whitlay 75-678-8083
Dempsey 71-635-5851
NP
Harold S Light 633-8383
NP
Billy R Edmiston 68-471-0628
11-1-89 260
NP
Marie M Hegu .64-576-8641
12-5-93 419
NP
Todd Roper .92-540-9732
9-10-85 405
11-4-93 415
NP
215
Michael Guerrero 92-380-0638
14-14-87 478
10-10-87 400
10-10-87 400
7-15-88 383
A Ritchey .86-576-0119
Ariene Mattos .92-444-9763
Wesley B Campbell
RESIDENCE 68 472-1746

CORONADO DR 80918

1140-1489 CT 52 80-910
NP LOC 1-8
St Robert Connors 72-633-4100
7-5-85 859
Tanciel H Boyle .86-835-1074
Mary Mehroff .91-635-8365
NP
Portillo Barabado 84-832-6015
William J Graham 75-632-2455
Andrew G McDermott
92-6473-7627
NP
George To .90-833-5096
11-25-86 850
Connie Guardino 92-471-2779
9-31-85 860
10-2-88 750
10-10-92 789
Edith F Harvey 81-471-7421
Thert G Ybanez 92-630-7536
7-5-88 760
NP
RESIDENCE

CORPORATE CENTR DR 80919

578-1089 CT 37.03 A.A.S
NP LOC 1-3
New S Wales Retmnt
22 260-8555
Advnt Mini Golf 92-528-5490
Dr Tracie E Koller .92-528-8555
Cantech .90-260-8080
Senti Bell Info 92-590-7377
Colonial Life/Accord 91-260-3333
Computech .99-599-9400
Growthmasters Corp
92-582-0500
Independent Forecsts 92-531-0304
Lmg Cores 91-593-2448

6780 *Perot Systems Corp 598-3800
*State Farm Ins Co 90-260-8800
*Touch Math .91-593-2448
6808 Tiffany Square
NP
*Tiffany Square .85-593-1537
*Tiffny Sq & Thtrs 85-598-5200

7-5-85 9999
1 RESIDENCE 20 BUSINESS

CORPORATE PLAZA DR 80919

New Street-1992
5000-599 CT 37.04 A.A.S
NP LOC 1-3
5030 *Alta Incorporated 92-598-4299
*S&M Microscope Inc
92-593-0078
5040 *Graven Austen & Drake
Mail .92-548-8292
1 BUSINESS

CORRAL VALLEY DR 80911

RR 5 .800-1199 CT 51
970 Robert S Ferguson 79-683-2210
6-9-87 320
1080 Robert W Pace .75-683-2818
2 RESIDENCE

CORTEZ DR 80911

N of 1800 Security Blvd
2200-2228 CT 41
NP LOC 1-3
*THE MAP LOC 1-3
2105 James V Geiger .90-390-0430
Roy Kovach .92-392-5854
2109 7-25-87 420
9-25-89 480
2201 Joe Juvera .89-392-6849
8-9-89 393
2205 Antonio Martinez .91-390-9847
NP
2208 James E Windle 79-632-8539
2210 L P Adams .87-382-9233
2213 David M Lehman .91-390-9213
2-10-92 510
7-30-93 510
2214 T G Roane .92-381-0872
2217 Chris P Politiks .92-382-5081
1-7-88 510
5-10-83 490
2218 Donald S Beebe 92-390-8768
3-27-92 349
2221 Walter E Zanitz .92-392-5806
12-22-92 415
2225 Richard Millard .83-392-2471
2228
2229 Kevin Keller .92-391-0303
8-2-92 470
2230 Jose D Trujillo 71-392-9572
2233 NP
2234 William Philippus .91-0728-2232
2237 2238 2242 NP
2246 Brian S Guthouse .92-392-7518
24 RESIDENCE

CORTINA CIR 80918

New Street-1992
3180-3499 CT 46
NP LOC 1-3
3403 Jarr Thomas .83-590-1290
3413 Warren Schubert .91-589-1496
10-22-91 1550
3423 John March .92-594-0354
11-5-91 850
3433 Joe E Houch .76-589-0106
3436 1-19-93 1107
3443 NP
3453 James O Stewart 90-589-3520
3458 Gregory J Nelson 78-598-7458
3463 Jeffrey D Wakeford 92-593-0887
473 Ed Mittinge .92-833-8524
3476 Carl E Hadman .75-598-3780
12-30-92 175
3486 Charles E Ireland 87-599-8683
10-8-88 1250
3483 Brian Chaffee .91-280-9419
3486 NP
15 RESIDENCE

CORTINA DR 80918

New Street-1992
2880-3699 CT 48
NP LOC 1-3
*THE MAP LOC 1-3
2910 Greg Frank .92-260-9894
6-9-87 760
2915 NP
2920 Michael A O'Neill 74-598-4918
2935 Gary Vymazal .87-260-1532
9-25-87 800
2940 Wini Feric .73-598-3051
10-19-85 967
2945 Douglas A Swanson
91-528-8480
2950 Robert S Unks .91-528-8480
2955 M Gilbert .92-531-5283
P Lamontagne .92-531-0527
2960 Joann Ryan .89-592-9310

3010 4-2-92 1030
3015 Larry Besch .92-260-8877
Lawrence E Besch .92-590-8027
3025 Roger A Raymond .92-522-1519
12-4-90 1033
3030 Al Stiger .80-599-4493
3045 John Donlin .92-528-5848
Carol Harper .92-260-7987
Carol Harper .92-528-5848
12-26-80 813
1-29-93 470
3050 Charles Delany .92-593-0571
12-30-92 935
3055 M J Giannini .86-598-8154
3080 Daniel E Eason 79-598-2953
3085 Ken Budzon .85-599-7640
3085 Warren E McLean .89-528-5124
10-28-84 400
3105 Ernest L Rine Jr .92-599-5342
7-15-91 729
3125 James Beatty .92-531-5464
6-5-86 850
3138 NP
3145 Wm C Campbell Jr 84-599-4852
3154 Elwood M Larsen 88-599-9152
9-24-86 810
3155 T M Smith .82-598-4399
160
5-22-86 845
4-15-87 790

CORPORATE PLAZA DR 80919

3165 Gregory Cole .87-599-7072
3170 Richard C Taylor 76-599-5719
3175 Don Jenkins .86-531-8768
11-2-85 860
3-17-87 870
3180 2-15-93 839
3185 *Carpet Medix Inc .91-260-9011
3190 Peter Ittner .91-593-1357
6-20-91 845
3205 NP
3210 Richard D Parent 92-260-8306
3215 Barbara Dineen .86-598-8898
3220 Keith H Sheldon 92-598-8838
3-31-92 819
3225 Thomas Hellenbeck 92-598-5542
6-17-87 845
3230 Charles E Vonnort 77-599-5311
3235 Evan Hankins .92-531-9443
12-1-88 770
3245 Gary Brock .83-593-7801
W E Wright .91-582-0182
3-3-87 920
3-18-87 870
6-25-93 980
3255 Michael Harvey .92-522-0840
3265 Michael Sullivan .92-535-9182
4-6-93 1079
3270 NP
3275 J W Himmelreich Jr .90-598-9712
3285 Thomas Lyman .92-528-4191
3290 Archie E Belford 75-598-3073
J Belford .75-598-3069
3295 NP
3305 M Boettger .92-528-0058
3310 Keith B Donley .92-593-9118
8-10-84 850
3320 N S Schiller .92-260-8710
3325 Wm H Henson .92-528-5361
11-6-90 935
3330 Daniel Kanzler .84-593-7981
7-6-80 770
3340 Tim C Campbell .88-593-0405
12-22-87 750
3380 Jack L Hudson .75-598-8290
NP
3370 NP
3380 Robert C Tesar .78-598-7591
3410 D Spurling .91-522-1028
11-2-89 1010
3415 Wm F Horton Jr 79-598-3698
3425 Rev Chas E Crosby 85-548-1374
8-18-88 885
3430 Joseph S Cabulecky .76-598-1178
NP
3435 NP
3440 Robert D Cooke .83-590-1837
3445 NP
3450 George Kirtkowsky 91-594-9529
6-4-80 1380
3460 11-12-91 1221
3463 NP
3470 Michael Vaughan 89-531-6733
12-15-88 230
5-2-88 1250
80 RESIDENCE 1 BUSINESS

CORPORATE PLAZA DR 80919

3185 Gregory Cole .87-599-7072
3170 Richard C Taylor 76-599-5719
3175 Don Jenkins .86-531-8768
11-2-85 860
3-17-87 870
3180 2-15-93 839
3185 *Carpet Medix Inc .91-260-9011
3190 Peter Ittner .91-593-1357
6-20-91 845
3205 NP
3210 Richard D Parent 92-260-8306
3215 Barbara Dineen .86-598-8898
3220 Keith H Sheldon 92-598-8838
3-31-92 819
3225 Thomas Hellenbeck 92-598-5542
6-17-87 845
3230 Charles E Vonnort 77-599-5311
3235 Evan Hankins .92-531-9443
12-1-88 770
3245 Gary Brock .83-593-7801
W E Wright .91-582-0182
3-3-87 920
3-18-87 870
6-25-93 980
3255 Michael Harvey .92-522-0840
3265 Michael Sullivan .92-535-9182
4-6-93 1079
3270 NP
3275 J W Himmelreich Jr .90-598-9712
3285 Thomas Lyman .92-528-4191
3290 Archie E Belford 75-598-3073
J Belford .75-598-3069
3295 NP
3305 M Boettger .92-528-0058
3310 Keith B Donley .92-593-9118
8-10-84 850
3320 N S Schiller .92-260-8710
3325 Wm H Henson .92-528-5361
11-6-90 935
3330 Daniel Kanzler .84-593-7981
7-6-80 770
3340 Tim C Campbell .88-593-0405
12-22-87 750
3380 Jack L Hudson .75-598-8290
NP
3370 NP
3380 Robert C Tesar .78-598-7591
3410 D Spurling .91-522-1028
11-2-89 1010
3415 Wm F Horton Jr 79-598-3698
3425 Rev Chas E Crosby 85-548-1374
8-18-88 885
3430 Joseph S Cabulecky .76-598-1178
NP
3435 NP
3440 Robert D Cooke .83-590-1837
3445 NP
3450 George Kirtkowsky 91-594-9529
6-4-80 1380
3460 11-12-91 1221
3463 NP
3470 Michael Vaughan 89-531-6733
12-15-88 230
5-2-88 1250
80 RESIDENCE 1 BUSINESS

CORPORATE PLAZA DR 80919

3185 Gregory Cole .87-599-7072
3170 Richard C Taylor 76-599-5719
3175 Don Jenkins .86-531-8768
11-2-85 860
3-17-87 870
3180 2-15-93 839
3185 *Carpet Medix Inc .91-260-9011
3190 Peter Ittner .91-593-1357
6-20-91 845
3205 NP
3210 Richard D Parent 92-260-8306
3215 Barbara Dineen .86-598-8898
3220 Keith H Sheldon 92-598-8838
3-31-92 819
3225 Thomas Hellenbeck 92-598-5542
6-17-87 845
3230 Charles E Vonnort 77-599-5311
3235 Evan Hankins .92-531-9443
12-1-88 770
3245 Gary Brock .83-593-7801
W E Wright .91-582-0182
3-3-87 920
3-18-87 870
6-25-93 980
3255 Michael Harvey .92-522-0840
3265 Michael Sullivan .92-535-9182
4-6-93 1079
3270 NP
3275 J W Himmelreich Jr .90-598-9712
3285 Thomas Lyman .92-528-4191
3290 Archie E Belford 75-598-3073
J Belford .75-598-3069
3295 NP
3305 M Boettger .92-528-0058
3310 Keith B Donley .92-593-9118
8-10-84 850
3320 N S Schiller .92-260-8710
3325 Wm H Henson .92-528-5361
11-6-90 935
3330 Daniel Kanzler .84-593-7981
7-6-80 770
3340 Tim C Campbell .88-593-0405
12-22-87 750
3380 Jack L Hudson .75-598-8290
NP
3370 NP
3380 Robert C Tesar .78-598-7591
3410 D Spurling .91-522-1028
11-2-89 1010
3415 Wm F Horton Jr 79-598-3698
3425 Rev Chas E Crosby 85-548-1374
8-18-88 885
3430 Joseph S Cabulecky .76-598-1178
NP
3435 NP
3440 Robert D Cooke .83-590-1837
3445 NP
3450 George Kirtkowsky 91-594-9529
6-4-80 1380
3460 11-12-91 1221
3463 NP
3470 Michael Vaughan 89-531-6733
12-15-88 230
5-2-88 1250
80 RESIDENCE 1 BUSINESS

CORPORATE PLAZA DR 80919

3185 Gregory Cole .87-599-7072
3170 Richard C Taylor 76-599-5719
3175 Don Jenkins .86-531-8768
11-2-85 860
3-17-87 870
3180 2-15-93 839
3185 *Carpet Medix Inc .91-260-9011
3190 Peter Ittner .91-593-1357
6-20-91 845
3205 NP
3210 Richard D Parent 92-260-8306
3215 Barbara Dineen .86-598-8898
3220 Keith H Sheldon 92-598-8838
3-31-92 819
3225 Thomas Hellenbeck 92-598-5542
6-17-87 845
3230 Charles E Vonnort 77-599-5311
3235 Evan Hankins .92-531-9443
12-1-88 770
3245 Gary Brock .83-593-7801
W E Wright .91-582-0182
3-3-87 920
3-18-87 870
6-25-93 980
3255 Michael Harvey .92-522-0840
3265 Michael Sullivan .92-535-9182
4-6-93 1079
3270 NP
3275 J W Himmelreich Jr .90-598-9712
3285 Thomas Lyman .92-528-4191
3290 Archie E Belford 75-598-3073
J Belford .75-598-3069
3295 NP
3305 M Boettger .92-528-0058
3310 Keith B Donley .92-593-9118
8-10-84 850
3320 N S Schiller .92-260-8710
3325 Wm H Henson .92-528-5361
11-6-90 935
3330 Daniel Kanzler .84-593-7981
7-6-80 770
3340 Tim C Campbell .88-593-0405
12-22-87 750
3380 Jack L Hudson .75-598-8290
NP
3370 NP
3380 Robert C Tesar .78-598-7591
3410 D Spurling .91-522-1028
11-2-89 1010
3415 Wm F Horton Jr 79-598-3698
3425 Rev Chas E Crosby 85-548-1374
8-18-88 885
3430 Joseph S Cabulecky .76-598-1178
NP
3435 NP
3440 Robert D Cooke .83-590-1837
3445 NP
3450 George Kirtkowsky 91-594-9529
6-4-80 1380
3460 11-12-91 1221
3463 NP
3470 Michael Vaughan 89-531-6733
12-15-88 230
5-2-88 1250
80 RESIDENCE 1 BUSINESS

CORPORATE PLAZA DR 80919

3185 Gregory Cole .87-599-7072
3170 Richard C Taylor 76-599-5719
3175 Don Jenkins .86-531-8768
11-2-85 860
3-17-87 870
3180 2-15-93 839
3185 *Carpet Medix Inc .91-260-9011
3190 Peter Ittner .91-593-1357
6-20-91 845
3205 NP
3210 Richard D Parent 92-260-8306
3215 Barbara Dineen .86-598-8898
3220 Keith H Sheldon 92-598-8838
3-31-92 819
3225 Thomas Hellenbeck 92-598-5542
6-17-87 845
3230 Charles E Vonnort 77-599-5311
3235 Evan Hankins .92-531-9443
12-1-88 770
3245 Gary Brock .83-593-7801
W E Wright .91-582-0182
3-3-87 920
3-18-87 870
6-25-93 980
3255 Michael Harvey .92-522-0840
3265 Michael Sullivan .92-535-9182
4-6-93 1079
3270 NP
3275 J W Himmelreich Jr .90-598-9712
3285 Thomas Lyman .92-528-4191
3290 Archie E Belford 75-598-3073
J Belford .75-598-3069
3295 NP
3305 M Boettger .92-528-0058
3310 Keith B Donley .92-593-9118
8-10-84 850
3320 N S Schiller .92-260-8710
3325 Wm H Henson .92-528-5361
11-6-90 935
3330 Daniel Kanzler .84-593-7981
7-6-80 770
3340 Tim C Campbell .88-593-0405
12-22-87 750
3380 Jack L Hudson .75-598-8290
NP
3370 NP
3380 Robert C Tesar .78-598-7591
3410 D Spurling .91-522-1028
11-2-89 1010
3415 Wm F Horton Jr 79-598-3698
3425 Rev Chas E Crosby 85-548-1374
8-18-88 885
3430 Joseph S Cabulecky .76-598-1178
NP
3435 NP
3440 Robert D Cooke .83-590-1837
3445 NP
3450 George Kirtkowsky 91-594-9529
6-4-80 1380
3460 11-12-91 1221
3463 NP
3470 Michael Vaughan 89-531-6733
12-15-88 230
5-2-88 1250
80 RESIDENCE 1 BUSINESS

CORPORATE PLAZA DR 80919

3185 Gregory Cole .87-599-7072
3170 Richard C Taylor 76-599-5719
3175 Don Jenkins .86-531-8768
11-2-85 860
3-17-87 870
3180 2-15-93 839
3185 *Carpet Medix Inc .91-260-9011
3190 Peter Ittner .91-593-1357
6-20-91 845
3205 NP
3210 Richard D Parent 92-260-8306
3215 Barbara Dineen .86-598-8898
3220 Keith H Sheldon 92-598-8838
3-31-92 819
3225 Thomas Hellenbeck 92-598-5542
6-17-87 845
3230 Charles E Vonnort 77-599-5311
3235 Evan Hankins .92-531-9443
12-1-88 770
3245 Gary Brock .83-593-7801
W E Wright .91-582-0182
3-3-87 920
3-18-87 870
6-25-93 980
3255 Michael Harvey .92-522-0840
3265 Michael Sullivan .92-535-9182
4-6-93 1079
3270 NP
3275 J W Himmelreich Jr .90-598-9712
3285 Thomas Lyman .92-528-4191
3290 Archie E Belford 75-598-3073
J Belford .75-598-3069
3295 NP
3305 M Boettger .92-528-0058
3310 Keith B Donley .92-593-9118
8-10-84 850
3320 N S Schiller .92-260-8710
3325 Wm H Henson .92-528-5361
11-6-90 935
3330 Daniel Kanzler .84-593-7981
7-6-80 770
3340 Tim C Campbell .88-593-0405
12-22-87 750
3380 Jack L Hudson .75-598-8290
NP
3370 NP
3380 Robert C Tesar .78-598-7591
3410 D Spurling .91-522-1028
11-2-89 1010
3415 Wm F Horton Jr 79-598-3698
3425 Rev Chas E Crosby 85-548-1374
8-18-88 885
3430 Joseph S Cabulecky .76-598-1178
NP
3435 NP
3440 Robert D Cooke .83-590-1837
3445 NP
3450 George Kirtkowsky 91-594-9529
6-4-80 1380
3460 11-12-91 1221
3463 NP
3470 Michael Vaughan 89-531-6733
12-15-88 230
5-2-88 1250
80 RESIDENCE 1 BUSINESS

CORPORATE PLAZA DR 80919

3185 Gregory Cole .87-599-7072
3170 Richard C Taylor 76-599-5719
3175 Don Jenkins .86-531-8768
11-2-85 860
3-17-87 870
3180 2-15-93 839
3185 *Carpet Medix Inc .91-260-9011
3190 Peter Ittner .91-593-1357
6-20-91 845
3205 NP
3210 Richard D Parent 92-260-8306
3215 Barbara Dineen .86-598-8898
3220 Keith H Sheldon 92-598-8838
3-31-92 819
3225 Thomas Hellenbeck 92-598-5542
6-17-87 845
3230 Charles E Vonnort 77-599-5311
3235 Evan Hankins .92-531-9443
12-1-88 770
3245 Gary Brock .83-593-7801
W E Wright .91-582-0182
3-3-87 920
3-18-87 870
6-25-93 980
3255 Michael Harvey .92-522-0840
3265 Michael Sullivan .92-535-9182
4-6-93 1079
3270 NP
3275 J W Himmelreich Jr .90-598-9712
3285 Thomas Lyman .92-528-4191
3290 Archie E Belford 75-598-3073
J Belford .75-598-3069
3295 NP
3305 M Boettger .92-528-0058
3310 Keith B Donley .92-593-9118
8-10-84 850
3320 N S Schiller .92-260-8710
3325 Wm H Henson .92-528-5361
11-6-90 935
3330 Daniel Kanzler .84-593-7981
7-6-80 770
3340 Tim C Campbell .88-593-0405
12-22-87 750
3380 Jack L Hudson .75-598-8290
NP
3370 NP
3380 Robert C Tesar .78-598-7591
3410 D Spurling .91-522-1028
11-2-89 1010
3415 Wm F Horton Jr 79-598-3698
3425 Rev Chas E Crosby 85-548-1374
8-18-88 885
3430 Joseph S Cabulecky .76-598-1178
NP
3435 NP
3440 Robert D Cooke .83-590-1837
3445 NP
3450 George Kirtkowsky 91-594-9529
6-4-80 1380
3460 11-12-91 1221
3463 NP
3470 Michael Vaughan 8

7421
Goldman ②

**CORTEZ SAC (FOUNTAIN)-IN A
CUL DE SAC EAST 1 BLK OT
FOUNTAIN MESA RD**

CTS

OM WOODMEN 95

IRSECTS

MS CORP govt
agv 599-3801

YONAL BANK
OAN-DIV

ICB INC
SELL

SYSTEMS

LEARNING

T ORDER OF
The Jewery

TE RECRUITERS &
CH 599-9400
MANAGEMENT CO
500.

ESS BROKERS
Jury 599-9000

FIKE S

CLAMS 500-5500

IFE & ACCIDENT
CO 599-5535

ICES INC ang
5-5511

7 F M radio sta

Shopping center

JULAR
5 Businesses

JUARE SIX
599-3955

11 Businesses

A DR -FROM 121-A

INTERSECTS

104

JUNTAIN
IAC EAST TO
A RD

17

② ③

② ③ 392-3226

② ③ 392-3030

CURRY res 392-7113

② ③ 392-7113

② ③ 392-5392

② ③ 392-3949

② ③ 392-5980

② ③ 392-5081

vic R & Virginia B ②

② ③ 392-3226

② ③ 392-3030

② ③ 392-3030

104

3925 Not Verified

3930 Erickson Dan E & Janice M ②

3935 Erickson Mark L 599-2050

3938 Erickson Timothy D 599-2050

3945 Erickson Kenneth C & Cathy L ②

599-7643

3948 Erickson Cathy L

3955 Mc Linn Warren E & Lucille ②

3958-5124

DEL PAZ DR INTERSECTS

3959 Ernest L ② ③ 599-5342

3110 Ward Roger & Kathryn ②

3115 Beatty James & Cheryl ②

3120 SCHNOR STAFFORD CONSTN

INC constn genl 545-1725

CORTINA PL INTERSECTS

3125 Not Verified

3135 Campbell Wm C Jr & Mary Beth ②

3145 Campbell Wm C Jr & Mary Beth ②

599-4952

3154 Larsen Phyllis ② ③ 599-5152

3155 Smith Terry M ② ③ 599-4390

Smith Linda D 599-4390

3160 Miller Michl D & Laura

3165 Cole Greg M Rev & Cheryl J ②

599-7073

Cole Sean 599-7073

3170 Taylor Richd L ② ③ 599-5170

3175 Jenkins Donald C & Linda J ② ③

581-6765

Jenkins Devin L 581-4765

3180 Vacant

3185 Not Verified

3190 Enger Bo C ② ③ 591-5733

3205 Moore Dan B & Medie C ② ③

3210 Not Verified

3215 Dixon Barbara

3220 Sheldon Keith & Tracy 599-5636

3225 MATTHEWS COMPUTER

CONSULTANTS 594-4047

Matthews Clark D & Cathy ②

594-4047

3230 Vancura Charles E ② ③ 599-4311

3235 Anderson D Edward & Tina C ②

596-3229

3245 Brock Gary & Jan ② ③ 598-7061

5955 Newcomer Bob L & Gina

595-4656

8 HOUSEHOLDS

COSMIC LIGHT DR -FROM
EVENING LIGHT CT SOUTHEAST
TO MISTOR DR

• ZIP CODE 59917

• EVENING LIGHT CT INTERSECTS

5945 Not Verified

5390 Rivers Lionel & Melissa ②

595-5559

6270 Randall Todd B ② ③ 590-0717

8 HOUSEHOLDS

COSTILLA ST E -FROM 400 S
CASCADA AV EAST

10 COOLIDGE PATRICIA G lwr

575-9012

• S TELON INTERSECTS

111 KING CHESE REE 594-3135

110 A-CENTRAL GROUP org-non
profit

115 GOOD-GRASS BIBLE CHURCH

115 H & M VACUUM SALES &
SERVICE 592-8557

119 CENT PRINTING COMPANY INC

printing ser 471-1845

121 CENT PRINTING COMPANY INC

(vacant)

122 ROSE'S KEYS 473-4355

125

• S NEVADA AV INTERSECTS

211 BARGAIN BOX cl-closed 475-1029

215 SCHOOL BELL cl-cd for needy sch
children 475-1029

220 DE LUXE CLEANERS & SHIRT
LAUNDRY 533-0019

227 PEEKS PEAK BINGO INC 535-3072

• WESPER INTERSECTS

313 THOMAS & THOMAS PLAN URBAN
DESIGN LINDCO ARCHT INC

design lndc archt 578-4777

315 BLUE FOX PHOTOGRAPHY photog
535-3435

317 COUNTY HUMAN RESOURCE DEPT

599-6208

319 PRINTERS PERSONNEL 592-0205

320 MIGLIAICHO DAVIDE C lwr

471-6300 JOHN R lwr 471-6300

TORRENT MICHL R lwr 471-6300

KIRCHNER JOHN E lwr 471-9300

SPEEDWAY GAS & OIL CO 471-9300

321 PRINTERS PERSONNEL (ADDL
SVC)

325 STAND BY PERSONNEL 530-1300

330 SARTER'S SHIPPING SHOPPE pkg &
ship 575-5554

• S WASHATCH AV INTERSECTS



473-3636

• DISPLAY PAGING
• TONE PAGING
460 Holly Sugar Bldg.

• ALPHANUMERIC PAGING
• 24 HOUR TELEMESSAGING



CORTINA CH

W 1971-1972

2100-2300 CT 48

3 Jim Thompson

3 Warren Schubert

10-22-91 1850

11-5-91 1850

3 Joe E Hoick

NP

3 J K Colwell

James O Stawan

Gregory O Nelson

Jeffrey D Watson

Ed Mitlage

Carl E Hedman

10-30-92 1175

Charles E Ireland

10-5-88 1250

Brian Chaffee

NP

15 RESIDENCE

NP

NP

COUCH PL

W of 17th Security

1700-1900 CT 41

1701 R Hart

1702 R Hart

1703 Joseph E Frost

1704 Richard Nowak

6-25-88 530

1710 V O Jones

8-17-85 550

1708 Joseph E Frost

1709 Richard Nowak

6-25-88 530

1713 Jeffrey Clark

1714 Edward Ruybalid

1801 Steve Reich

1802 Adolfo Zavala

NP

1800 Robert E Foster

1810 1813 1814

NP

1818 Joseph P Vigil

6-24-84 450

17 RESIDENCE

NP

NP

CORTINA DR -Contd

General Cleaning & Supply Inc chng
sup distr 599-3387
Kappstein Conrad G 599-3387
28706 Himmelfried Steve
28706 Himmelfried John W Jr 599-0712
28724 Ward Eleanor I
28726 Belford Archie E 599-3073
28726 De Ridder Thelma E 599-3073
28726 De Ridder Kathy K 599-7285
28726 Cochran Gerard D
28726 Schiller Nancy 599-7285
28726 Vacant
28726 Kandler Danl D 599-7961
28726 Vacant
28726 Campbell Timothy D 599-0406
28726 Hudson Irene R 599-0290
28726 ALENA DR INTERSECTS
28726 Coburn Larry 599-4686
28726 Fear Robt C
28726 CORTINA CR INTERSECTS
28726 Horton Wm F Jr 599-3698
28726 Schrey Chs E 548-1874
28726 Dubinsky Joseph S 599-1176
28726 Return
28726 Cooke Robt D 599-1837
28726 Vacant (2 Hse)
28726 Carricato Paul S
28726 Laughan Michl 591-6738
28726 INTRIDGE DR INTERSECTS

CORTINA PL - FROM 3130 CORTINA DR NORTH

28726 Vacant
28726 CODE 80918
28726 Vacant
28726 Mison Joseph A 598-0905
28726 Almerkenas Rudolph 593-5886
28726 Vandenberg Vince J 549-0734
28726 Schwankne Roger H 598-2752
28726 Harper Wm E 599-0890

CORT PL - FROM 2510 CORTINA DR WEST

28726 CODE 80915
28726 No Return
28726 Rinesmith Drake W 597-5820
28726 Mc Cormick Wm J 597-2411
28726 Martin Neilson M Jr 570-1047
28726 Donovan Paul W 574-8190
28726 Severin Mark A 574-5818
28726 Vacant (2 Hse)
28726 Rick Jeff D 597-5658
28726 Campbell Dennis E

COSMIC LIGHT DR - FROM EVENING LIGHT CT SOUTHEAST TO METEOR DR

28726 CODE 80917
28726 Debiols Mike L 380-0483
28726 Devora Lionel 596-6866
28726 Randall Todd B 560-0717

COSTILLA ST E - FROM 400 S CASCADE AV EAST

28726 CODE 80903
28726 Anderson Philip J Iwry 633-4873
28726 TJSON INTERSECTS
28726 King Chf rent 534-9135
28726 A-Central Group org-nn/profit
28726 G S Budget Baby Shop 635-8237
28726 H & M Vacuum Sales & Service
28726 383-9287
28726 Six Flags City outlet
28726 CODE 80918
28726 Jassal Taylor Cap 473-3047
28726 Colorado Springs Realty Inc 577-4544
28726 Vacant
28726 NEVADA AV INTERSECTS
28726 Bargain Box clo-outd 475-1029
28726 School Bell second hand store
28726 475-1029
28726 De Luxe Cleaners & Shirt Laundry
28726 633-6019
28726 Pacer Peak Bldg Inc 635-3072
28726 WEBER INTERSECTS
28726 PUEBLO INTERSECTS
28726 Thomas & Thomas landscape archs
28726 578-8777
28726 Insurance Shop-Empire Inc 635-3321
28726 Hickey Elizabeth T Iwry 471-9300
28726 Torbet John R Iwry 471-9300
28726 Bronsley Michl R Iwry 471-9300
28726 Stevenson John E Iwry 471-9300
28726 Kirchner John E Iwry 471-9300
28726 Renfrow J Royce Iwry 471-9300
28726 Speedway Gas & Oil Co 471-9300
28726 Empire Insurance Agency 635-3324
28726 Auto Quote Line auto ins
28726 Vacant
28726 Strah's Shipping Shoppe pkg & ship
28726 578-8654
28726 WAHSATCH AV INTERSECTS

Banfield's Brass Beds 577-0003**Ent Federal Credit Union 574-1100**

S EL PASO INTERSECTS
705 Vacant
711 Herrier Warren D Jr 520-0460
711 No Return
71144Crews C J
711 Apartments
A-B Vacant (2 Apts)
711 Bowmont Mini Warehouses 676-2288
720 Vacant
721 Full Gospel Church of God 362-6267
724 James Oceania 578-5455
726 Bowers David A 593-4528
728 Fitzgerald Star Service 634-7968
730 Fauchier Cecil E 593-3164
733 Office Building
734 Vacant
A-G Vacant (5 Hse)
734 Marriott Rose M Mrs 632-2277
737 No Return
740 Zenon Elous E 632-7542
743 Vacant
744 No Return
746-748 Vacant (2 Hse)
752 No Return
SOUTH PROSPECT INTERSECTS
801 Landry Peter T 635-1649
805 Carrithers Terry
807 Pollock L A 534-7161
809 Collins James G
812-813 Vacant (3 Hse)
815Cormann Daphne A 565-1901
815 Santos Delores A
817 Myers James E
820 Griffin Paul A 633-0346
823 Mc Donald Dorothy G M
830-8162
832M Vacant
834 Copple J L 635-9019
836 Van Dyke Roberta P 636-3626
837 Vacant
838 Haden Sheldon
831 Moore Manuel
832CJackson Karen A
834 Pencil Adelle R 632-5748
838 Shumway Steven
839CNewman John
840 Hillard Albert J
841 Buchmann Frances M Mrs
850-4194
847 Mc Gue Sairn P 473-4779
S INSTITUTE INTERSECTS
902 Rogers Bernice A 632-3887
905 Maxwell Fred H 471-1310
906CSegura Lisa A
909C Rene Rene 635-3826
912 Vonner O B 632-5885
914 Hamilton
915 D J S Carpentry Service 475-7867
Sturtevant Donald 475-7867
917 Vacant
920CLogan Lula D 475-7859
921-924 Vacant (2 Hse)
925 Gomez Salvador L
927CMarines Cora F 634-8210
931 Gomez Daria 630-9290
932 Smith Janet C
933 Salazar Joe S 634-5036
933CRodriguez John
934C Morton Jay H
934A Humphill Darryl P
937 Gentile J L 471-7815
938Waddell Clifford D 633-7666
941 Seridit Mary K 635-6095
942Lewis Wm G Jr 632-2452
944Davis Victor H 475-8582
946 Hanson Jerry
947 Vacant
950 Martin Carl R 635-1673
S CEDAR INTERSECTS
1002 Vacant
1005 Mc Whorter Beatrice M 634-5406
1006 Gonzalez Terence P 578-5740
1013 Vacant
1017 Lara Susie N Mrs 620-0829
1019 Davis Cordia K
1020 Smith Arnold H 632-2429
1023 Mc Cormick Don E 635-6290
1044 Dennis Rodney
1028-1038 Vacant (2 Hse)
1034 Gutierrez Lopez M
S HANCOCK AV INTERSECTS
ZIP CODE 80910

COSTILLA ST W - FROM 400 S CASCADE AV SOUTH

ZIP CODE 80903
12 Door Stop the 634-1567
14 Vaholtz & Anderson P C Iwrys
632-1145
21 Thompson Investigations 677-4677
22 Gray The 700-702
22 Lay Depot Ltd sells glass products
630-8668
30 Capco 8773
Summit Brick Co brick als & constn
633-8723
SAHWATCH INTERSECTS
22 101 Colorado Springs Regl Bldg Dept
(Site Dept) 578-6610

132 Crissey Fowler Lumber (Sigs & Dispatch Ofc)

S SIERRA MADRE INTERSECTS
RR TRACKS CROSS
CONJOS INTERSECTS
306 Chadsborn Spanish Mission
(conference rm)
311 Dolansky Steph E 633-9915
312 Apartments
312C Vacant
312C Vacant (2 Apts)
316 Gonzales Richd 634-7085
324 Harley A P Sales Co serv sta vac
& tires 635-1187
328 Beaver Log Mills genl contrs 631-0911
332 Sides General Inc 475-9311
MONUMENT CREEK INTERSECTS
S 8TH INTERSECTS
ZIP CODE 80905
S 9TH INTERSECTS
191 Stiefel's cab makers 634-2340
S 10TH INTERSECTS
1019 Lislston Wm E 471-1288
S 11TH INTERSECTS
1210 Cain Byron 473-1356
1216 Monkrus A R 634-8589
1223 Station Dale R 632-4449
S CHEROKEE ST INTERSECTS
1304 Mullin Jas J 632-4762
1310 Scaurto Wayne J 633-5683

COTTAGE DR - FROM APRIL DR EAST

ZIP CODE 80920
CHARITY DR INTERSECTS
QUAIL GLEN DR INTERSECTS
ALPINE VALLEY DR INTERSECTS
BELLCOONE CR INTERSECTS
RANGWOOD DR INTERSECTS
ZURICH DR INTERSECTS
3801 Laberge Mary 282-0510
3803CKinney Dwight E 282-1904
3825C Murphy K T 282-2116
3833 Walter Michl 282-0512
3841C Patton Anthony 282-0920
3801 Herrington Clarence O 282-1370
3805Wille Johnnie H Jr 222-1815

COTTONWOOD DR (SECURITY VILLAGE) - FROM 1300 WIDEFIELD DR (SV) EAST

ZIP CODE 80911
504Barnett Mary I
505 Spencer R
508 Pacheco Saml F 392-7240
509CManuel Maria
512 Gonzales Armando
513 Withey Michl J 391-1666
516 Wickham Virgil C 392-7739
517 Kolozy Frank
520 Medina Zella A 392-2842
521 Carter Pearl J Mrs 392-3582
524McConaughay James E 391-0021
525C Kruger Charles
EVERGREEN DR INTERSECTS

COTTONWOOD GROVE DR (SECURITY VILLAGE)

ZIP CODE 80925
6635CBagall Christopher D 390-3366
6640McCallum David W 391-0533
DUTCH ELM INTERSECTS

COUCH CR (SECURITY VILLAGE) FROM 1801 COUCH PL WEST

ZIP CODE 80911
702Walter Ruth L 392-5545
703CConway Kevin H
1706 Frost Joseph E 390-0977
1709 Pfaff De
1710 Jones Vernon O 391-1123
1713C Kufroth Roxanne M 390-0265
1714 Raybold Edw M 392-5493
1801 Relich Steve 390-6114
1805 Zavala Adolfo 392-6568
COUCH CIRCLE INTERSECTS
1806 O'Donnell James 392-5034
1806 Foster Robt E 390-4967
1810 Chapp Roy C
1813C Giberson Rhonda K

COUCH PL (SECURITY VILLAGE) FROM HALLAM AV SOUTH TO SUMAC DR

ZIP CODE 80911
1702Walter Ruth L 392-5545
1703CConway Kevin H
1706 Frost Joseph E 390-0977
1709 Pfaff De
1710 Jones Vernon O 391-1123
1713C Kufroth Roxanne M 390-0265
1714 Raybold Edw M 392-5493
1801 Relich Steve 390-6114
1805 Zavala Adolfo 392-6568
COUCH CIRCLE INTERSECTS
1806 O'Donnell James 392-5034
1806 Foster Robt E 390-4967
1810 Chapp Roy C
1813C Giberson Rhonda K

COUNTY PORTALES DR - FROM THE 700 BLK OF PENROSE BLVD

ZIP CODE 80906
700 Broadmore Heights Townhouses
633-1151
701 Stonaker W Lawrence 633-4684
702 Jaramillo Ed 632-8310
708 Head R L 634-8290
704 Loy Lorán D 633-0772
706 Hagger Ed 632-8167
707 Kelly Leonard P 473-1328
708 Ryker Hugh F 632-7280
709 Wilhelm Richard W 632-4498
710 Becker Ed 385-0551
711 Smith B I 632-9948
712 Rocks Gary K 633-2227
715 Hawkins Earl G 632-1453
716 Annaler Garlud L 634-0580
716C Long Robt W 473-8755
716C Russel Whithers 633-5656
717 Macaw H O 473-1712
719 Lockwood Ed G 633-6223
719 Lewis Jas 473-1277
720Bennenger B
721C Gibson J Braden 634-4256
722 Trot Bernard L 634-2670
723C Holloway Reid F 473-9725
724 Brady Donald F 632-6356
725 Thomson Herbert E
726 Dimock Geo W 630-7445
727 Vacant
728C Penkhus Jerome C 633-7069
729 Bowman
730 Wader P L Mrs 634-5582
731 Morgan H 634-5814
732 Roden Ted G 630-1651
733Cebiane J
734 Vacant
736 Lewis Carla 473-2035
738 Berger Jas C 632-2160
739C Kansas M E 473-1485
739C Vacant
740 Blak Robt M 630-9909
742 Jeffery W
744 Lou Ordie 632-1764
746 La Mora Donald E 630-7511

COUNTRY BROOK CT - FROM NORTH OF OLD FARM CREEK

ZIP CODE 80917
4904 Edwards John M 597-7819
4910 Kramer Michael E 596-1085
4915 Skoug Steven K 574-0227
4909 Lane Edw C 570-9780
4926 Waltham Scott R 581-9740
4930 Vacant
4936 Briggs Myrl G 574-7054
4940 Carlas Richd A 597-5887
4945 Nelson Timothy E
4950 Kendrick James H 591-0196
4955 Stewart Shild H 500-0735
4960 Cockrell Clifford D 674-2839
4965 Morris Cheryl L 474-5750
4970C Brown Curtis W 390-0963
4975 Berry Brian E 597-1940
4980 Vacant
4985C Mark E 591-5842
4990 Heydulf Daniel L 591-2802
4996 Vacant

COUNTRY CLUB CIR - FROM 2812 N CIRCLE DR IN A CIRCLE ENDING AT COUNTRY CLUB PLACE

ZIP CODE 80909
2802 Alay Max P 635-0155
2806C Stone Carl F 632-8792
2806C Stone Carl F 632-8792
2807 Baumgardner W 471-8818
2808 Smith Berlie F 473-3359
2809C Thompson Robt D
2810 Hm Terry D 630-1425
2811 Curry Reginald 630-3989
2812 Kelley R D 633-9480
2813C Oransky Gordon C 471-3369
2814 Cordts John N 475-1242
2822 Return

2824 Meider Wayne P 473-4245

2825C Rimmer Denise 630-1549
2827 Vigney G Michl 473-8617
2828 Lovato Leroy
2829 Davidson James H 634-3114
2830C Anderson Sandra 471-1752
2831 Bruner Robt L 471-2586
2832 Frantz Wayne L 471-2683
2836 Werner Larry H 634-3655
2838 Wooten Robert L 630-1582
2844 Miller Russell W 630-5803
2845 Perry V E 630-5936
2843 Winnick B J 473-2092
2844 Charles J Stanley 633-9122
2846 Kipping J 634-3527
2846 Davis Wm E 475-9759
2847 Weber Jas J 638-7422
2848 Bunge John H 678-1675
2849C Trummel Allen L 634-1027
2850 No Return
2851 Alres Francis L 633-4801
2852C Nicholson Carl K 634-1366

SMITH BARNEY HARRIS UPHAM & CO.

TEL (719) 633-1793

ESTABLISHED 1873

1500 S. Tejon St., Suite 1000, Colorado Springs, CO 80903

Net'l WATS 1-800-225-1163

CO WATS TEL. 1-800-332-50

* NEW NEIGH

1500 ST E - FROM 400 S MADE AV EAST

1500 30903
Philip J Iwyr 633-4873
INTERSECTS
Chief restr 634-9135
1500
Budget Baby Shop 633-6237
Vacuum Sales & Service
1500
International Cuisine
Taylor cps 473-3047
Crest Appraisal 473-3048
1500 Springs Realty (Annex)
1500
1500 AV INTERSECTS
Box closed-used 476-1028
Bell second hand store
1500
Cleaners & Shirt Laundry
1500
Peak Single Inc 633-9072
INTERSECTS
Thomas landscape archts
1500
Dance Shop-2100 Co Inc 594-5100
Elizabeth T Iwyr 471-6800
John R Iwyr 471-6800
Michael R Iwyr 471-6800
Cony C Iwyr 471-6800
John E Iwyr 471-6800
Joy J Royce Iwyr 471-6800
Way Gas & Oil Co 471-6800
Insurance Agency 633-3324
Auto Line auto ins
Shipping Shoppe pkg & ship
1500
WATCH AV INTERSECTS
Brass Beds sla 577-0003
Mix Concrete Co 475-0700
Mix Duro Division (div
mix mix concrete co) 475-0700
Valerie

1500
Mix Concrete Co (Addl
1500
Springs Florist (Stge)
1500 Springs Wholesale Florist
632-4878
Colorado Federal Credit Union
1500
1500 INTERSECTS
Warren D Jr 530-5460
John V
1500
Mini Warehouses 630-0062
1500
Look Supply
1500
Oencia 678-5435
David A 633-4828
Mail Tax Service 634-7968
Mer-City E 633-3154
1500
Mini Warehouses 630-0062
1500
Harry E 632-2277
1500
Elous E 632-7542
Vince
1500
Joe A 634-0618
SPECT INTERSECTS
Foster T 633-1649
1500
C 634-7164

12 839 Shumway Steve D ●
840 Hillard Albert J ●
841 Buchmann Frances M Mrs ●
633-6184
847 Mc Guire Sand P 473-4779
S INSTITUTE INTERSECTS
902 Rogers Bernice A ● 632-3387
906 Maxwell Fredk R ● 471-1310
909 Weipert Robt B 634-4871
909A Rudolph
912 Vonner O B ● 633-8865
914 Hamilton Wm G ●
915 Sturtevant Donald ● 475-7887
917 Vacant
920 Casburn Cdc Facility alternative
home 632-6987
Casburn C Myrle Mrs ● 632-6387
921 No Return
924 Mercier Bonnie Lw 473-7842
928 Gomez Salvador L ●
927 Vacant
931W Clesneros Darla ● 520-9280
932W Burns John J ● 634-5036
933W Brewer Wm ●
934W Morton Jay H ●
934W Hemphill Darryl P 575-1877
937W Gentile J L 471-7815
938 Vacant
941 Sercini Mary K ● 633-6095
942 Vacant
945 Davis Victor H ● 475-8662
946W Hanson Jerry
947 Vacant
960 Martin Carl R ●
963W EDAR INTERSECTS
1002W Burns Robt W Iwyr 632-4009
1008 Mc Whorter Beatrice M ● 634-3406
1010 Gonzales Terry F 578-5470
1013 Vacant
1017 Davis Susan M Mrs ● 520-9829
1019 Davis Cordia K ●
1020 Smith Arnold H ● 632-2429
1028 Mc Cormick Don E 635-5280
1034W Denus Rodney
1035W Helms Earl 633-6640
22 1033 Vacant
1034W Gutierrez Louis M
S HANCOCK AV INTERSECTS
ZIP CODE 80910

COSTILLA ST W - FROM 400 S CASCADE AV SOUTH

ZIP CODE 80903
12 Vacant
14 Ashley Peter J Iwyr 475-7412
Holbert Robert M Iwyr 633-9422
Anderson Robt Iwyr 632-1146
Goldberg Douglas G Iwyr 632-8100
Shupp Gary Iwyr 634-4435
Vahosholtz & Anderson P C Iwyr
632-1145
Thompson Investigations 577-4677
20W Lay Thos 630-7002
22 Glass Depot Ltd sells glass prods
630-5668
30 Capco ceramic tile mfg 750-1919
Summitt Brick Co brick sla & constn
633-8723
SAHWATCH INTERSECTS
101 Colorado Springs City Regl Bldg Dept
(Elec Dept) 578-6810
Colorado Springs City Regl Bldg Dept
(Htg Section) 578-6813
Colorado Springs City Regl Bldg Dept
578-6802
Colorado Springs City Regl Bldg
(Plmb Dept) 471-5816
104 Crissey Fowler Lumber Co (Whee)
120 Crissey Fowler Bargain Barn
222 Tuxall Uniform Co 633-5134
120 Berwick Electric Co 632-7893
132 Crissey Fowler Lumber (Stge &
Dispatch Ofc)
S SIERRA MADRE INTERSECTS

RR TRACKS CROSS
CONJUG INTERSECTS
306 Chadsborn Spanish Mission conference
room
311 Dolanay Steph E ● 633-9615
312 Apartments
1 Vacant
2 Vacant

119

1019 Littleton Wm E ● 471-1288
S 11TH INTERSECTS
1210 Cain Byron 578-1566
1218W Monks A R ● 634-8086
1228 Stratton Dale ● 632-4449
S CHEROKEE ST INTERSECTS
1304 Mullin Jas ● 633-4762
1310 Sturtevant Wayne J ● 633-5683

COTTAGE DR - FROM APRIL DR EAST

ZIP CODE 80920
CHARITY DR INTERSECTS
QUAIL GLEN DR INTERSECTS
ALPINE VALLEY DR INTERSECTS
BELLONE CTR INTERSECTS
S WOODWOOD DR INTERSECTS
ZURICH DR INTERSECTS
3801W Alaberge Mary 282-0610
3833W Hatters Michl ● 282-0612
3601 Wellington Clarence D ● 282-1370

COTTONWOOD DR (SECURITY VILLAGE)-FROM 1800 WIDEFIELD DR (SV) EAST

ZIP CODE 80911
504W Woodrum Nancy 360-3840
506 Spencer R ●
508 Pacheco Saml F ● 362-7240
509W Romero Edward
512 Gonzales Armando ● 362-7431
518 Wihelm Michl J ● 362-7077
516 Wichman Virgil C ● 362-7750
517 Koloky Frank V ● 362-3194
520 Medina Felix A ● 362-2842
521 Carter Pearl J Mrs ● 362-3582
524W Williams Robert 360-0570
526 Vacant
EVERGREEN DR INTERSECTS
COTTONWOOD GROVE DR
(SECURITY VILLAGE)
6630 Vacant
DUTCH ELM BEGINS

COUCH CIR (SECURITY VILLAGE) FROM 1801 COUCH PL WEST

ZIP CODE 80911
72 Vacant
73 Scott Anna ●
76 Norton Craig F ● 362-4110
77 Holmes James ● 362-9156

COUCH PL (SECURITY VILLAGE) FROM HALLAM AV SOUTH TO SUNAC DR

ZIP CODE 80911
1701 Benson Wm A ● 362-8645
1702 Davis Thomas C 362-5556
1705 Chatter Iwyr 362-2845
1706 Frost Joseph E ● 360-0977
1709W Pfaff Dew
1710W Farnitz C ● 361-1123
1713 Mitchell Charles H 362-6721
1714 Rydberg Edw M ● 362-5493
1801W Relich Steve ● 360-6114
1806 Valdez Adolfo ● 362-0508
COUCH CHURCH INTERSECTS
1808 O'Donnell James ● 362-6034
1809 Foster Robt E ● 360-4087
1810 Chew Roy C 362-3287
1812W Coggoy B A 362-2583
1814 Armstrong Dennis H ●
1817 Colton Israel ● 362-3710
1818W Vigil Joe ● 360-8851
HALLAM PLACE INTERSECTS

9 COUGAR CT - EAST FROM BREEZE CUT

ZIP CODE 80918

COUNT POULETALES DR - FROM THE 700 BLK OF PENROSE BLVD

716 Cool Russell W ● 633-2650
717 Macaw H G ● 471-1713
718W Short E ● 473-8231
719 Lewis Jas ● 473-1277
720 Armstrong Arthur F 634-5099
721 Hays D ●
722 Trout Bernard L ● 634-2670
723W Jalek P ●
724 Brady Donald F ● 635-6066
726 Thomson Herbert E ●
728 Dimock Geo W ● 630-7443
727 Hayden J 471-9327
728 Flint
729 Bowman John E ●
730 Mader P L Mrs ● 634-5582
731 Morgan H 634-5814
732 Roden Ted G ● 630-1861
733 Echols Marshall Architect 632-6291
*Echols G Marshall 632-8291
734 Kramer M 633-9127
736 Lewis Carla ● 473-2026
738 Berger Jas C ● 633-2116
740 Lindstrom D ●
738 Bourgeois Lionel ● 632-1732
740 Blak Robt M 630-8009
742 Jeffers W
744 Loo Orrin ● 632-1764
746 La Mora Donald E ● 630-7511

COUNTRY BROOK CT - FROM NORTH OF OLD FARM CREEK

ZIP CODE 80917
4906 Estrada Ralph M ● 597-7819
4910 Kramer Michael E ● 596-1008
4915 Krong Steven K ● 574-0227
4916 Lane Edw ● 570-9780
4925 Wehrly Scott ● 572-2740
4940 Franklin Daniel B ● 574-6594
4936 Briggs Myrl G ● 574-7054
4940 Caras Richd A ● 597-5887
4944W Newton Timothy E 574-5579
4950 Benck Richard ● 591-9186
4955 Stewart Shirl H ● 590-0775
4960 Cockrell Clifford D ● 574-2830
4965 Morris Cheryl L ● 574-5759
4970 Rogers Paul A 591-0683
4971 Berry David L ● 597-1940
4980 Opler M ● 637-4936
4986 Vacant
4980 Heydauff Daniel L ● 591-2802
4995 Vacant

COUNTRY CLUB DR - FROM 2000 HOLIDAY LA NORTH

ZIP CODE 80909
2801 Fischer Thos C ● 471-1498
2802 Pittenger Sharon B ● 633-1838
2910 Bennett Hal 471-2305
2818 Fisher John E ● 473-2735
2817 Massaro Ava M ● 632-3799
2818 Basman Katherine C ● 632-938
2820 Foster Robt S ● 632-5454
2824 Adams Florence H ● 630-0570
2828 Jobs Henry E ● 632-4096
2830 Trigg O Gerald Rev 473-1879
2836 Hunter Fred D ● 638-1444
2838 Stigmar Darrell ● 632-5308
2842 Martin Ralph E ● 633-0068
2846 Russa Curtis H ● 634-2523
2848 Charlesworth Kenneth B ● 633-86
2853 Johnson Jas P ● 634-0121
GRANDVIEW INTERSECTS
2901 Poterter John J ● 632-3130
2908 Dickson Lon R ● 634-0369
2907 Norton Lon R ● 634-9926
2912 Cimino Mary E Mrs ● 632-0016
2913 Peake Donald S ●
2918 Hook Mark B Mrs ● 633-1448
2919 Murdoch F H ● 632-8392
2924 Mc Cotter Max E ● 634-5027
2925 Burkin Ivy J Mrs ● 473-1303
2930 Williams Lee ● 473-8980
2931 Benner
2936 Morris B Beatrice ● 634-4614
2937 Varney
2939 Eichner Myron A ● 475-8513
2940 Collins John E ● 473-2940
2947 Williams Robt E ● 632-4167
2948 Christensen C Lewis ● 633-9900