



**FLOOR PLAN** 41,686 S.F.

SCALE: 1/16" = 1'-0"

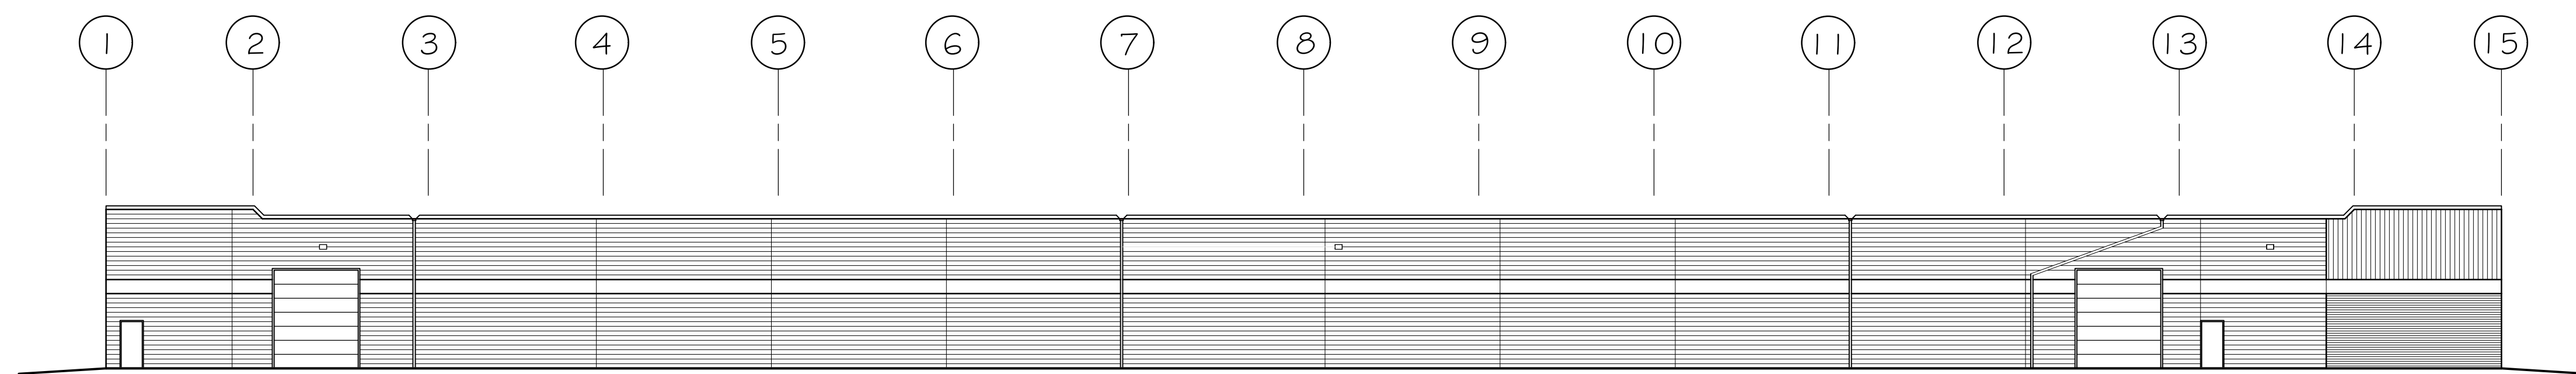


**WEST ELEVATION**

SCALE: 1/16" = 1'-0"

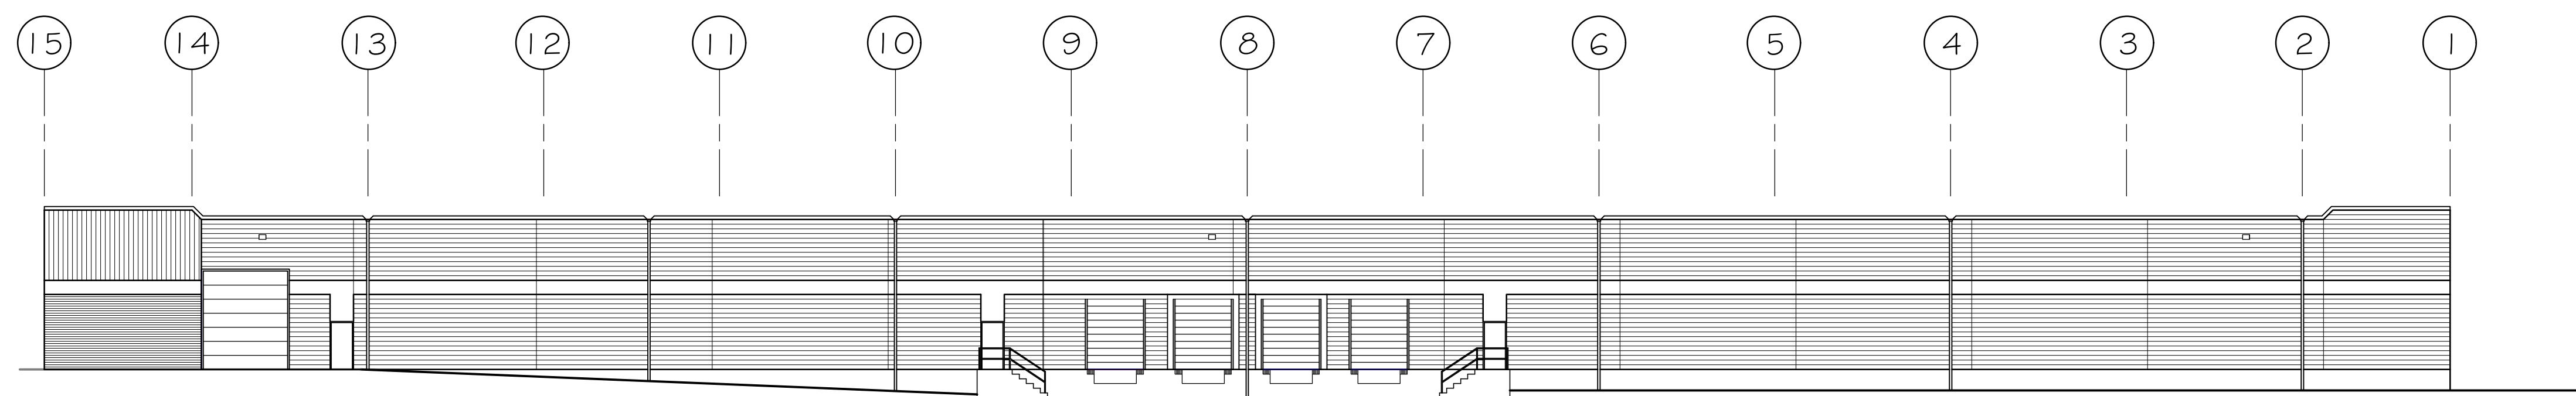


**EAST ELEVATION**

SCALE: 1/16" = 1'-0"

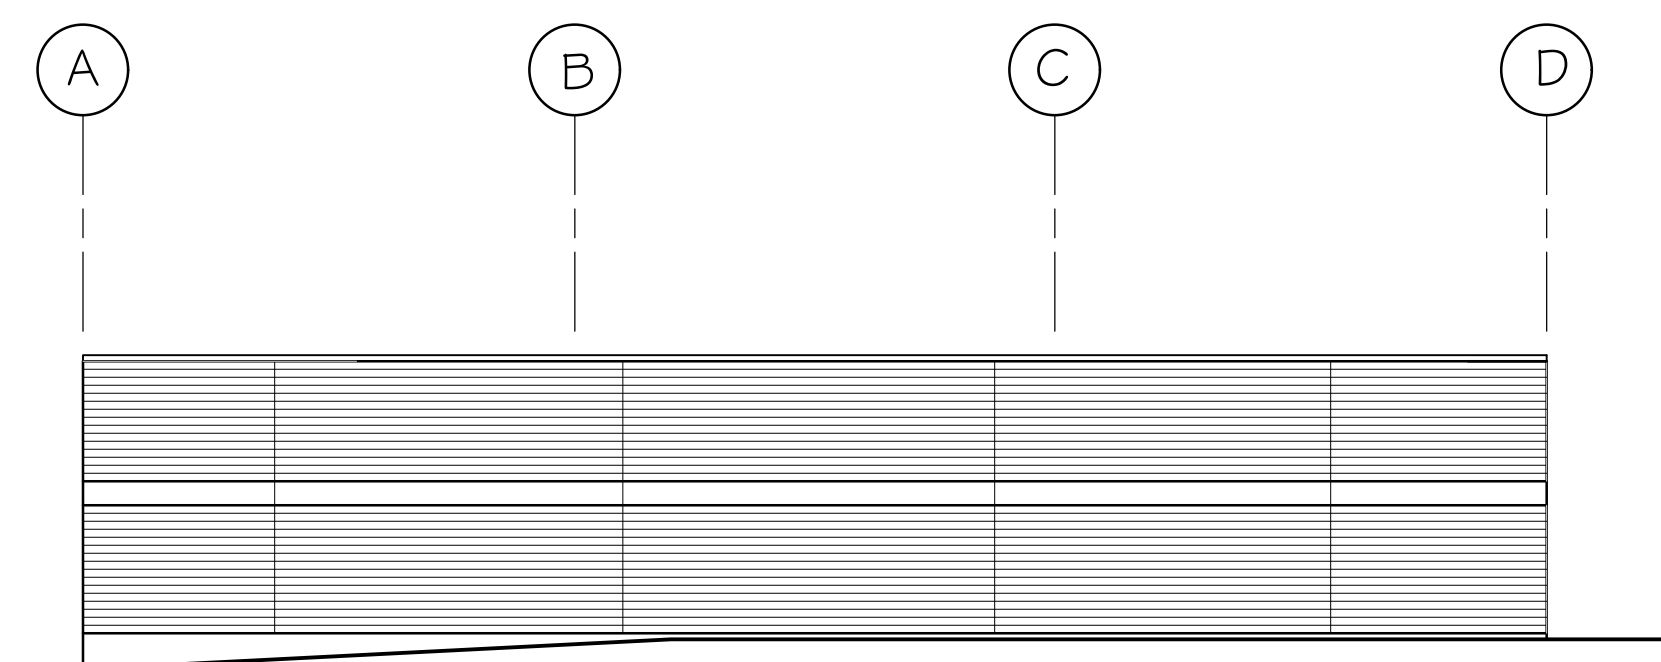


**NORTH ELEVATION**

SCALE: 1/16" = 1'-0"

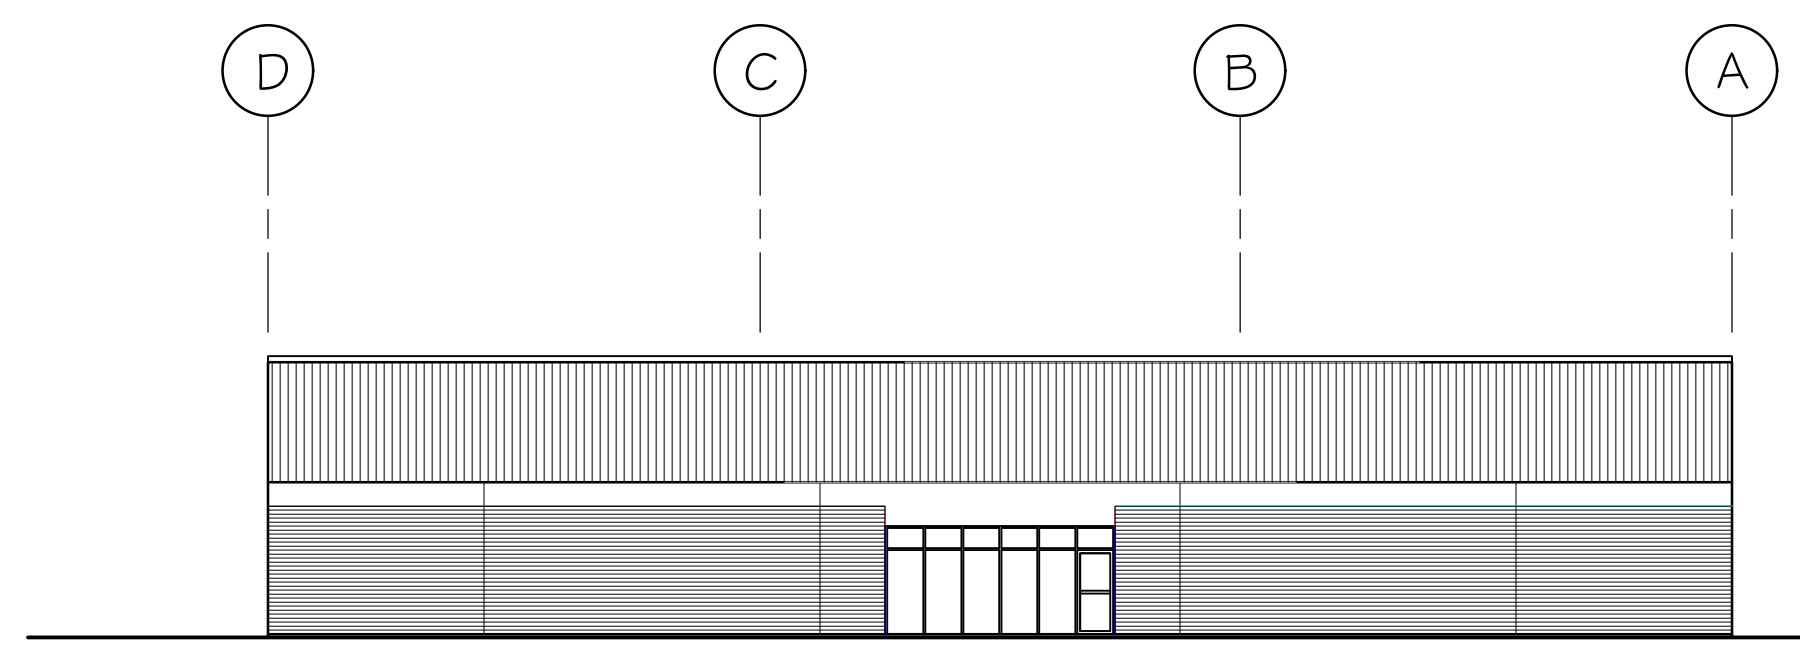

**SOUTH ELEVATION**

SCALE: 1/16" = 1'-0"

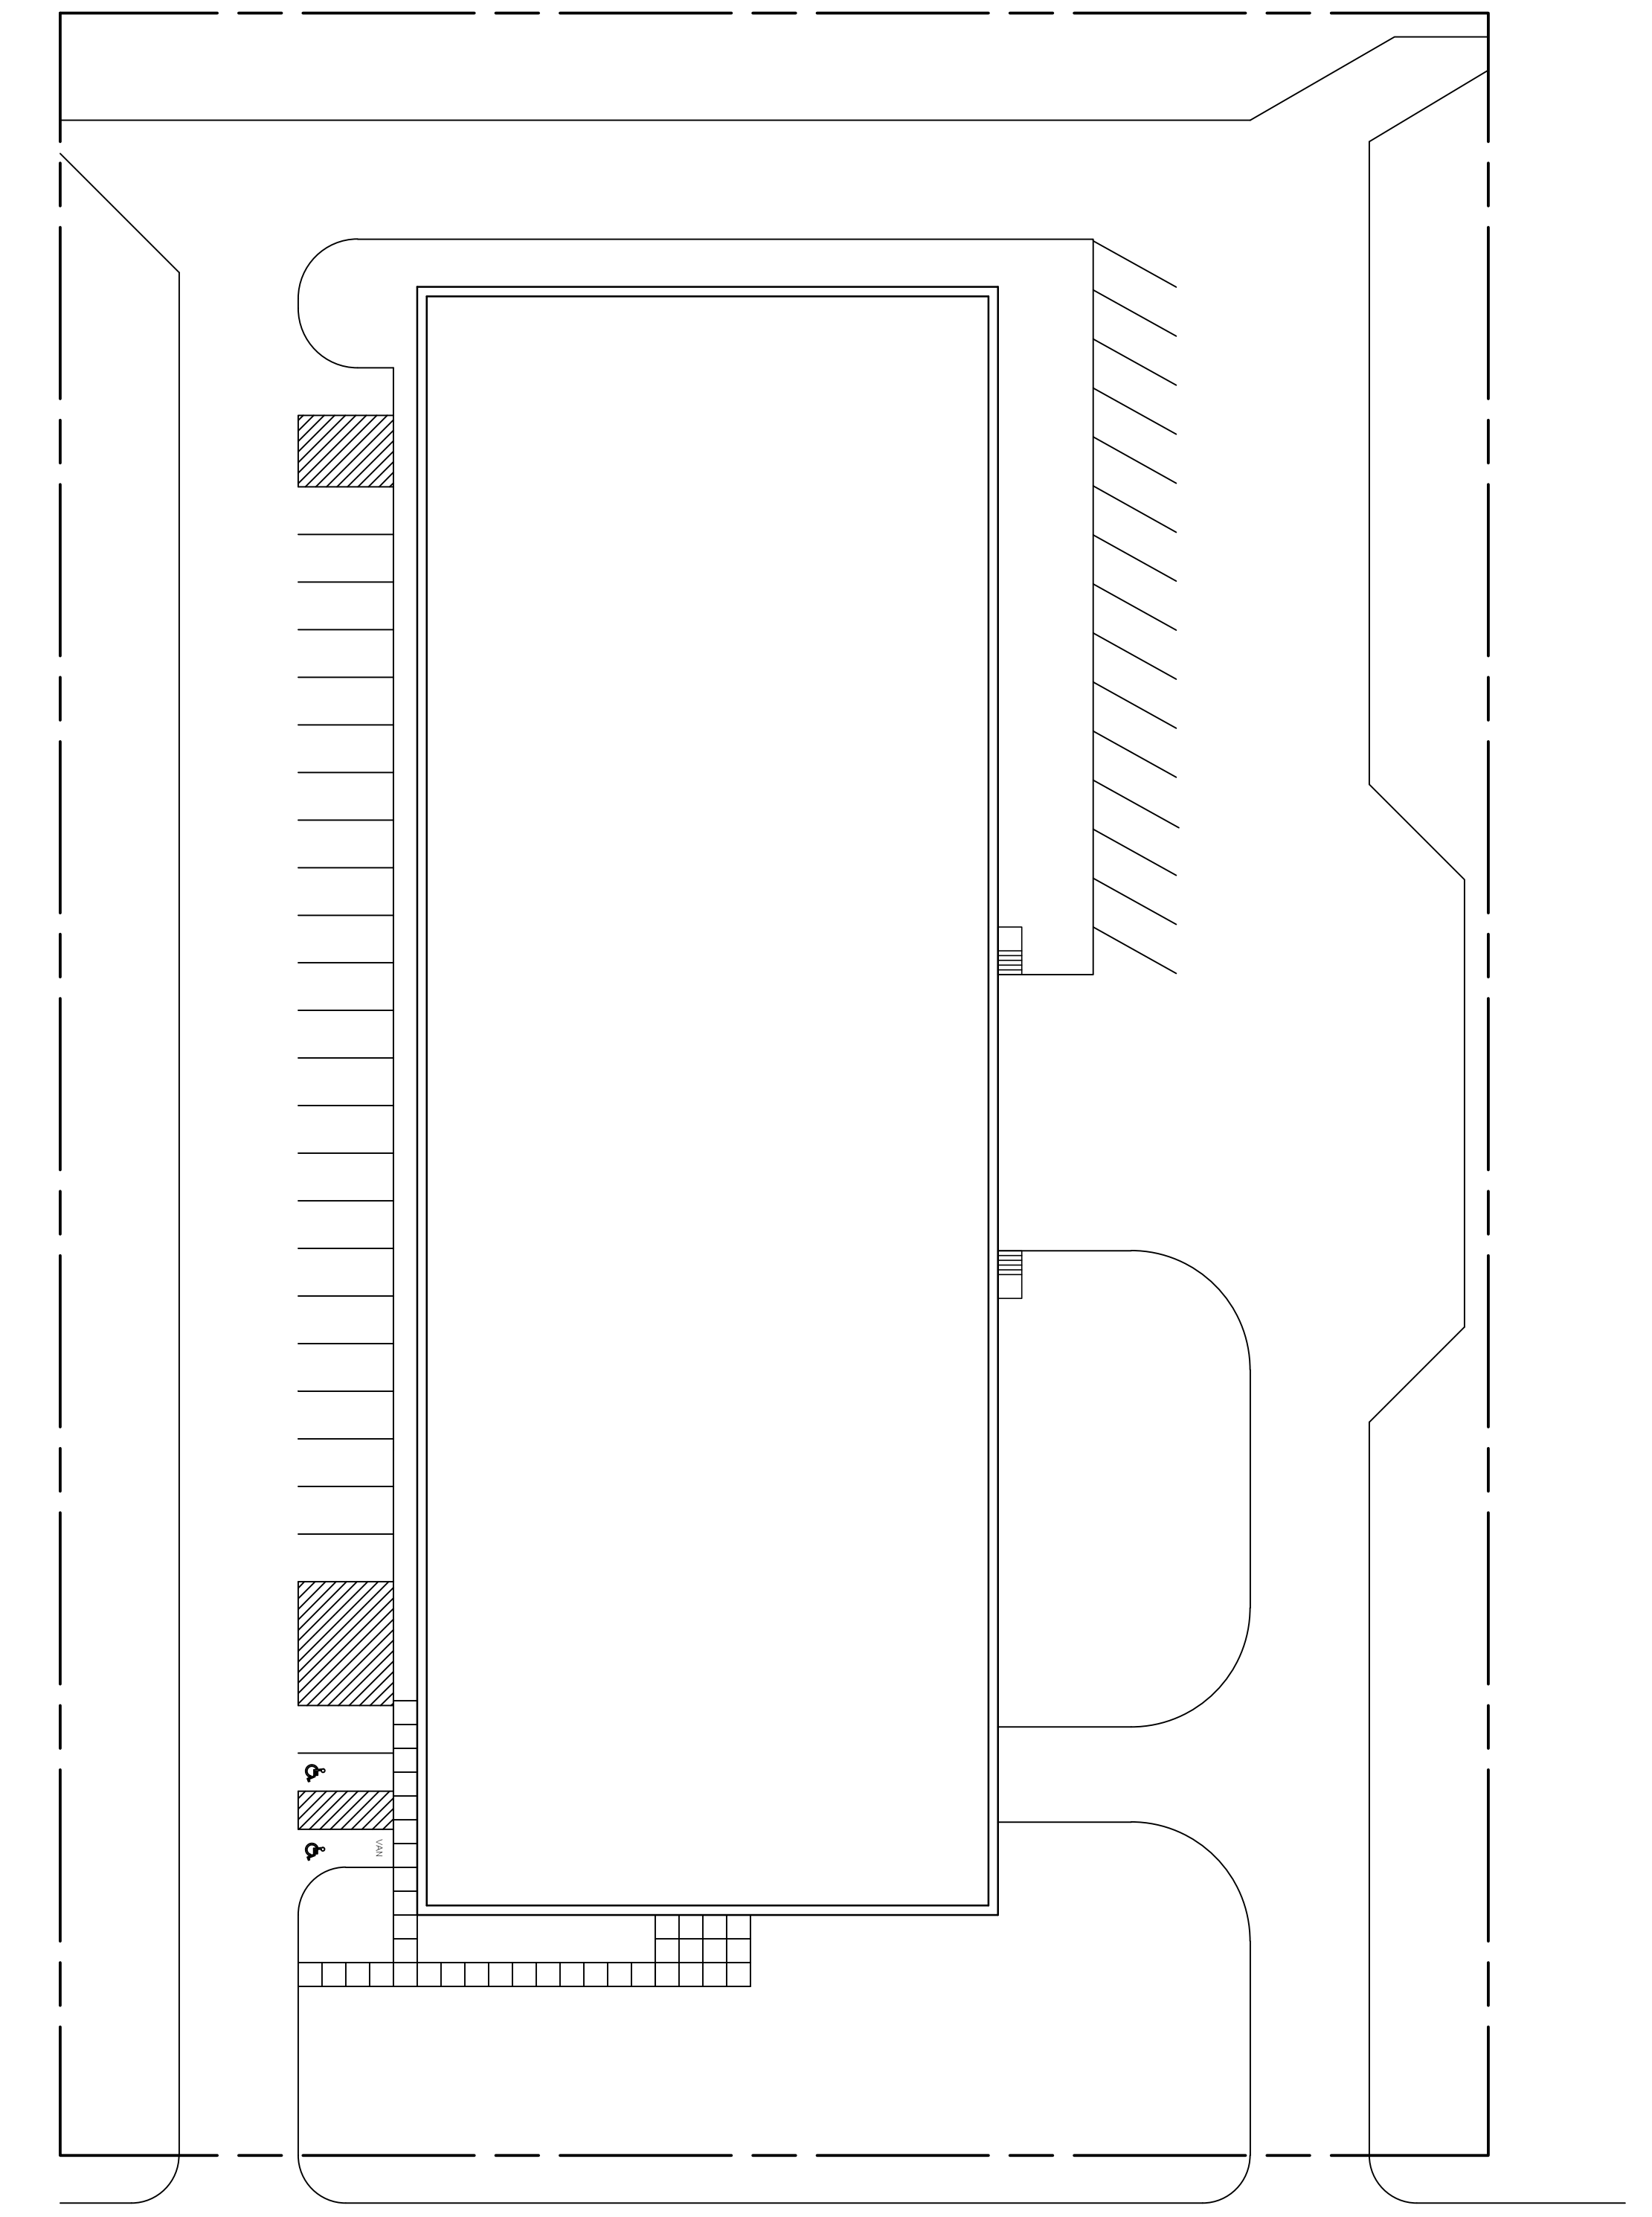

**PLOT PLAN**

SCALE: 1" = 30'-0"

<p><b>SUDLER</b> 245 GREEN VILLAGE ROAD CHATHAM, NEW JERSEY 07928 973-257-0700</p>	<p><b>CORPORATE PARK LAKEWOOD</b> 1705 OAK STREET LAKEWOOD, NEW JERSEY</p>	<p>PROJECT NO. 1705DAKLAK DRAWN BY: MGD SCALE: 1/16" = 1'-0" DATE: 10-09-2025</p>
	<p>MARKETING PLAN</p>	<p>MP-1</p>