
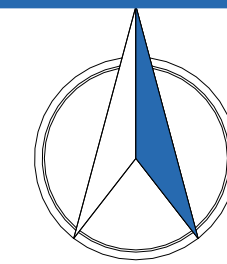


Property Key PARK

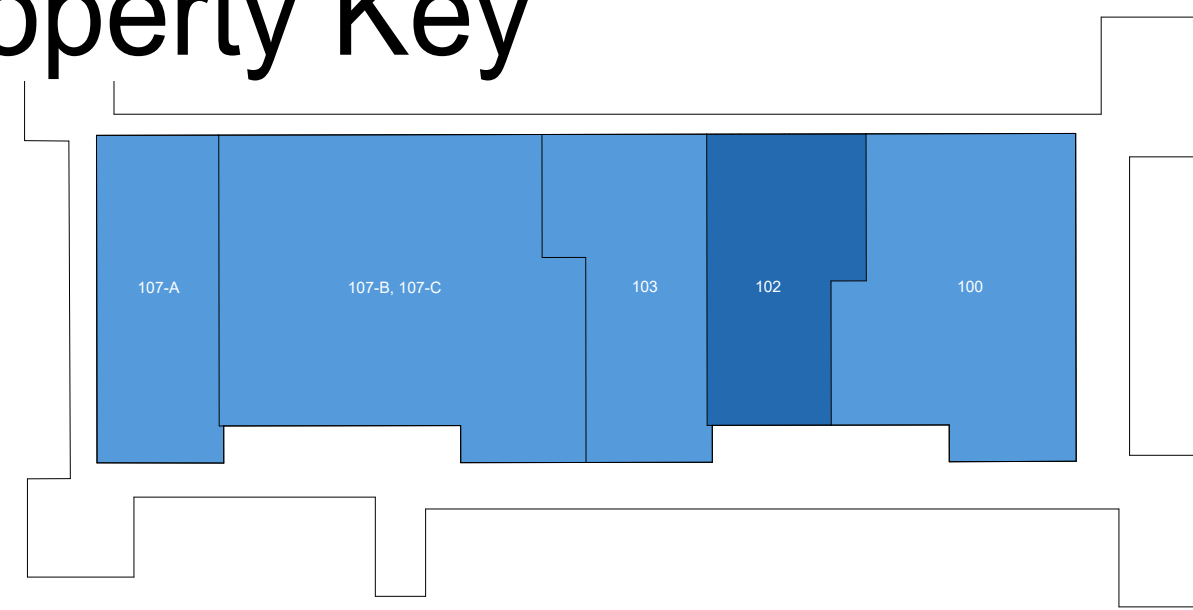


Southland As Built Marketing Package

7566 Southland Blvd, Orlando, FL 32809, US

Building: 7566

Suite: 102

Sheet **E1**

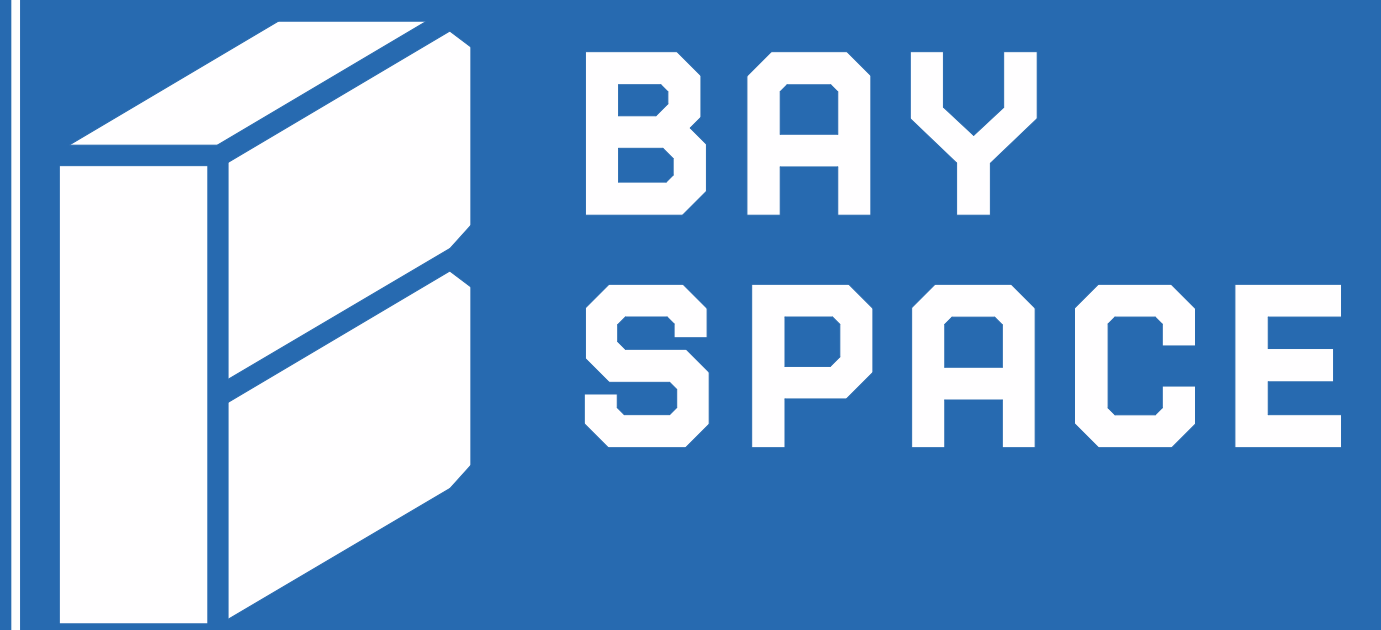


Scale: Not to Scale
Sheet Size: 42" x 30"
Not For Construction

Usable Square Foot Analysis

Office Area	2,167	100 %
Warehouse Area	0	0%
Total Area	2,167	

Building Information

Deck Height:	14' - 9"
Clear Height:	12' - 4 3/4"
Ceiling Height:	8' - 7 1/4"
Sprinklered:	<input type="checkbox"/> Yes <input checked="" type="checkbox"/> No
Mechanical Area:	0 SQFT

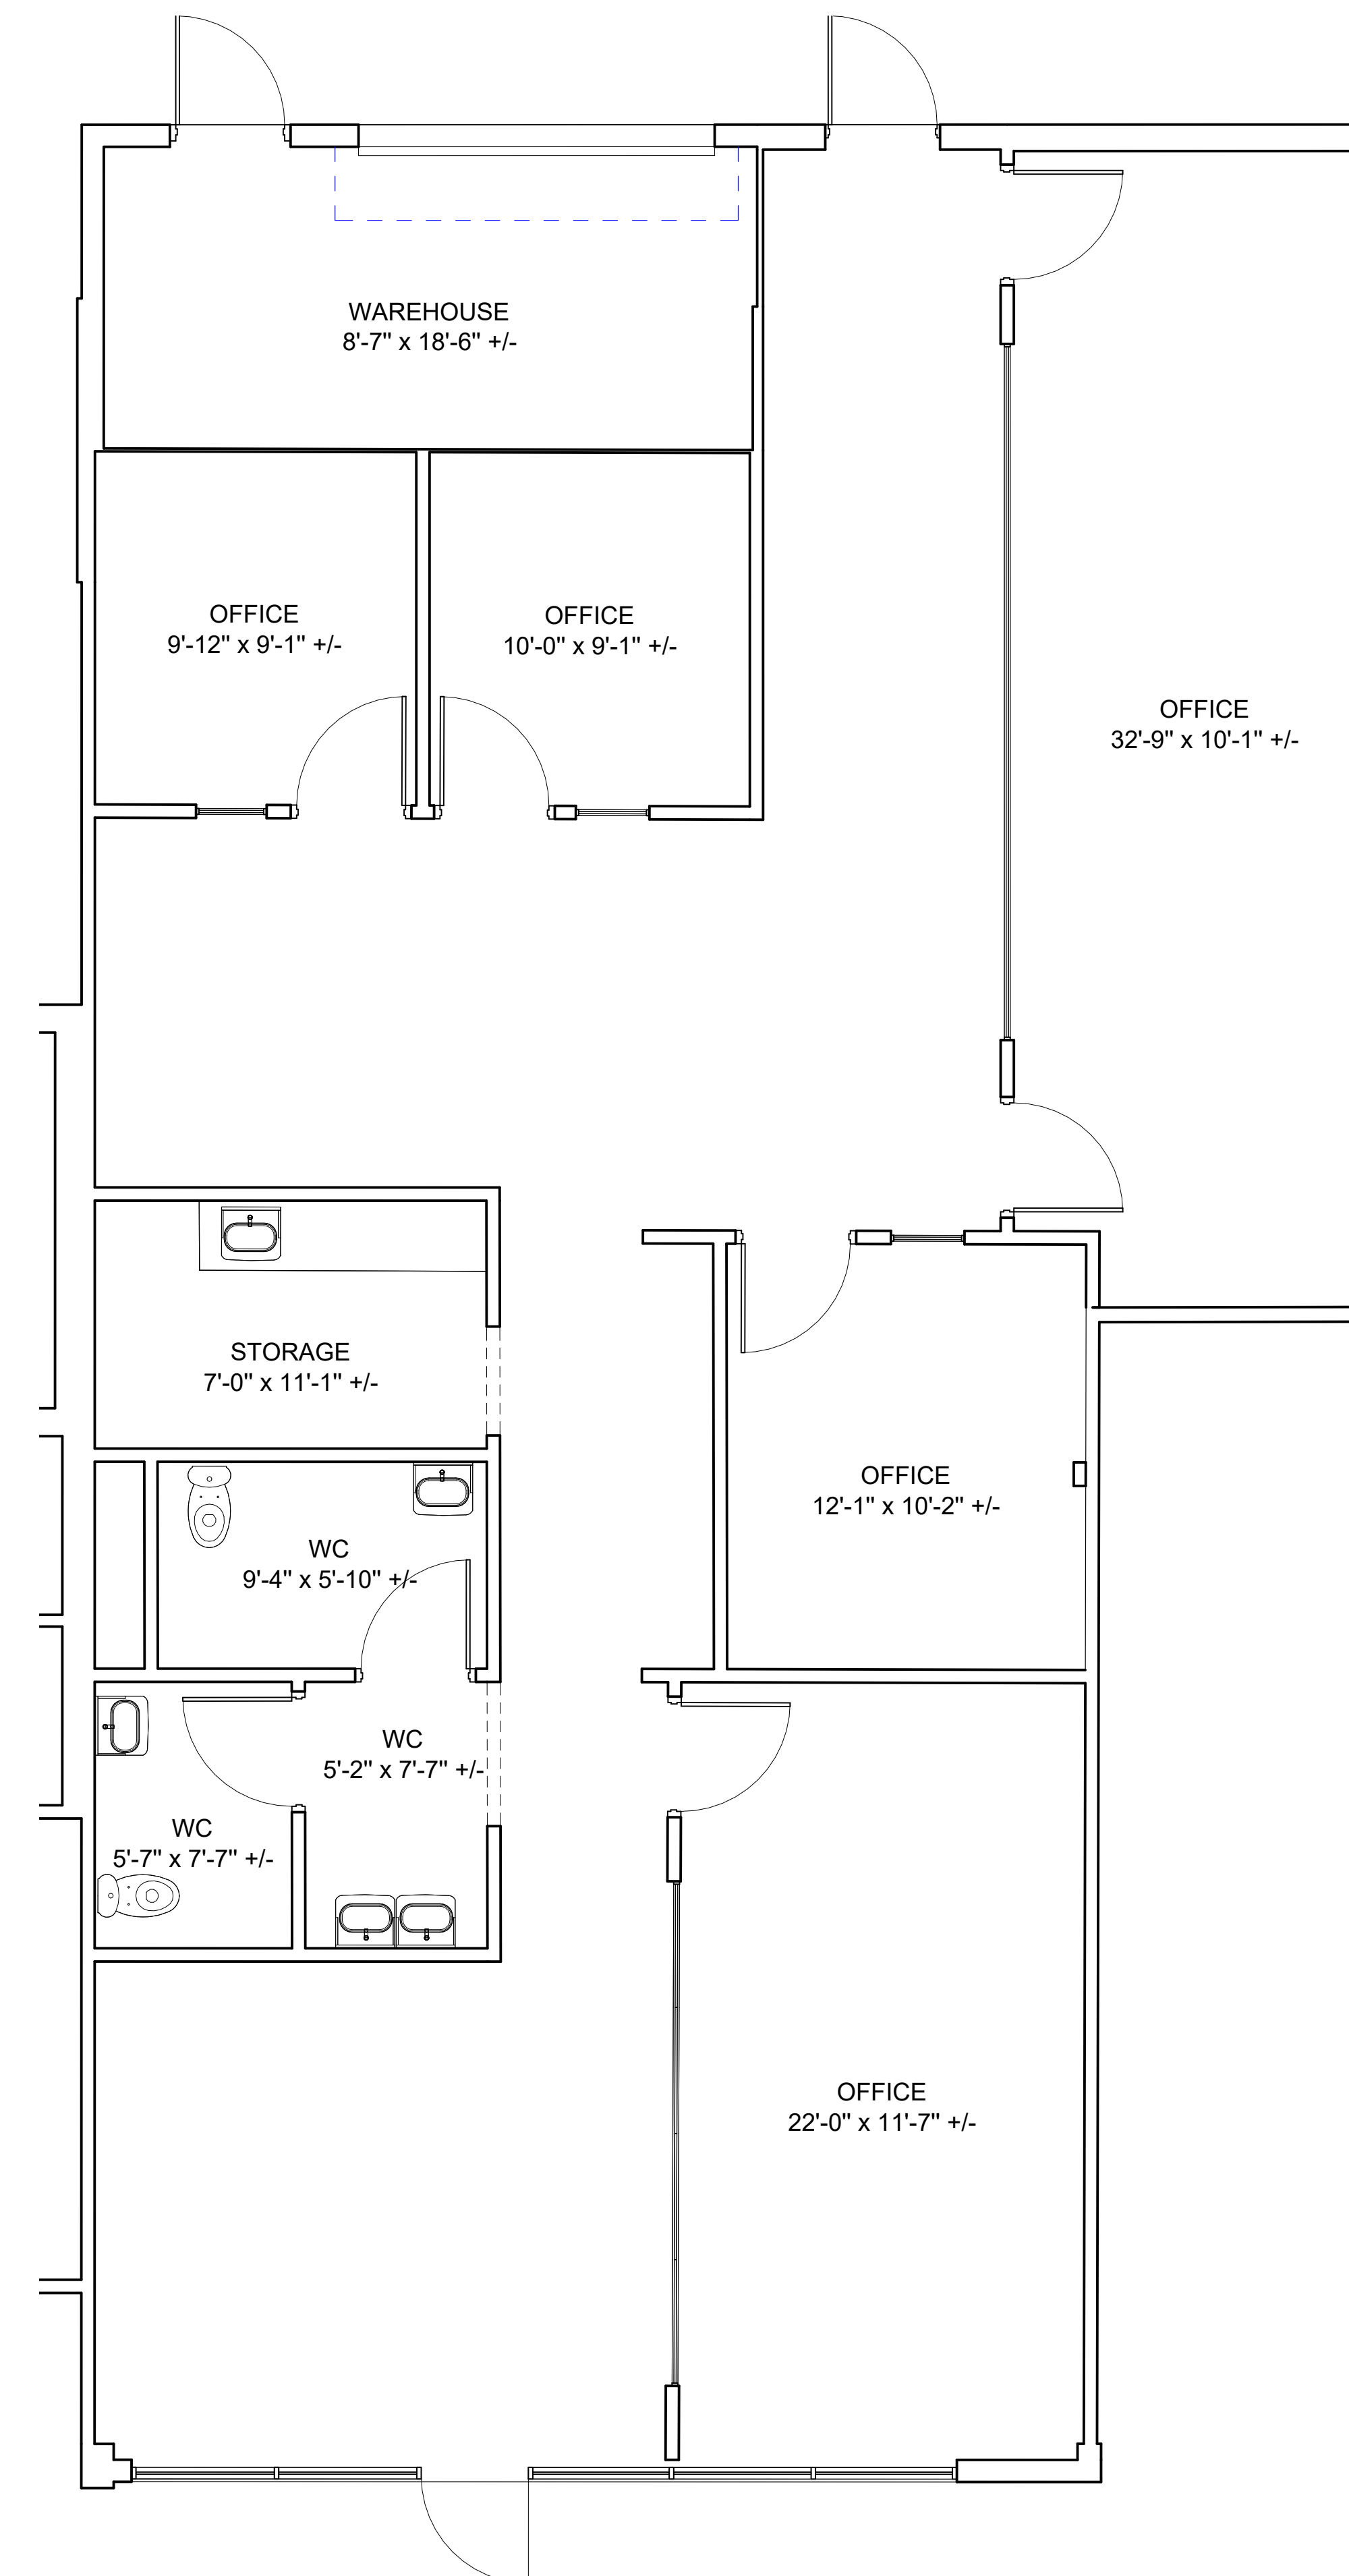

② 102
1 : 40

As Built Floor Plan for Marketing

