


GOLDEN EARS BUSINESS CENTRE


9525 201 STREET, LANGLEY, BC
OFFICE FOR LEASE | UNIT 300-309 AS-BUILT

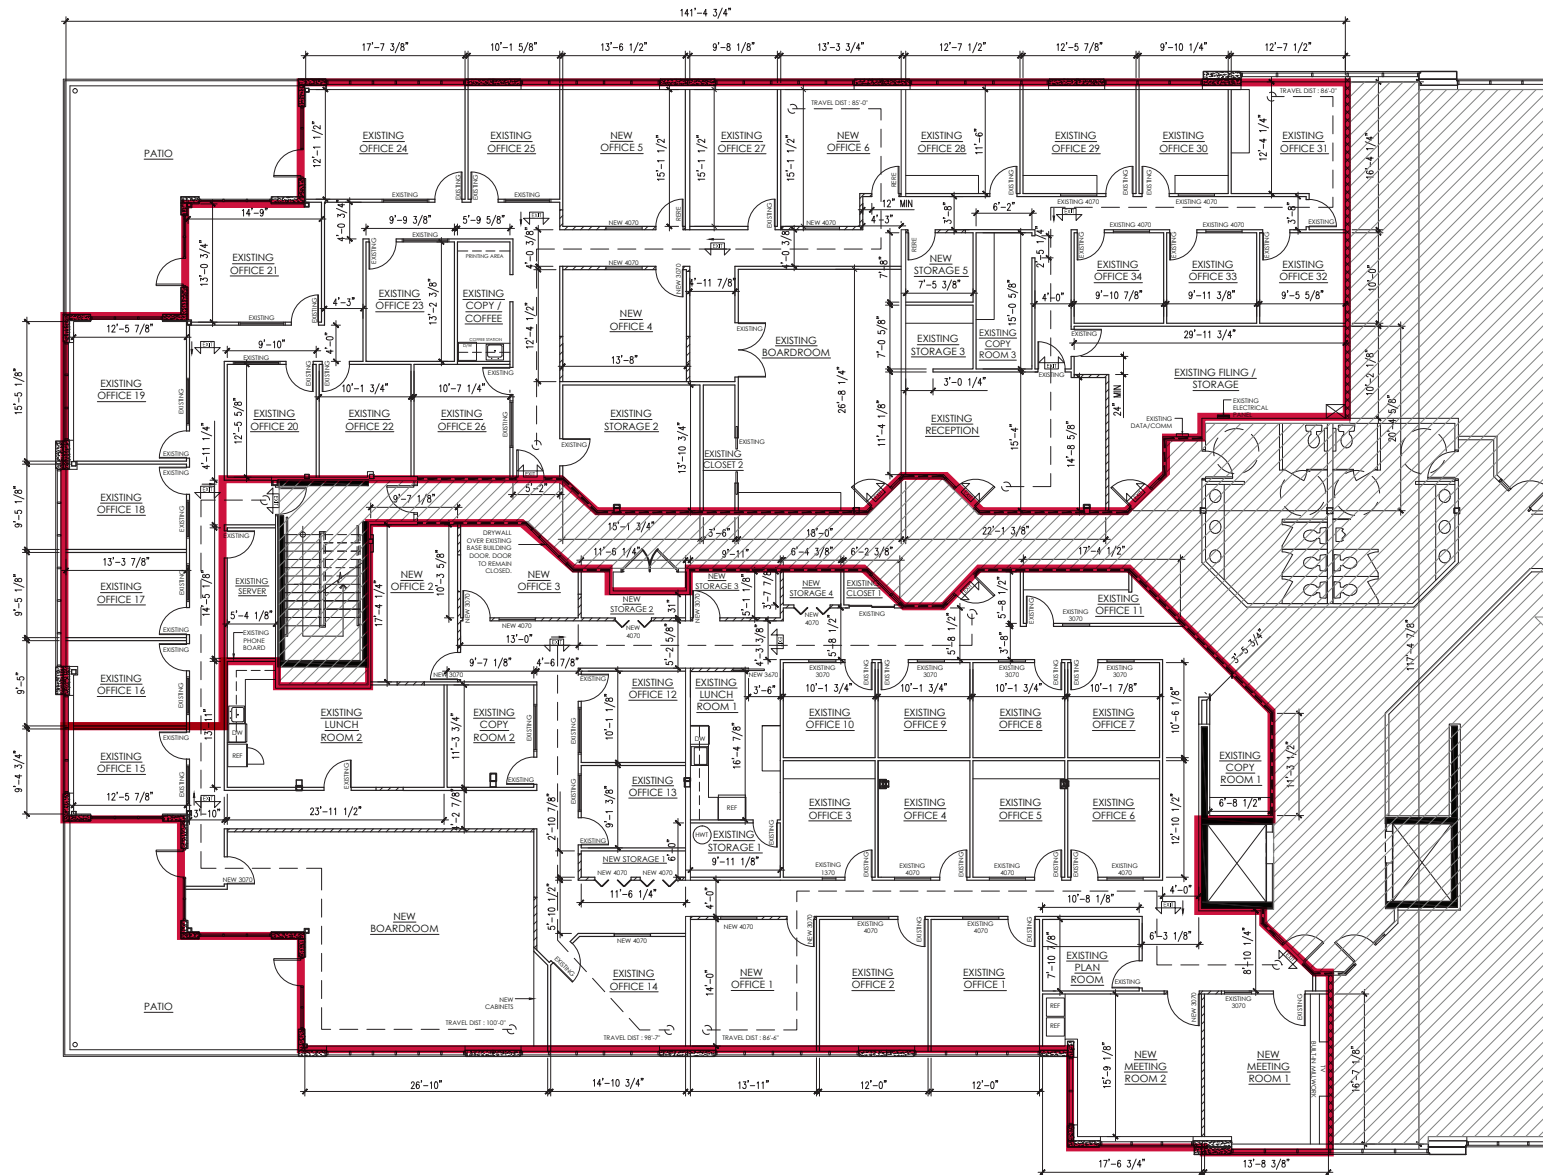

Disclaimer: Although the information contained within is from sources believed to be reliable, no warranty or representation is made as to its accuracy being subject to errors, omissions, conditions, prior lease, withdrawal or other changes without notice and same should not be relied upon without independent verification. 0312 © 2026 Lee & Associates Commercial Real Estate (BC) Ltd. All Rights Reserved.

GOLDEN EARS BUSINESS CENTRE

9525 201 STREET, LANGLEY, BC
OFFICE FOR LEASE | THIRD FLOOR PLAN

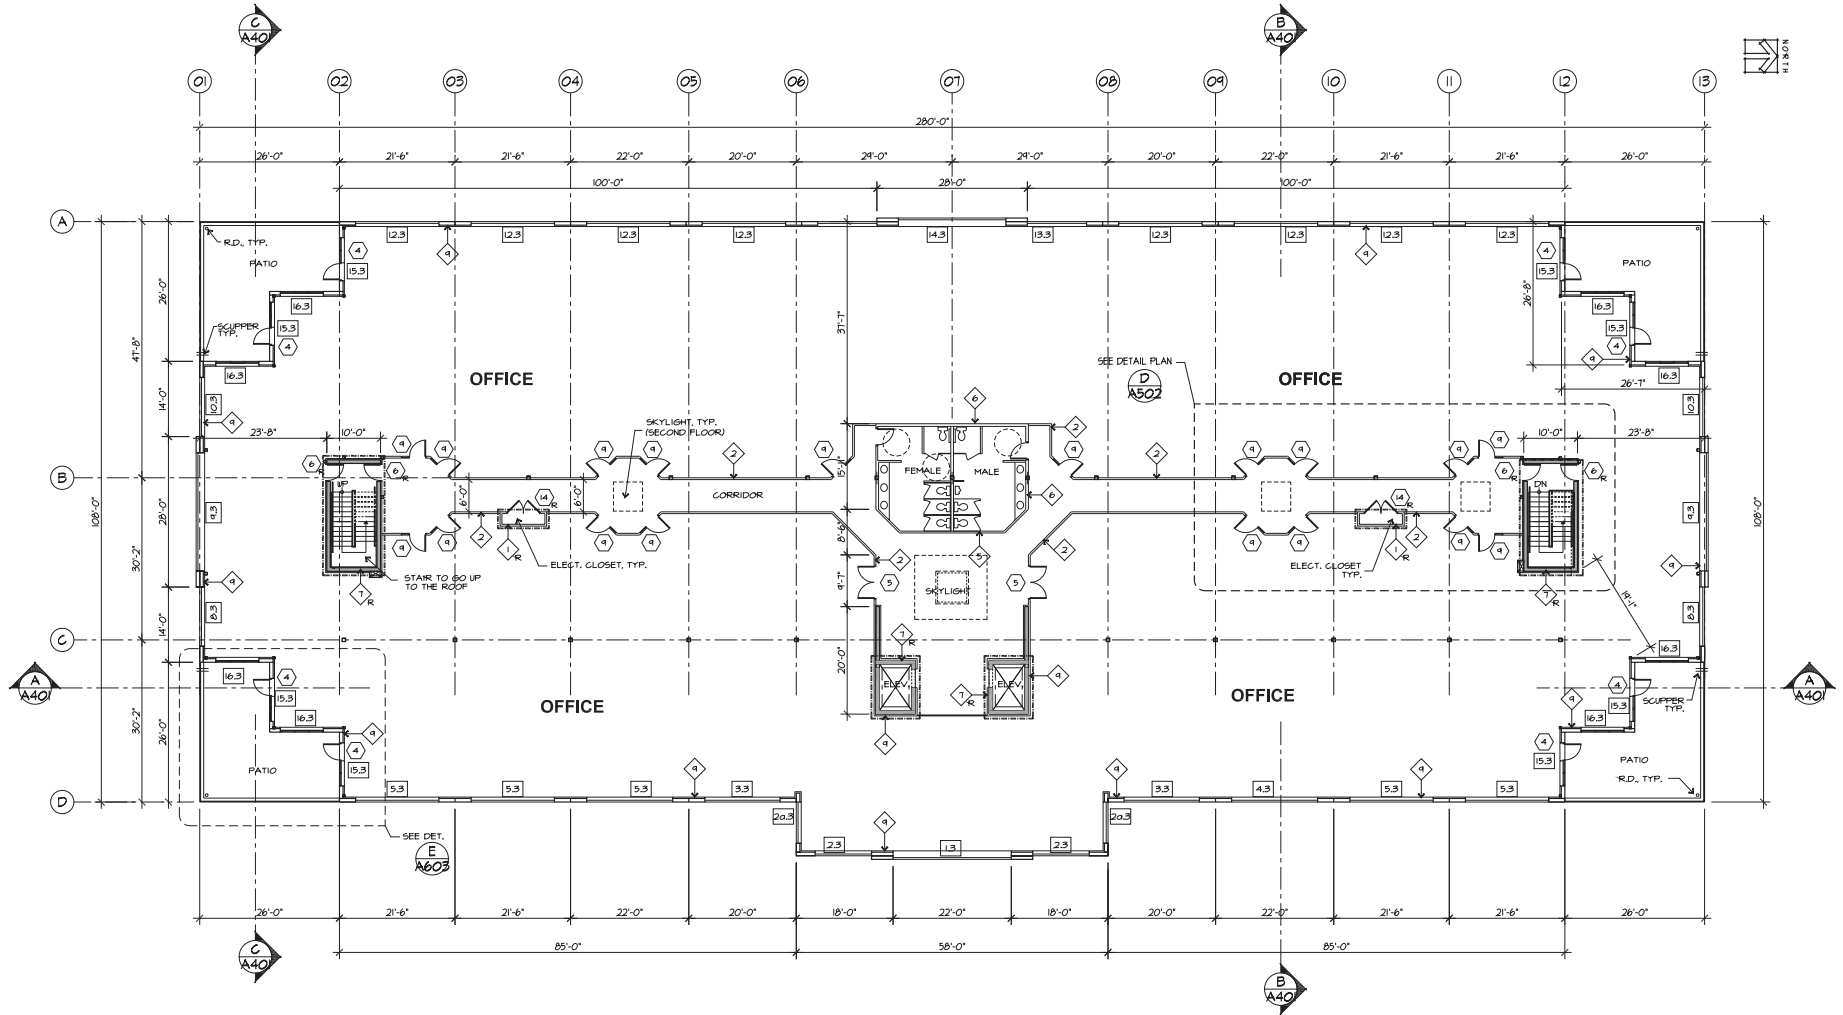

THIRD FLOOR PLAN

Scale 3/32"=1'-0" 28,640 SQ. FT.

Disclaimer: Although the information contained within is from sources believed to be reliable, no warranty or representation is made as to its accuracy being subject to errors, omissions, conditions, prior lease, withdrawal or other changes without notice and same should not be relied upon without independent verification. 0312 © 2026 Lee & Associates Commercial Real Estate (BC) Ltd. All Rights Reserved.