


Property Key

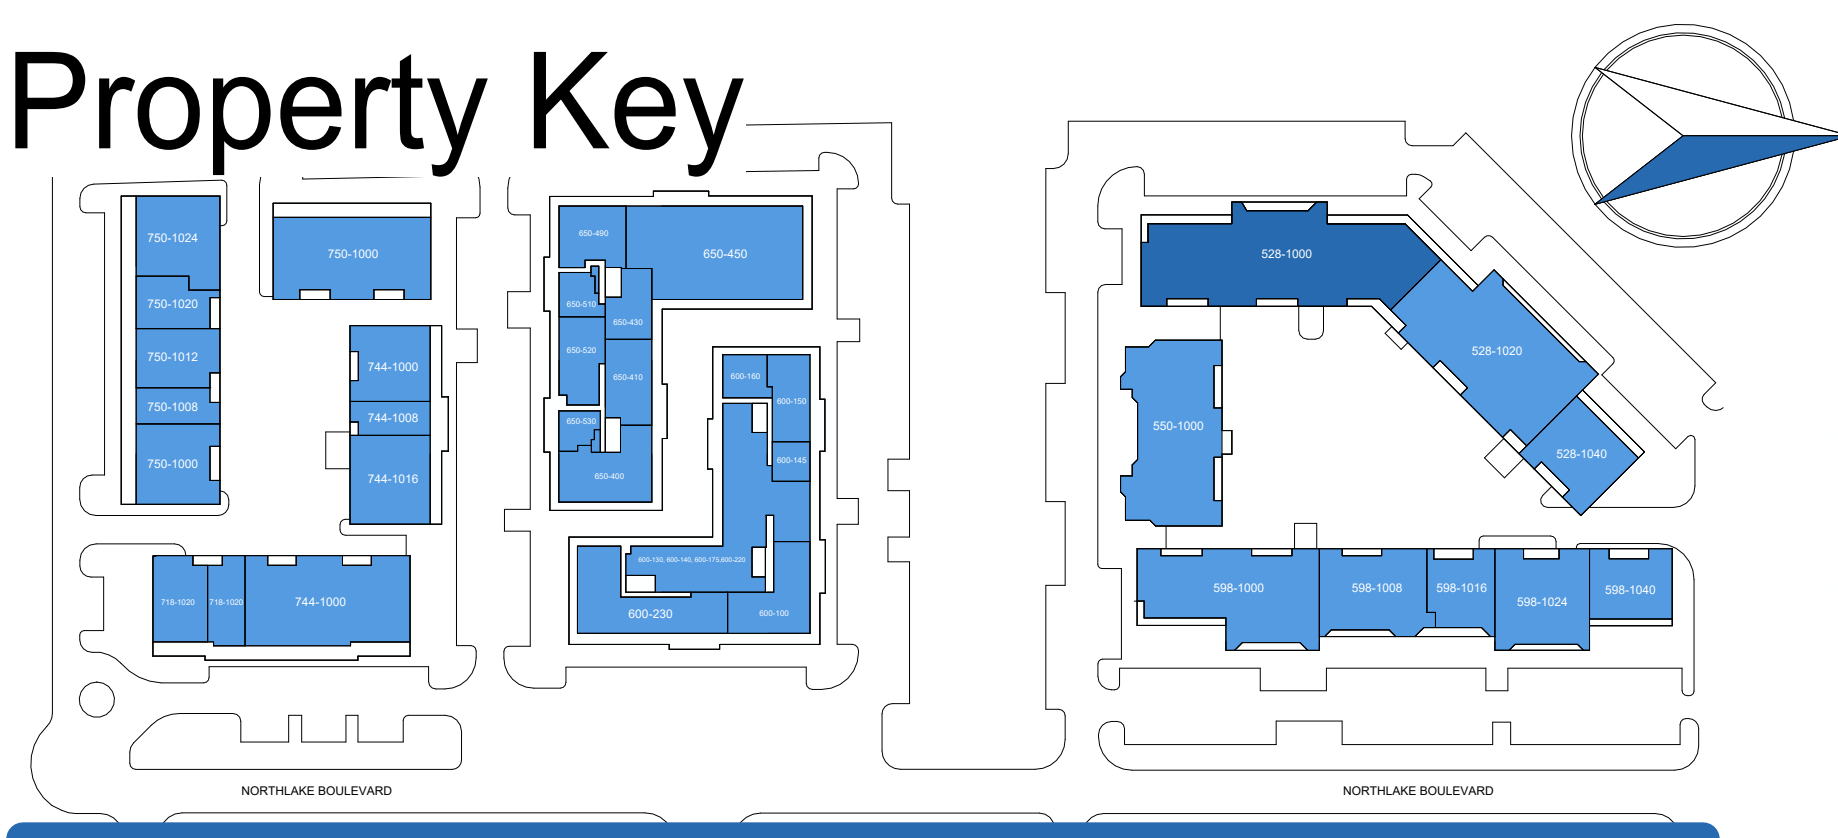

Alt Springs As Built Marketing Package


528 Northlake Blvd, Alt Springs, FL 32701, US

Building: 528

Suite: 1000

Sheet **E1**

Scale: Not to Scale
Sheet Size: 42" x 30"
Not For Construction

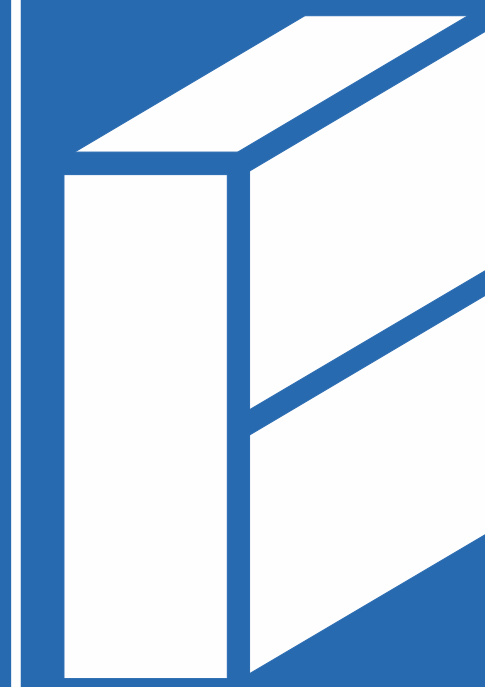

BAY SPACE

Usable Square Foot Analysis

Office Area	12,483	100%
Warehouse Area	25	0%
Total Area	12,508	

Building Information

Deck Height:	15' - 0"
Clear Height:	10' - 4"
Ceiling Height:	8' - 10"
Sprinklered:	<input checked="" type="checkbox"/> Yes <input type="checkbox"/> No
Mechanical Area:	180 SQFT

