


KEY PLAN: NOT TO SCALE

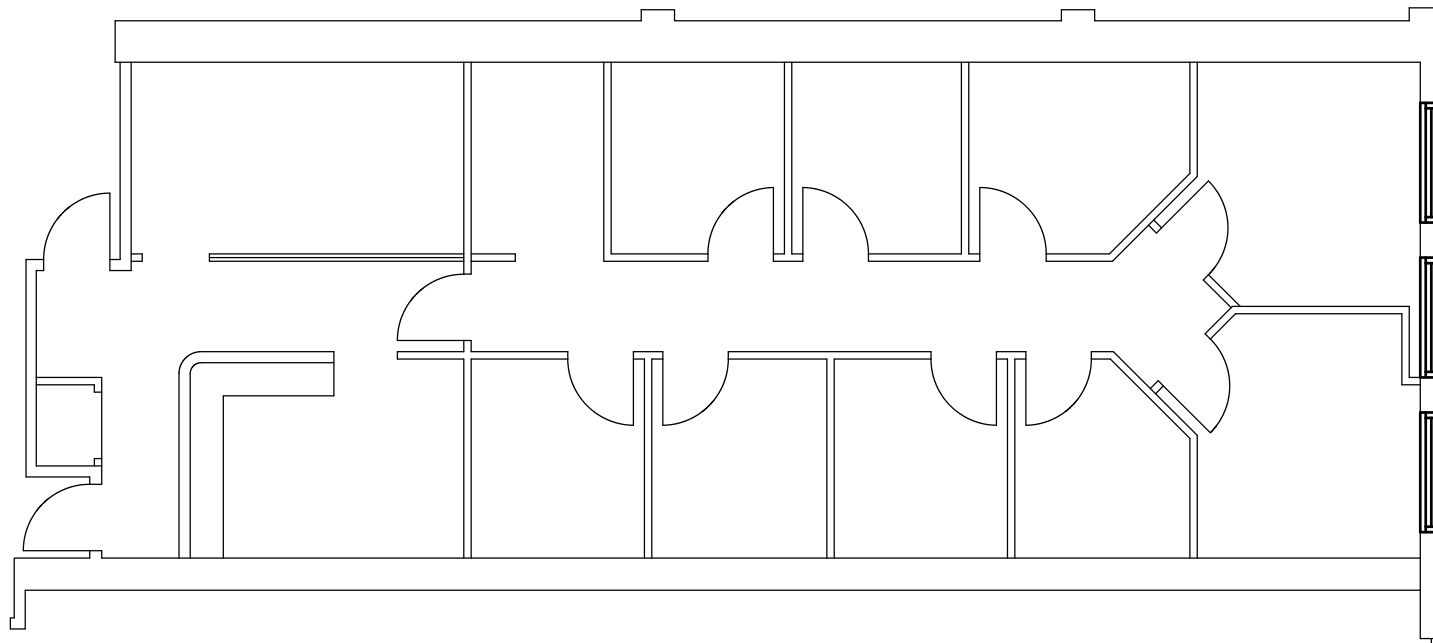

All areas and dimensions are approximate. Field verification is necessary.


Date Printed: 11/10/2023

MUSS DEVELOPMENT LLC
BUILDING NEW YORK CITY SINCE 1906

1556 Third Avenue
New York, NY 10128

4th Floor

Suite 406
2,167 RSF

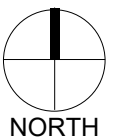

NORTH