


EXISTING FLOOR PLAN - LEVEL 1
SCALE: 1/8" = 1'-0"

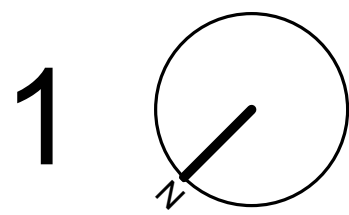

REDDICK ST.

1109 STATE ST.
1109 STATE ST, SANTA BARBARA, CA 93101

KEVIN MOORE ARCHITECT

530 SANTA BARBARA ST.
SANTA BARBARA, CA. 93101
T (805) 455-0574
kevin@kevinmoorearchitect.com
www.kevinmoorearchitect.com

KEVIN W. MOORE

No. C33116
02/28/2023
RENEWAL
DATE
STATE OF CALIFORNIA

11/15/2024 7:14:39 PM

PROJECT PHASE: AS BUILT


REV. #

DATE

DESCRIPTION


A2.11

EXISTING FLOOR PLAN - LEVEL 1

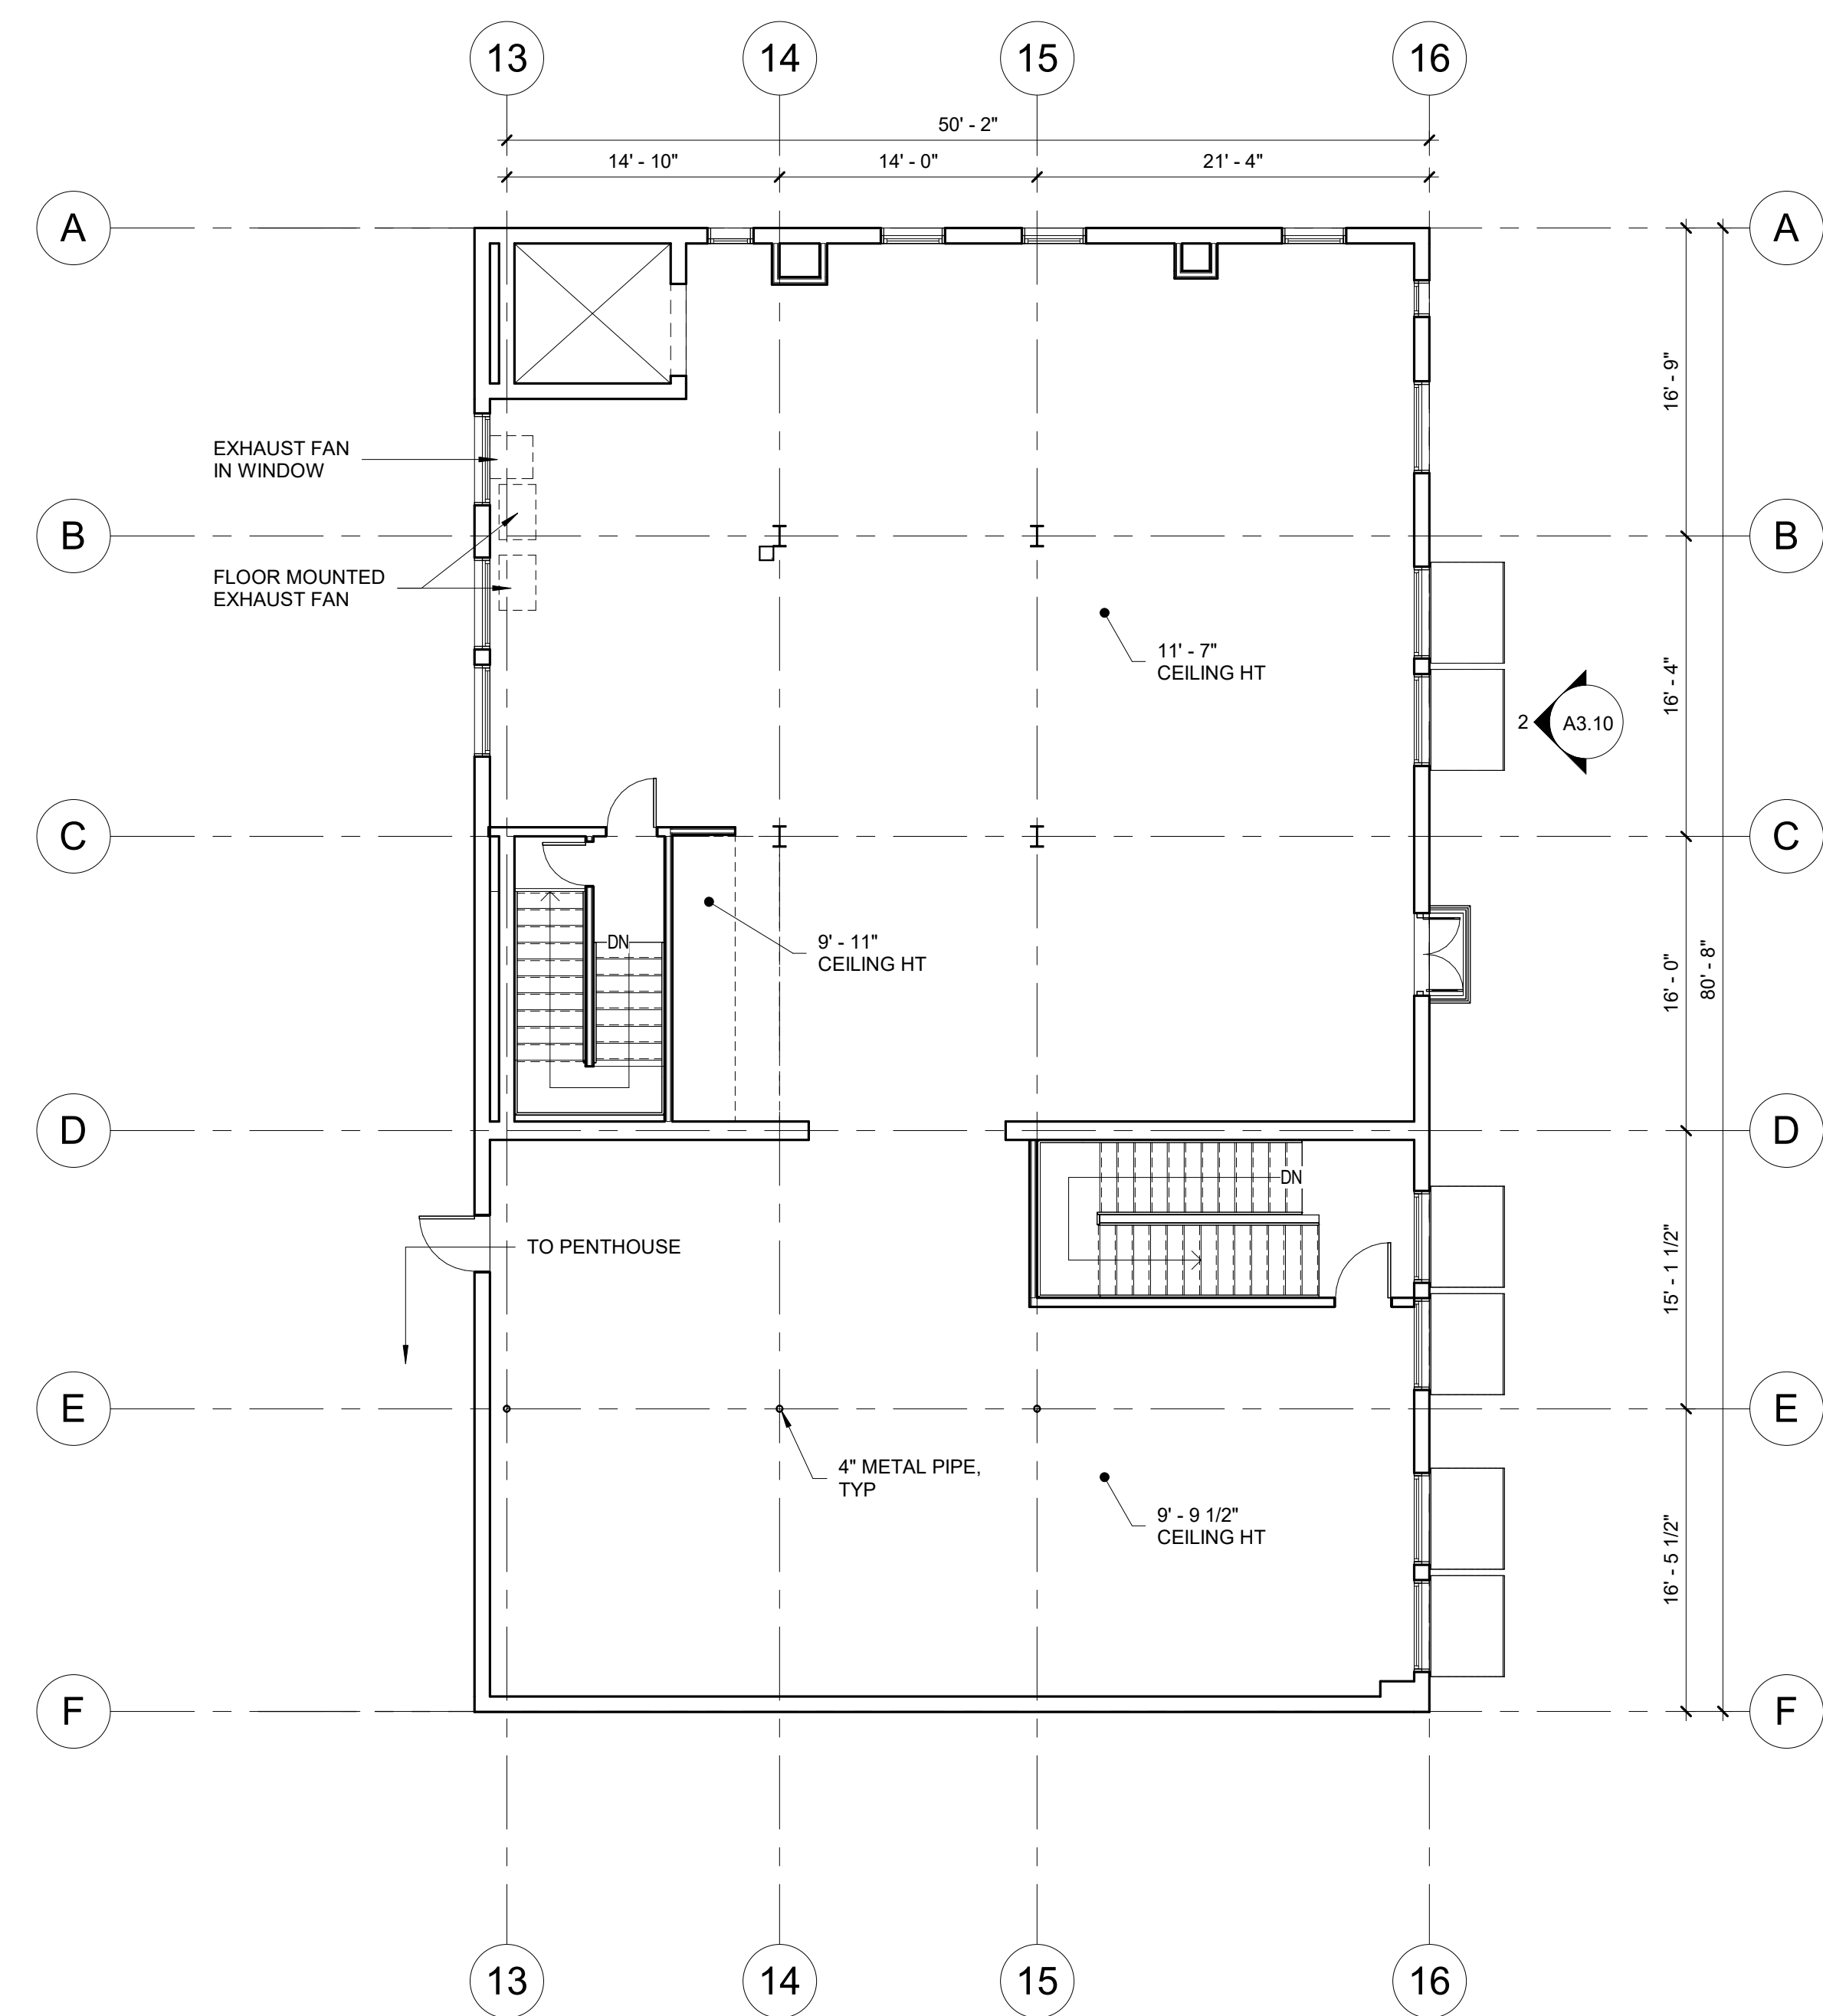

EXISTING FLOOR PLAN - LEVEL 3
SCALE: 1/8" = 1'-0"

2

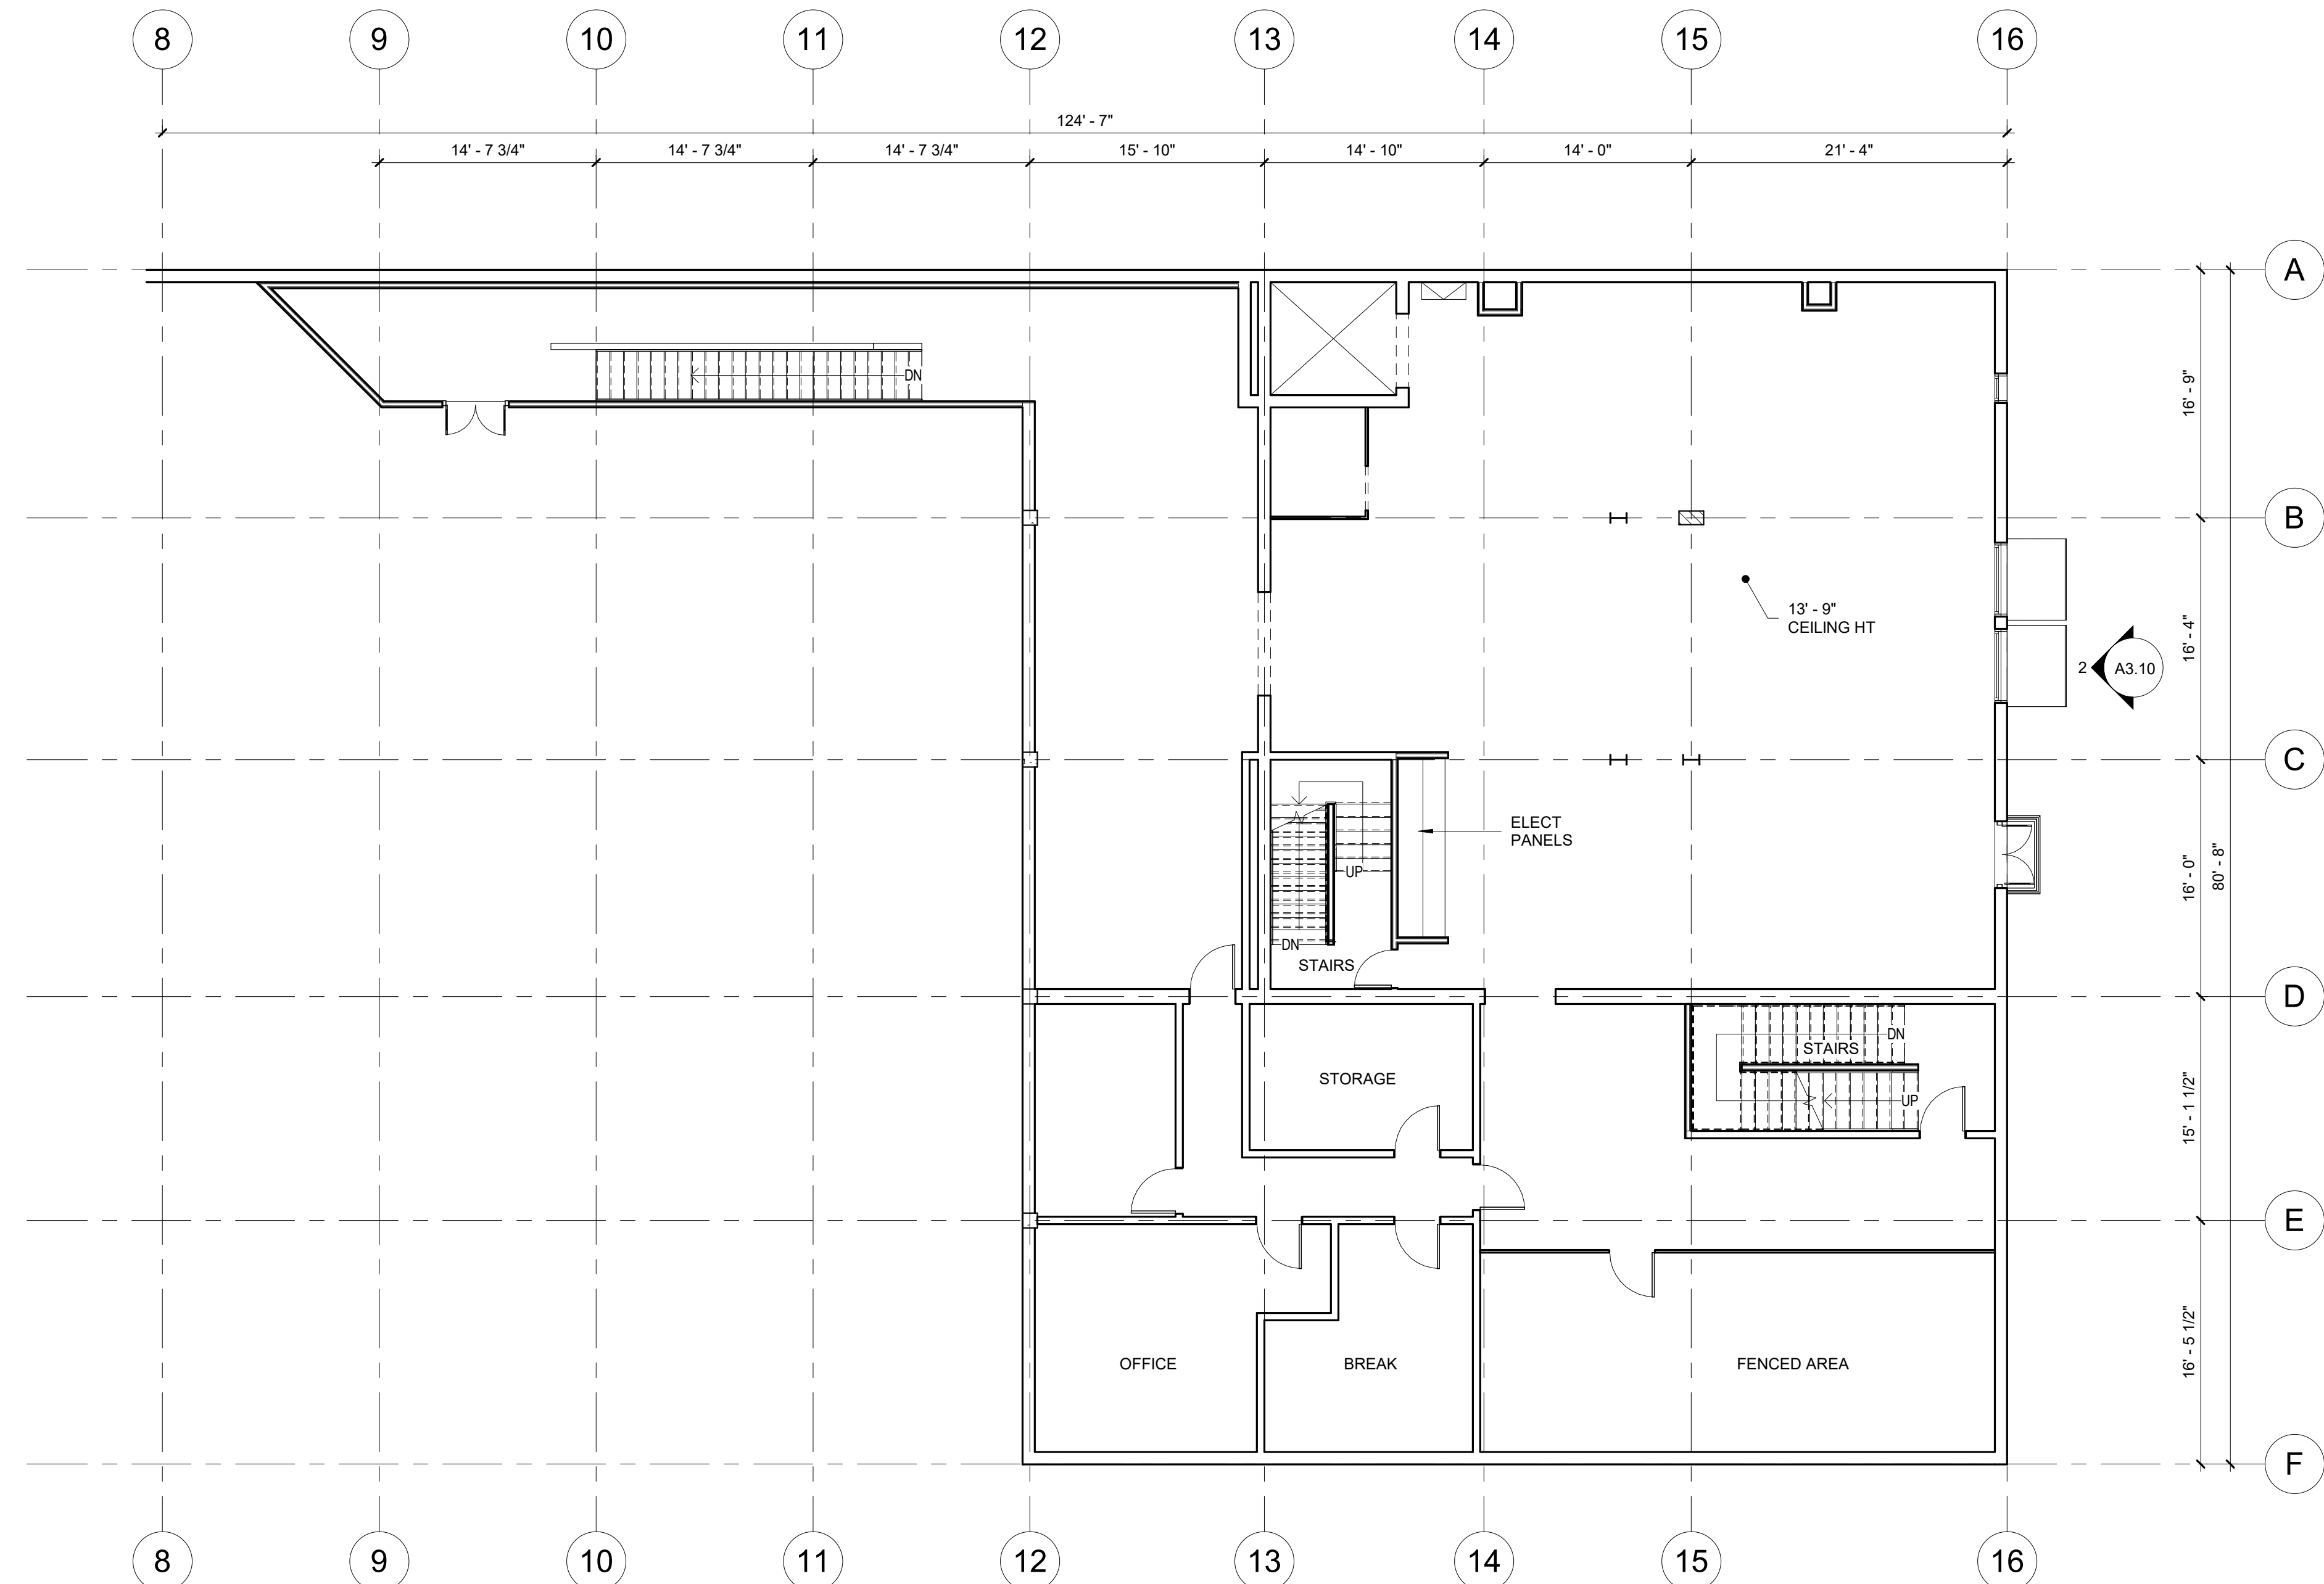

EXISTING FLOOR PLAN - LEVEL 2
SCALE: 1/8" = 1'-0"

1

1109 STATE ST.
1109 STATE ST, SANTA BARBARA, CA 93101

KEVIN MOORE ARCHITECT
530 SANTA BARBARA ST.
SANTA BARBARA CA. 93101
T (805) 455-0574
kevin@kevinmoorearchitect.com
www.kevinmoorearchitect.com

LICENSED ARCHITECT
KEVIN W. MOORE
No. C33116
02/28/2023
RENEWAL
DATE
STATE OF CALIFORNIA

11/15/2024 7:14:40 PM

PROJECT PHASE: AS
BUILT

All fees, designs, and plans indicated or represented by these drawings are owned by and are property of Kevin Moore Architect and were created and developed for use in connection with the specified project. None of such ideas, designs, or plans shall be used for any purpose whatsoever without the written permission of Kevin Moore Architect.
© Kevin Moore Architect

REV. #	DATE	DESCRIPTION

A2.12

EXISTING FLOOR
PLANS -
LEVEL 2 & 3

[illegible]