

Property Key




3904 Corporex Drive As Built Marketing Package

3904 Corporex Drive, Tampa, FL 33619

Building: 1
Suite: 100
Sheet: A-1


Scale: Not to Scale
Sheet Size: 8.5" x 11"
Not For Construction

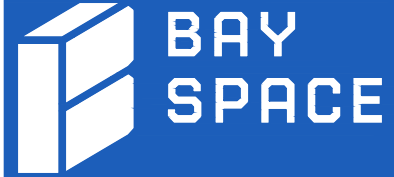

Total Area - 5,589 SF

Building Information

DECK HEIGHT:	17'-4"
CEILING HEIGHT:	8'-4"
CLEAR HEIGHT:	15'-11"
SPRINKLERED:	No

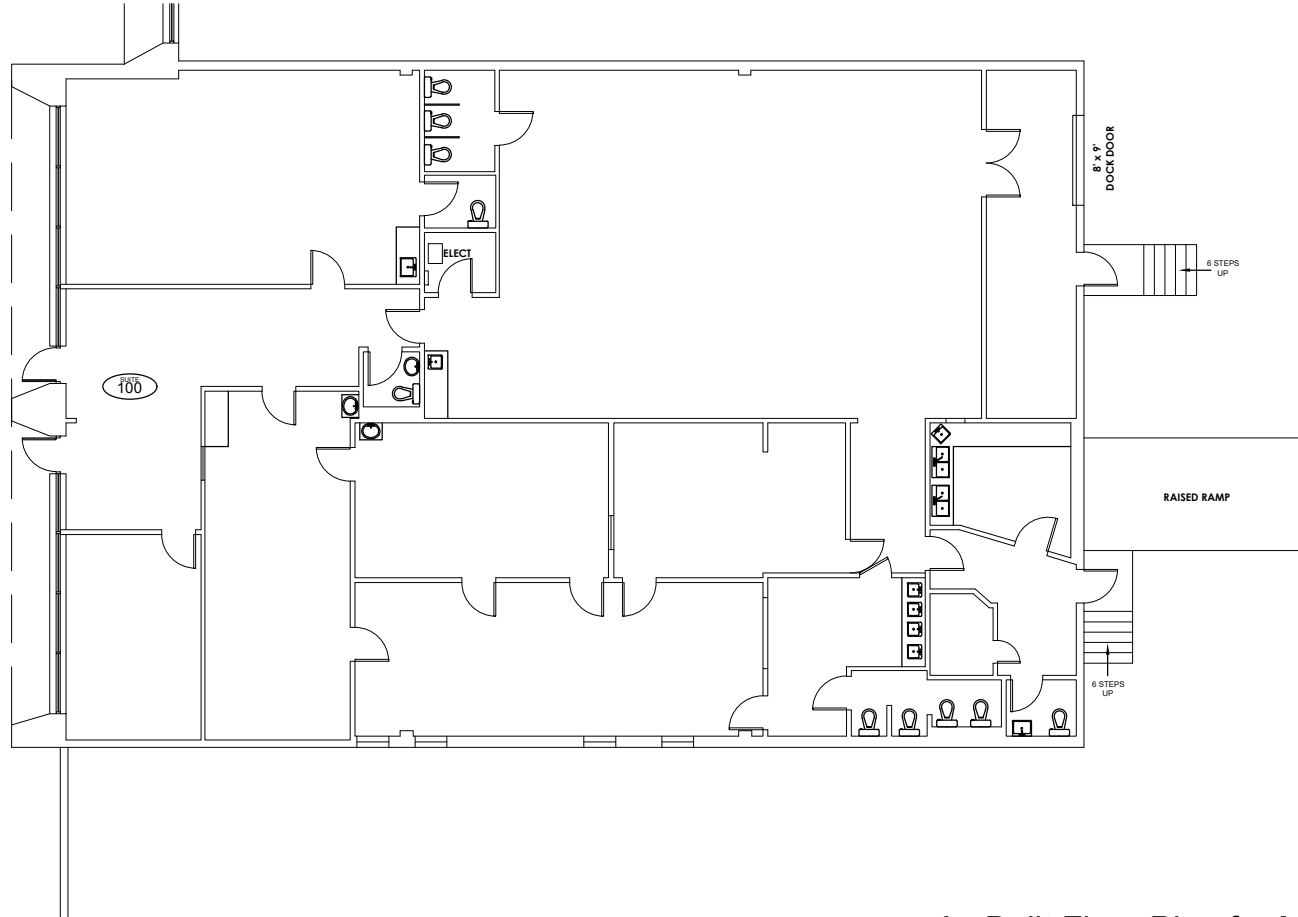

As Built Floor Plan for Marketing

