
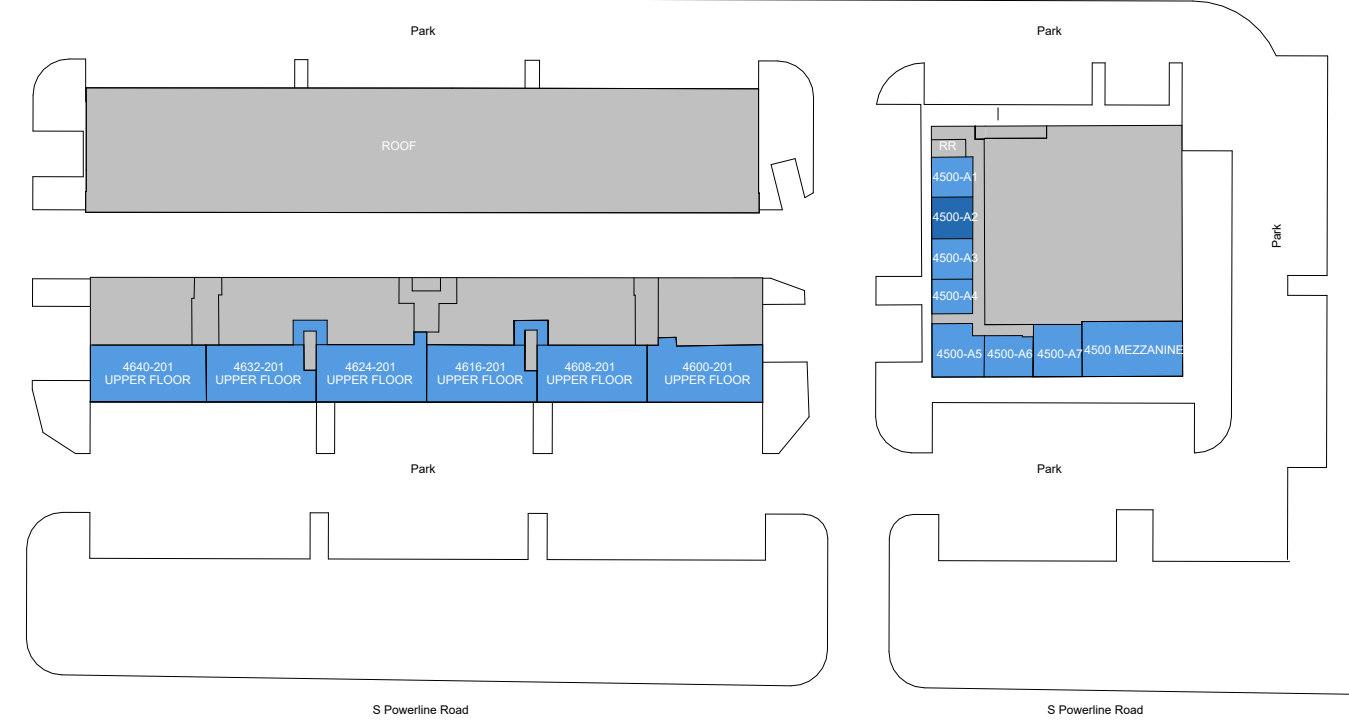


Property Key

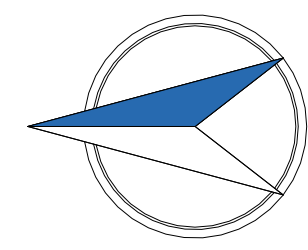


Deerfield

4500 N Powerline Rd, Pompano Beach, 33073 FL

Building: 4500

Suite: 4500-A2

Sheet **E1**

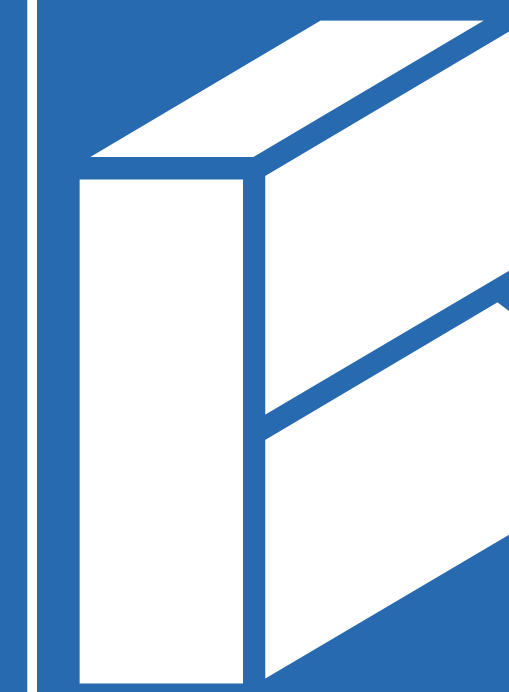

BAY SPACE


Scale: Not to Scale
Sheet Size: 42" x 30"
Not For Construction

Usable Square Foot Analysis

	SQFT	BUILDING PERCENTAGE
Office Area	475	100 %
Warehouse Area	0	0 %
Total Area	475	

Building Information

Deck Height:	8' - 2 1/4"
Clear Height:	8' - 2 1/4"
Ceiling Height:	8' - 2 1/4"
Sprinklered:	<input checked="" type="checkbox"/> Yes <input type="checkbox"/> No
Mechanical Area:	0 SQFT

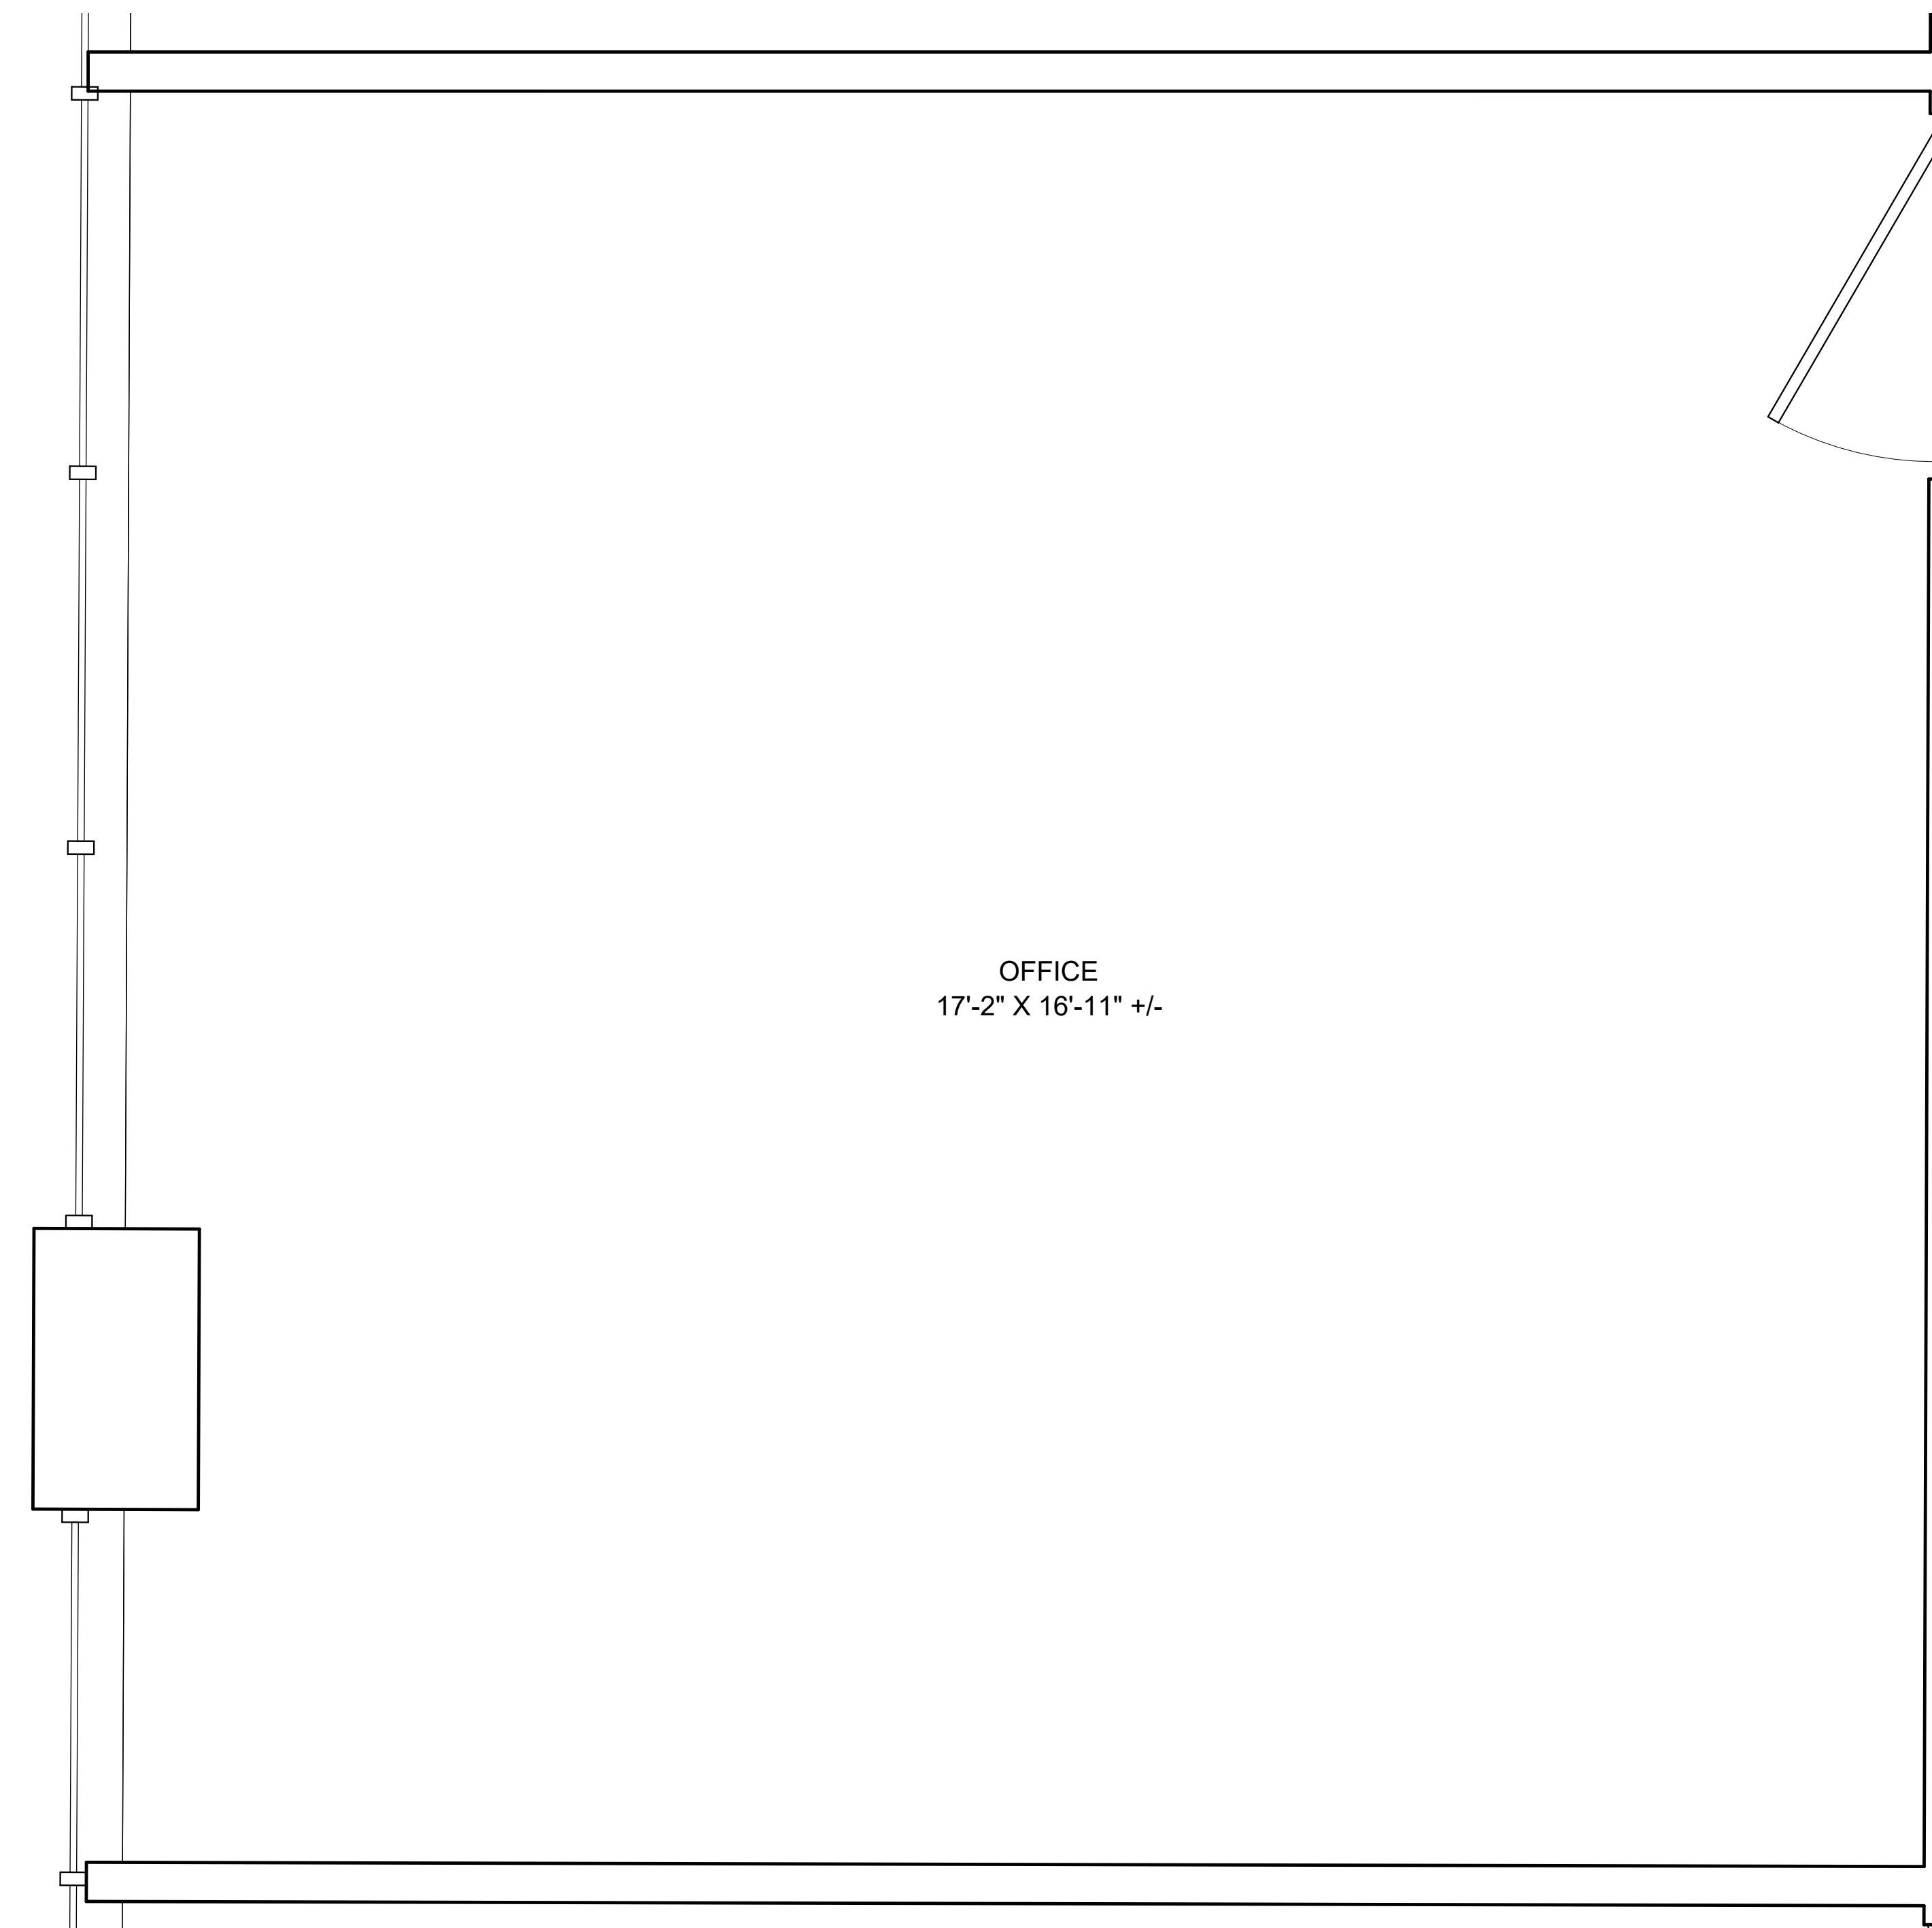

⑤ 4500-A2
1 : 15

As Built Floor Plan for Marketing

