


1ST FLOOR 1,217 RSF
 2ND FLOOR 2,197 RSF
TOTAL 3,414 RSF

Graphic Legend

- Existing to Remain
- Usable sq ft
968 sq ft

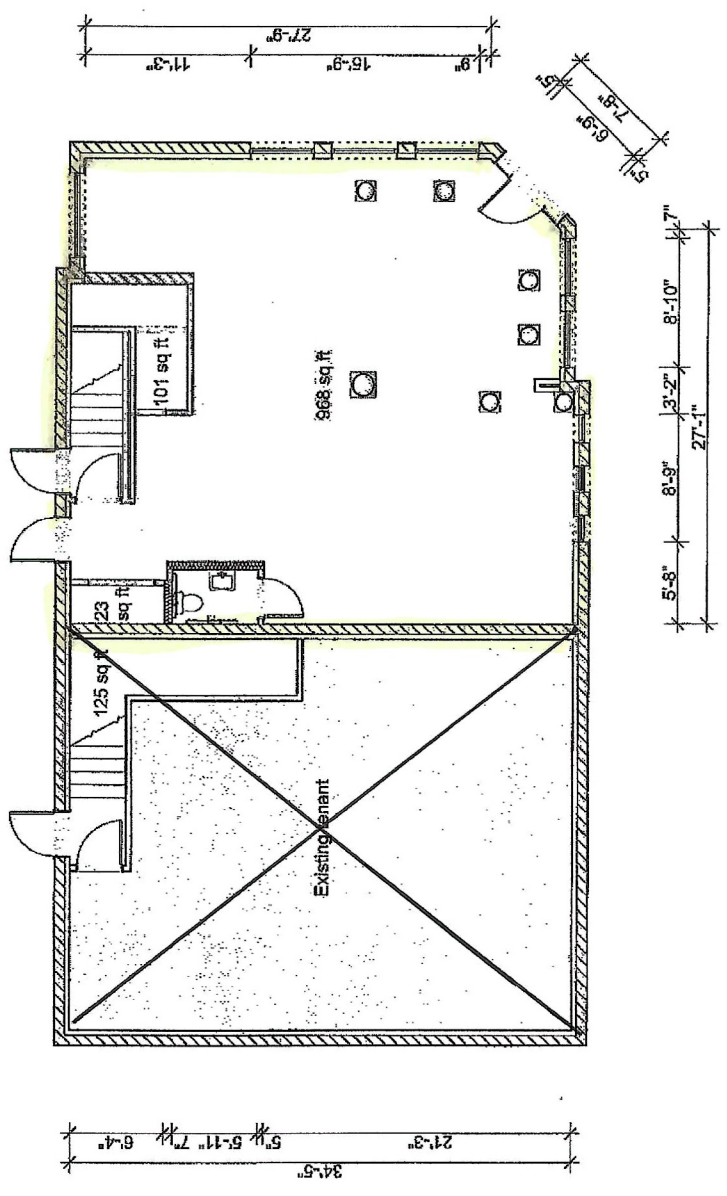

1ST FLOOR
 1,217 RSF



SCALE: 1/8" = 1'-0"

Ground Floor Landlord Backup - Sqft
 A-101
 PROJECT NO: #1300
 PUBLISH DATE: 6/18/25

301 S Federal Hwy
 As-Built
 301 S Federal Hwy, Boca Raton, FL 33432

MUMMAW + ASSOCIATES, INC.
 ARCHITECTURE & INTERIOR DESIGN
 301 Camino Gardens Blvd - Ste. 202, Boca Raton, FL 33432
 P: 561-361-0375 • F: 561-361-0376
 ARE 92210 - CQC# 55122

