


**FLOOR PLAN
AS BUILT**

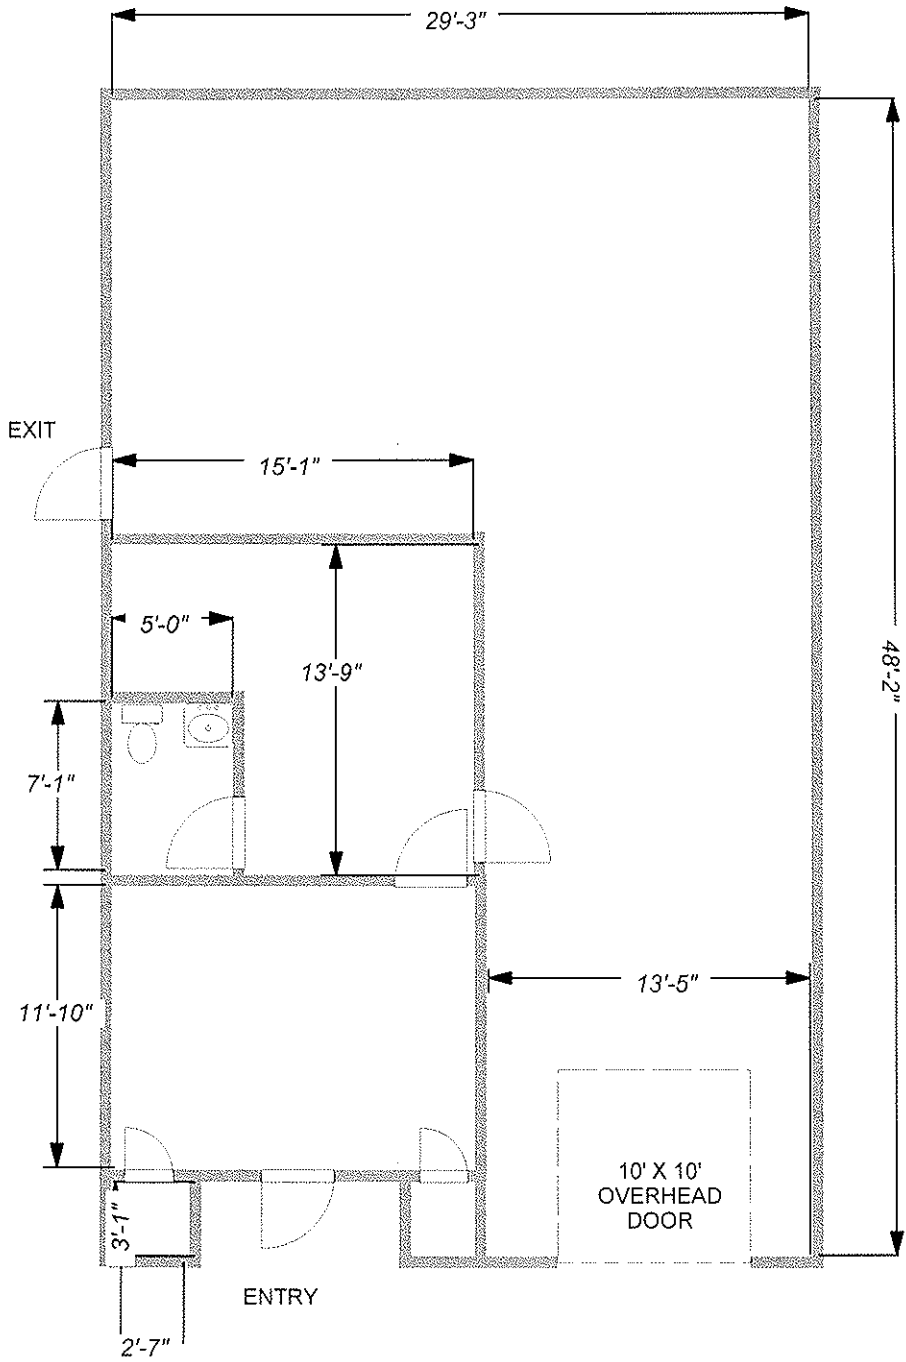

**218 BRONZE, GARLAND, TEXAS
APPROX. 1680 SQUARE FEET
OFFICE / WAREHOUSE**

SCALE: 1/8" = 1'