
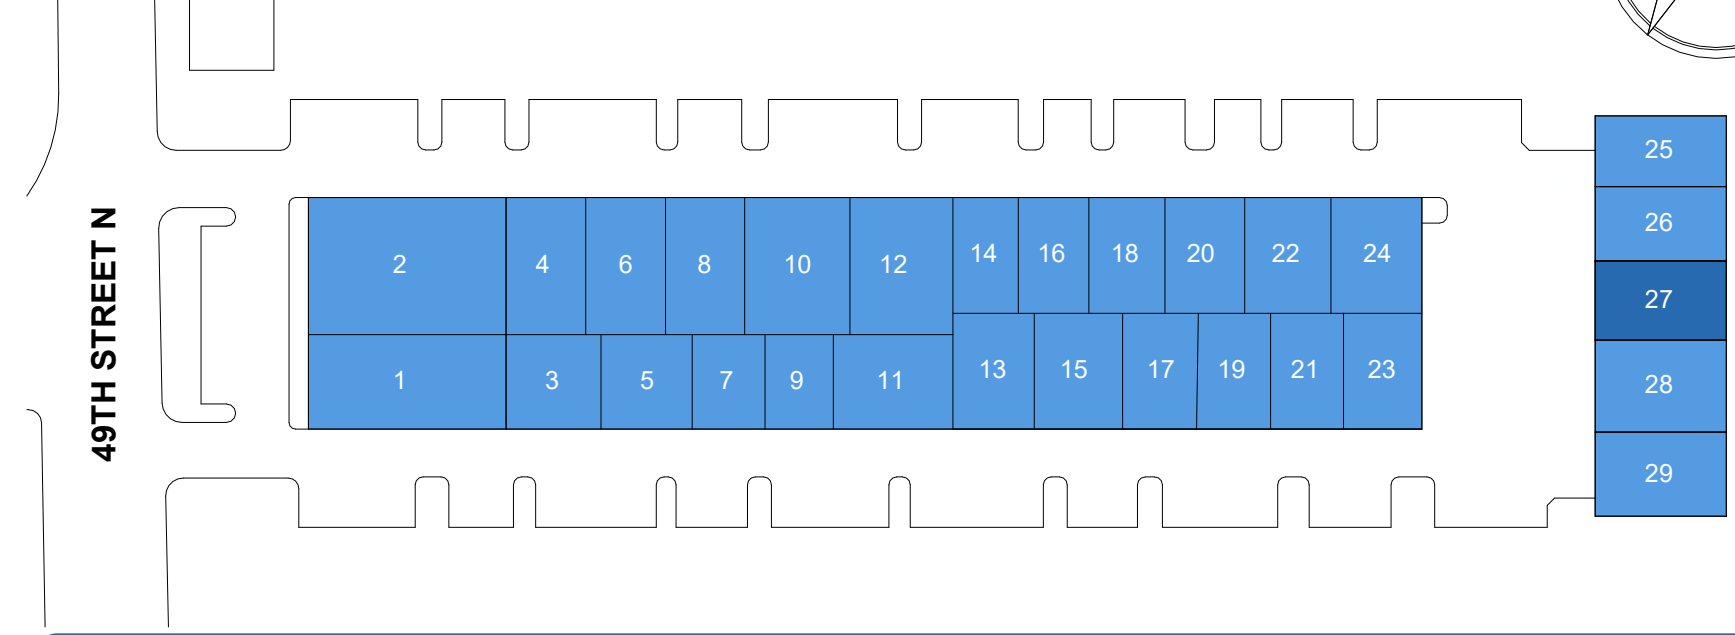


Property Key

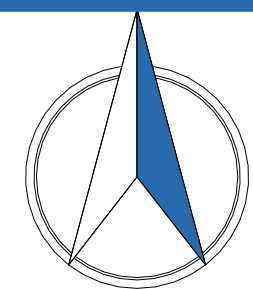

Clearwater As Built Marketing Package

14605, 49th Street N, Clearwater, FL 33762, US

Building: 2

Suite: 27

Sheet **E1**



BAY SPACE

Scale: Not to Scale
Sheet Size: 42" x 30"
Not For Construction

Usable Square Foot Analysis

Office Area	1,500	100 %
Warehouse Area	0	0%
Total Area	1,500	

Building Information

Deck Height:	14' - 7"
Clear Height:	11' - 8"
Ceiling Height:	7' - 6 1/2"
Sprinklered:	<input type="checkbox"/> Yes <input checked="" type="checkbox"/> No
Mechanical Area:	0 SQFT

