


Property Key

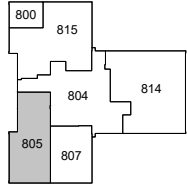

WMG ICOT BC As Built Marketing Package

13830-13923 58th Street North, Clearwater, FL 33760

Building: 8

Suite: 805

Sheet: A-3

Scale: Not to Scale
Sheet Size: 8.5" x 11"
Not For Construction




BAY SPACE

Total Area - 3,124 SF

Building Information

DECK HEIGHT:	N/A
CEILING HEIGHT:	8'-10"
CLEAR HEIGHT:	8'-10"
SPRINKLERED:	No

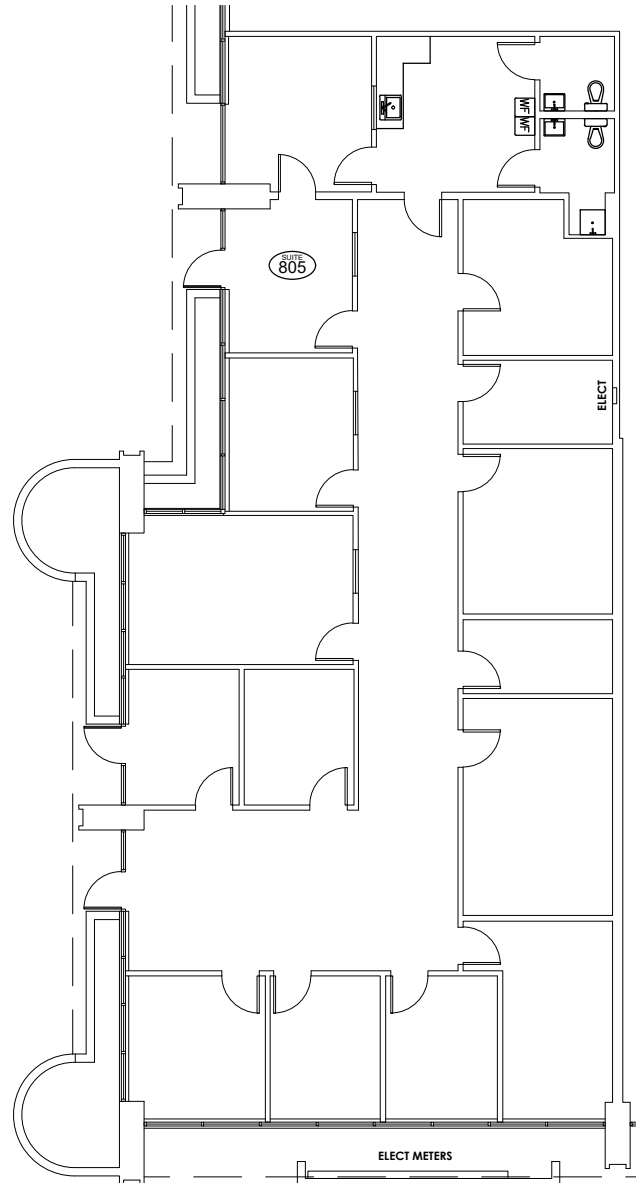

As Built Floor Plan for Marketing

