


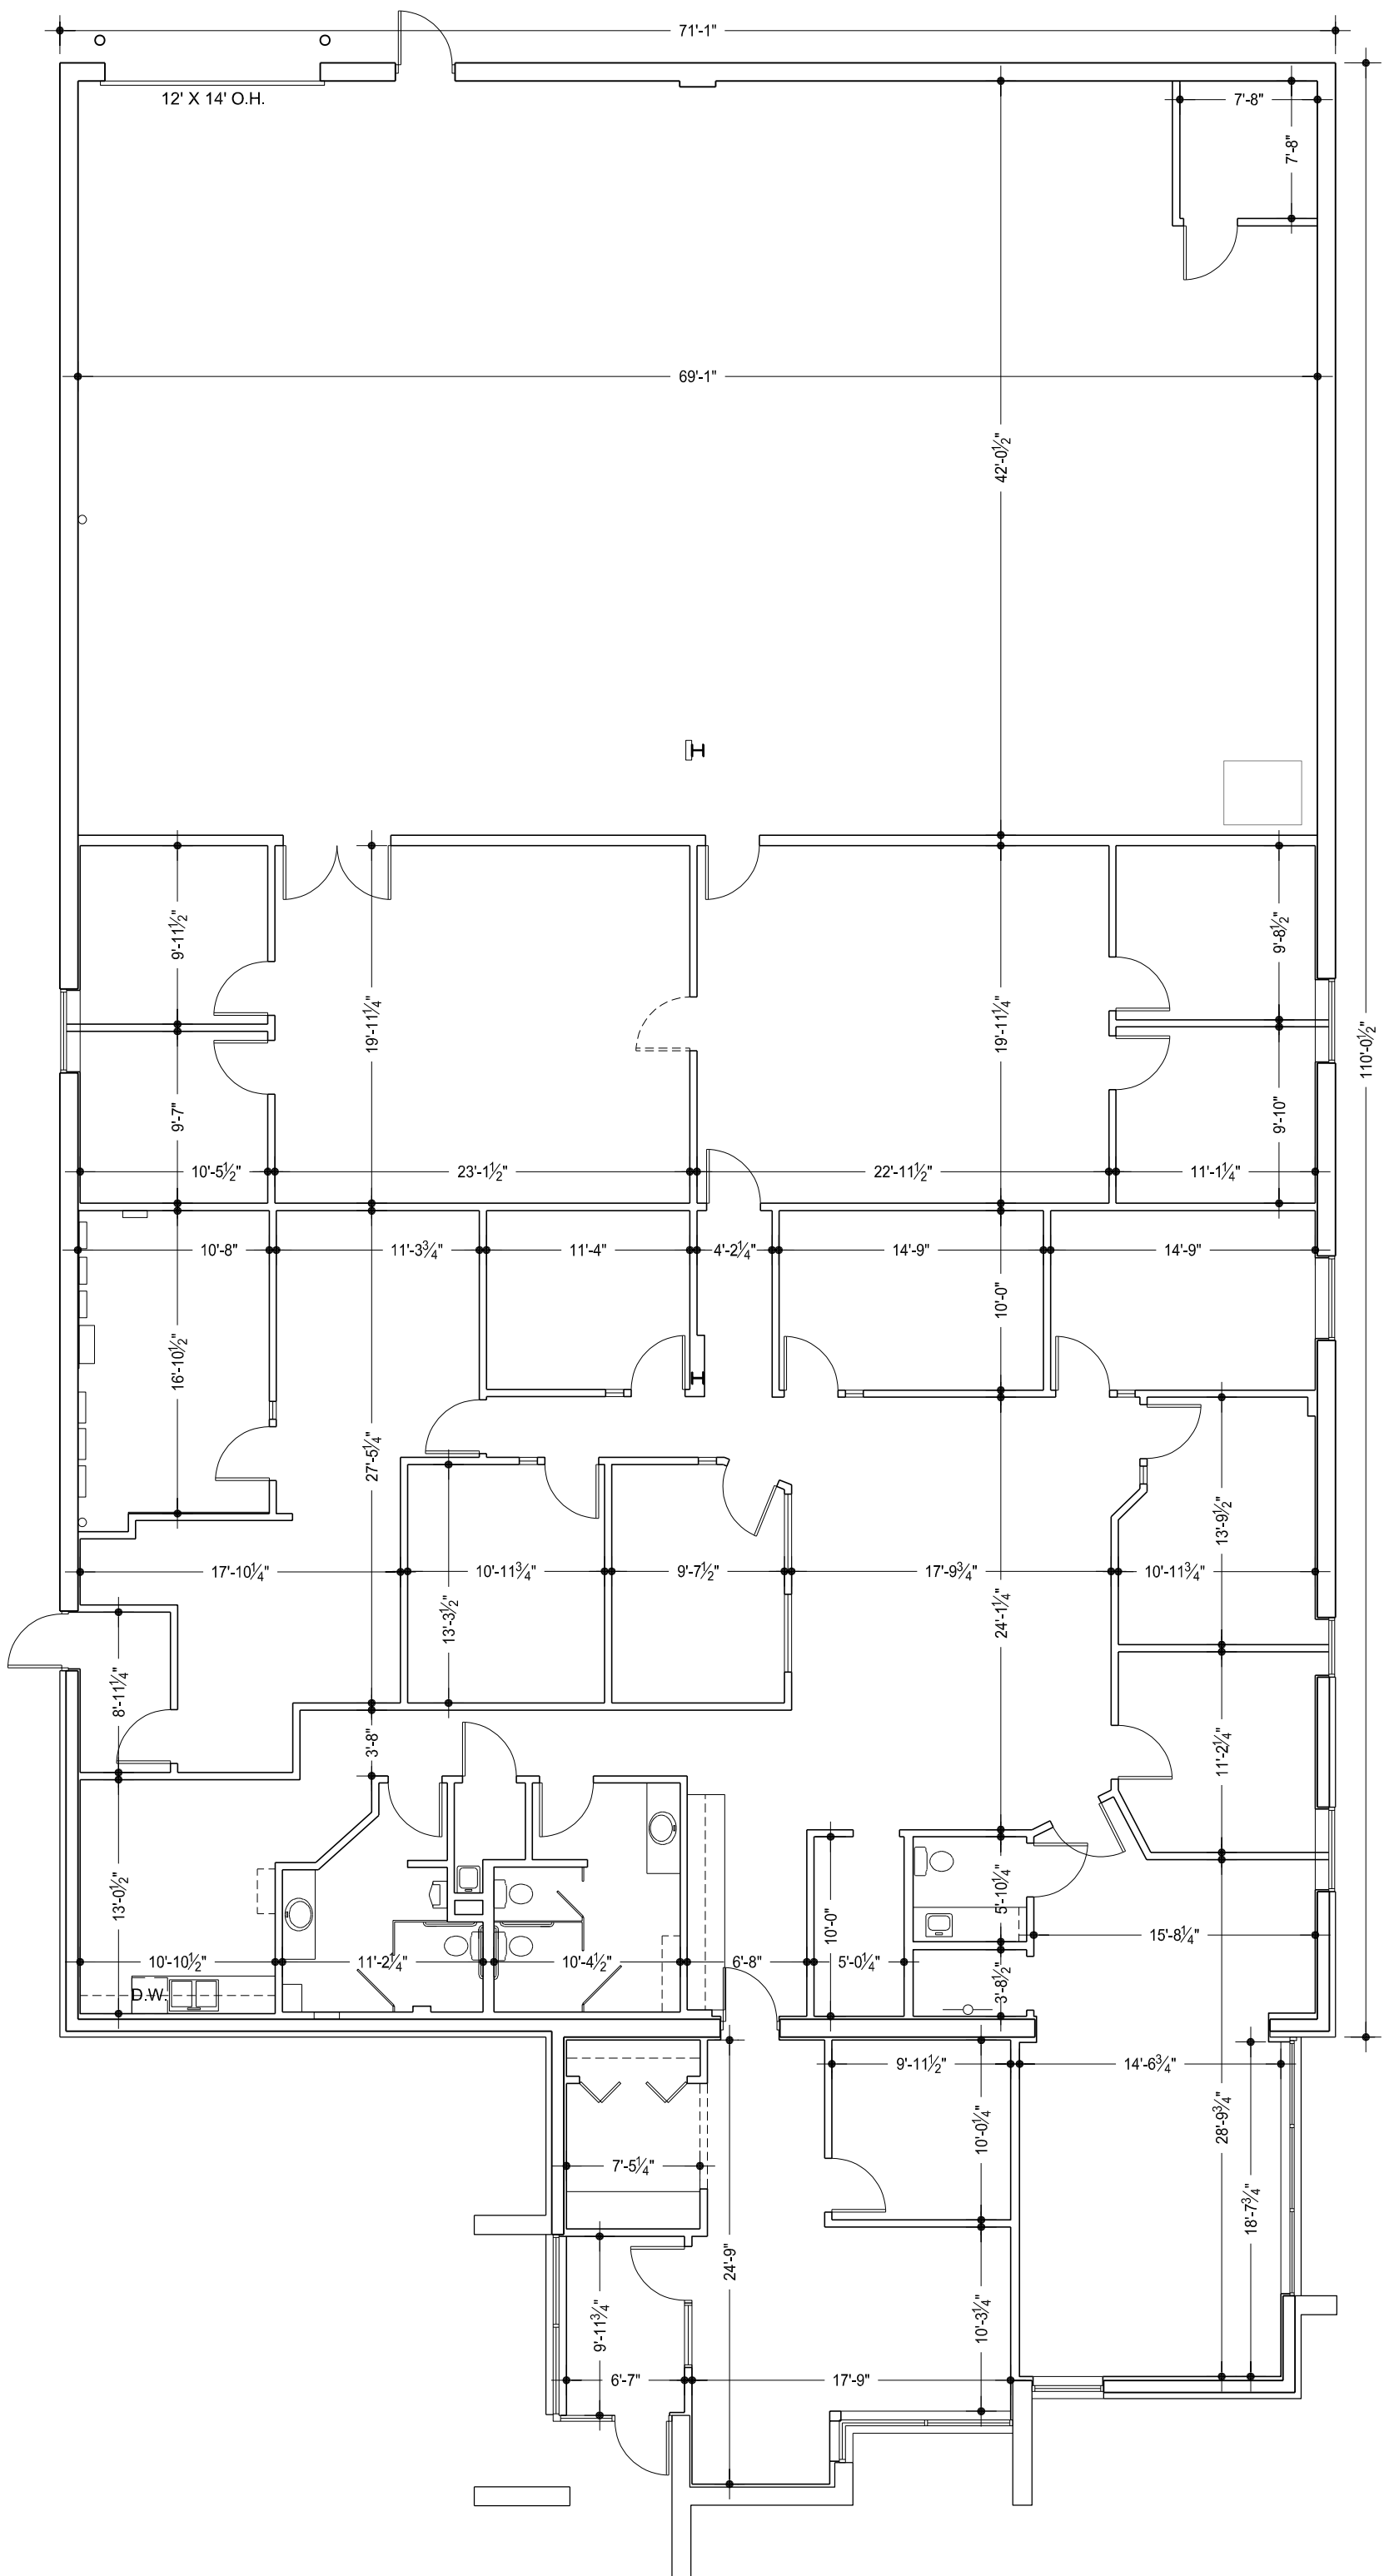

AS-BUILT FLOOR PLAN

23370 COMMERCE DRIVE, FARMINGTON HILLS, MI

9/12/2023

8,758 GROSS SF

SCALE: NTS

