


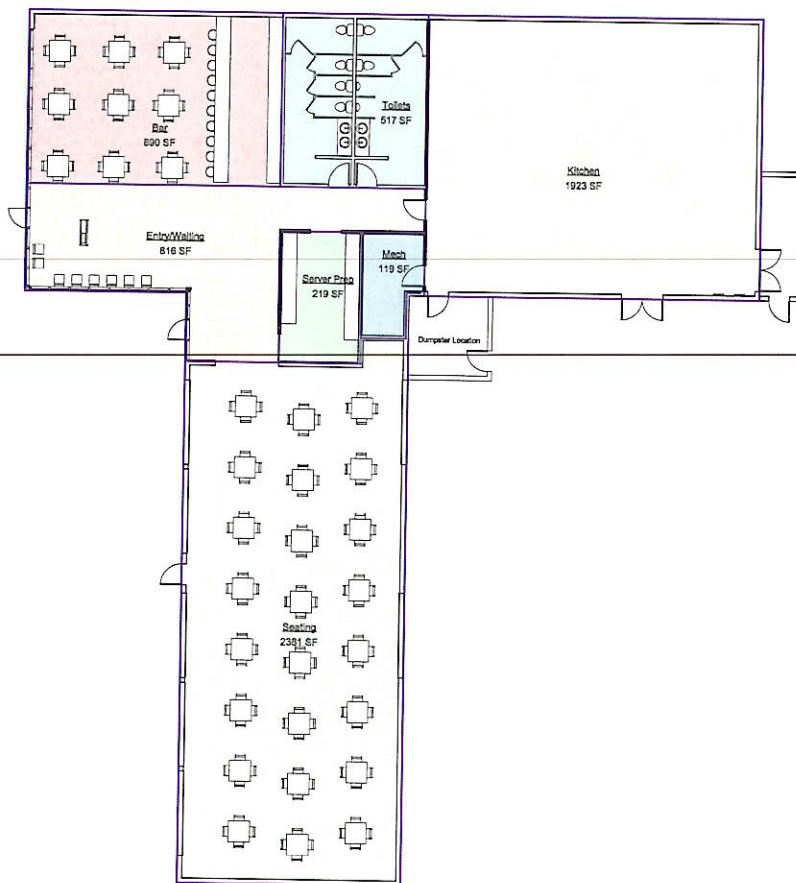

① Floor Level
1/8" = 1'-0"



scharhag
KEVIN A. SCHARHAG COMPANY, ARCHITECTS

5936 Central Kansas City, Mo. 64113
Phone: 816-944-5165 Scharhagarch@gmail.com

Copyright ©2023 Kevin A. Scharhag Co., Architects
All Rights Reserved. No part of this drawing may be reproduced in any form or by any means of electronic or mechanical means, without written permission.

AS BUILTS FOR

2021 SWIFT
NORTH KANSAS CITY, MO

1. Jeffery Schwartz Mo. License A-0108
Partner Scharhag Co., Inc. City of Aurora IL IL

No.	Description	Date
	Revised Schedule	

Area Plan

Printed number 2358
Date 12.20.2023

A100

Scale 1/8" = 1'-0"

12/20/2023 15:32:00 AM