


IDEAL PROFESSIONAL PARK
SUITE C-204: As-builts
SCALE: 1/8"=1'
1,682 SQFT

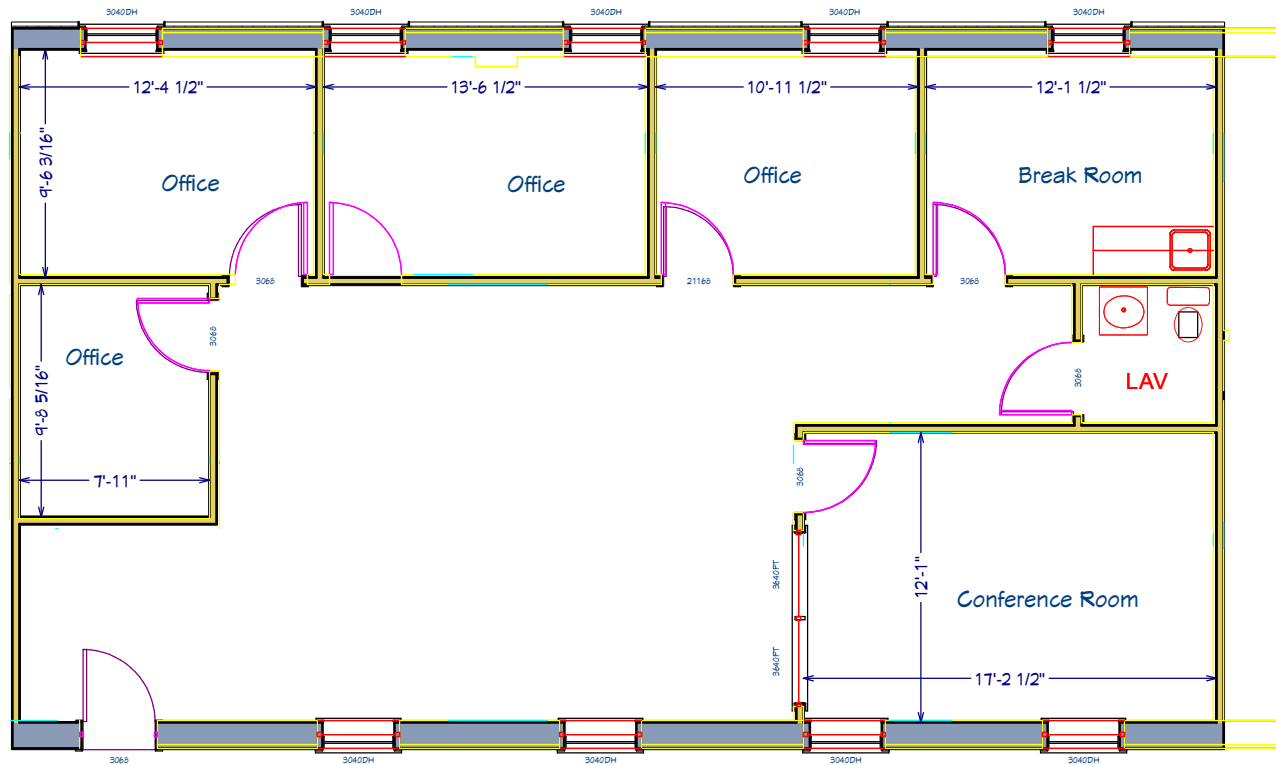

Prepared by DVP
***all dimensions are approximate*