
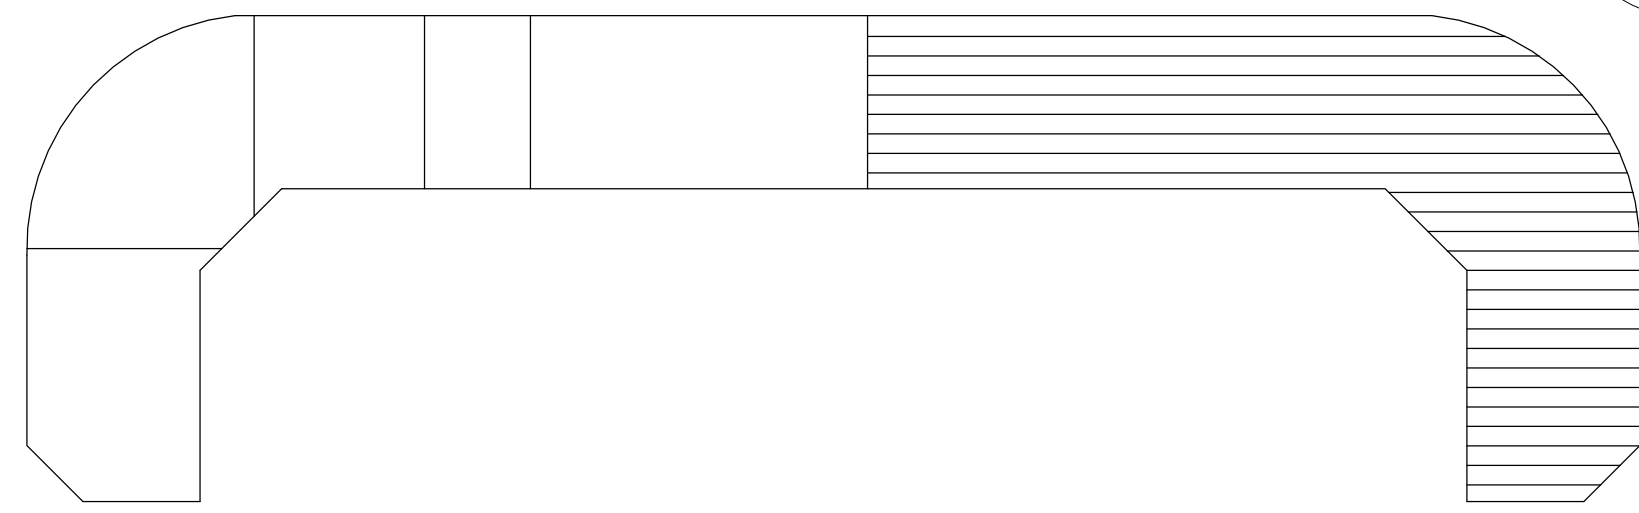


Property Key

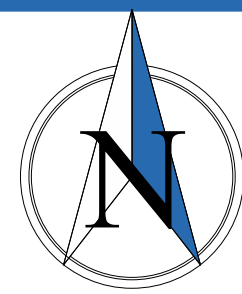

Lakefront As Built Marketing Package

6101 Chancellor Dr,
Orlando, FL 32809, US
UNIT 1000

Sheet **E1**



BAY SPACE


Scale: Not to Scale
Sheet Size: 42" x 30"
Not For Construction

Usable Square Foot Analysis

Office Area		
Warehouse Area		
Total Area	36,475	

Building Information

Deck Height:	xx'-yy"
Clear Height:	xx'-yy"
Ceiling Height:	xx'-yy"
Sprinklered:	xx'-yy"
Mechanical Area:	xx'-yy"

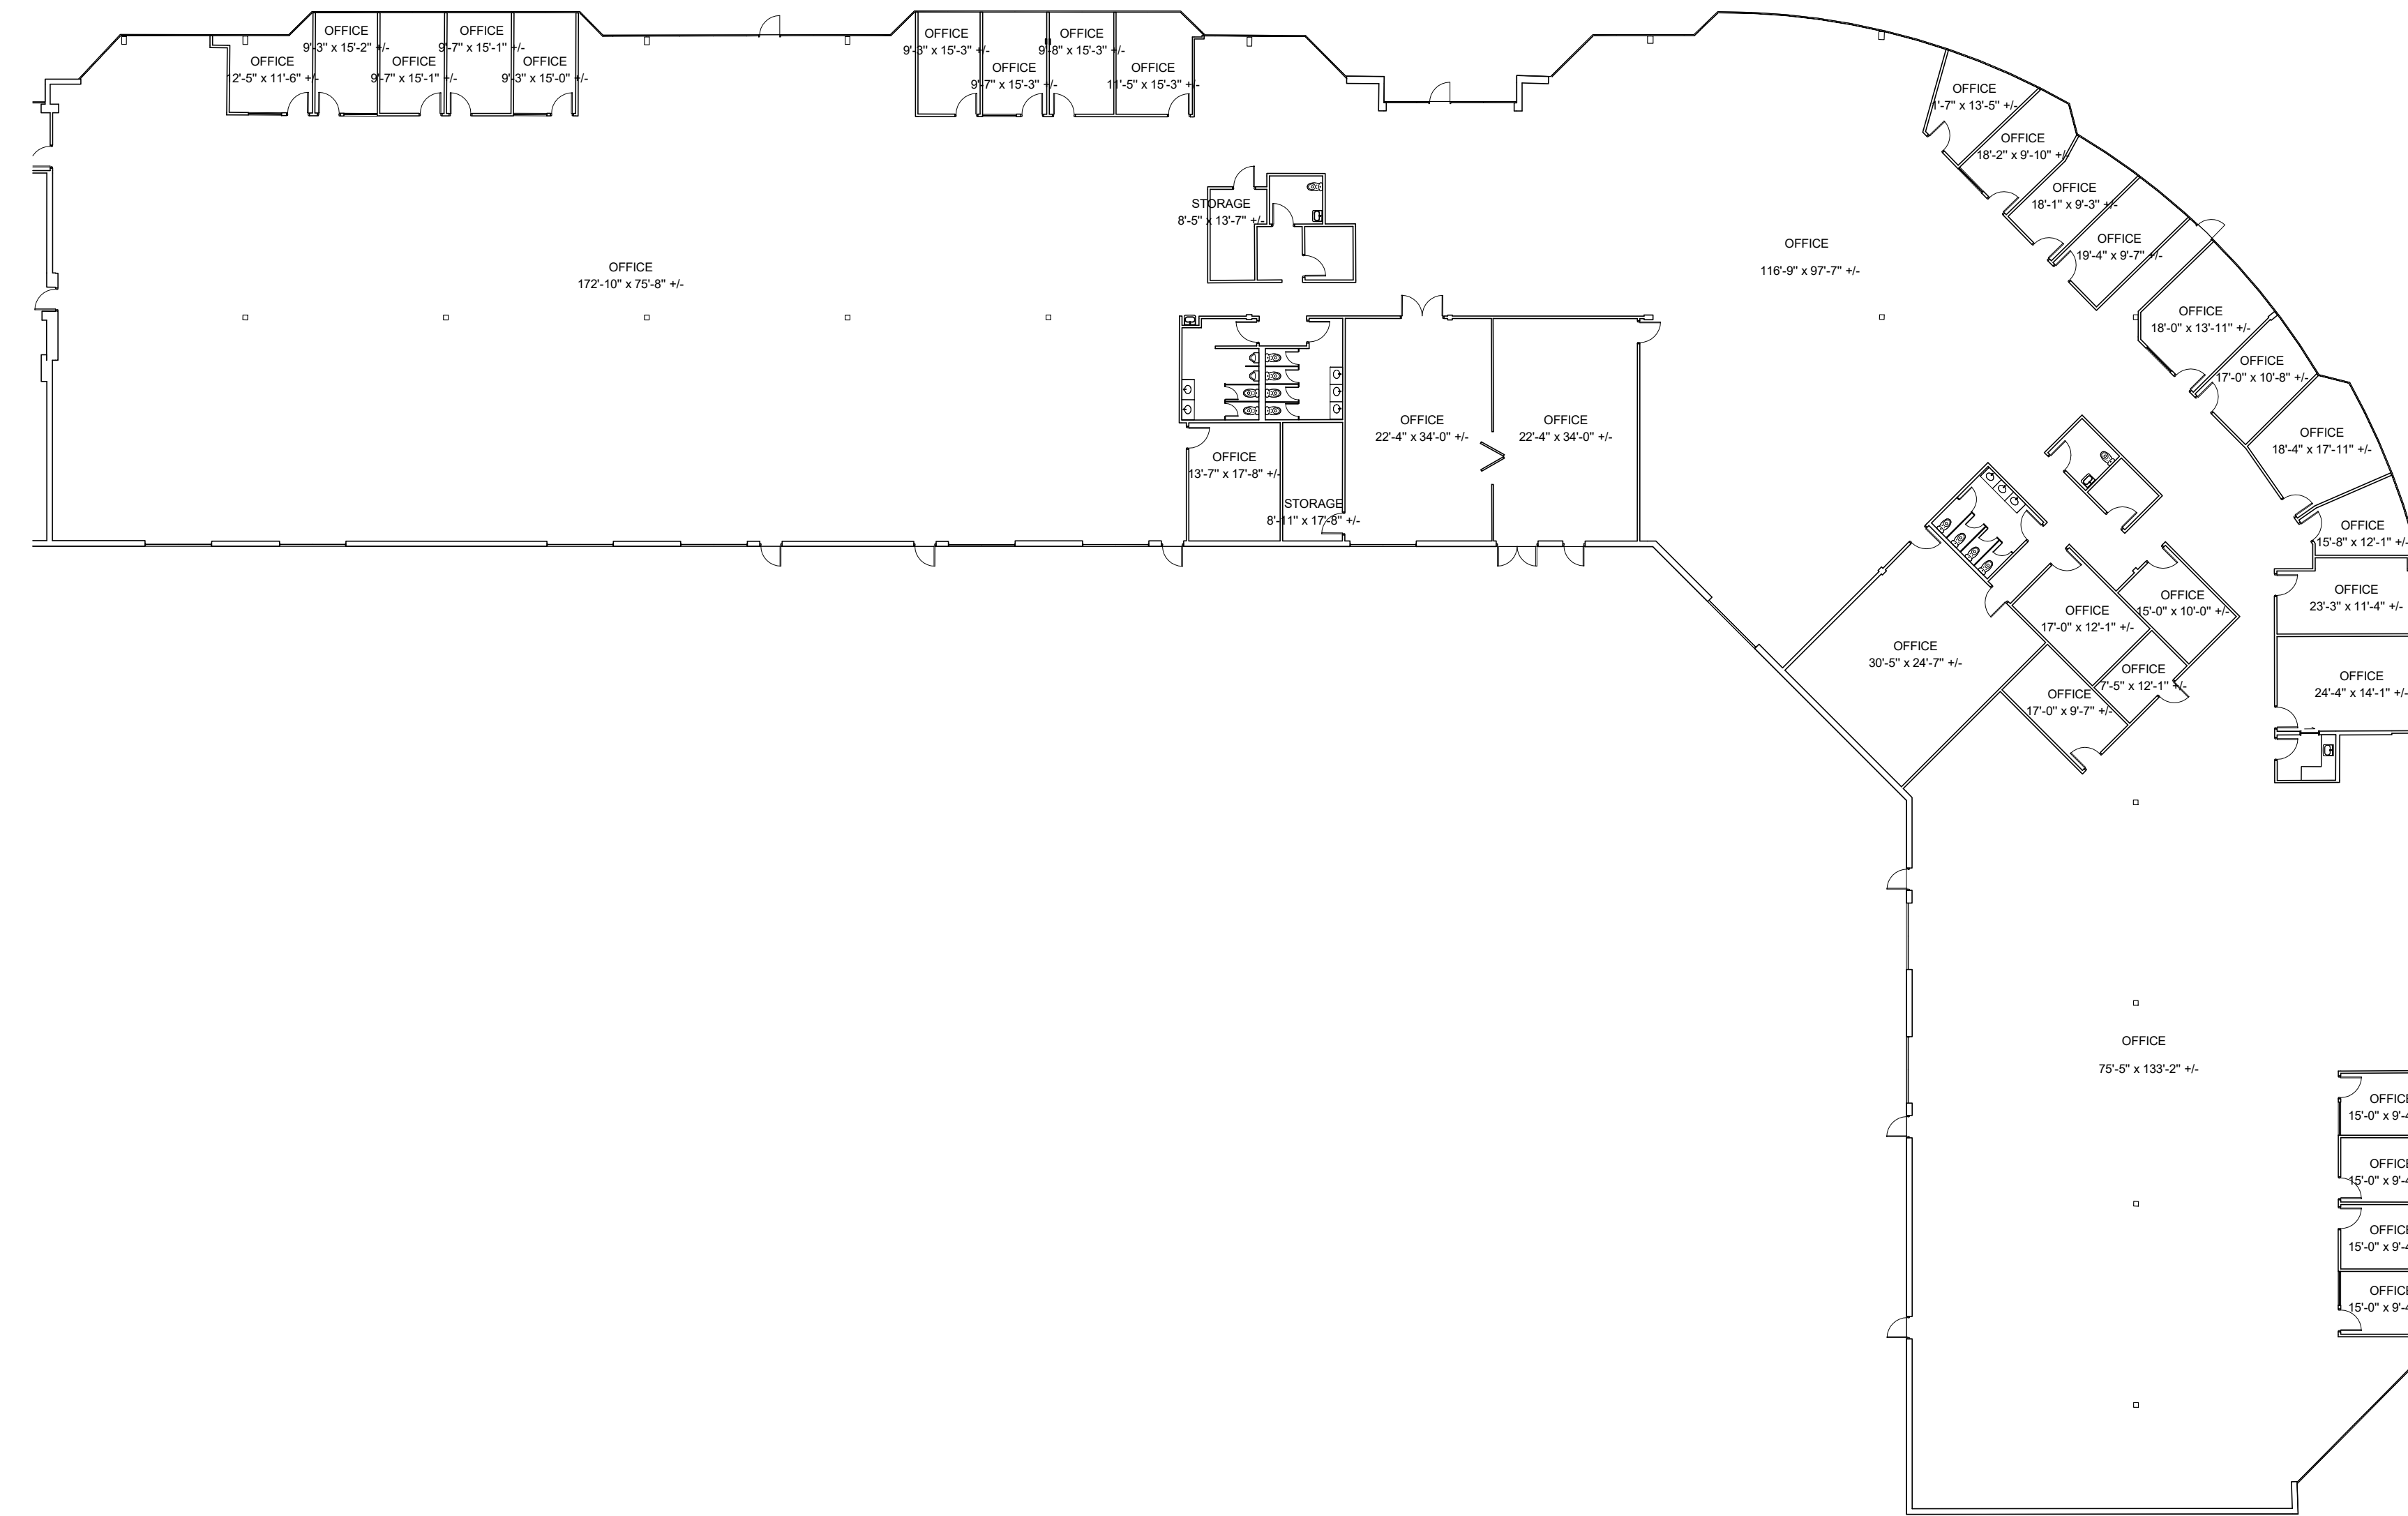

① 1st Floor-1000
1" = 20'-0"

As Built Floor Plan for Marketing

