


Property Key

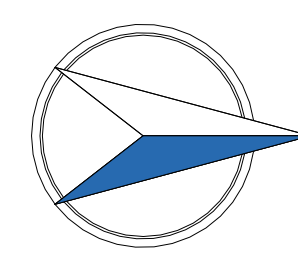

Alt Springs As Built Marketing Package

402 Northlake Blvd, Alt Springs, FL 32701, US

Building: 402

Suite: 1026

Sheet **E1**

Scale: Not to Scale
Sheet Size: 42" x 30"
Not For Construction




BAY SPACE

Usable Square Foot Analysis

Office Area	1,589	97%
Warehouse Area	51	3%
Total Area	1,640	

Building Information

Deck Height:	N/A	
Clear Height:	10' - 1 1/2"	
Ceiling Height:	9' - 0"	
Sprinklered:	<input checked="" type="checkbox"/> Yes	<input type="checkbox"/> No
Mechanical Area:	0 SQFT	

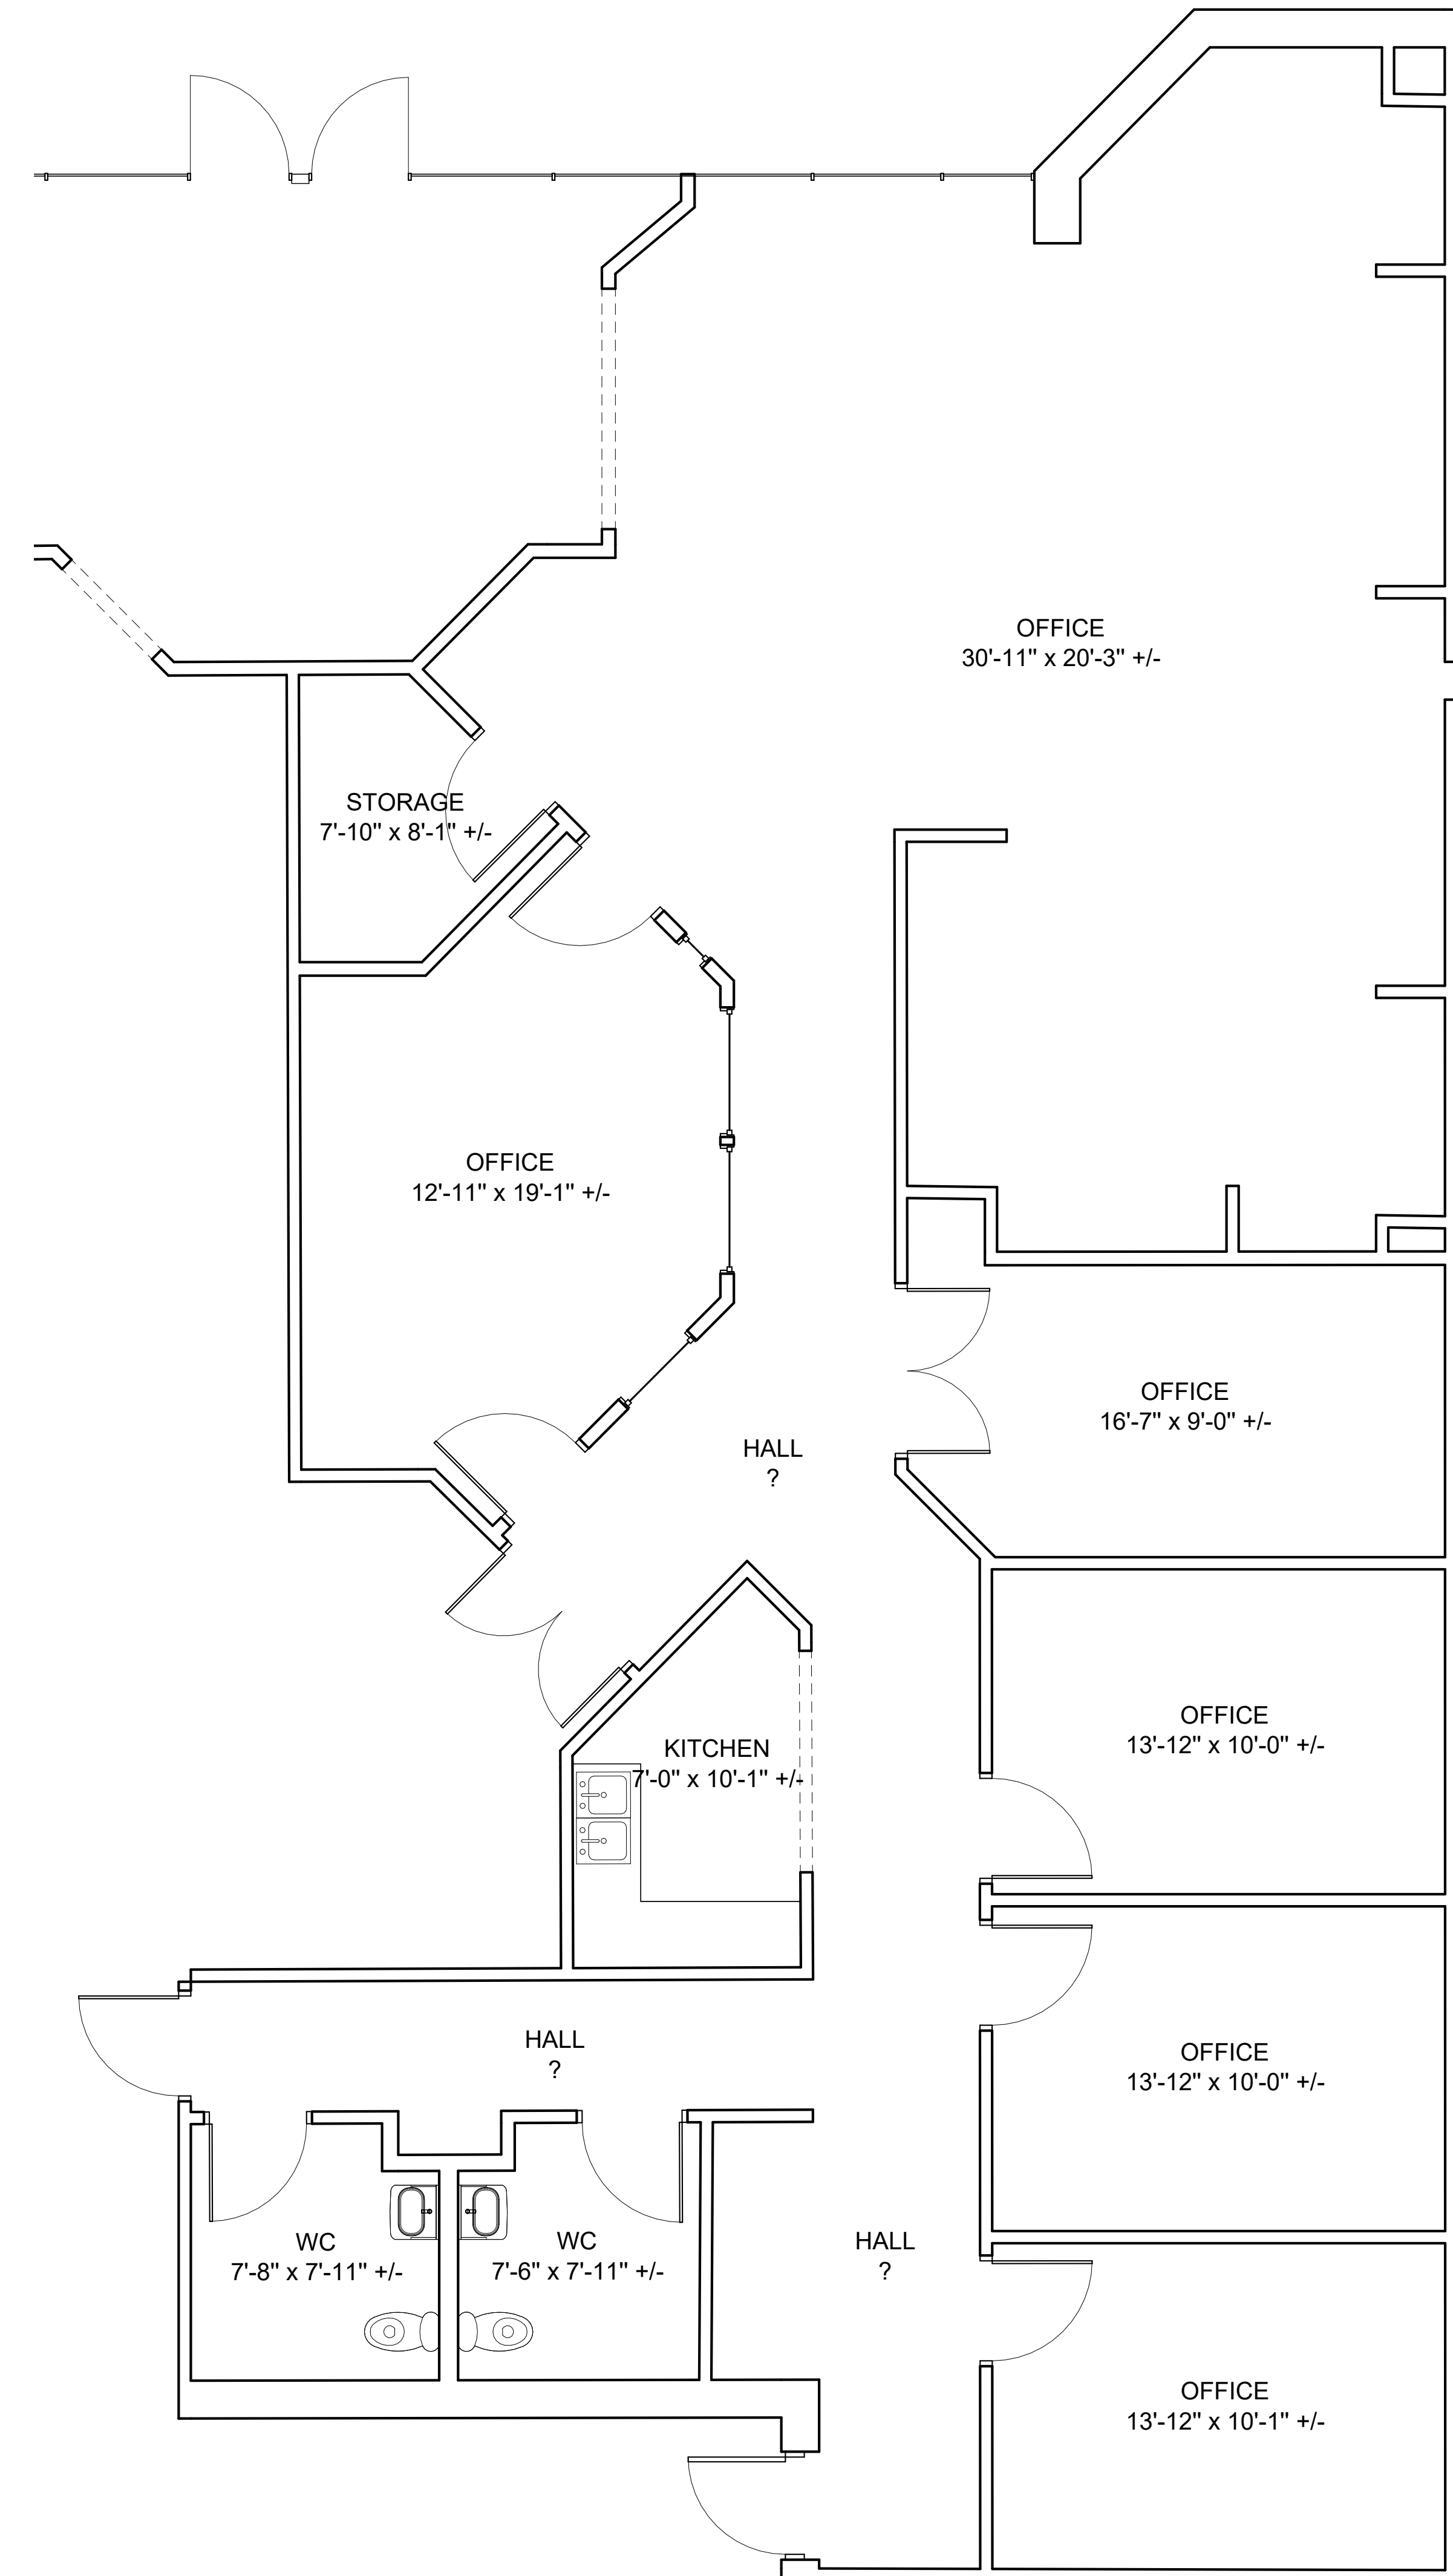

As Built Floor Plan for Marketing

