


AS-BUILT PLANS OF:

517 & 519 WEST MAIN ST

YUKON, OKLAHOMA

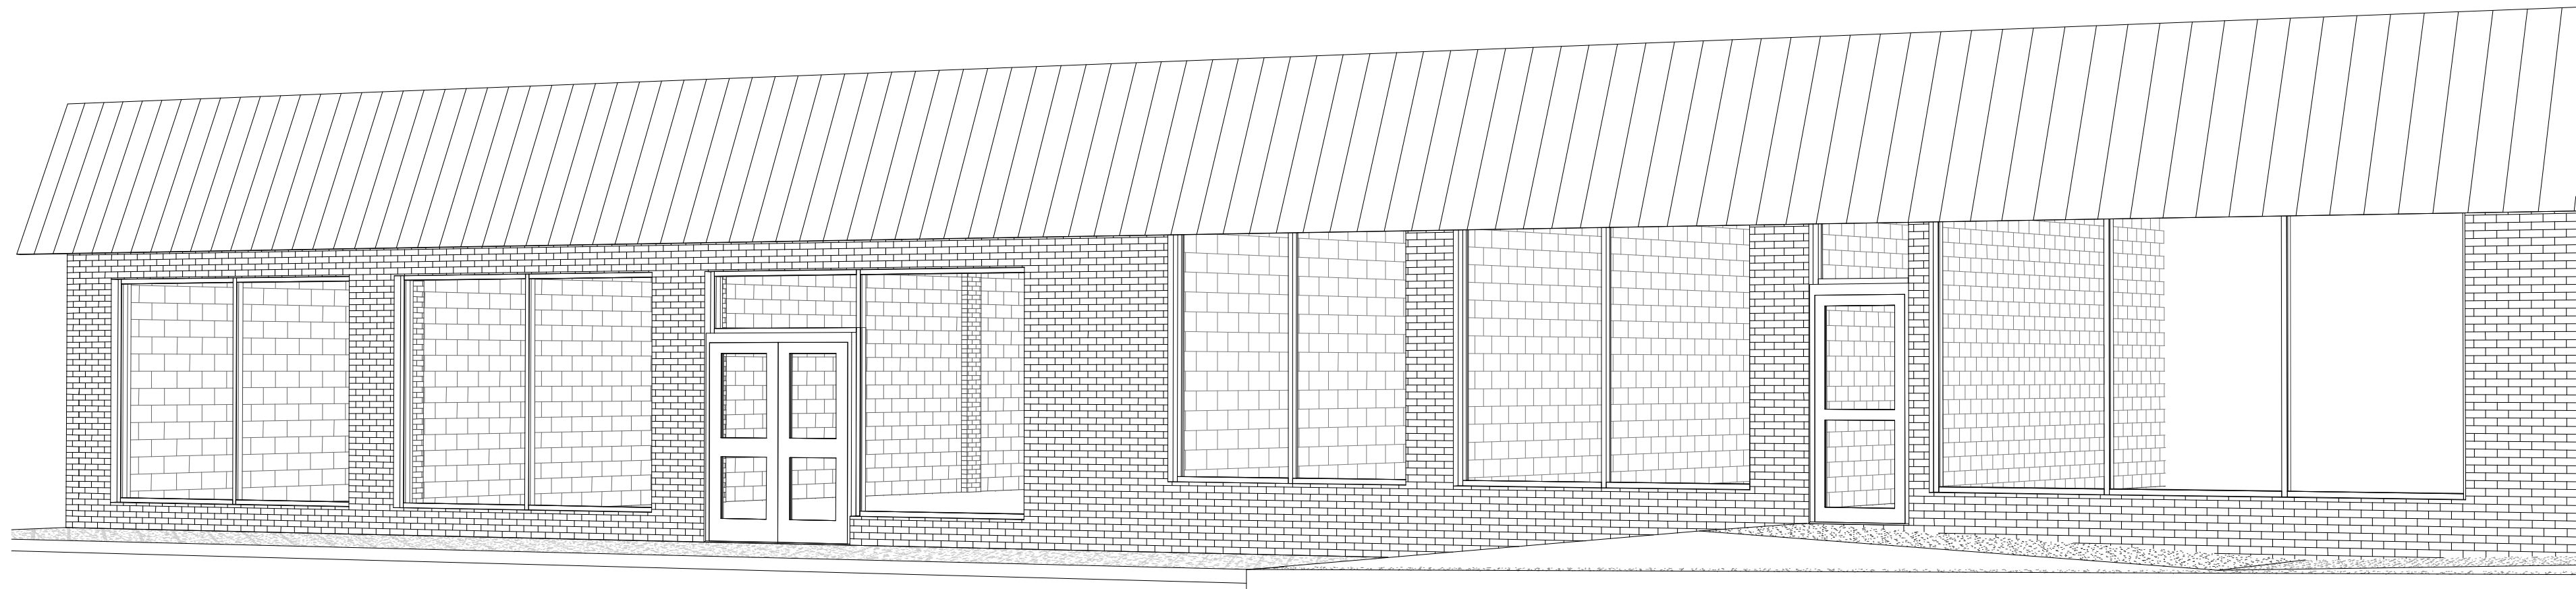

ABBREVIATIONS									
A.F.F.	ABOVE FINISHED FLOOR	DTL	DETAIL	HT	HEIGHT	MIN	MINIMUM	T.O.W.	TOP OF WALL
ADJ	ADJUSTABLE	ELEC	ELECTRICAL	HM	HOLLOW METAL	MISC	MISCELLANEOUS	T	TREAD
ALUM	ALUMINUM	E.W.C	ELECTRIC WATER COOLER	HORIZ	HORIZONTAL	MTL	METAL	TYP	TYPICAL
APPROX / APP	APPROXIMATELY	ELEV	ELEVATION	INSUL	INSULATION	N.I.C.	NOT IN CONTRACT	VERT	VERTICAL
BRG	BEARING	EQ	EQUAL	INT	INTERIOR	N.T.S.	NOT TO SCALE	VCT	VINYL COMPOSITION
B.B.	BENCH MARK	EXIST	EXISTING	JST BRG	JOIST BEARING	REF /RE:	REFER		TILE
BTM	BOTTOM	E.J.	EXPANSION JOINT	JT	JOINT	REINF	REINFORCING	VNYL PLNK	VINYL PLANK FLOORING
BLDG	BUILDING	EXT	EXTERIOR	LAM	LAMINATE	REQ'D	REQUIRED	WC	WATER CLOSET
Q	CENTERLINE	F.H.	FIRE HYDRANT	LAV	LAVATORY	R.I.	ROUGH IN	WD	WOOD
CLG	CEILING	F.E.	FIRE EXTINGUISHER	NO.	NUMBER	RM	ROOM	WD TL	WOOD LOOK TILE
CMU	CONCRETE MASONRY UNIT	F.E.B.	FIRE EXTINGUISHER BRACKET	Q.C.	ON CENTER	R	RADIUS OR RISER		
C.J.	CONTROL JOINT	F.E.C.	FIRE EXTINGUISHER CABINET	OPNG.	OPENING	SIM	SIMILAR		
COL	COLUMN	F.H.C.	FIRE HOSE CABINET	OPP	OPPOSITE	SJ	SCORED JOINT		
CONC	CONCRETE	F.F. /FIN. FLR.	FINISH FLOOR	PL	PLATE	SPECS	SPECIFICATIONS		
CONT	CONTINUOUS	FL	FLOW LINE	PLAM	PLASTIC LAMINATE	SQ	SQUARE		
DIA	DIAMETER	G.I.	GALVANIZED IRON	PLYWD	PLYWOOD	STL	STEEL		
DIM	DIMENSION	GA	GAUGE	MFR	MANUFACTURER	STL JST	STEEL JOIST		
D.F.	DRINKING FOUNTAIN	GW/B	GYPSUM WALL BOARD	M.O.	MASONRY OPENING	STRUCT	STRUCTURAL		
DN	DOWN	HD	HEAD	MAT'L	MATERIAL	T.O.C.	TOP OF CURB		
D.S.	DOWN SPOUT	HD/CP /HC	HANDICAPPED	MAX	MAXIMUM	T.O.M.	TOP OF MASONRY		
		HDWR	HARDWARE	MECH	MECHANICAL	T.O.S.	TOP OF STEEL		

MATERIALS LEGEND

FOR PLANS AND DETAILS

	FACE BRICK		PLASTER
	CMU		GYPSUM BOARD
	CONCRETE		PLYWOOD / OSB
	FRAME PARTITION (METAL STUD)		CHALKBOARD OR TACKBOARD
	SOUND TREATED PARTITION		RIGID INSULATION BOARD
	ROUND STEEL COLUMN		SHEATHING
	SQUARE STEEL COLUMN		WOOD FRAMING (CONTINUOUS MEMBER)
	WIDE FLANGE STEEL COLUMN		WOOD BLOCKING (DISCONTINUOUS MEMBER)
	SQUARE CONCRETE COLUMN		FINISH WOOD
			MISCELLANEOUS METAL
			ALUMINUM
			STRUCTURAL NEOPRENE GASKET
			GYPSUM LATH
			ACOUSTICAL TILE
			EARTH FILL

NOTE: ABOVE MATERIAL INDICATIONS ARE STANDARD & ARE NOT INTENDED AS A LISTING OF MATERIALS ON THE JOB.

SYMBOLS LEGEND

	EXISTING SPOT ELEVATION		STRUCTURAL GRID COORDINATES
	FINISH SPOT ELEVATION		SECTION CUT MARK
	EXISTING GRADE CONTOUR		LARGER SCALE DETAIL MARK
	FINISH GRADE CONTOUR		INTERIOR ELEVATION
	EXISTING TREE TO BE PROTECTED		WALL TYPE LETTER
	EXISTING TREE TO BE REMOVED		INTERIOR WALL TYPE MARK
	PROPERTY LINE		
	PAVING (CONCRETE)		
	PAVING (ASPHALT)		
	CONCRETE WALK		
	TEST HOLE		
	BENCH MARK		
	EXISTING BUILDING TO REMAIN		
	EXISTING BUILDING TO BE REMOVED		
	NEW BUILDING		
	FENCE		
	ELEV. INDICATED		
	SHEET # OF ELEV.		
	DOOR NUMBER		
	ROOM NUMBER		
	ALUMINUM FRAME ELEVATION		
	ITEM NO.		
	EQUIPMENT MARK		

SHEET LIST	
NUMBER	NAME
A000	COVER SHEET
A301	AS-BUILT FLOOR PLAN & CEILING PLAN

PROJECT DESCRIPTION:

AS-BUILT FLOOR PLANS OF EXISTING WAREHOUSE BUILDINGS

AREA:
14,000 GROSS SF

EXITS:
(2) EACH BUILDING

PLUMBING CALC:
(1) SINGLE USER RESTROOM EACH BUILDING



701 Cedar Lake Blvd, Suite 154
OKC, OK 73114
405.517.5042
tim@tp-arch.com

AS-BUILT PLANS OF:

517 & 519 WEST MAIN ST

YUKON, OKLAHOMA

AS-BUILT PLANS

Date: 11-3-25

Revised:


COVER SHEET

PROJECT NUMBER:
25039



Sheet No.

A000


COPYRIGHT © 2025
TP ARCHITECTURE LLC

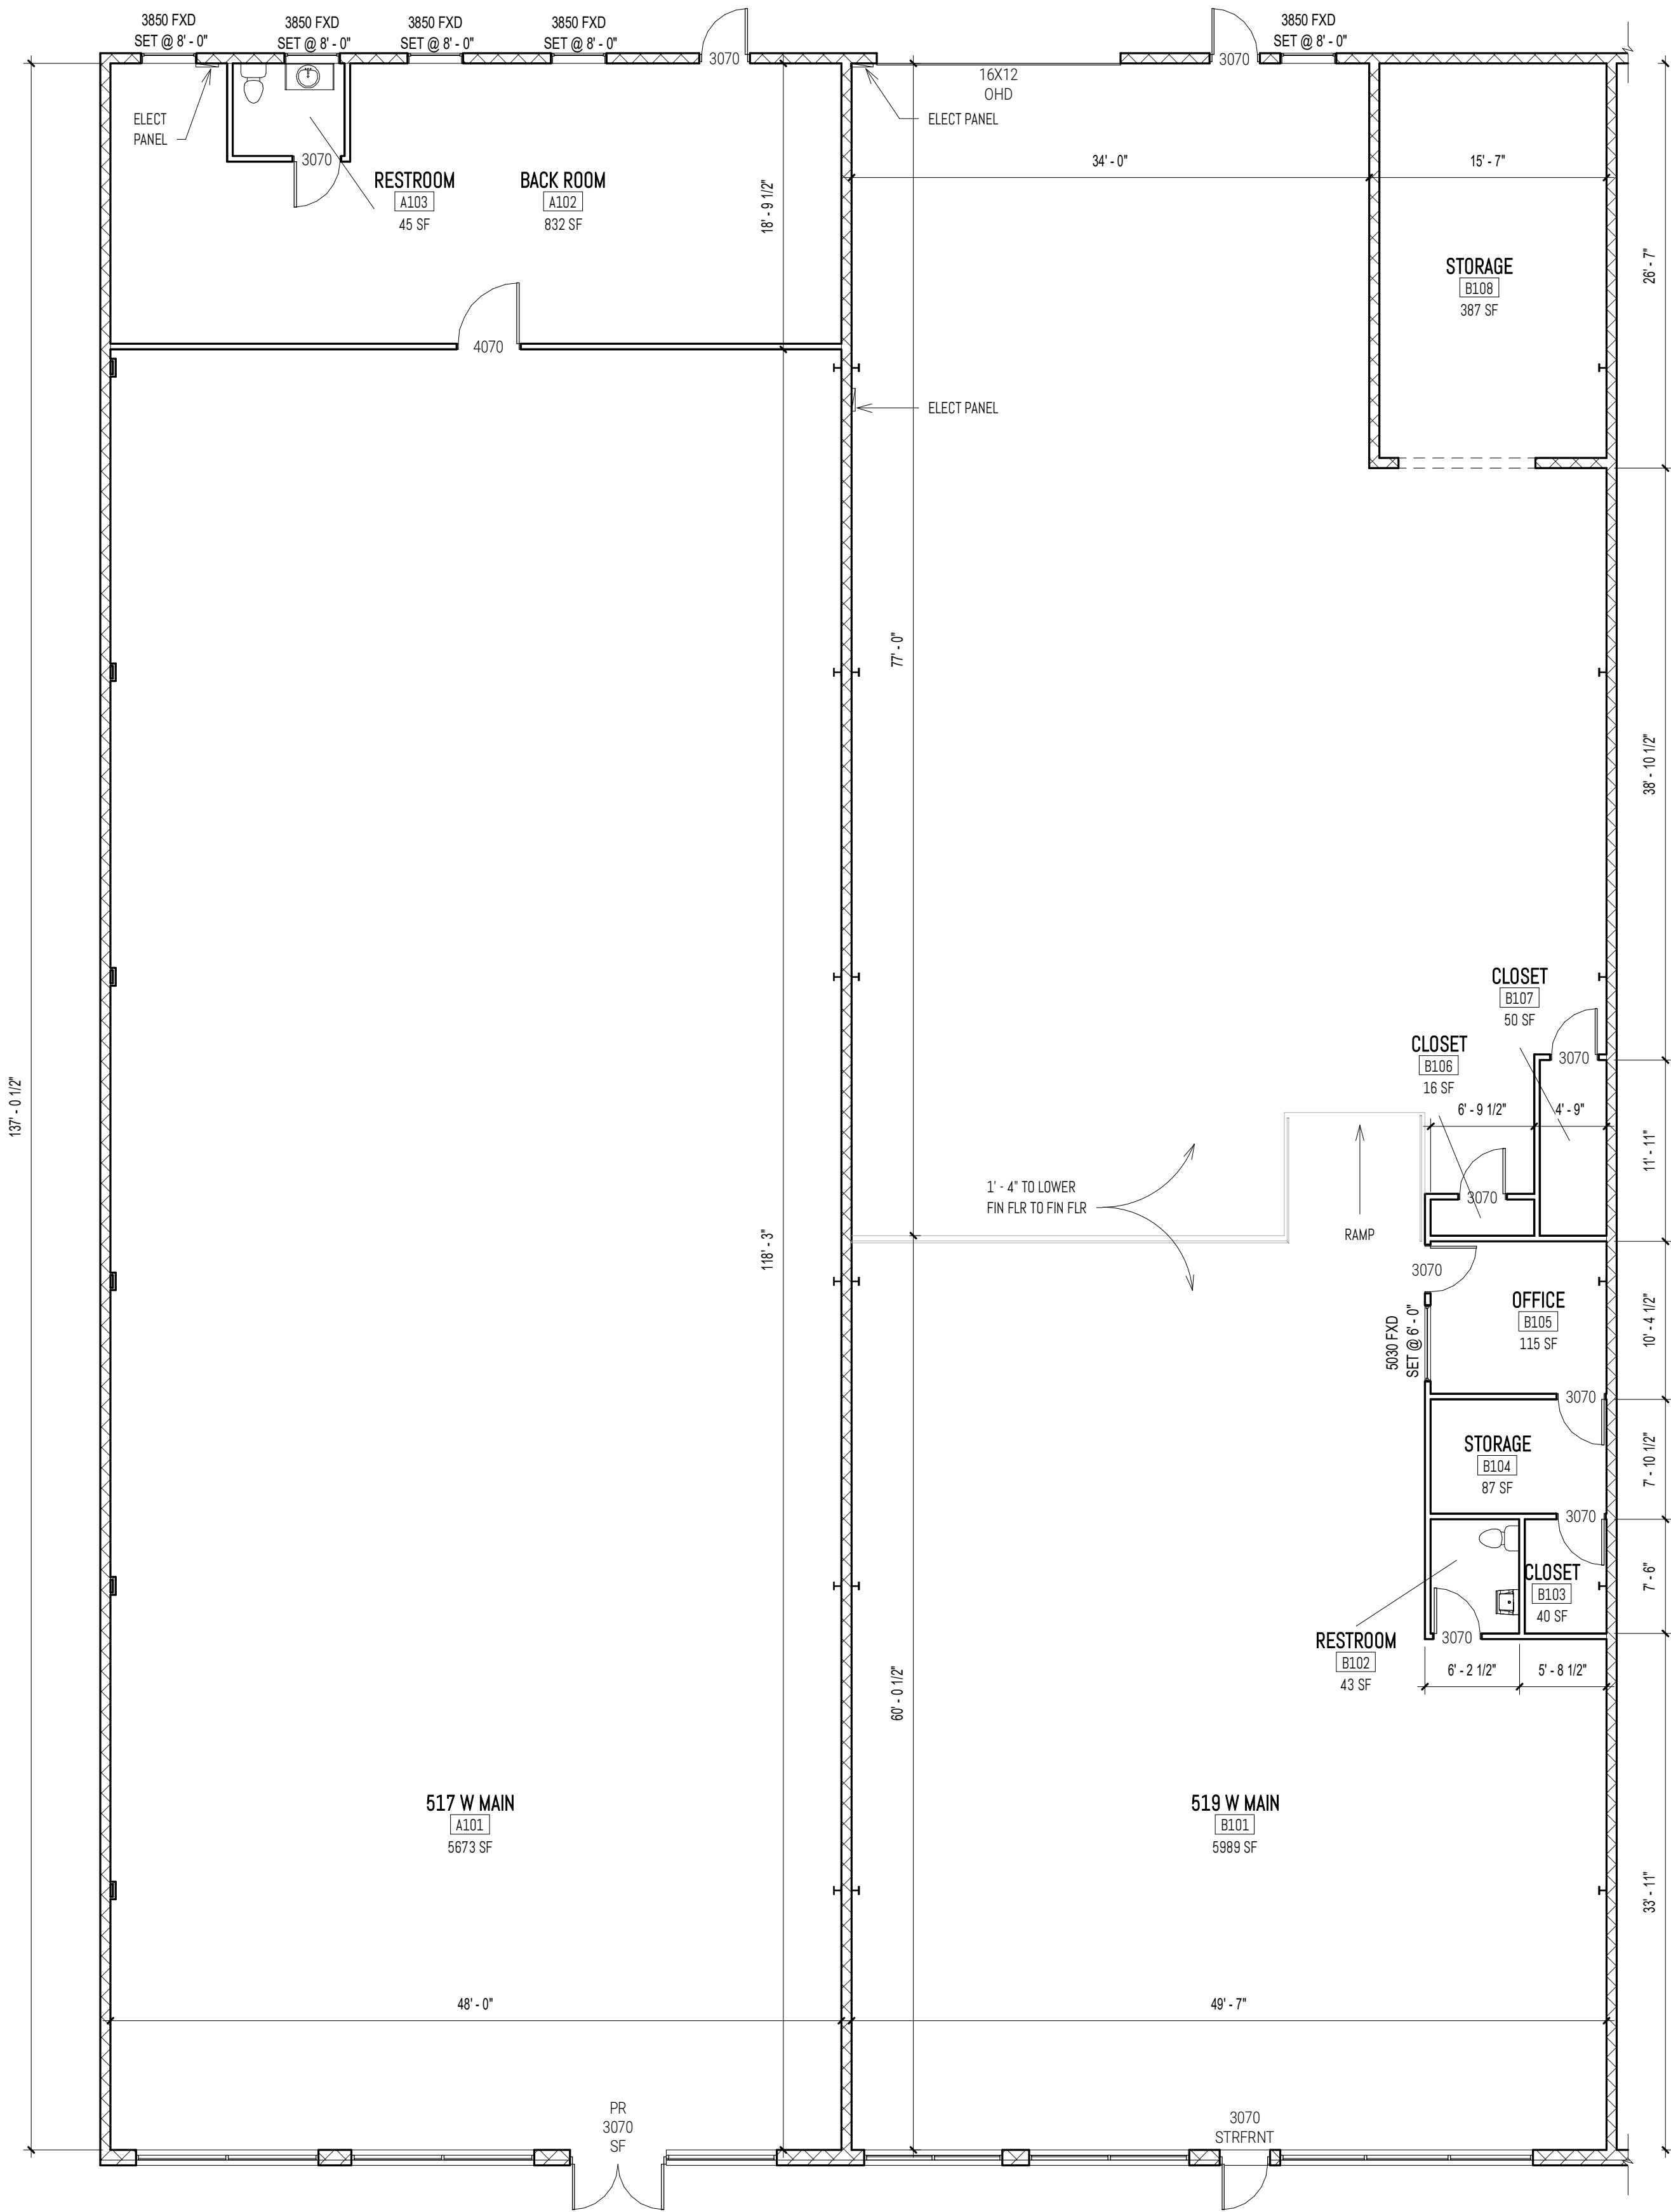

1 EXISTING AS-BUILT FLOOR PLAN
1/8" = 1'-0"

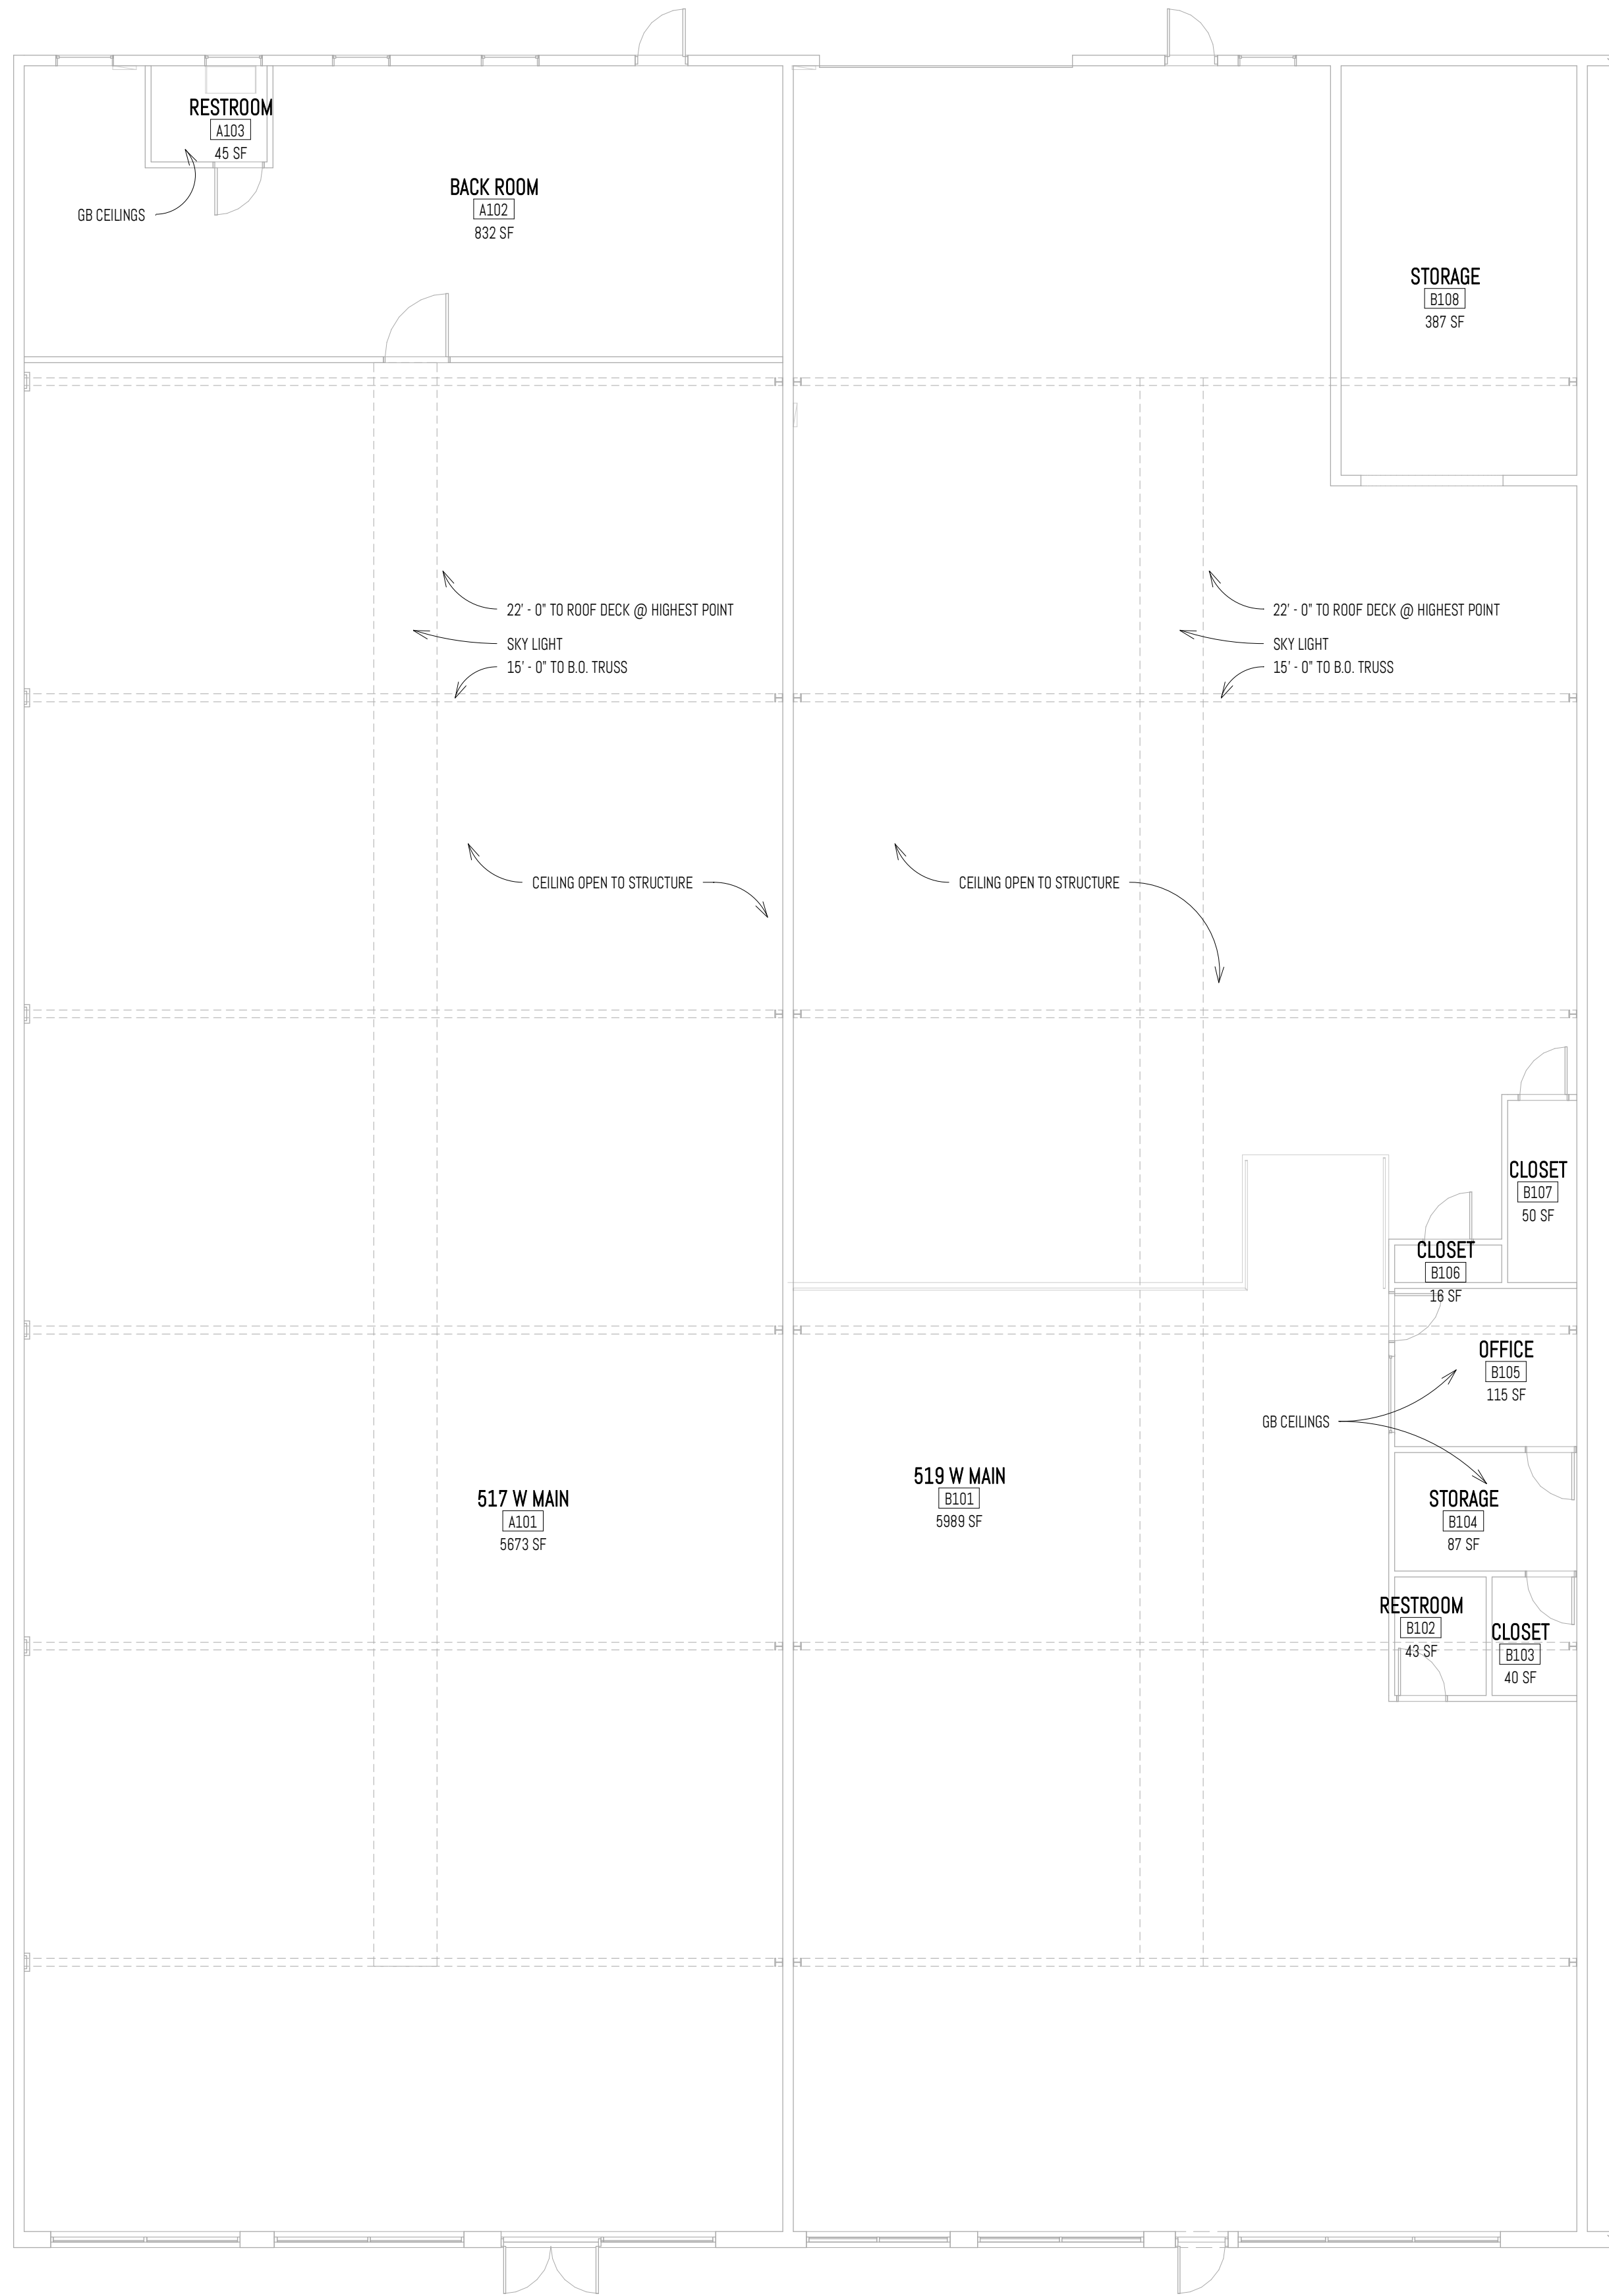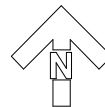

2 REFLECTED CEILING PLAN
1/8" = 1'-0"

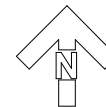

701 Cedar Lake Blvd, Suite 154
OKC, OK 73114
405.517.5042
tim@tp-arch.com

AS-BUILT PLANS OF:
517 & 519 WEST MAIN ST
YUKON, OKLAHOMA

AS-BUILT PLANS

Date: 11-3-25

Revised:

AS-BUILT FLOOR PLAN &
CEILING PLAN

PROJECT NUMBER:
25039

Sheet No.

A301

COPYRIGHT © 2025
TP ARCHITECTURE LLC