


THIS DRAWING IS THE PROPERTY OF ALL ARCHITECTURE, LLC AND MAY NOT BE REPRODUCED WITHOUT WRITTEN CONSENT © 2025

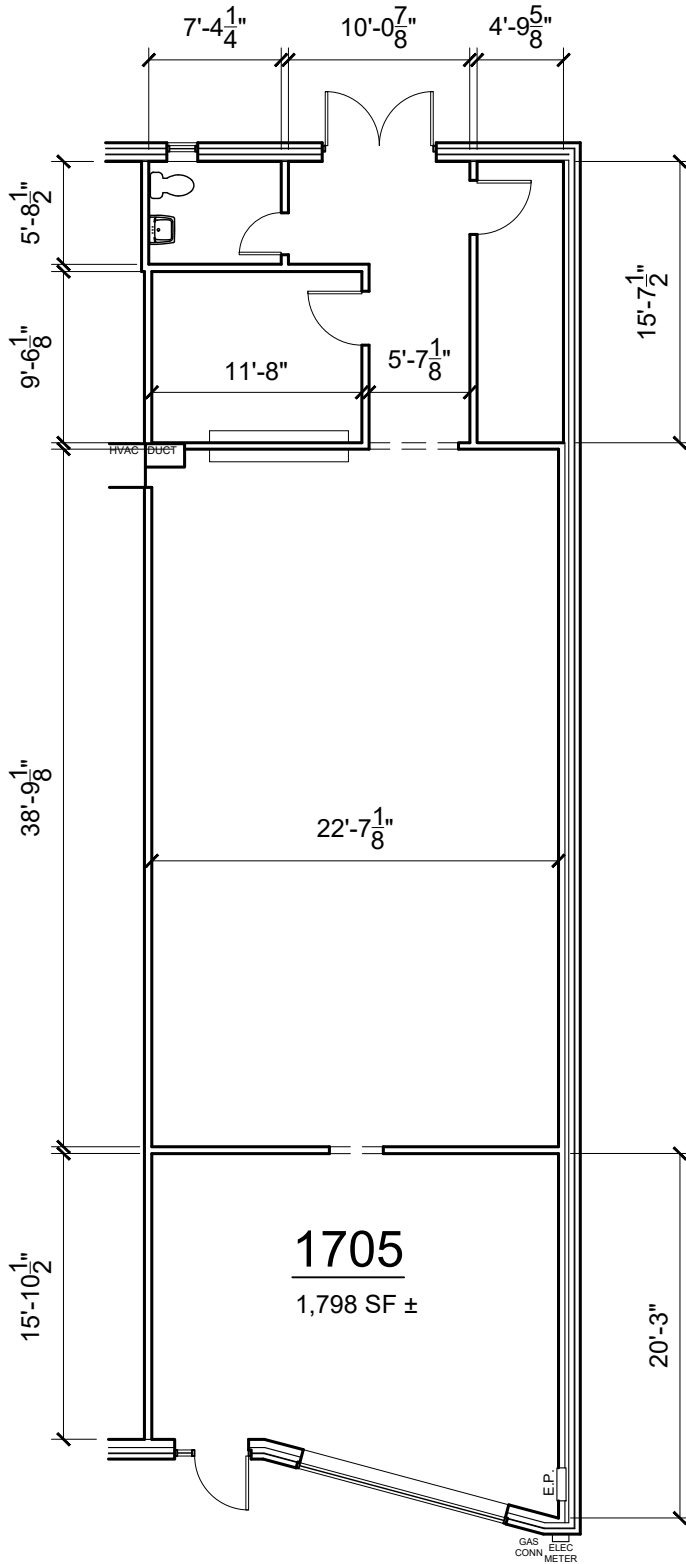

TRUE NORTH

ALL Architecture, LLC  
INFO@ALLARCHLLC.COM

DATE: 03/10/25  
PROJ. NO. 25019

1705 WASHINGTON RD  
EAST POINT, GA 30344

