

NOTES

THIRDWAY INTERIORS DO NOT ACCEPT LIABILITY FOR ANY ERRORS AND OMISSIONS ARISING FROM THE PREPARATION OF BASE BUILD DRAWINGS WHICH ARE DERIVED FROM ORIGINAL MATERIAL PROVIDED BY OTHERS.

ALL DISCREPANCIES ARE TO BE REPORTED TO THIRDWAY INTERIORS.

GRID LINES ARE FOR REFERENCE PURPOSES ONLY.

ALL DIMENSIONS TO BE VERIFIED BY CONTRACTOR ON SITE PRIOR TO ANY WORKS COMMENCING.

DO NOT SCALE FROM THIS DRAWING.

THIS DOCUMENT IS THE PROPERTY OF THIRDWAY INTERIORS. COPYRIGHT IS RESERVED BY THEM, AND THE DRAWING IS ISSUED ON THE CONDITION THAT IT IS NOT COPIED, REPRODUCED OR RETAINED BY, NOR DISCLOSED TO ANY UNAUTHORISED PERSON, EITHER WHOLLY OR IN PART, WITHOUT THE CONSENT IN WRITING FROM THIRDWAY INTERIORS.

© THIRDWAY INTERIORS

GENERAL KEY

| |
|--|
| DOOR REFERENCE NUMBER |
| ROOM REFERENCE NUMBER |
| PLY LINED WALL |
| NEW 100mm FULL HEIGHT PARTITION (RAF TO FCL) |
| NEW 100mm HALF HEIGHT PARTITION (FROM RAF) |
| NEW 12mm GLASS PARTITION |
| NEW SOLID CORE TIMBER DOOR (SEE DOOR SCHEDULE) |
| NEW FRAMED GLASS DOOR (SEE DOOR SCHEDULE) |

STATUS

- Approval / Comment
- Building Control
- Contract
- Construction
- As-Built

REVISION DETAIL

| REV | DETAIL | BY | DATE |
|-----|--------|----|------|
| - | - | - | DDMM |
| - | - | - | - |
| - | - | - | - |
CLIENT

STYLUS

PROJECT ADDRESS

**116 OLD STREET
LONDON
EC1V 9BG**

DRAWING TITLE

**FIRST FLOOR
GENERAL ARRANGEMENT
AS-BUILT**

DWG NO: **21946-01-GA-AB**



REVISION: **B**

SCALE @A1: **1:100** @ A3: **1:200**

DATE: **13.01.2020**

DRAWN BY: **TG**

CHECKED BY: **FS**

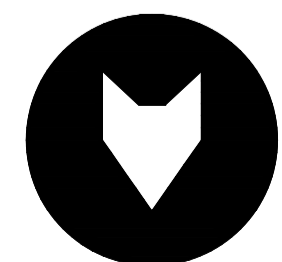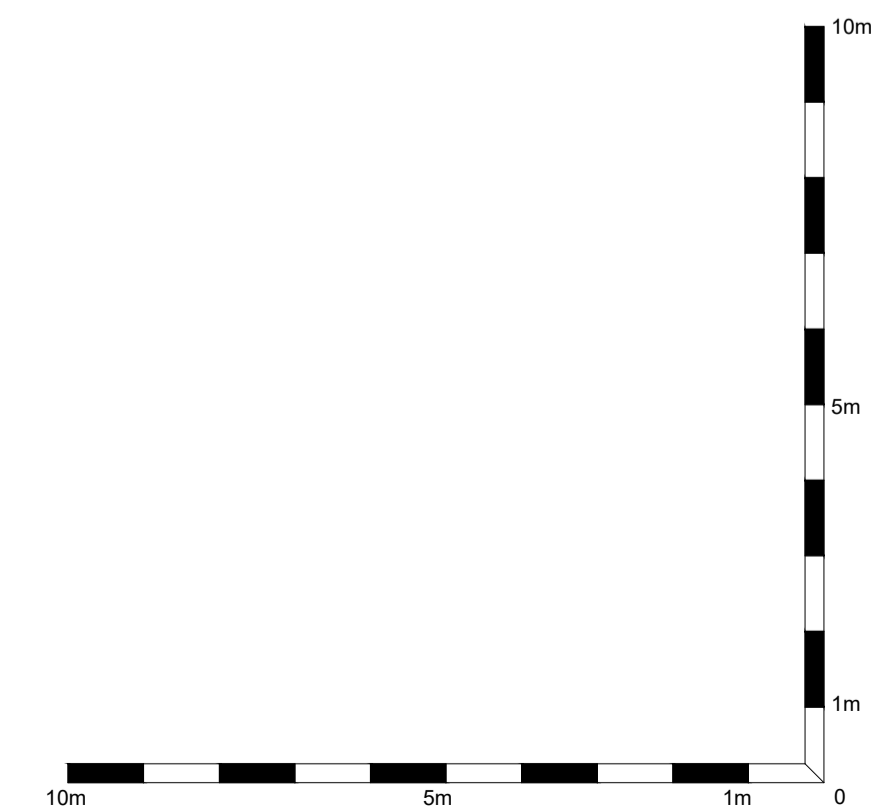

THIRDWAY