
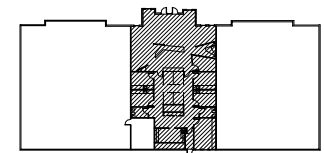


NOT FOR CONSTRUCTION
[CONTRACTOR TO FIELD VERIFY EXISTING
CONDITIONS PRIOR TO PRICING THIS PLAN]

PLAN LEGEND

EXISTING TO REMAIN

-  WALL
-  PARTIAL HEIGHT WALL
-  WINDOW / SIDELIGHT
-  DOOR AND FRAME
-  CASEWORK / BUILT-IN
ELEMENT

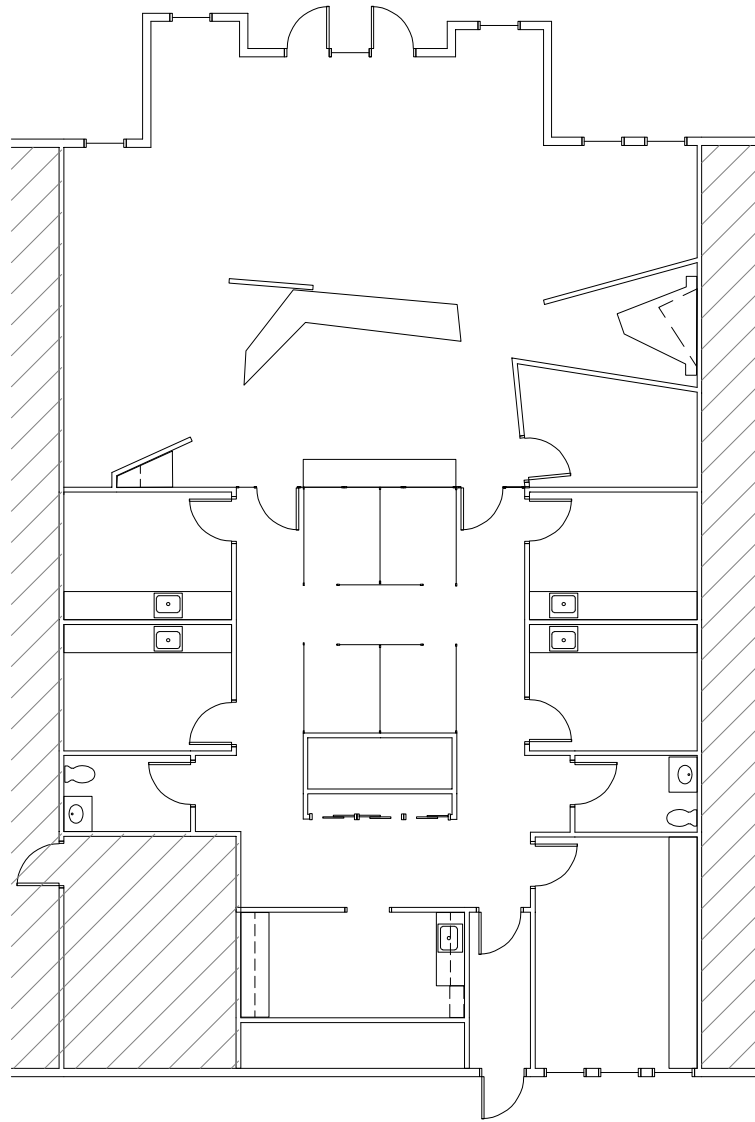

SUITE 120 ASBUILT

3965 W 106TH ST CARMEL, IN 46032

2,974 RSF

SCALE: 3/32" = 1'-0"

PROJECT MGR: EH

DATE: 09.28.21

2021.277