


# Suite # 500 As Built Floor Plan

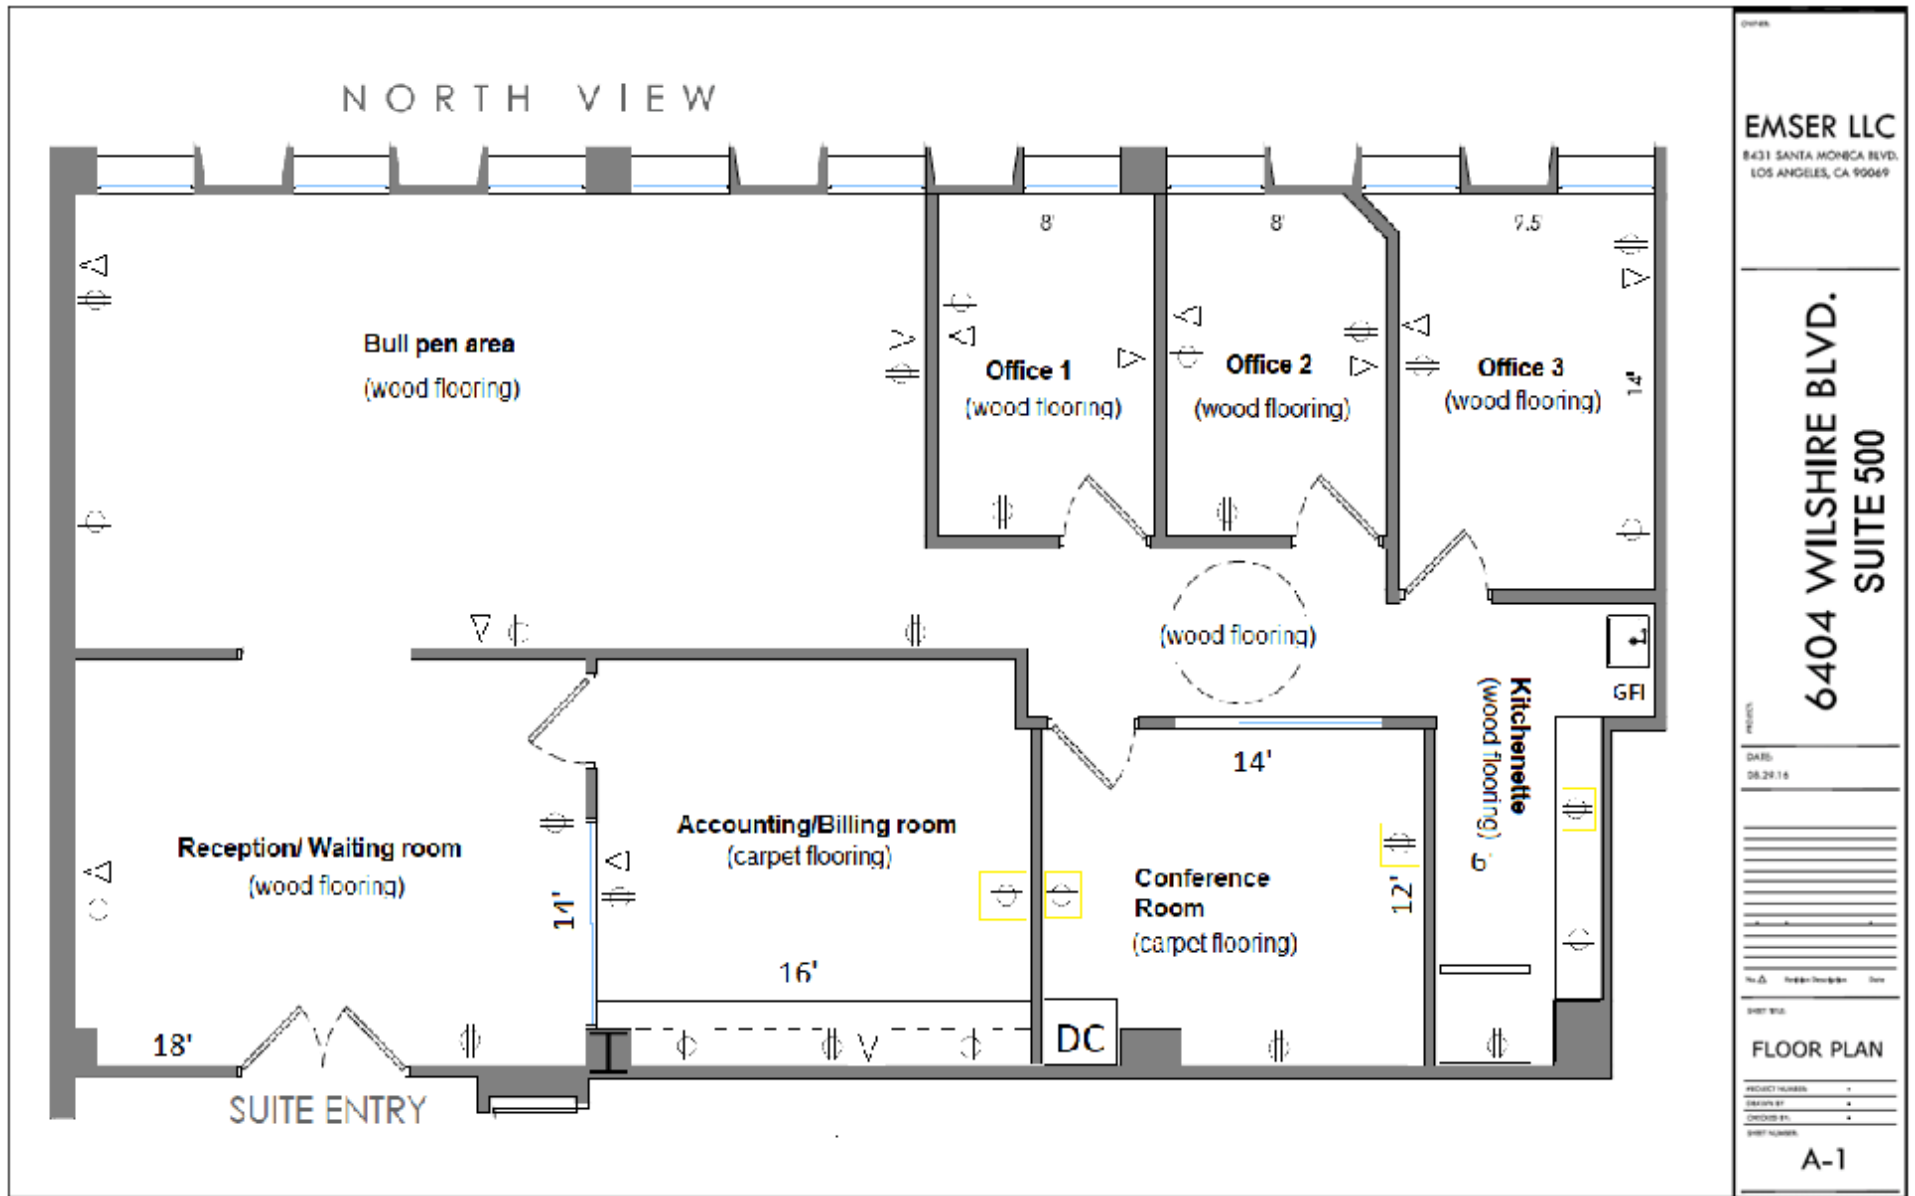

**EMSER LLC**  
8431 SANTA MONICA BLVD.  
LOS ANGELES, CA 90049

**6404 WILSHIRE BLVD.  
SUITE 500**

DATE:	08.29.16
PROJECT NUMBER:	
DRAWN BY:	
CHECKED BY:	
SHEET NUMBER:	A-1