
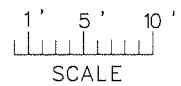


EXISTING PROPERTY AT:

1201 W. PENDER STREET,
VANCOUVER, B.C.

SECOND FLOOR

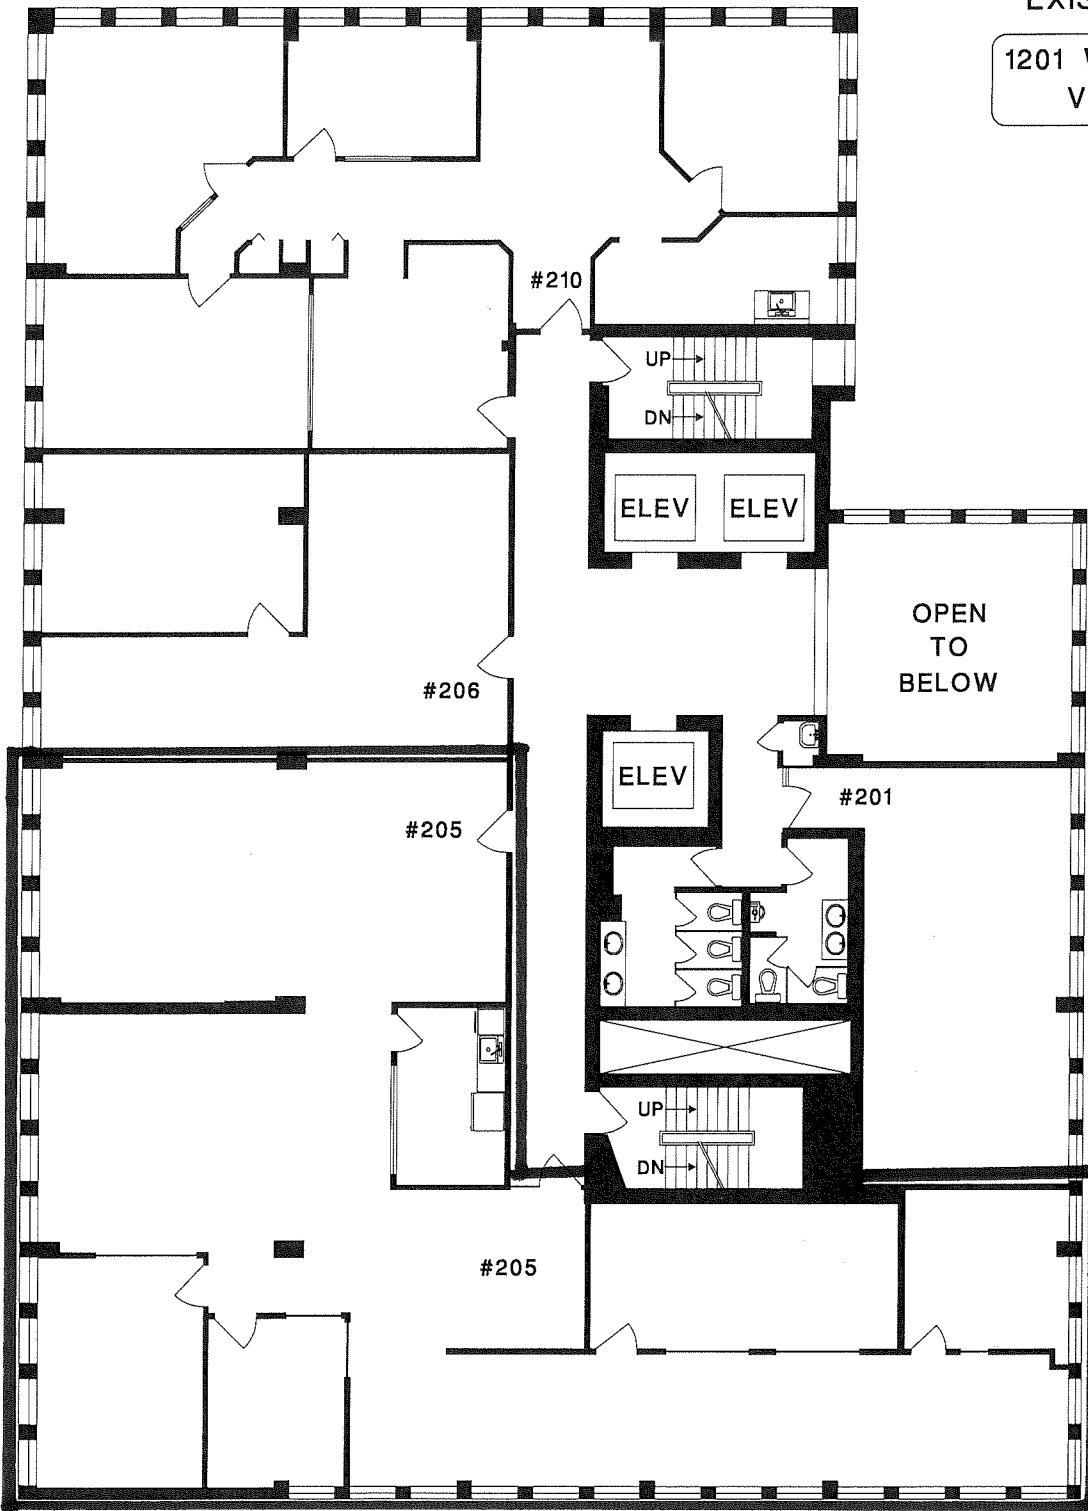

MEASURE MASTERS
VAN/BBY/TAI-DIT/ES
(804) 831-8585
DRAWN: JUNE 2001
REV: APRIL 2006
REV: NOV. 2015
REV: DEC. 2023

All measurements must be verified
prior to construction or renovations.